

11' 6"



BM 98.74 SE cor. conc. porch Ho. NE cor. Ash & Rule.

Total	Property	City
	1019.9	0
+10%	1121.9	
	1121.2	anyda.

BM 98.60 SE cor. conc. porch NW cor. Rule & Spruce.

Property

- 76.1
- 55.8
- 98.9
- 111.3
- 146.7
- 165.2
- 157.2
- 142.0
- 136.9
- 1019.3

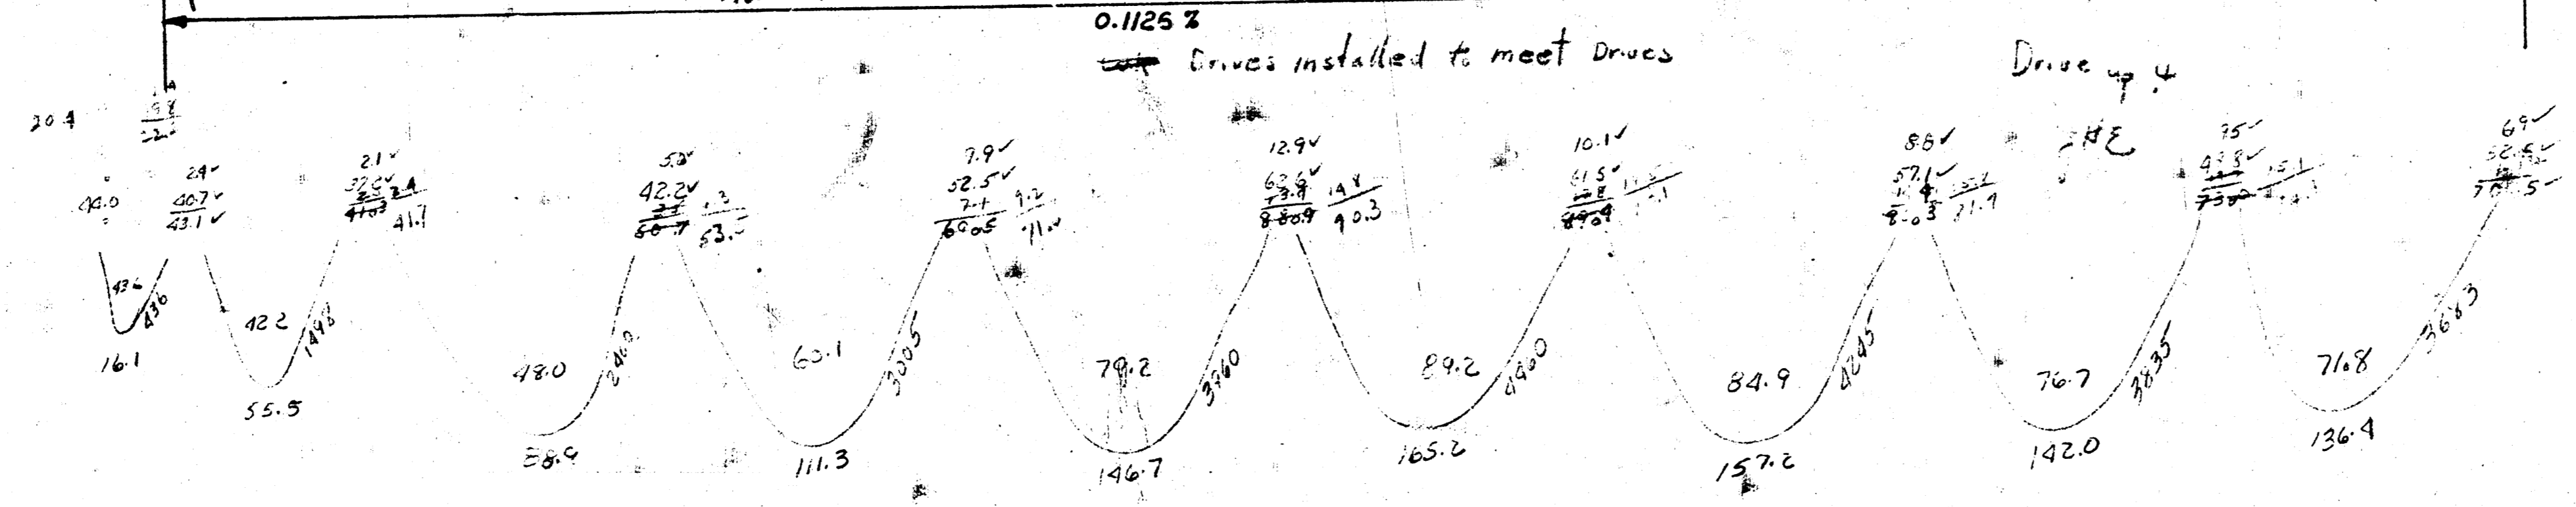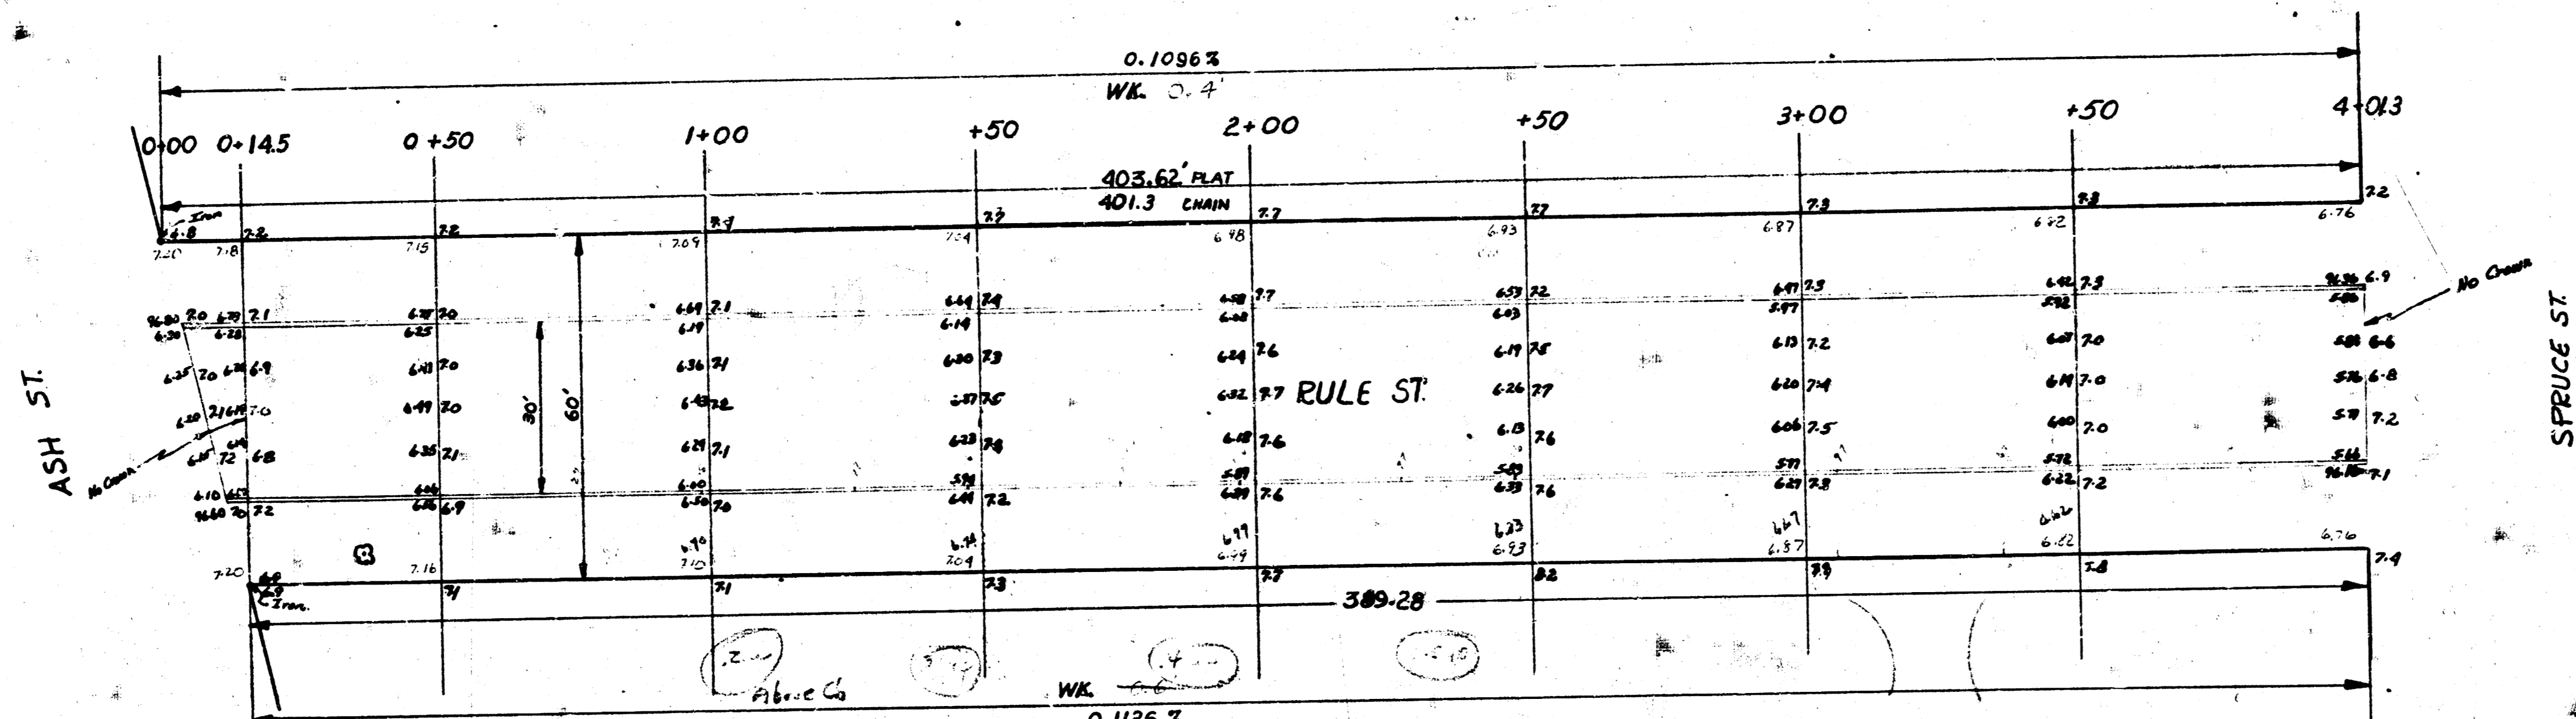

16 dr

RULE ST.  
EL ASH WL SPRUCE  
30' CONC. & CB.  
CITY OF WICHITA, KANS.  
LK WHITE CITY ENGINEER  
AUGUST, 1950 C10-93

4 e 3 53