


D.M. 121.04 Dalt 3'5.61 S.E. Cor. Brack Ridge Str. N.E. Cor. Arkansas & 21st St
 D.M. 122.00 15' m Globe C. W. N. N.W. Cor 21st & Rosenthal

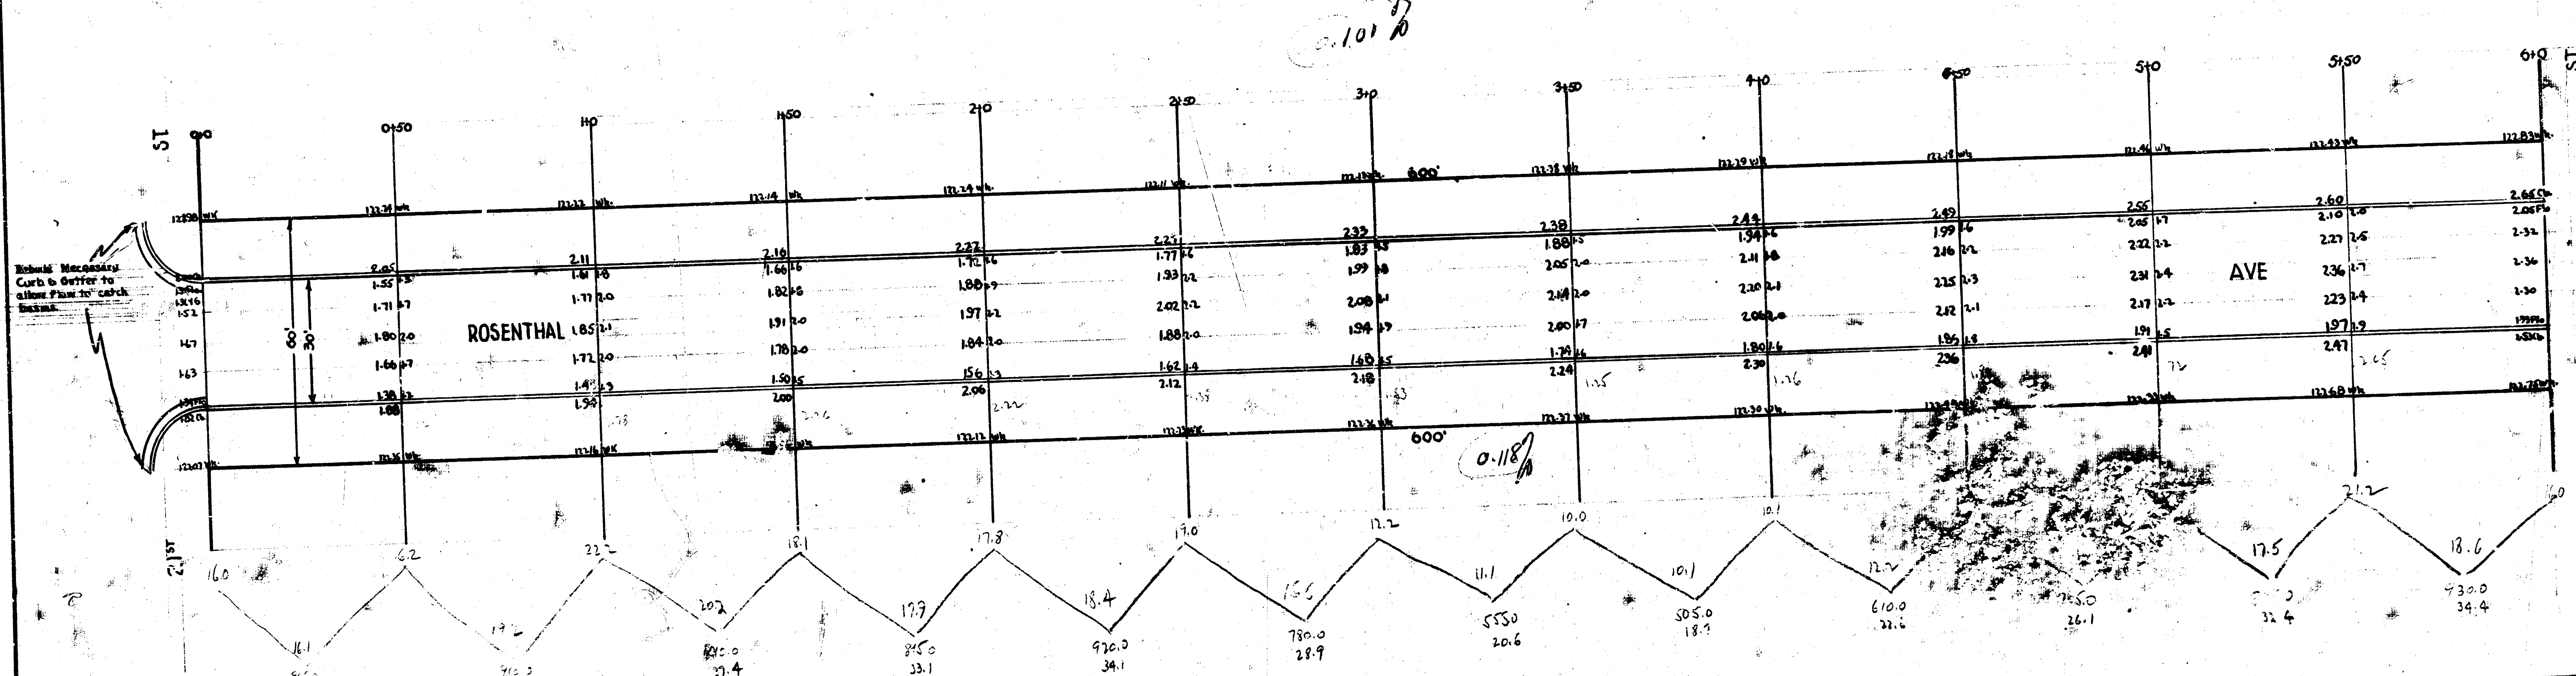

ROSENTHAL AVE
 N.L. 21st TO S.L. 22nd
 30' CONCRETE & C.B.
 CITY OF WICHITA, KANSAS
 LK WHITE CITY ENGINEER
 JUNE 1946

4853