


B.M. 199.64 4' in pavement @ 17th E.L. Harvard
201.63 3' in pavement @ 17th E.L. Harvard

Note: All stationing is 25' from P.L.

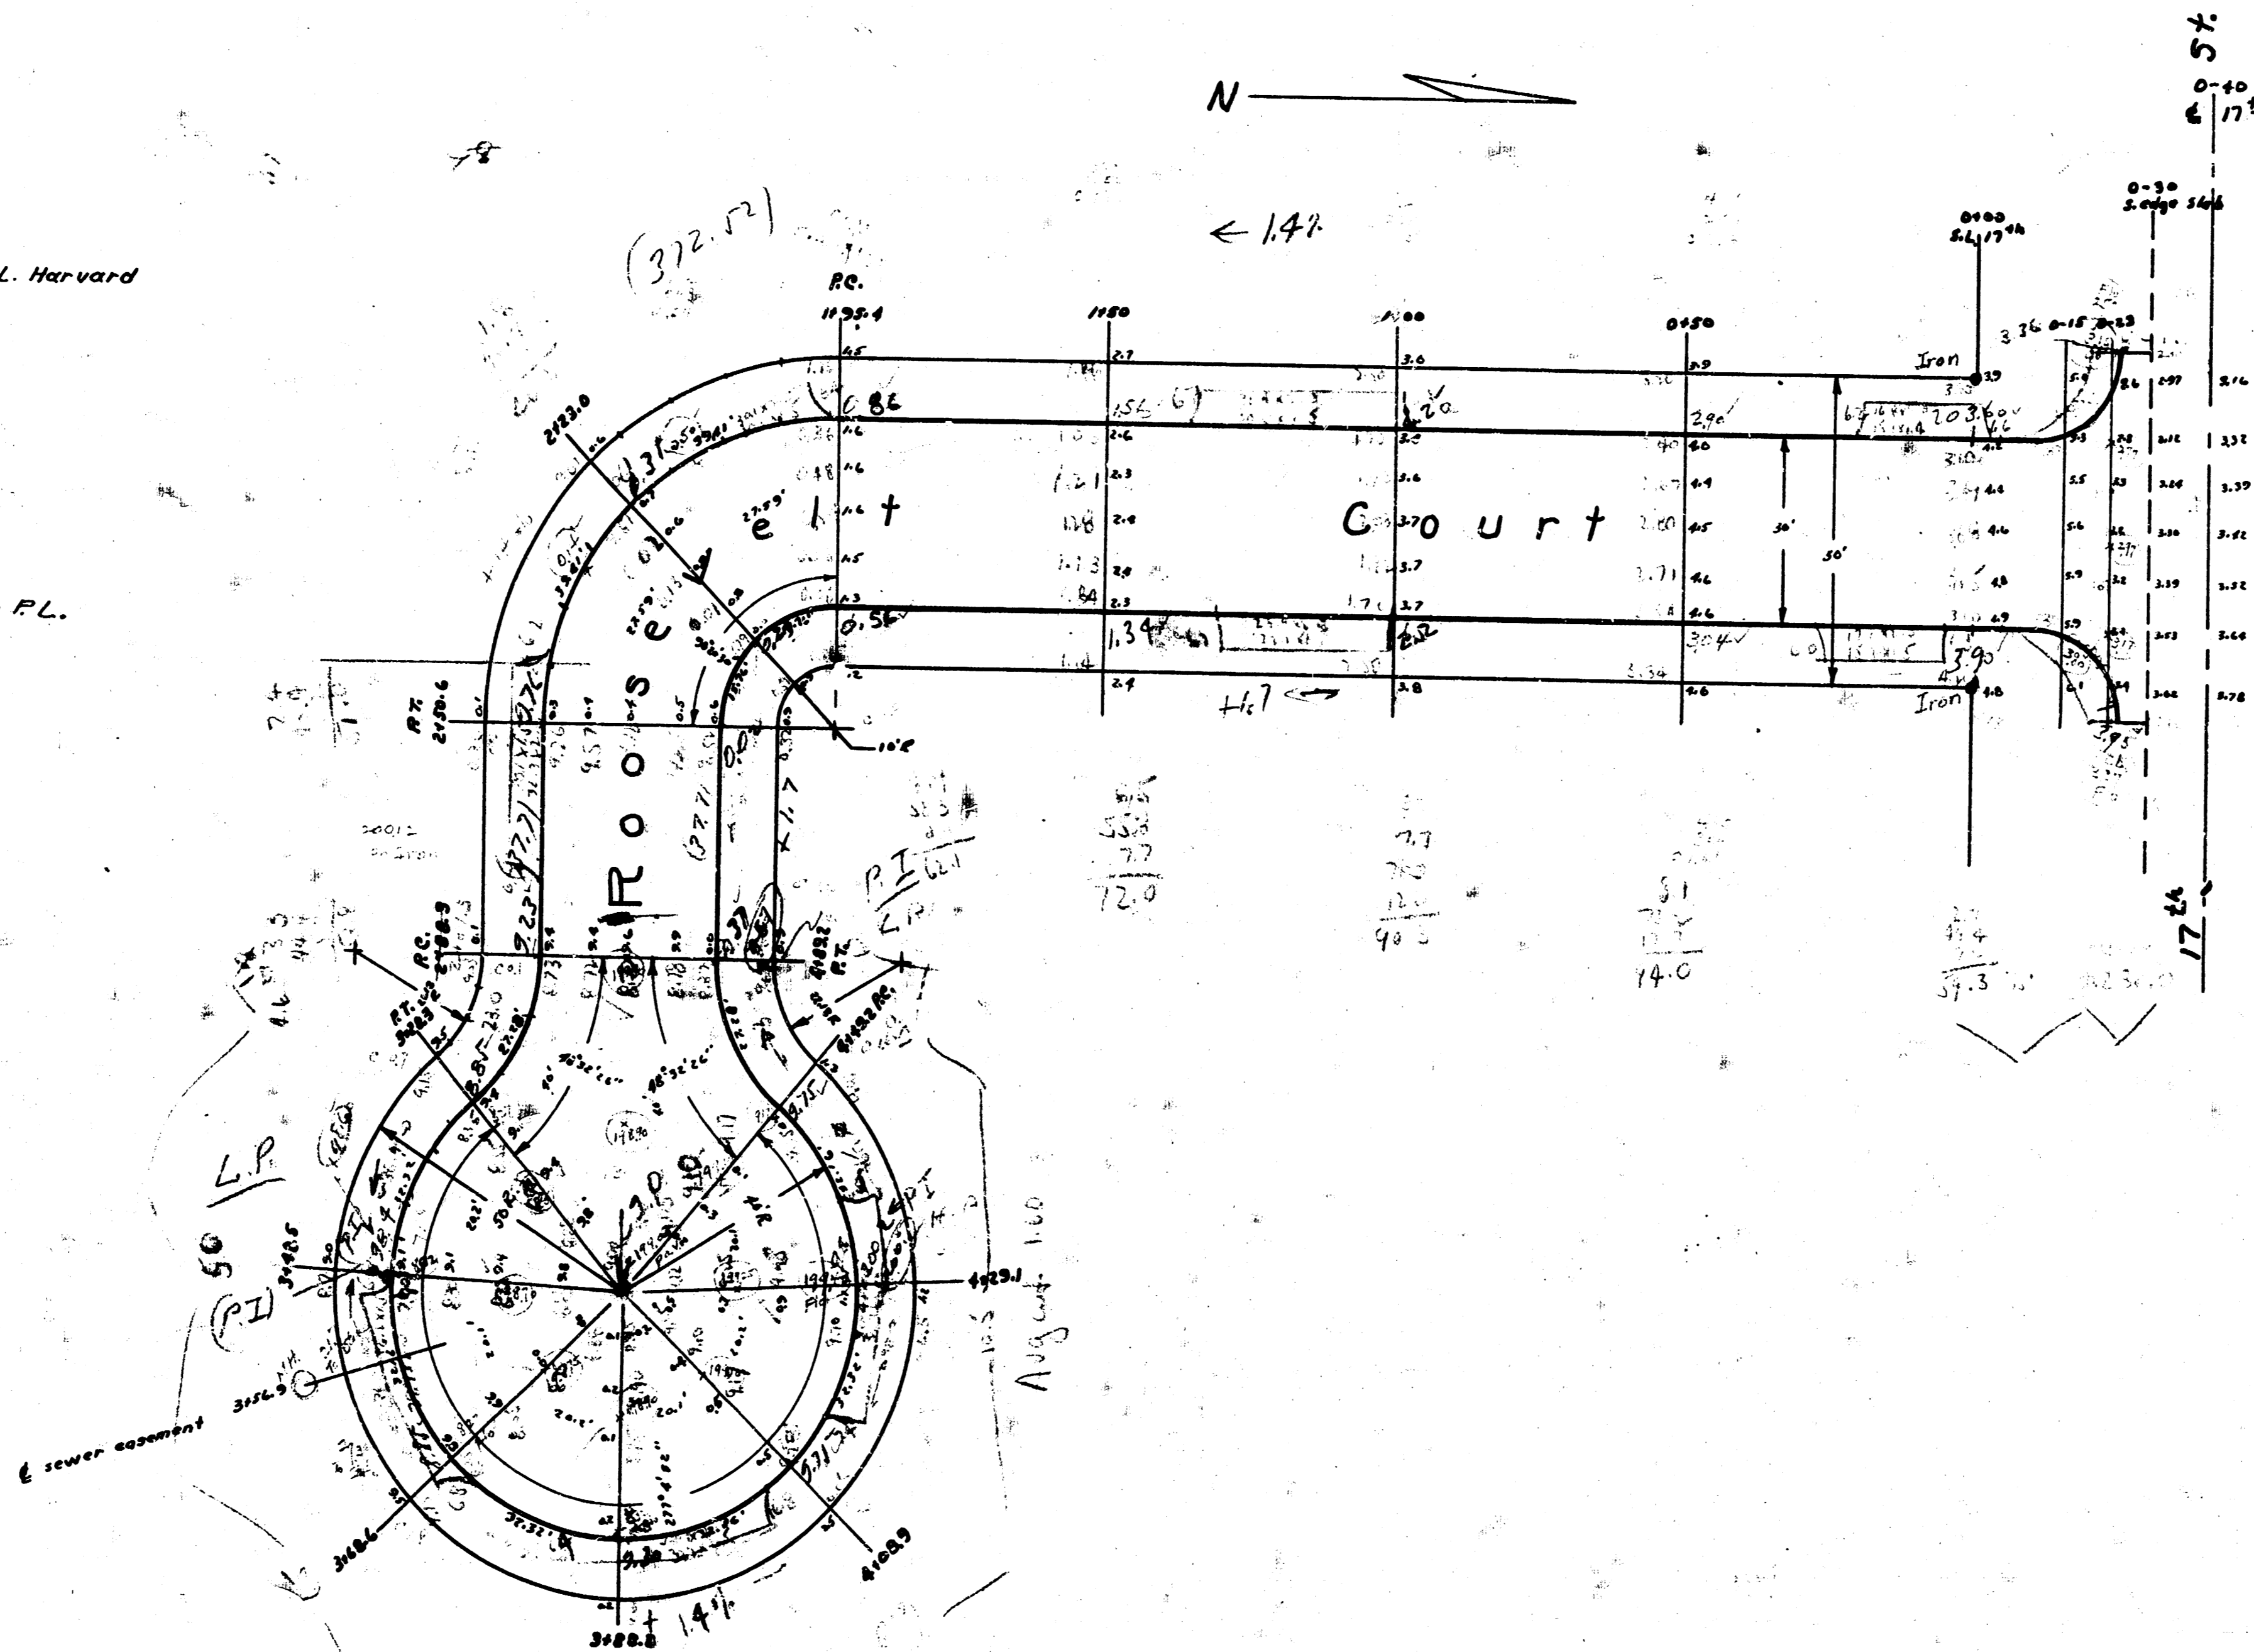

Roosevelt Court
S.L. 17th ~ South
30' Conc. & Cb.
City of Wichita, Kansas
L. K. White ~ City Engineer
11-49 Private Job