


D.M. 20251 NW COR. PORCH HO. # 1593 GENTRY

Excluded as well as  
inches

STATIONED ON 11' OFFSET FROM W.R.L.

Property

94.3  
151.4  
91.8  
46.3  
59.6  
65.3  
68.1  
576.8  
110% 57.6  
634.4 cu yd

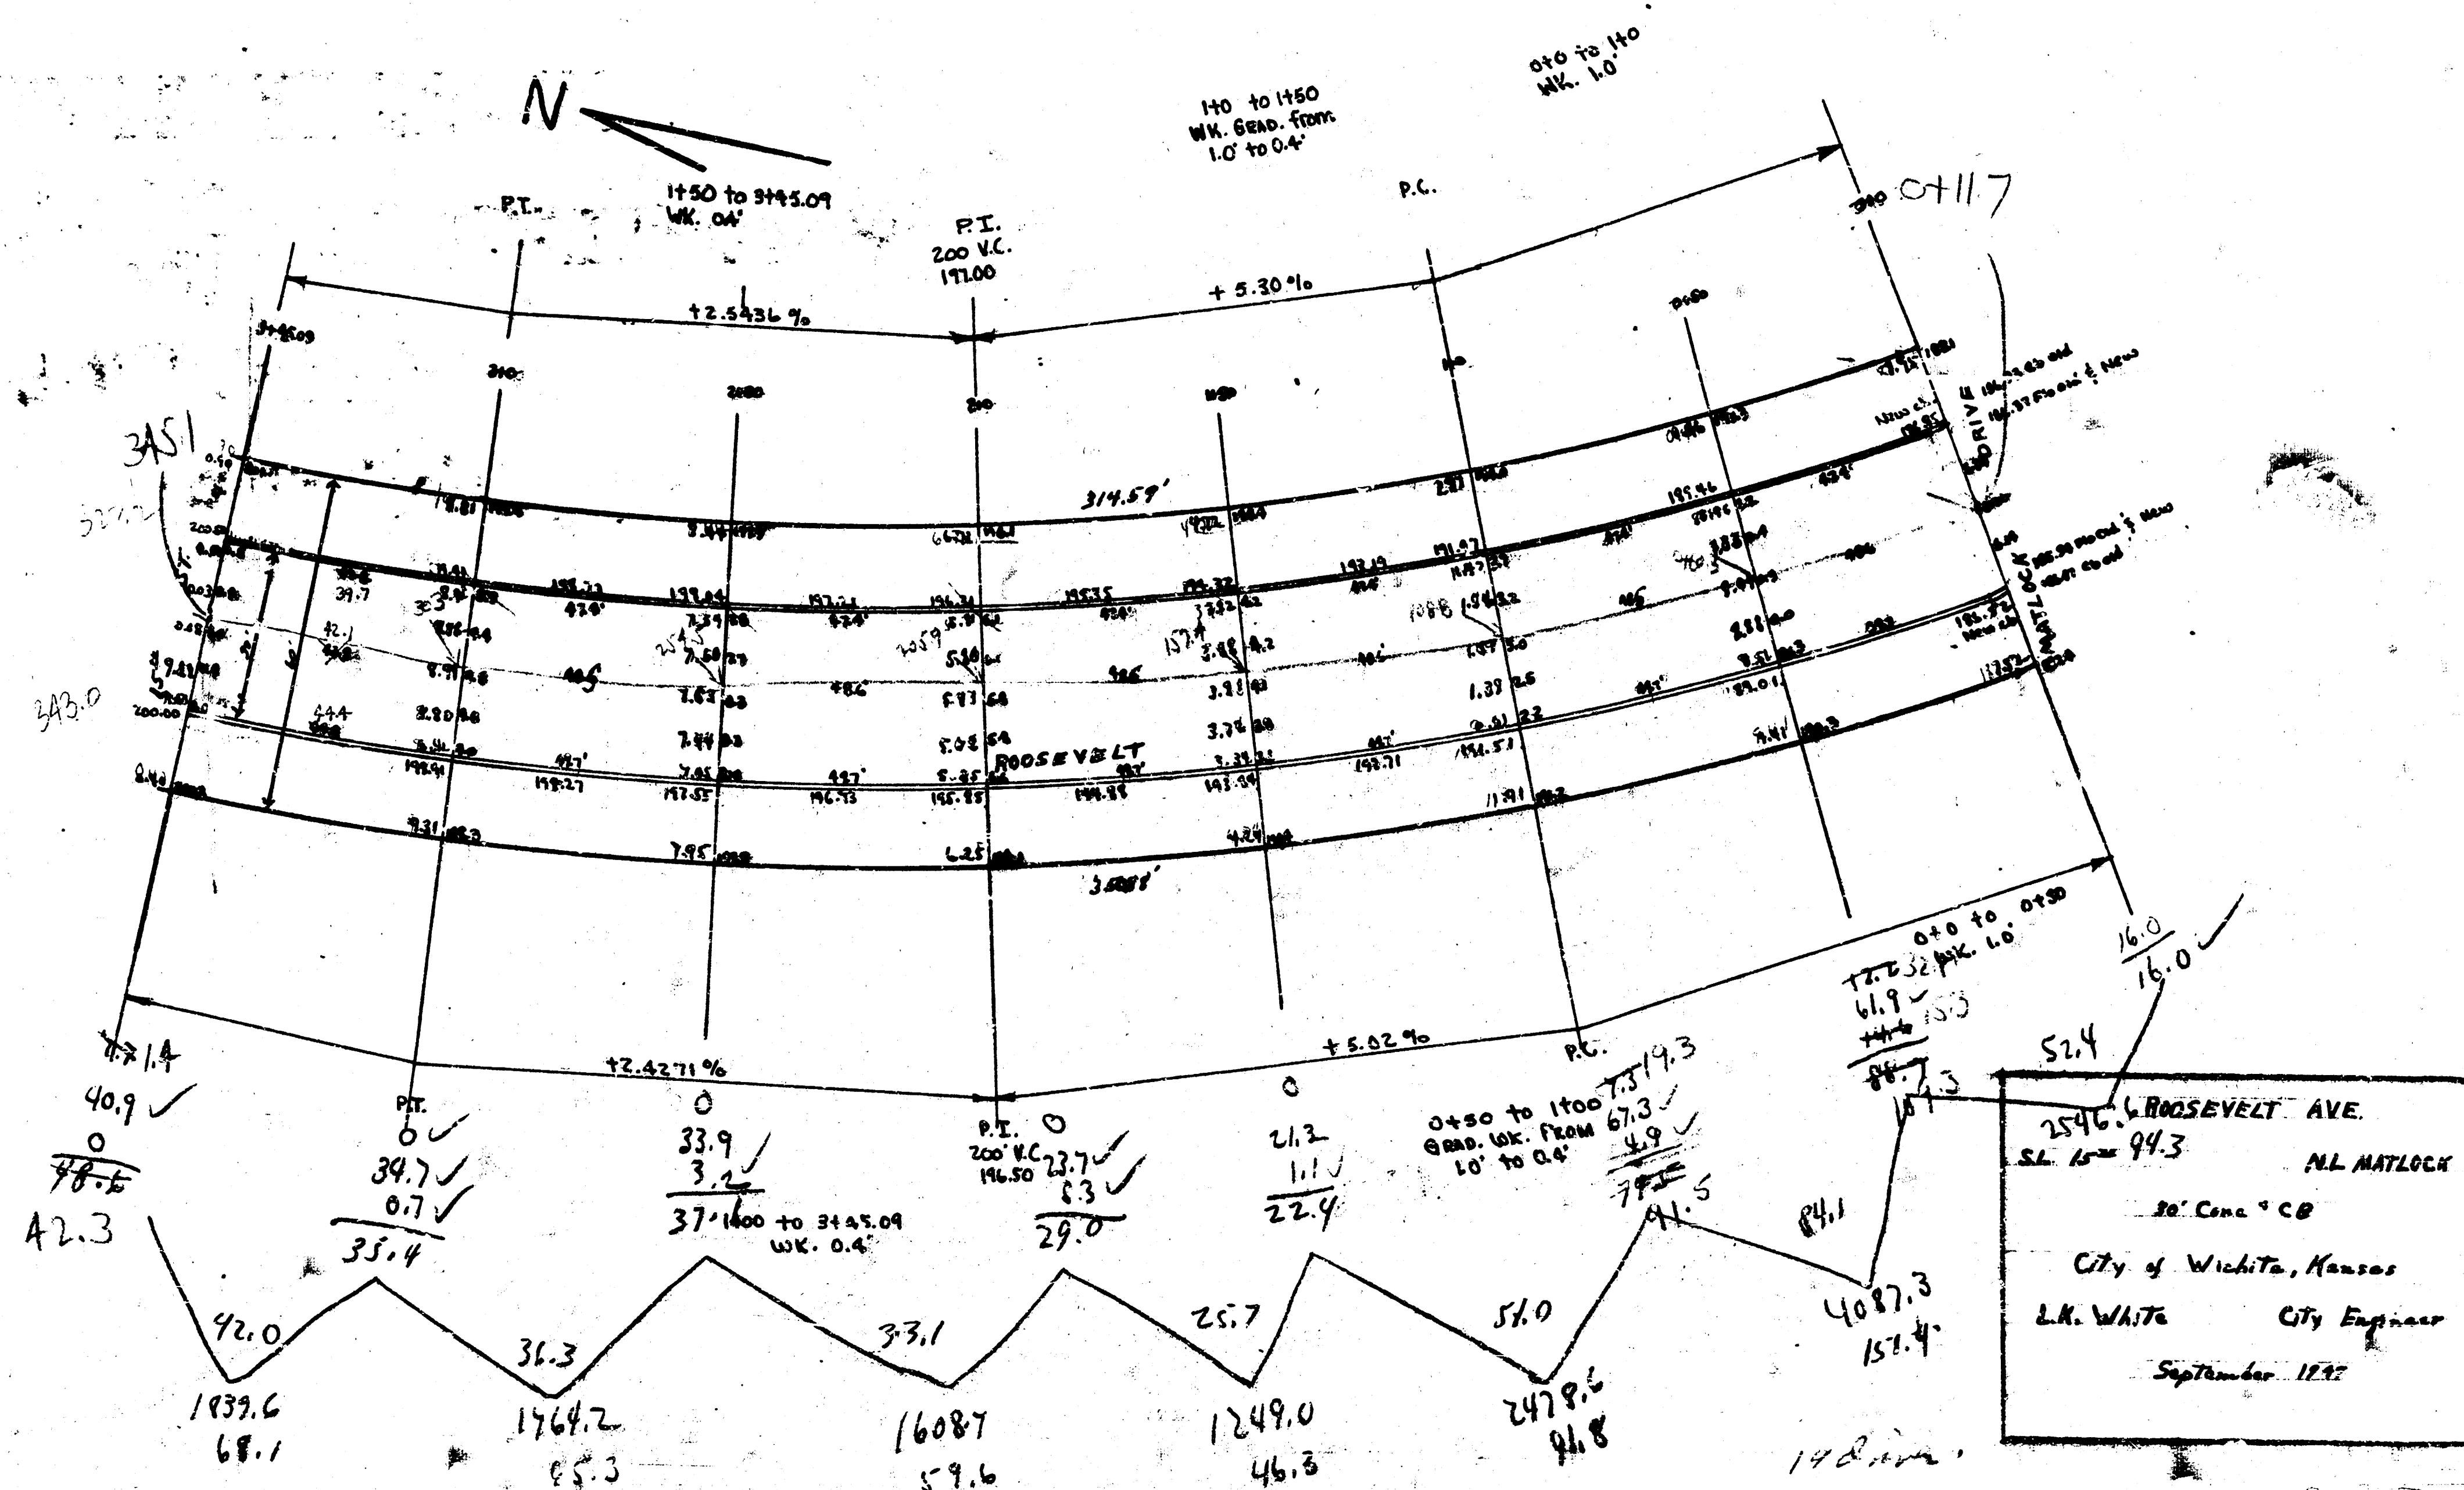

2247 412 1 5