Bench Mark:

Woodchuck & Central
City of Wichita Bench Mark.
52.00 ft. North of center line.
24.00 ft. West of center line.
Elevation = 154.05 (City Datum)

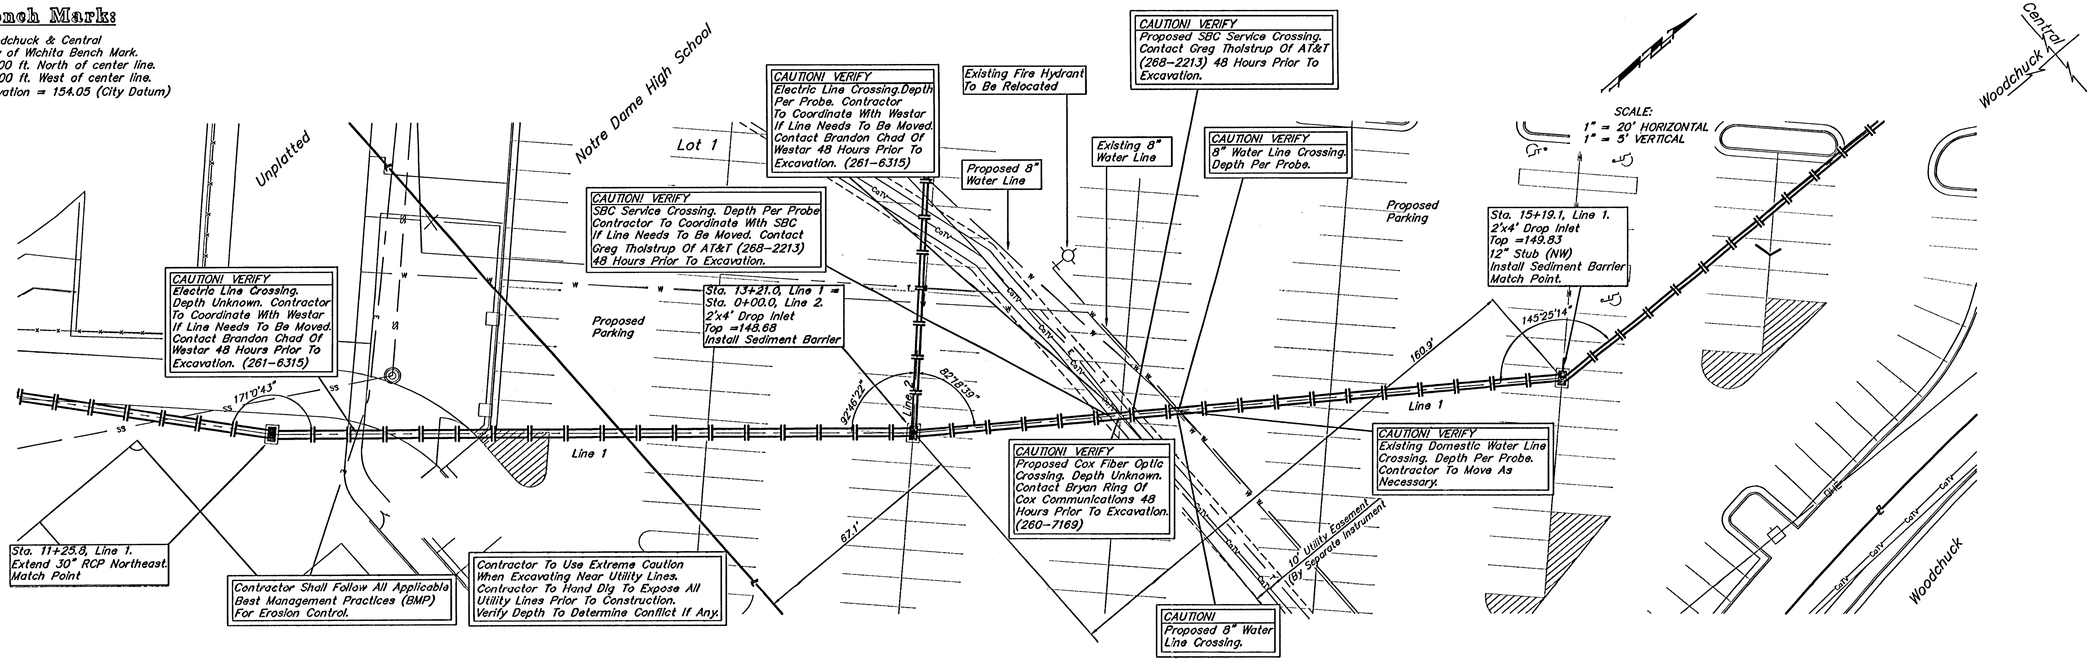

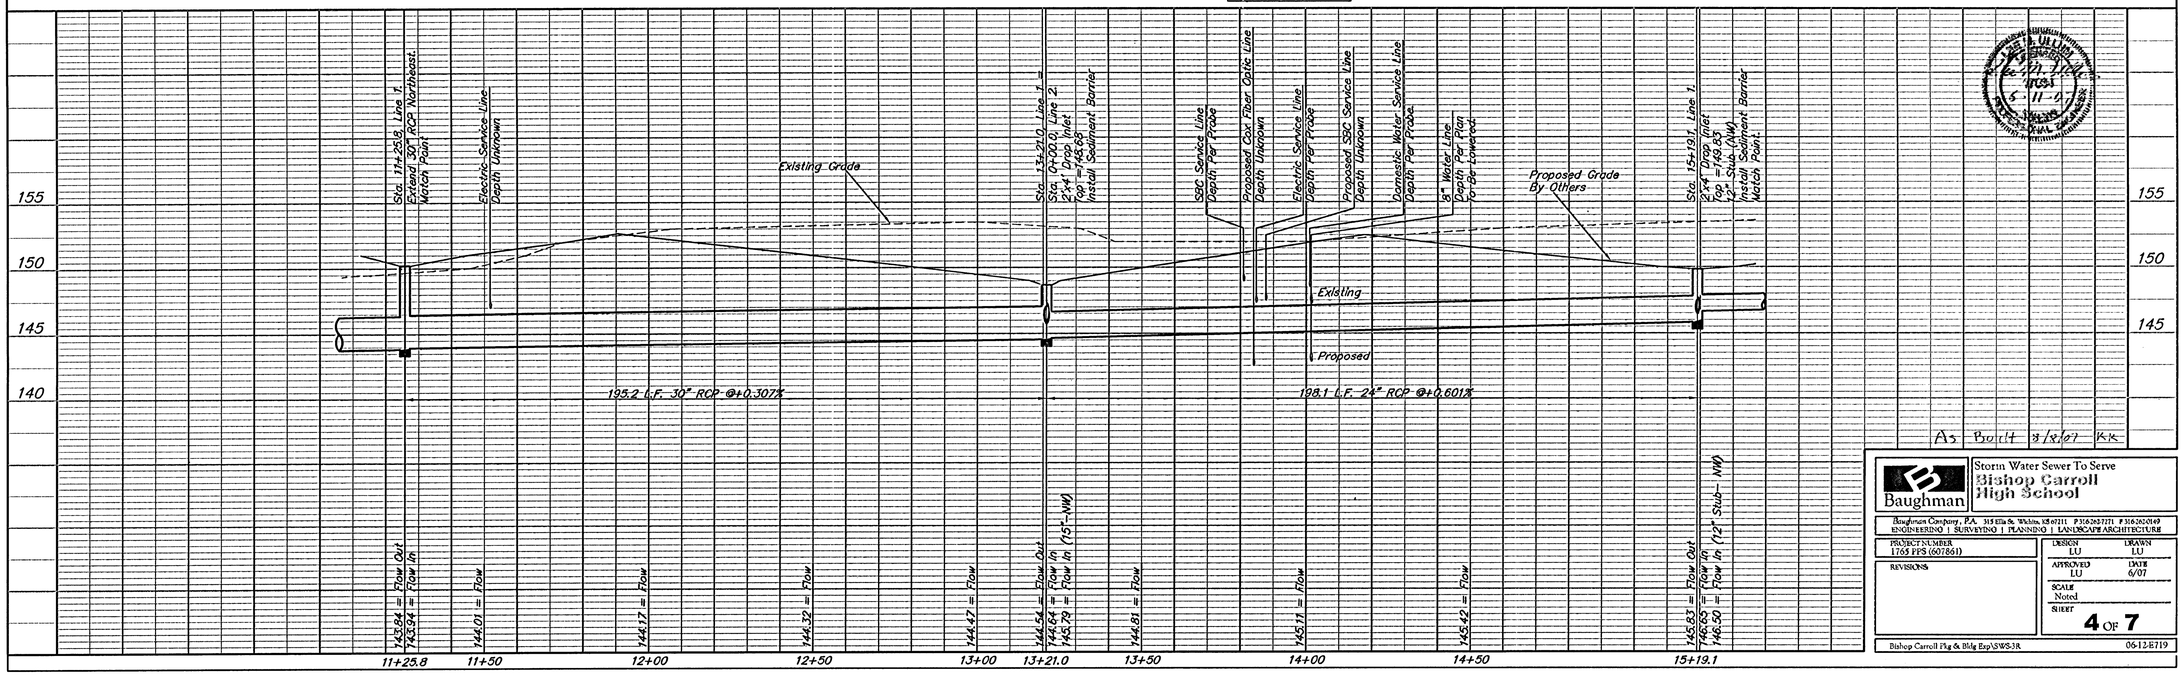

As Built 8/8/07 KK

Baughman

Storm Water Sewer To Serve
Bishop Carroll High School

Baughman Company, P.A. 315 Ella St. Wichita, KS 67211 P 316.262.7171 F 316.262.0149
ENGINEERING | SURVEYING | PLANNING | LANDSCAPE ARCHITECTURE

PROJECT NUMBER: 1765 FPS (607861)
DESIGN: LU
DRAWN: LU
APPROVED: LU
DATE: 6/07
REVISIONS
SCALE: Noted
SHEET: 4 OF 7

Bishop Carroll Plg & Bldg Exp\SWS-3R
06-12-E719