
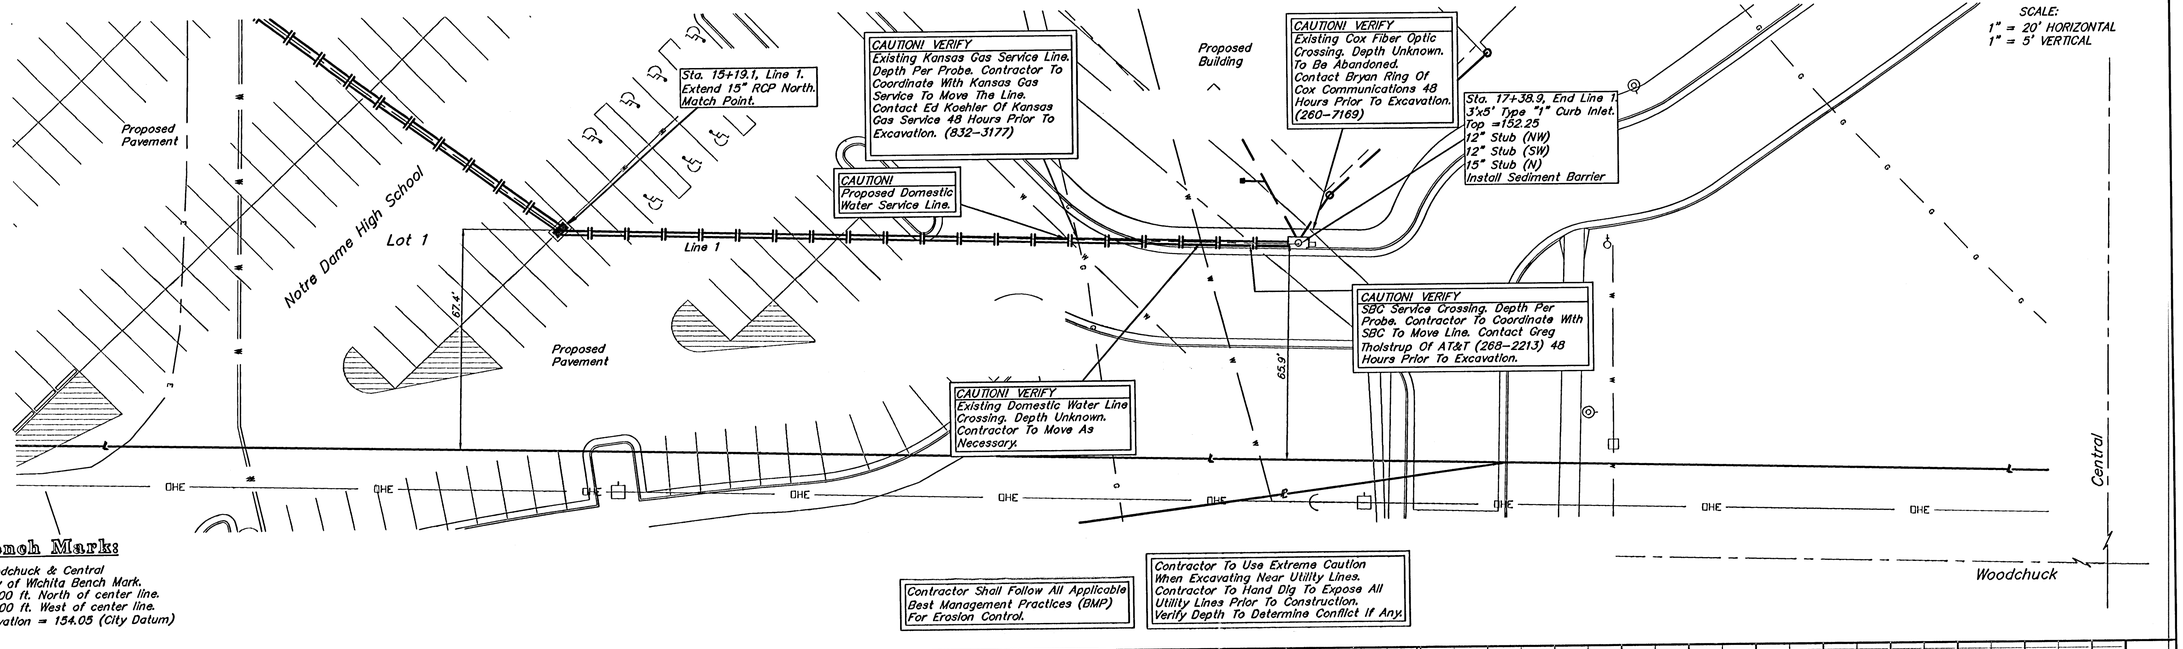


Bench Mark:

Woodchuck & Central
City of Wichita Bench Mark.
52.00 ft. North of center line.
24.00 ft. West of center line.
Elevation = 154.05 (City Datum)

Contractor Shall Follow All Applicable Best Management Practices (BMP) For Erosion Control.

Contractor To Use Extreme Caution When Excavating Near Utility Lines. Contractor To Hand Dig To Expose All Utility Lines Prior To Construction. Verify Depth To Determine Conflict If Any.

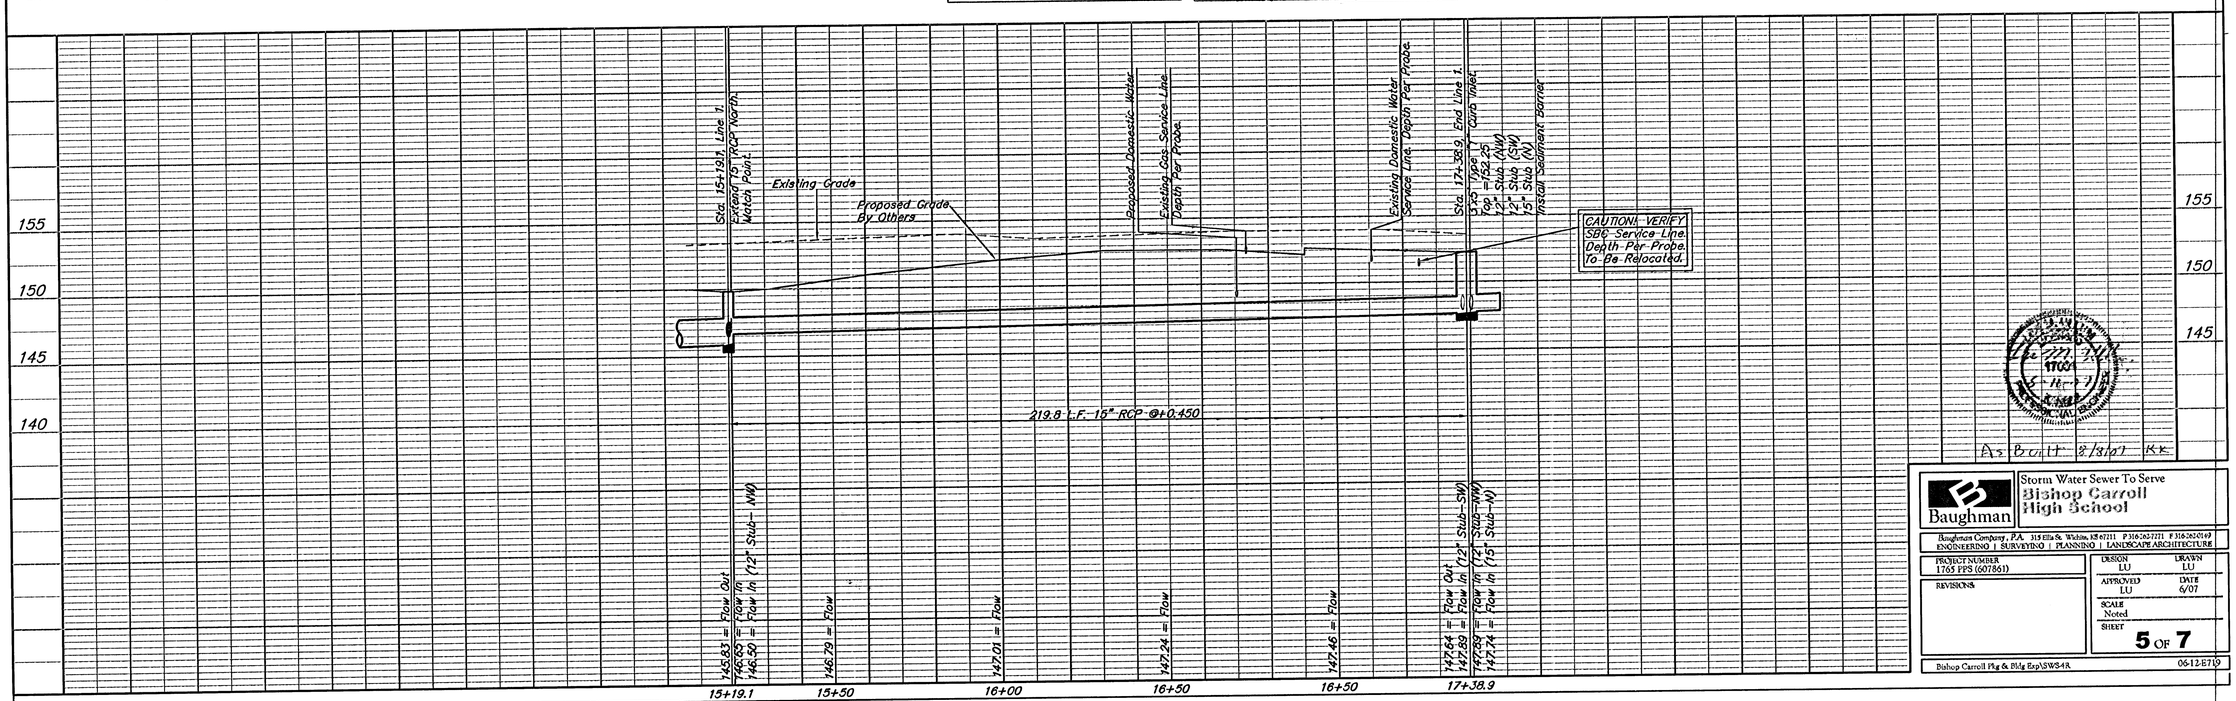

As Built 8/3/07 KK

Storm Water Sewer To Serve
Bishop Carroll High School

Baughman

Baughman Company, P.A. 315 Ella St. Wichita, KS 67211 P 316.262.7271 F 316.262.0149
ENGINEERING | SURVEYING | PLANNING | LANDSCAPE ARCHITECTURE

PROJECT NUMBER 1705 PPS (007851)	DESIGN LU / DRAWN LU
REVISIONS	APPROVED LU / DATE 6/07
	SCALE Noted
	SHEET 5 OF 7

Bishop Carroll Plg & Bldg Dep\SWS4R 06-12-E719