Bench Mark:

Woodchuck & Central
City of Wichita Bench Mark.
52.00 ft. North of center line.
24.00 ft. West of center line.
Elevation = 154.05 (City Datum)

CAUTION! VERIFY
Proposed SBC Service Crossing. Contact Greg Tholstrup Of AT&T (268-2213) 48 Hours Prior To Excavation.

CAUTION! VERIFY
Electric Line Crossing. Depth Per Probe. Contractor To Coordinate With Westar To Move Line As Necessary. Contact Brandon Chad Of Westar 48 Hours Prior To Excavation. (261-6315)

CAUTION! VERIFY
SBC Service Crossing. Depth Per Probe. Contractor To Coordinate With SBC To Move Line As Necessary. Contact Greg Tholstrup Of AT&T (268-2213) 48 Hours Prior To Excavation.

CAUTION!
Proposed Domestic Water Service Line Crossing.

CAUTION! Verify
Existing Cox Fiber Optic Line. Depth Unknown.

Sta. 0+00.0, Begin Line 2 = Sta. 13+21.0, Line 1. Extend 15" RCP Northwest.

Line 1

Line 2

Unplatted

Proposed Pavement

Proposed Pavement

CAUTION! VERIFY
Existing Domestic Water Line Crossing. Depth Per Probe. Contractor To Move As Necessary.

10' Utility Easement (By Separate Instrument)

CAUTION!
Proposed 8" Water Line Crossing. Depth Per Plan.


Lot 1

Proposed Building

Sta. 1+58.8, End Line 2
Construct 2'x2' Drop Inlet
Top = 152.8.
12" Stub (NW)
10" Stub (N)
6" Stub (SW)
Install Sediment Barrier.

CAUTION! VERIFY
Proposed Cox Fiber Optic Crossing. Depth Unknown. Contact Bryan Ring Of Cox Communications 48 Hours Prior To Excavation. (260-7169)

CAUTION! VERIFY
Proposed SBC Service Crossing. Contact Greg Tholstrup Of AT&T (268-2213) 48 Hours Prior To Excavation.

SCALE:
1" = 20' HORIZONTAL
1" = 5' VERTICAL

Woodchuck / Central

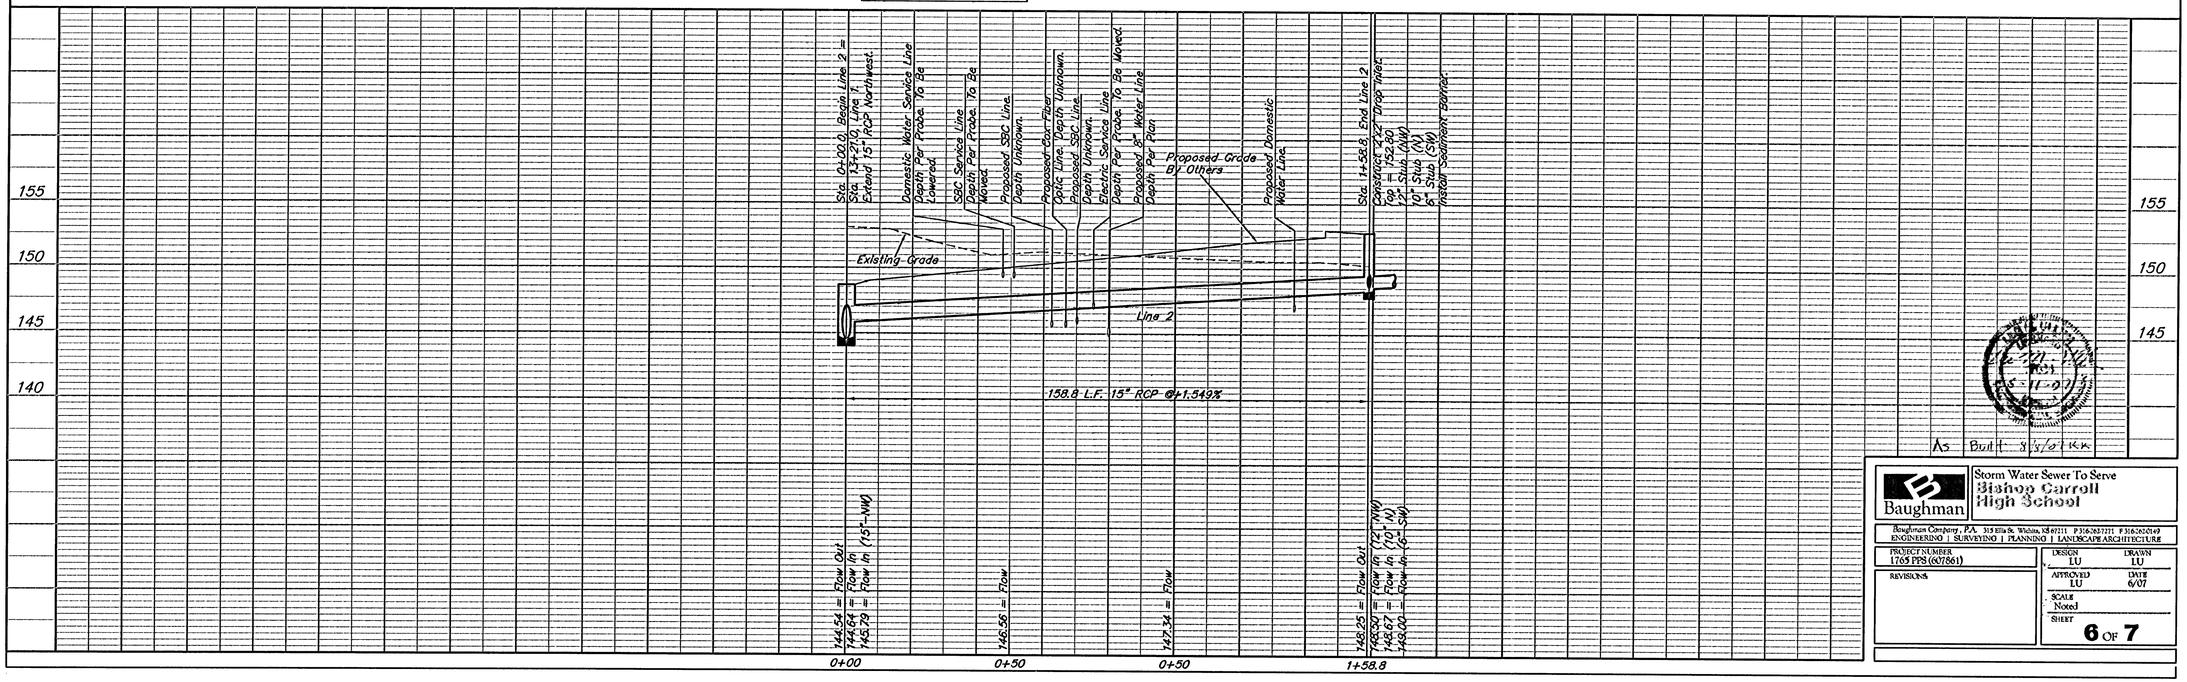

As Built 8/5/08 KK

Baughman

Storm Water Sewer To Serve
Bishop Carroll High School

Baughman Company, P.A. 315 Ellis St. Wichita, KS 67211 P 316.267.7771 F 316.267.0949
ENGINEERING | SURVEYING | PLANNING | LANDSCAPE ARCHITECTURE

REVISIONS
DESIGN LU
DRAWN LU
APPROVED LU
DATE 6/07
SCALE Noted
SHEET 6 OF 7