
Book = 43Y

BM 200.84 'X' TOP CR. W.S. PERSHING SL 13TH

~~TP = 205.68 S.E. TERR. 14TH AND TERRACE DRIVE~~ — ?

NOTE: STA. ON ℄ FROM STA. 0+00 TO 5+91.12

	EXC.
	211.5
	175.7
	110.7
	81.5
	120.4
	96.0
	62.2
	63.3
	116.7
	138.3
	165.7
	147.4
	116.7
	1563.8
+10%	156.4
total	1720.2 cu. Yds.

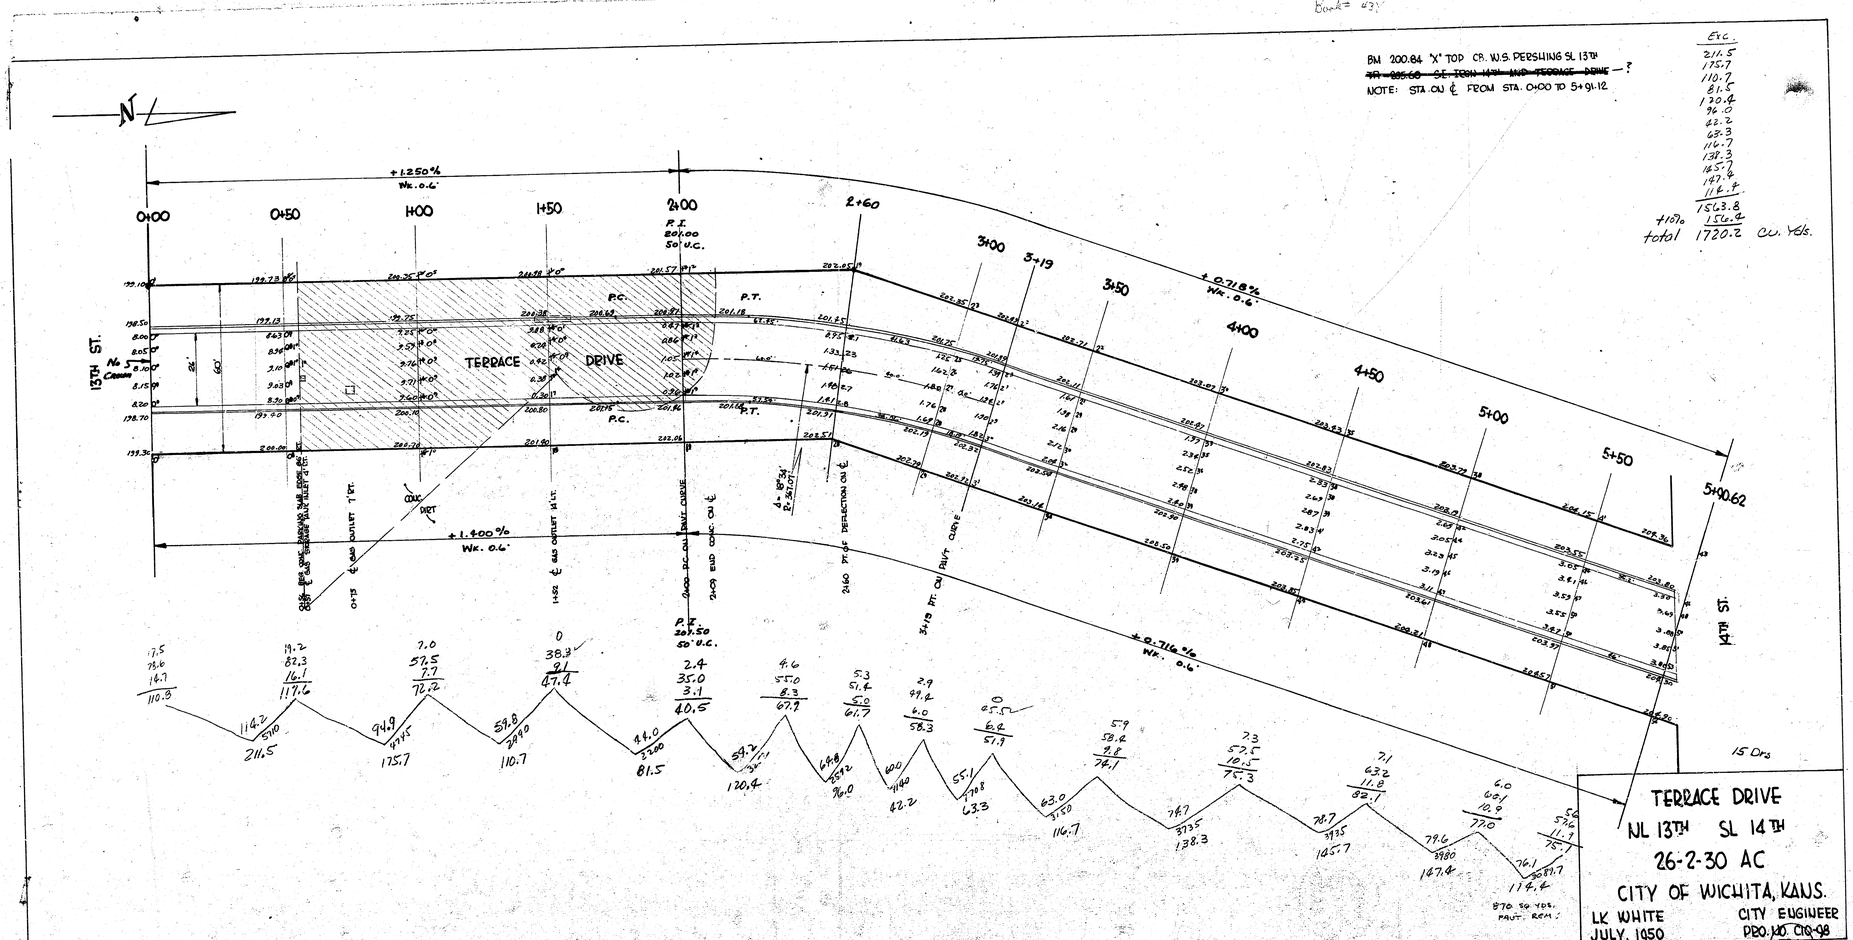


4 2 4 (51)

Bk # H-2 X Sections after Fill
Bk # 43-4 X Sections before filling

B.M. 206.63 "M" in Mueller Fire Hydrant S.E. cor. 14th & Pershing.

FIELD ENGR
1.-Section shall be taken after exc of Loose Fill

N

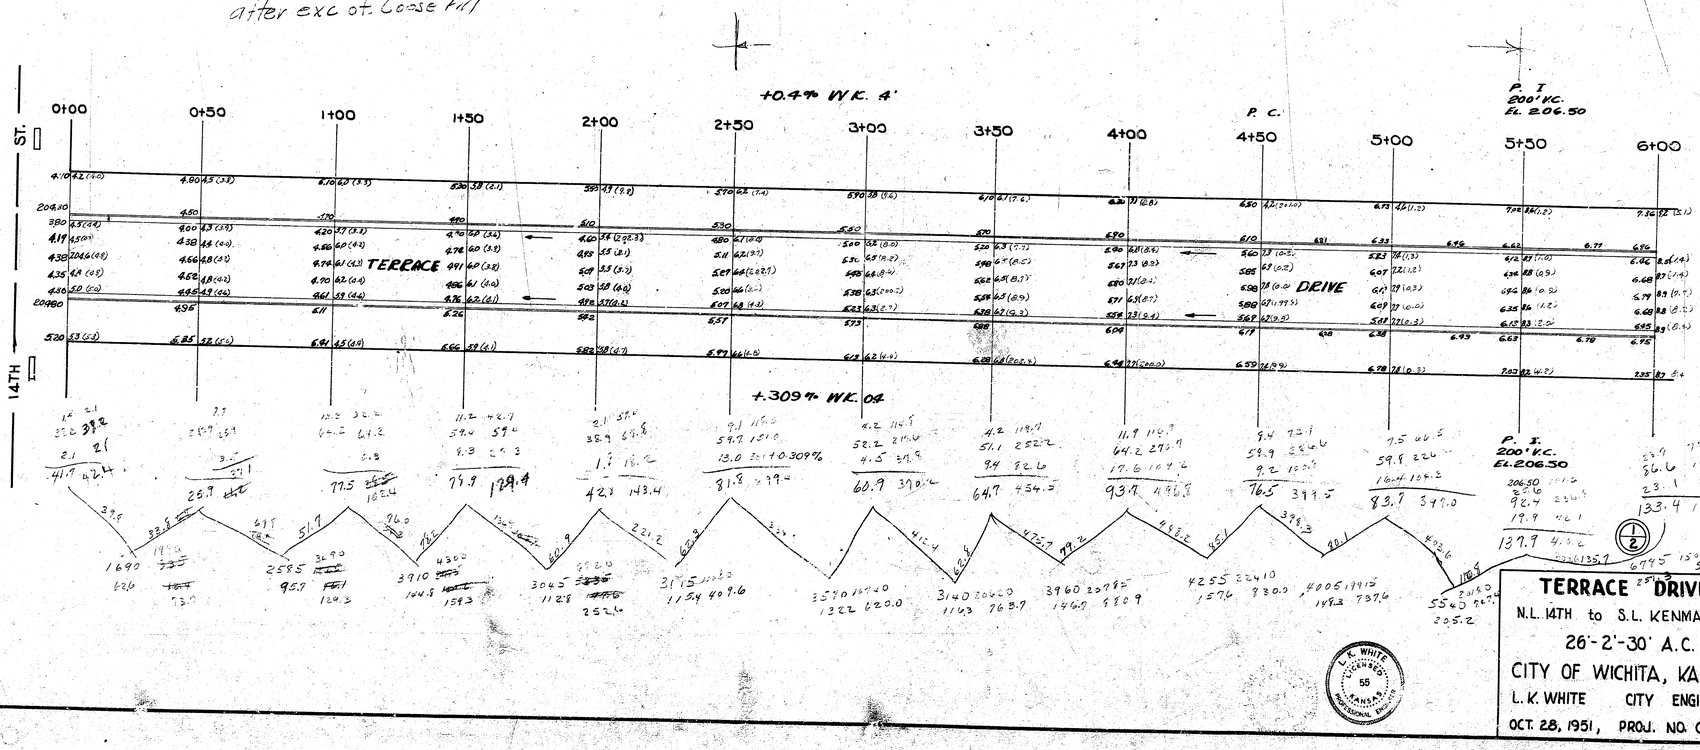

L. K. WHITE LICENSED 55 KANSAS PROFESSIONAL ENGINEER

TERRACE DRIVE

N.L. 14TH to S.L. KENMAR DR.

26'-2'-30' A.C.

CITY OF WICHITA, KANSAS

L. K. WHITE CITY ENGINEER


OCT. 28, 1951, PROJ. NO. CII-260

Bk # H-2

B.M. 215.67 S.E. cor. conc. Porch No. 1651 Kenmar

NOTE: Stationing on 9.2° offset E. P. L. E.C. 1290.7 C.y.d. sta 9+00 to 10+91.60

N

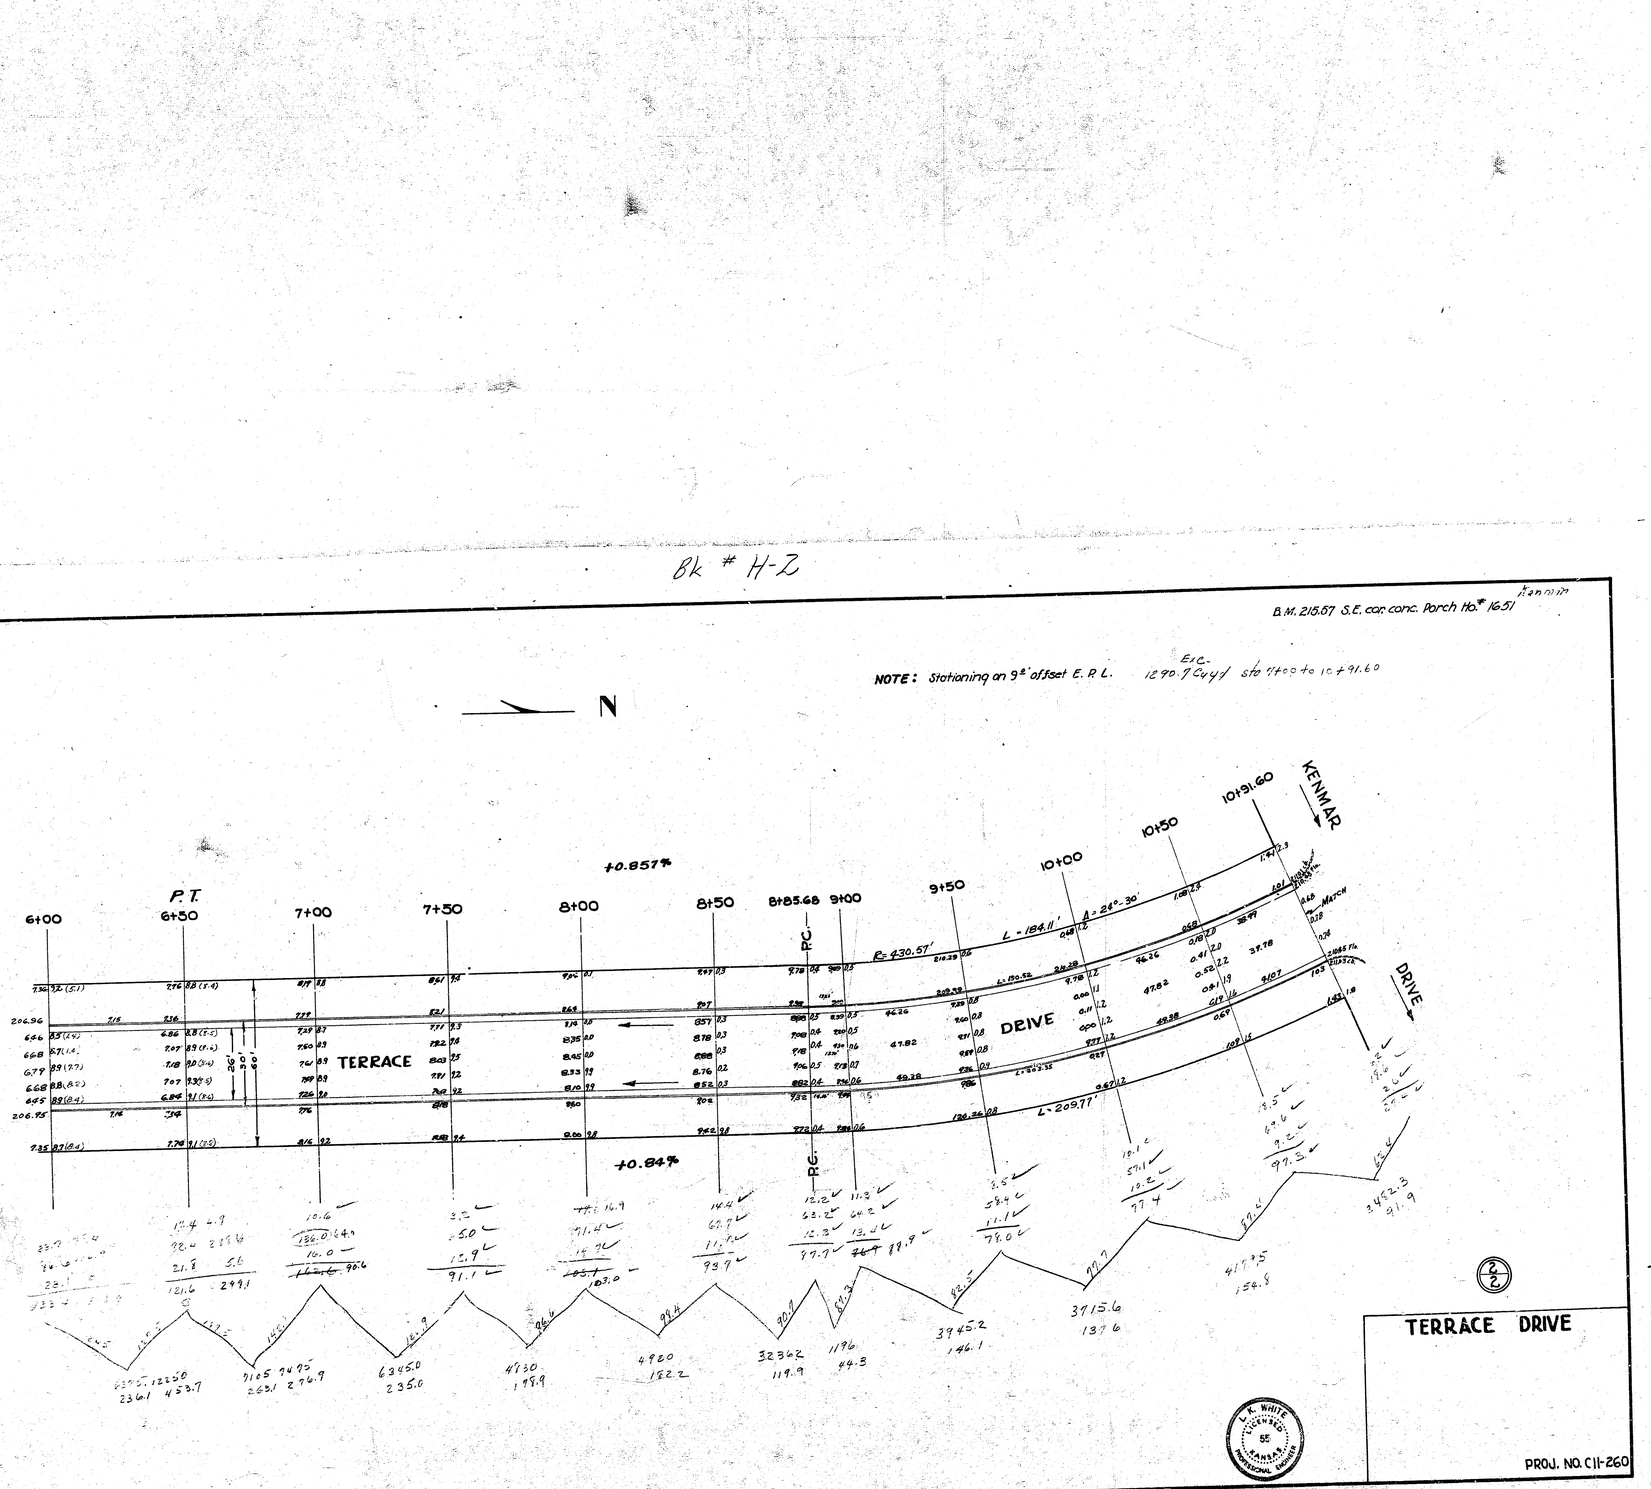

TERRACE DRIVE

PROJ. NO. C11-260

E. WHITE LICENSED KANSAS PROFESSIONAL ENGINEER 55

A 2 A