


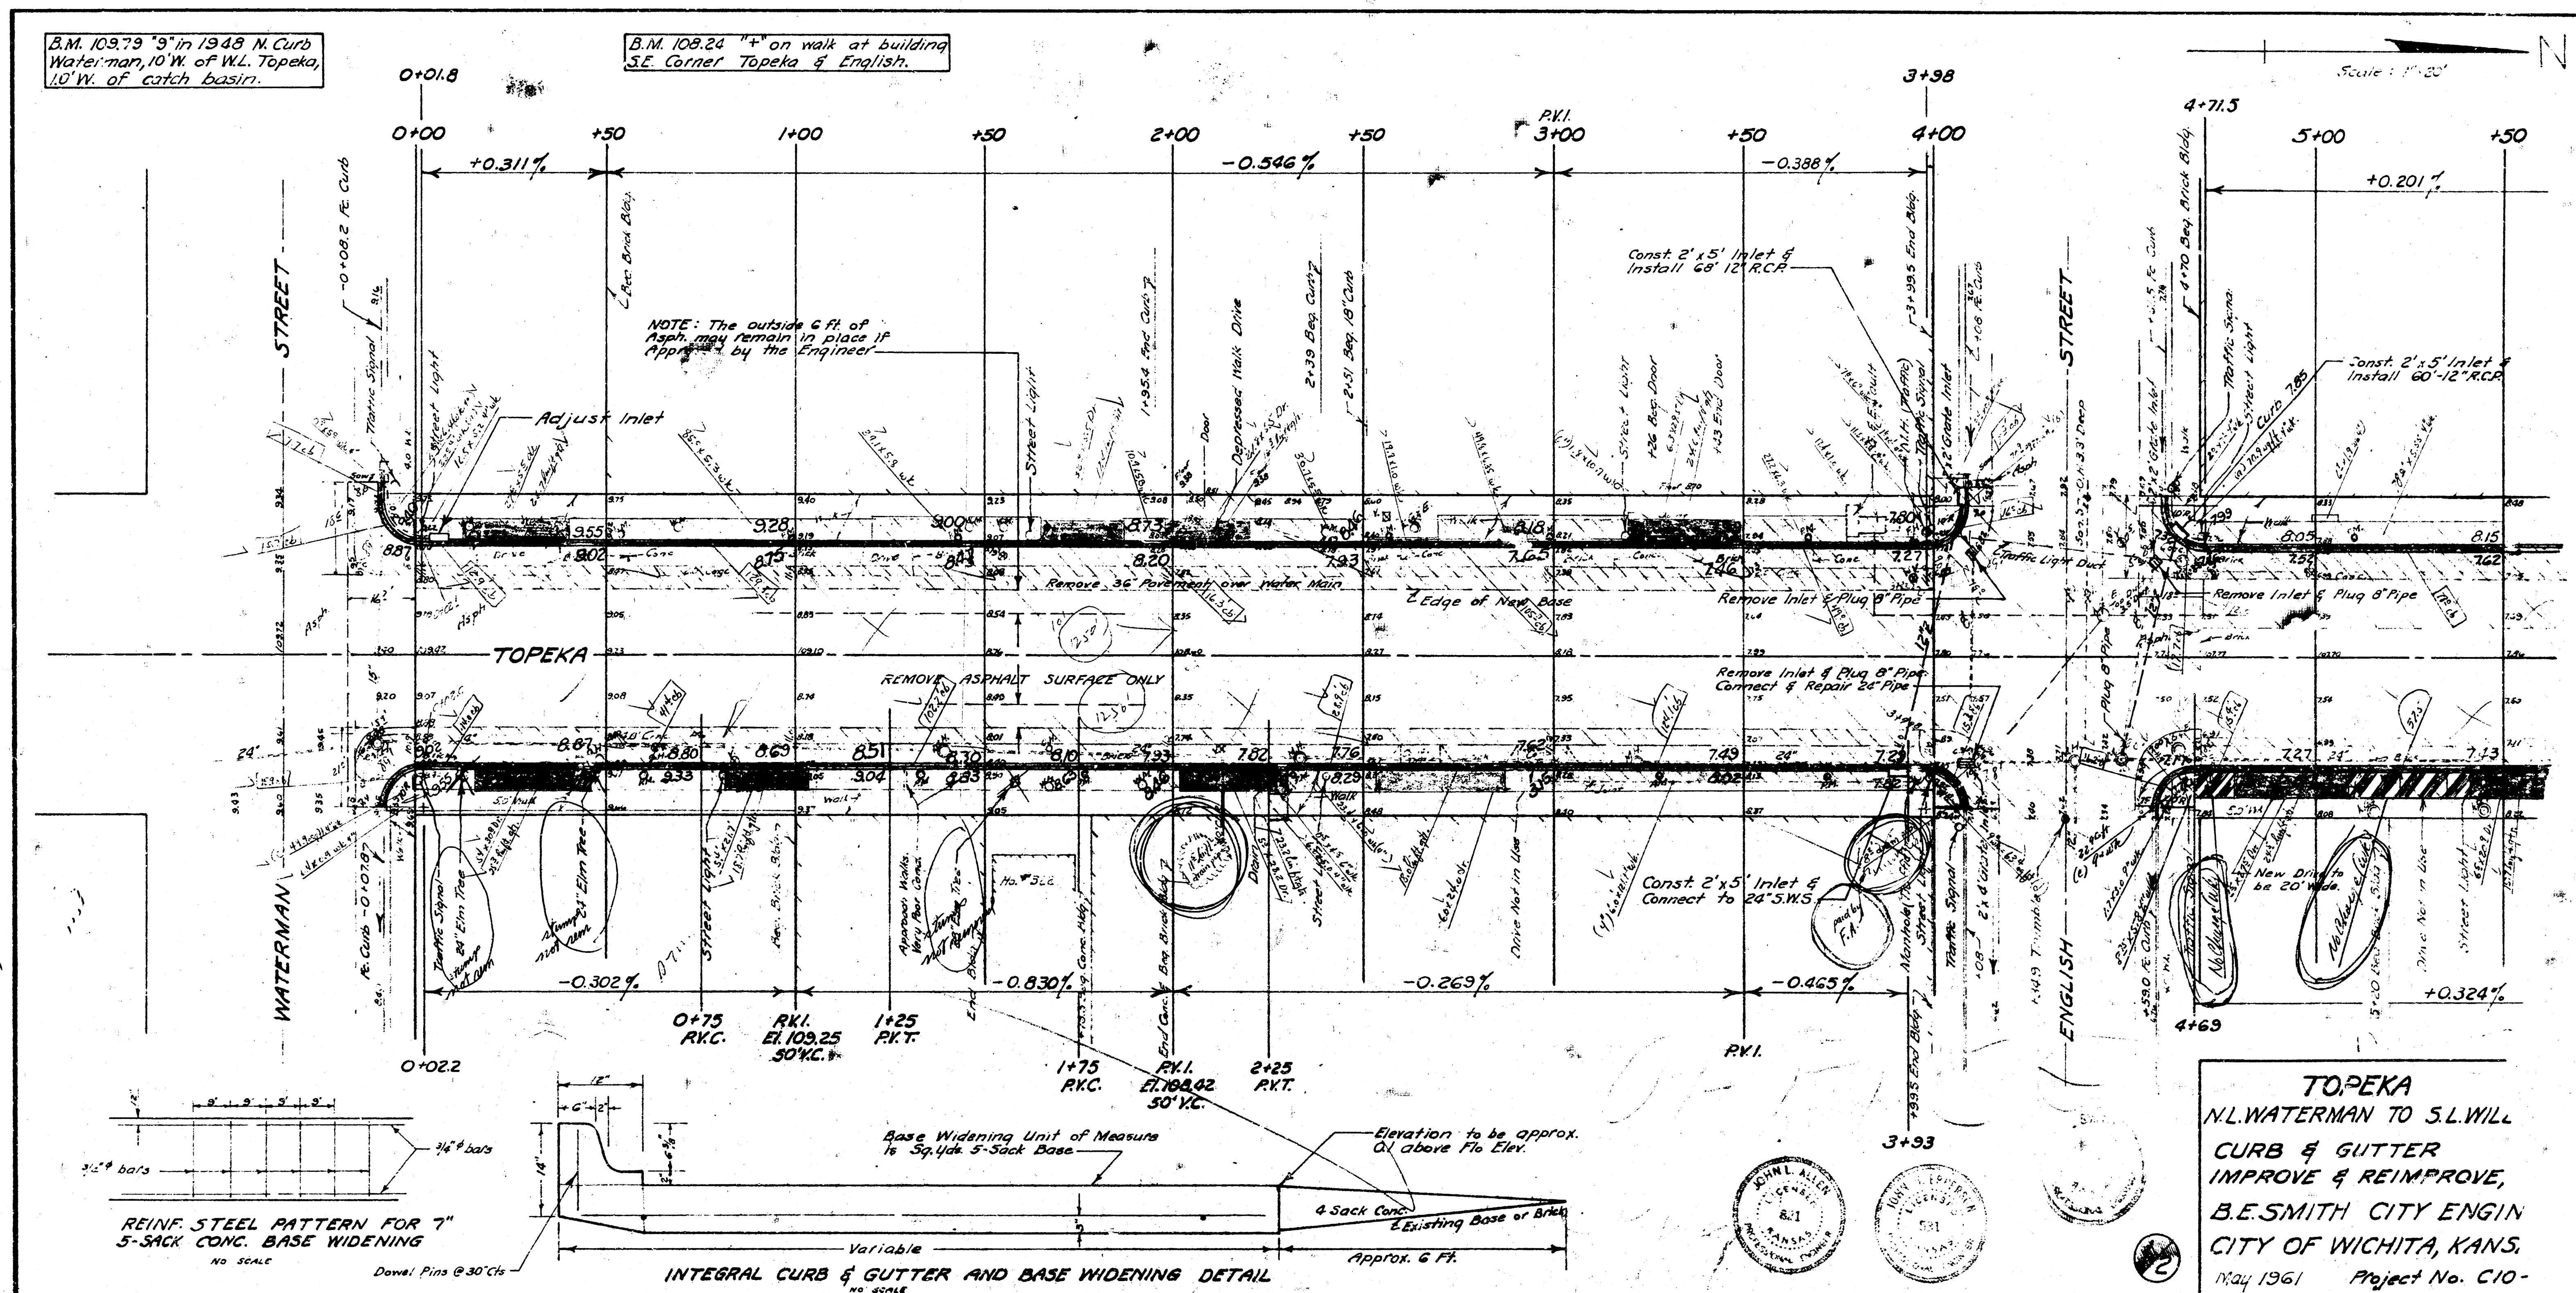

B.M. 108.75 "B" on S.L. William
40' W. of E.L. Topeka.

