


LEGACY PARK WILSON ESTATES 2ND ADDITION



CAUTION!!
UTIL. CROSSING

NOTE:
CONTRACTOR TO VERIFY SIZE AND DEPTH OF THE EXISTING UTILITIES PRIOR TO CONSTRUCTION.

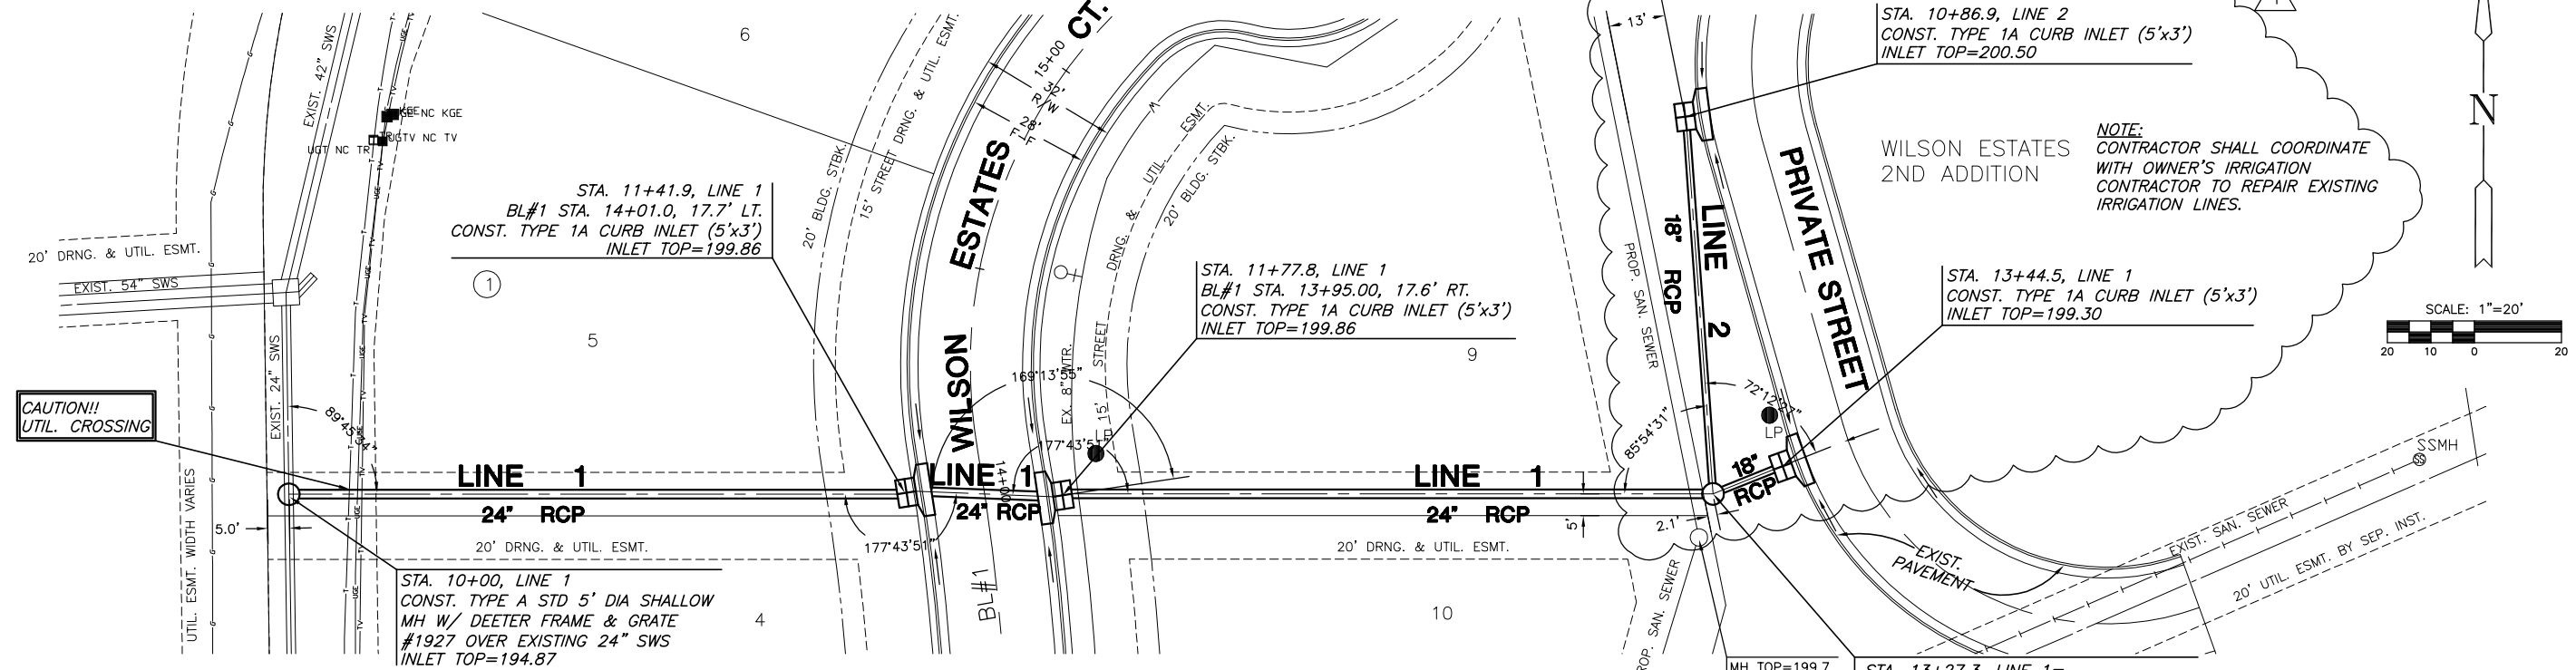


LEGACY PARK WILSON ESTATES 2ND ADDITION

PLAN LINE 1

PLAN LINE 2

PROFILE LINE 1

PROFILE LINE 2

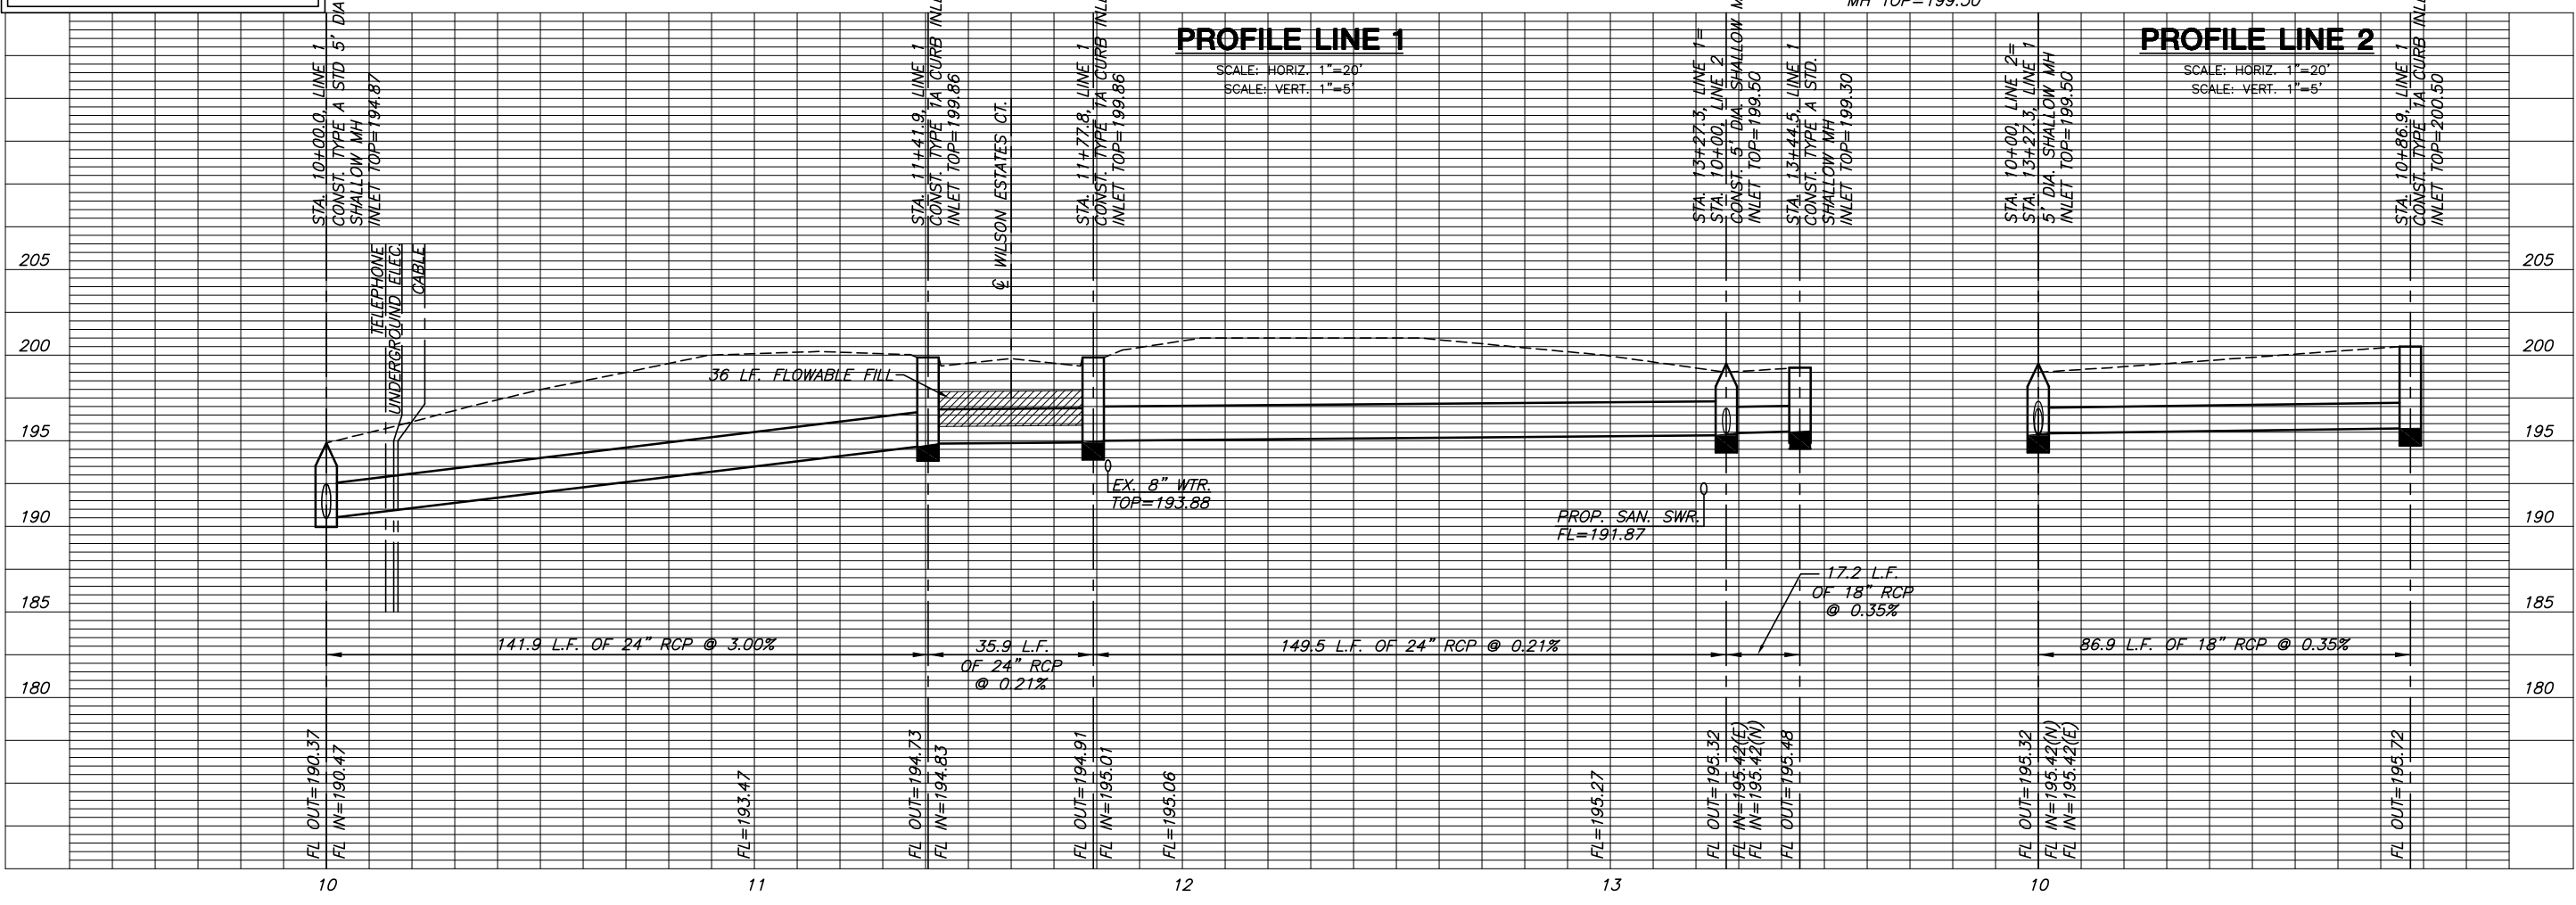

PUBLIC IMPROVEMENT PLANS FOR
LEGACY PARK
WILSON ESTATES 3RD ADD.
WICHITA, KANSAS

SWS
LINE 1
SHEET TITLE
PROJECT NUMBER
05753

DESIGN BY
SRS
DRAWN BY
KWS
CHECKED BY
GJA

ISSUED
JUNE 2006
REVISED
7/27/06
COW COMMENTS

SHEET NO.
10 of 25