


S.M. 13260 60 SPIKE N.S. RR 55.37TH 75' W. OF WOODROW No.




BASE LINE - E. 1/2 WOODROW AVENUE

STATION	ARC	CHORD LENGTH	CHORD BEARING	DEFLECTION	TOTAL DEFLECTION

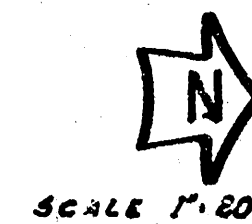

SCALE 1"=20'

FIELD ENGINEER & CONTRACTOR - GRADE, PAVING & CLEAR
 PROPOSED SIDEWALK, COMPACT FILL IN SIDEWALK AREA.
 ALL CONSTRUCTION BY "OTHERS"

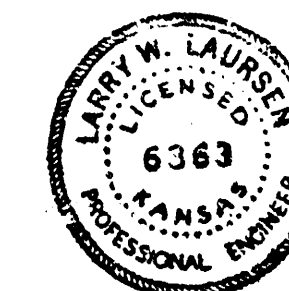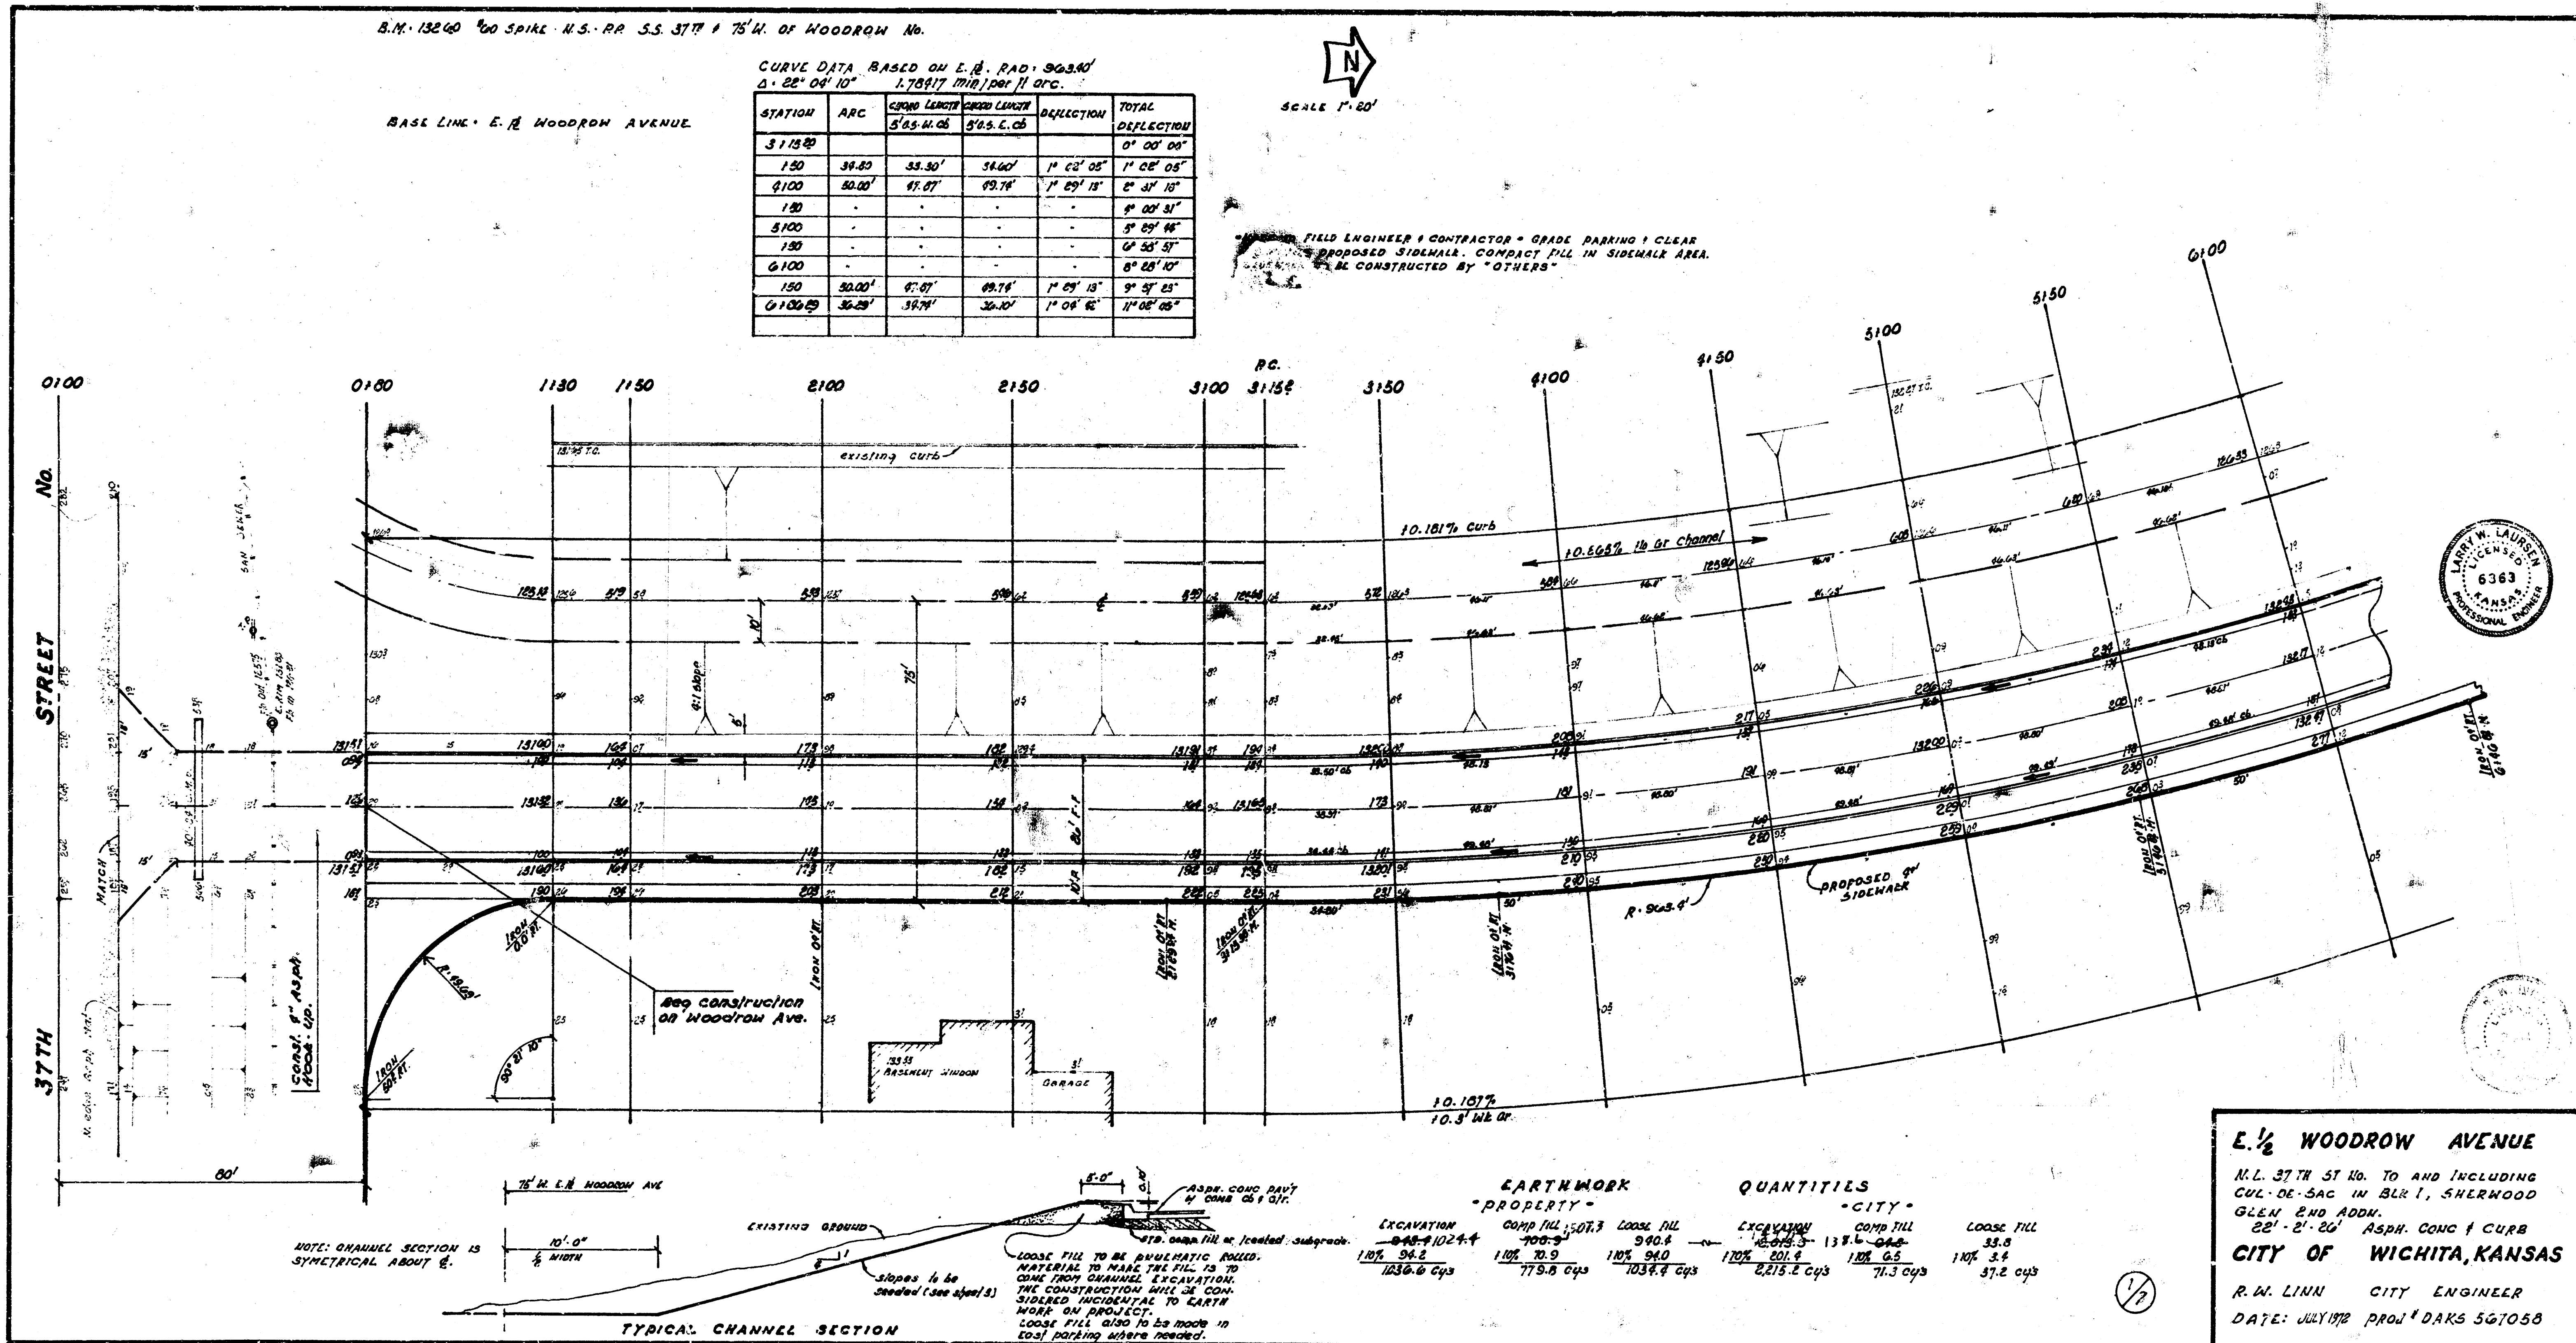

E. 1/2 WOODROW AVENUE
 M.L. 37TH ST. TO AND INCLUDING
 CUL-DE-SAC IN BLK 1, SHERWOOD
 GLEN END ADDN.
 22' - 2' - 26" ASPH. CONC. & CURB
CITY OF WICHITA, KANSAS
 R. W. LINN CITY ENGINEER

EARTHWORK

PROPERTY


EXCAVATION	COMP. FILL	LOOSE FILL	EXCAVATION	COMP. FILL	LOOSE FILL


QUANTITIES

CITY


EXCAVATION	COMP. FILL	LOOSE FILL	EXCAVATION	COMP. FILL	LOOSE FILL



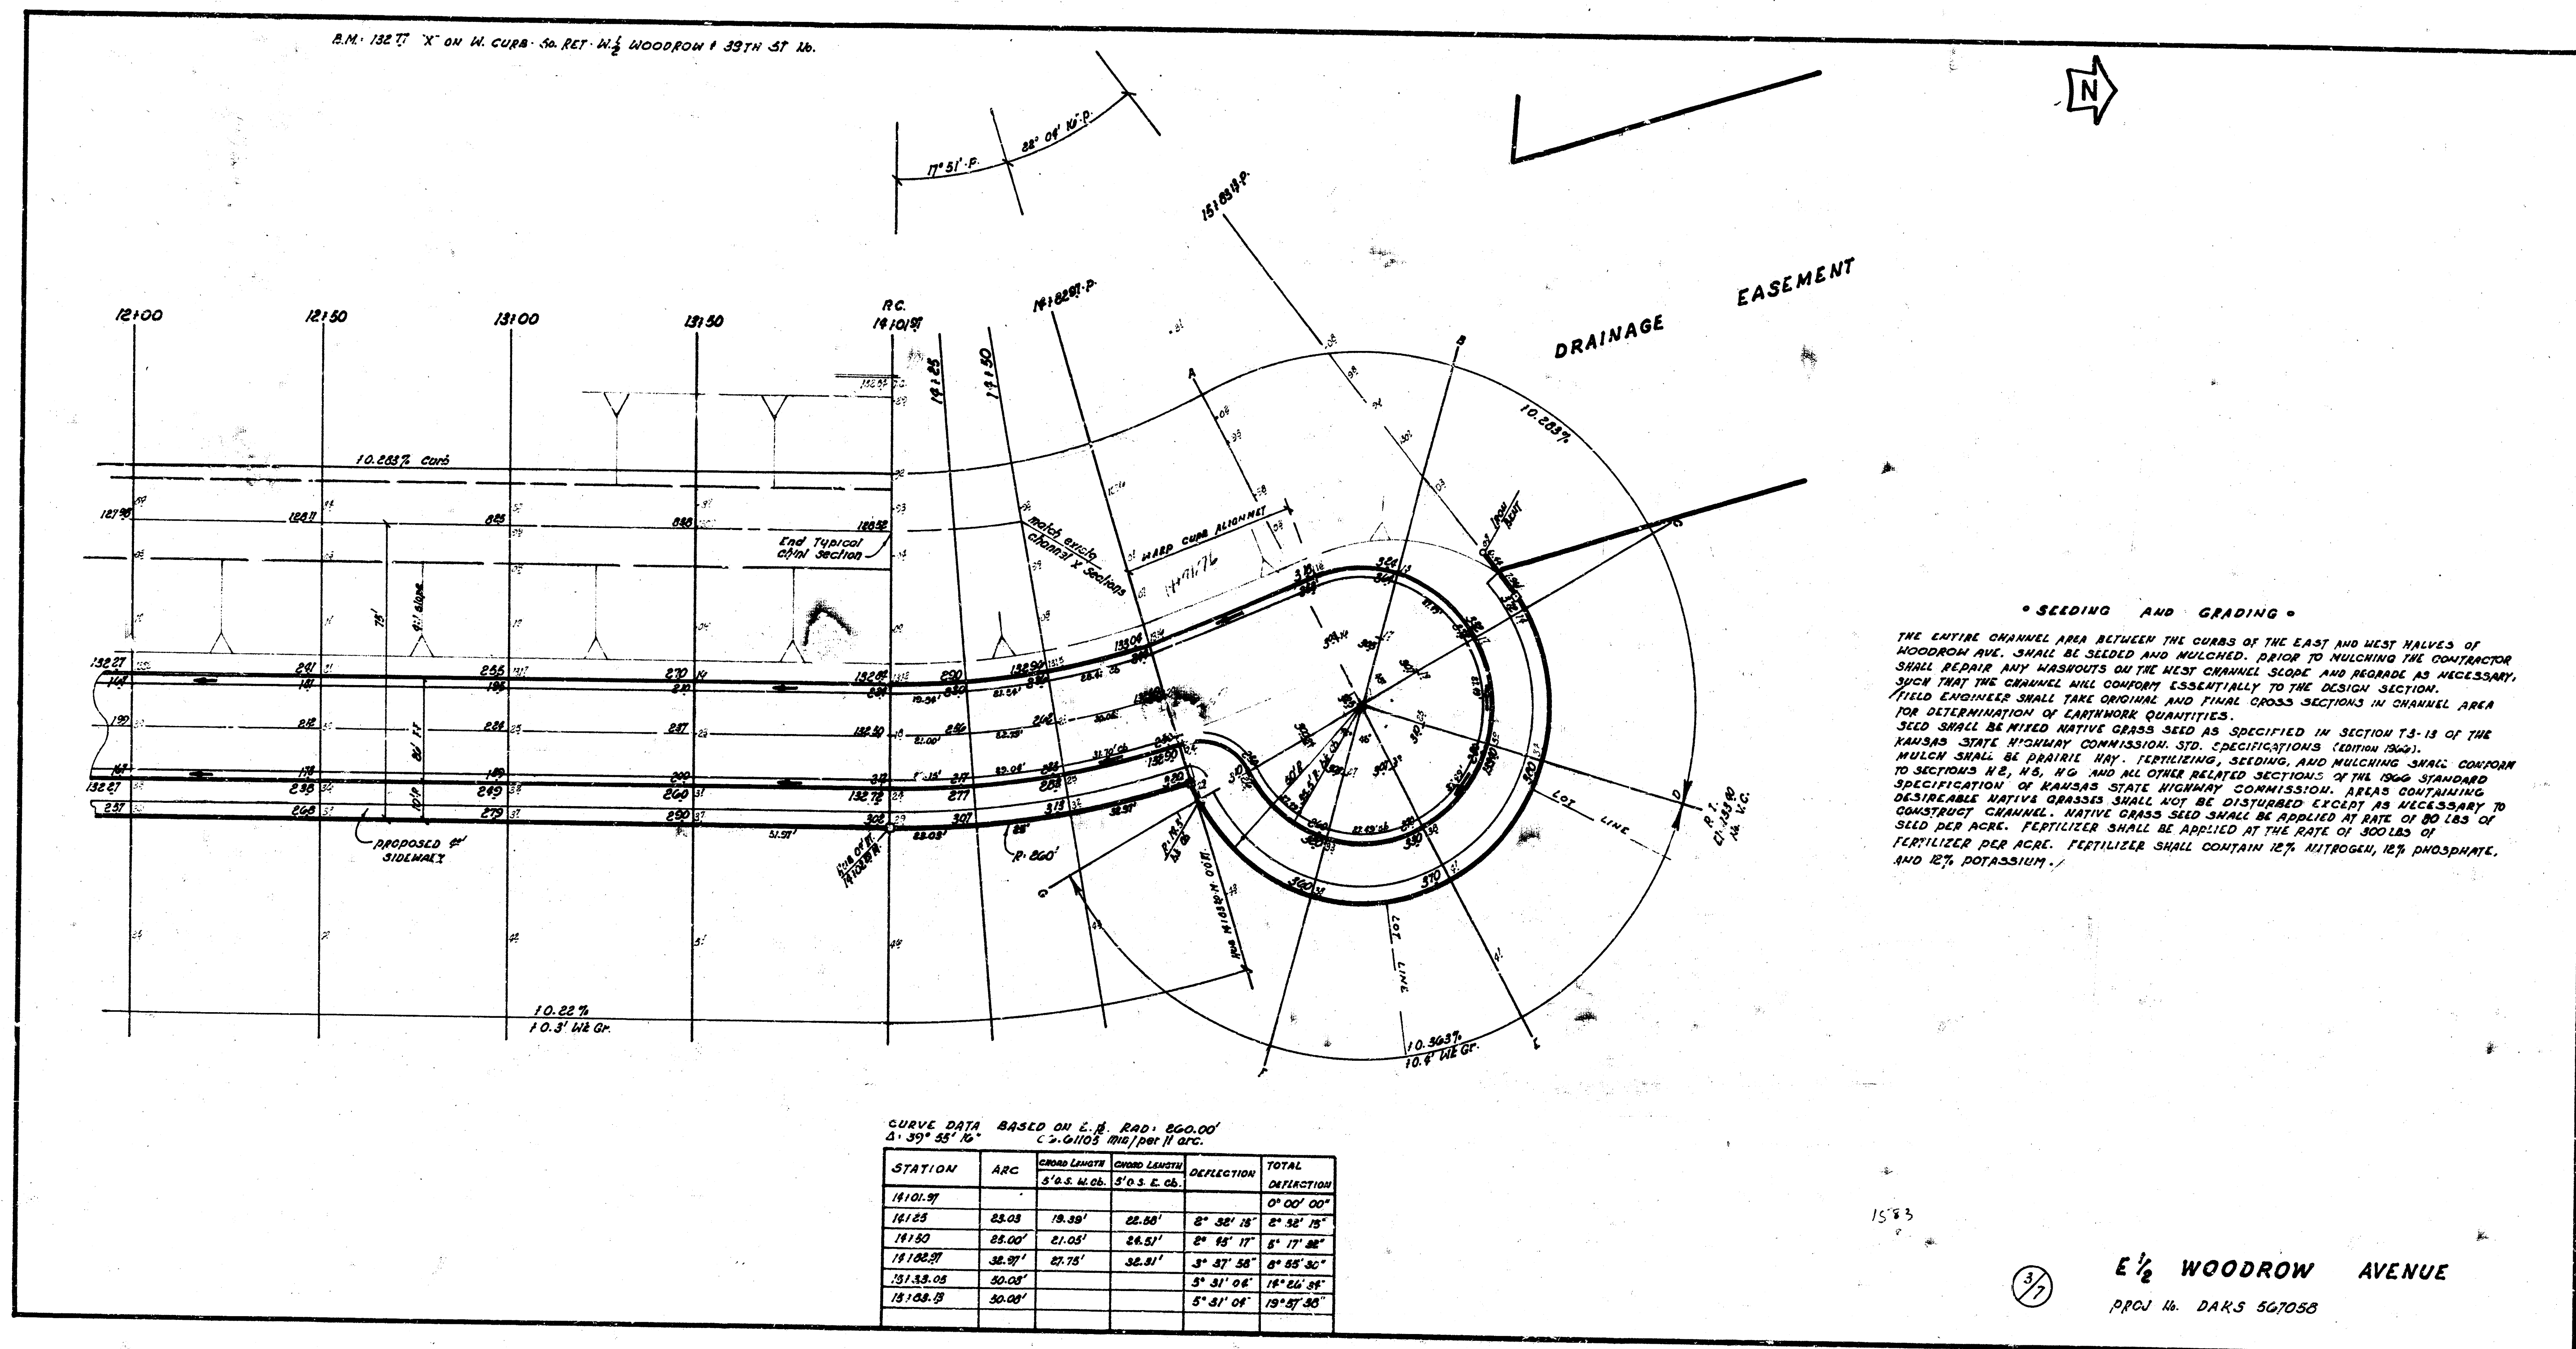

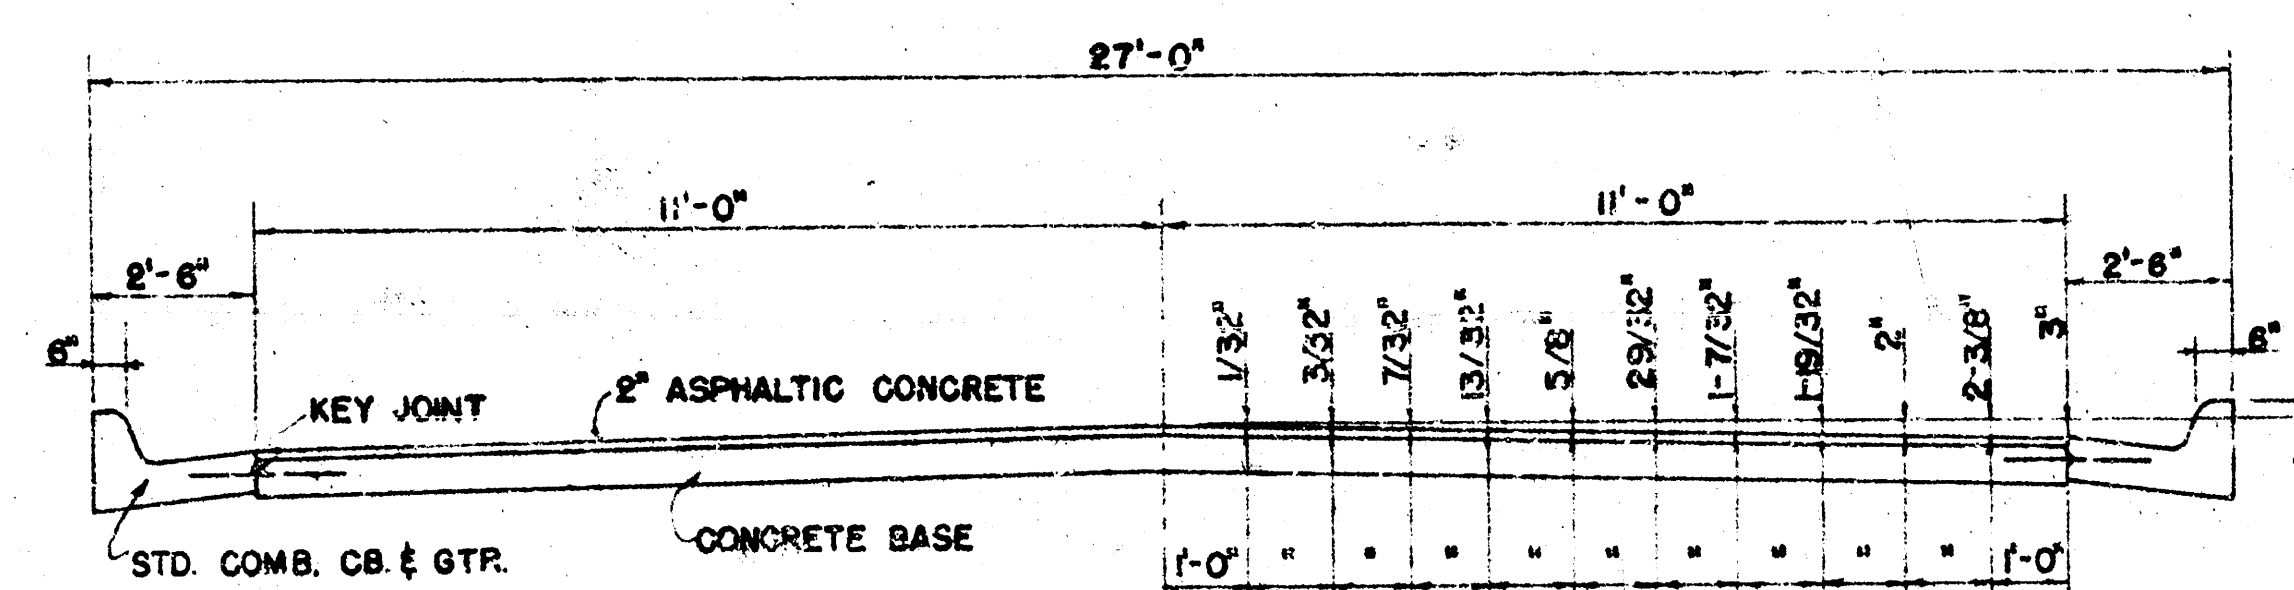

TYPICAL SECTION

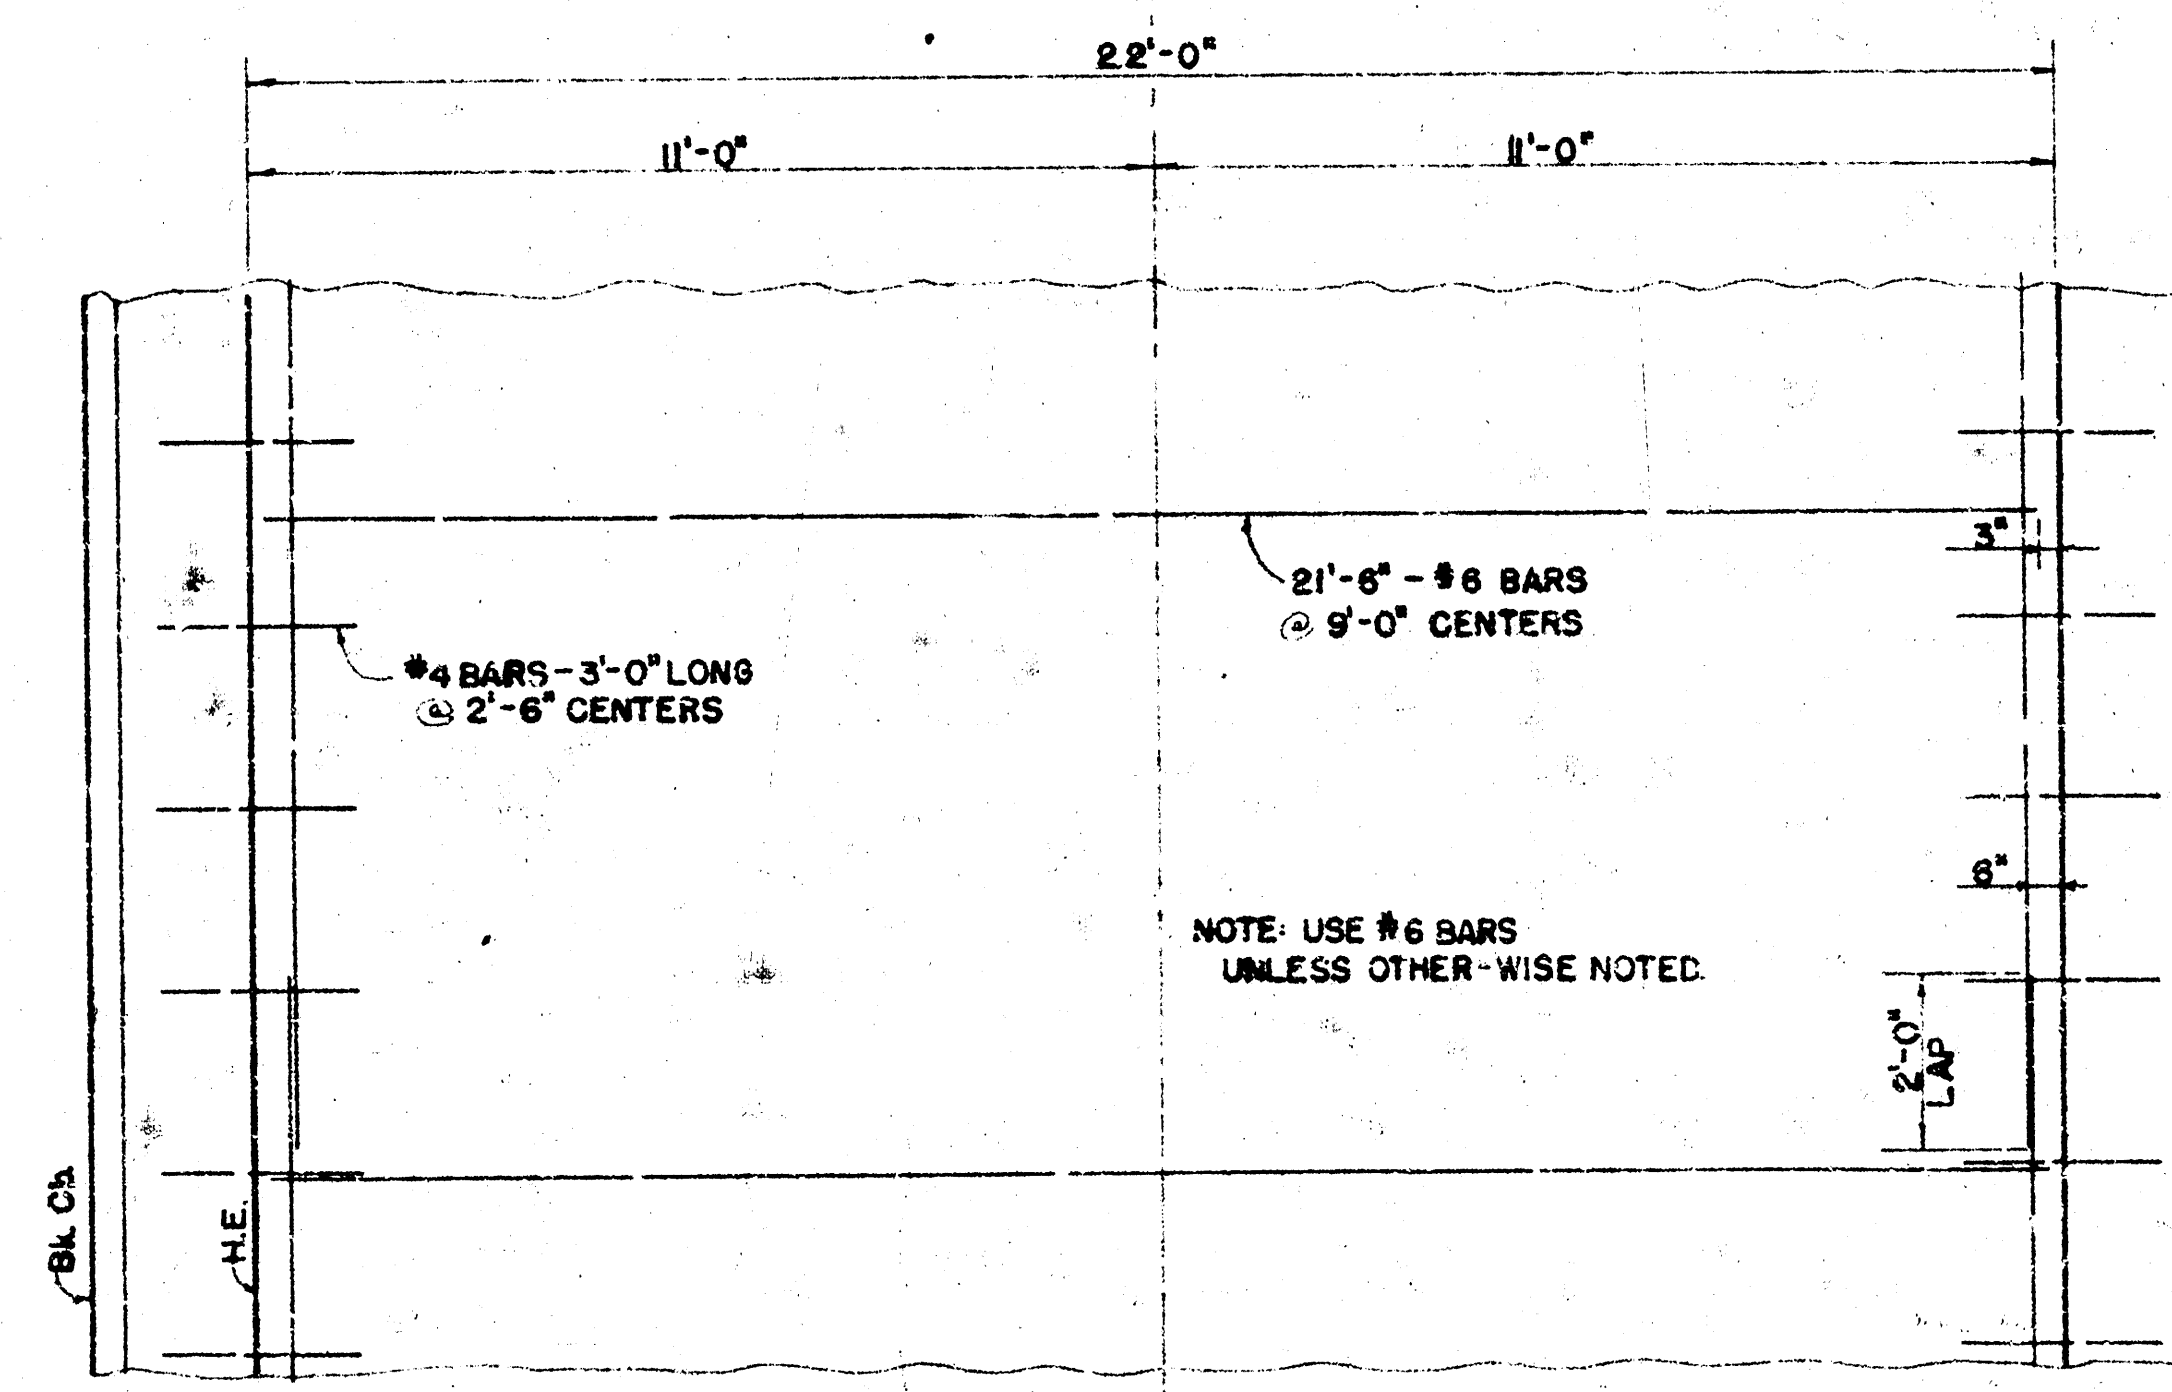

SFEEL PATTERN



CITY OF WICHITA, KANSAS
 Department of Public Works - Engineering Division
 R. W. LINN City Engineer
 Date: Project No.

