
E.M. 169.81 "X" on S. cb Lavon @ ho. approach wk. S.E. Lavon & Yale Blvd.
B.M. 180.08 S.W. Cor. curb on S.W.S. bulkhead 100' N. 15th & approx. @ Yale Blvd. S.

Note: Stationing is on W.P.L. to Sta. 2+48.01 and is 25' W. of W. Cb. from Sta. 2+48.01 to Sta. 9+91.21

From P.I. of curve Sta. 6+21.91 to S.L. 15th, Sta. 9+91.21, the E. of Yale Blvd. is 55' E. of E.L. Yale Ave.

Grades set on Cb. line distances.

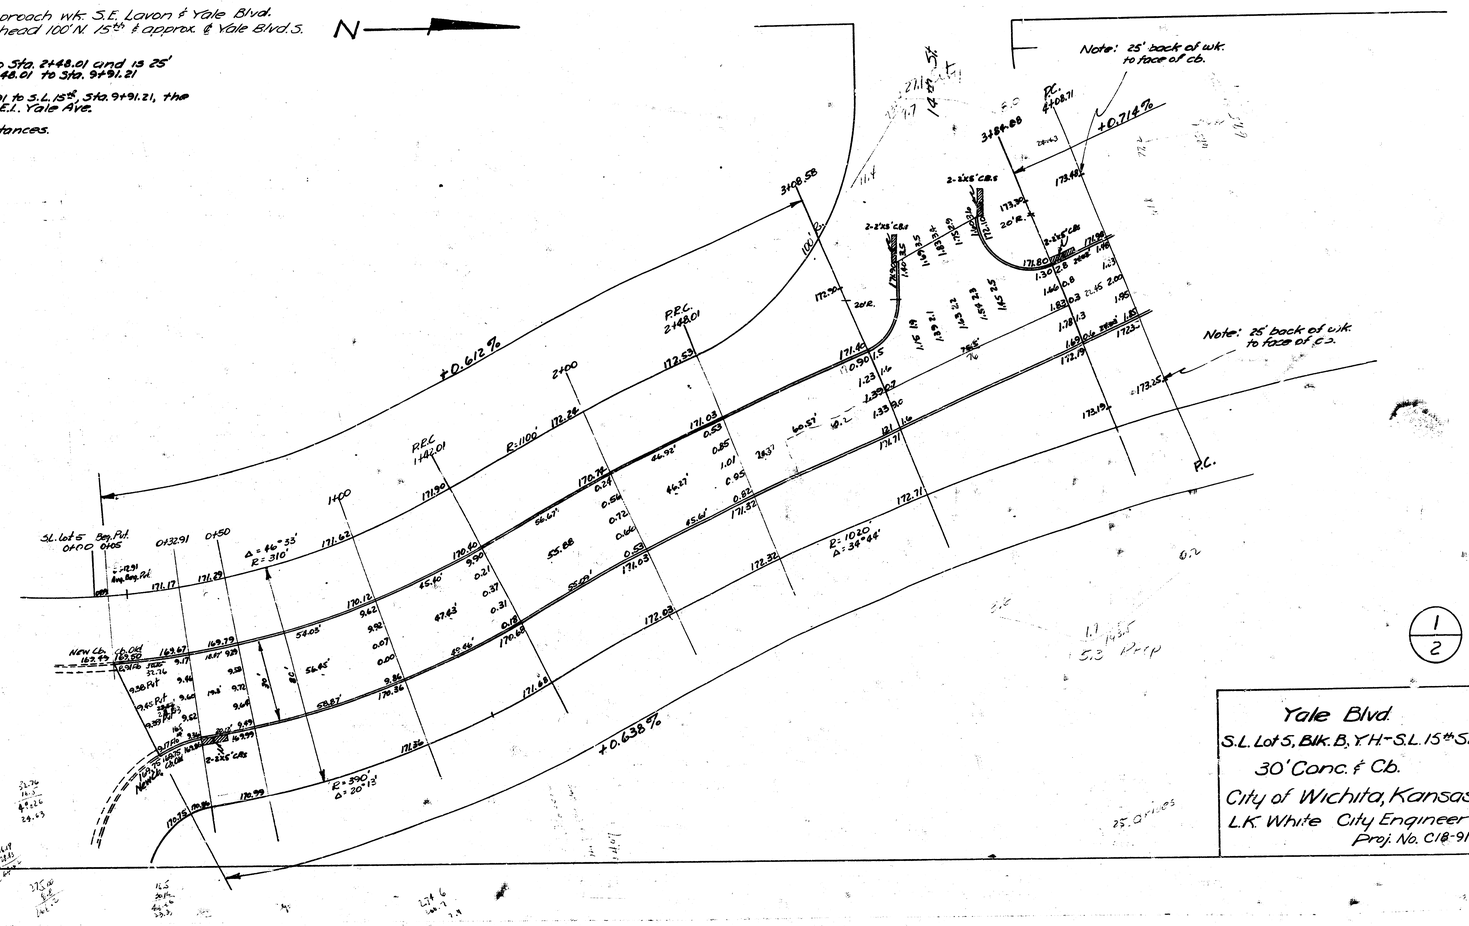

N

14th St.

Yale

5+50 6+00 PT. 6+21.91 6+50 PC. 7+00 7+50 P.I. 200' V.C. 174.70 8+00 8+50 WK. 1.5' +2.77% PT. 9+00 Ave. 9+50 9+91.21

15th St.

Note: 25' back of wk. to face of ch.

Note: 25' back of wk. to face of ch.

R.C. 4+08.71

R= 480.3' Δ= 22°48'

R= 1020' Δ= 34°44'

R= 388.3' Δ= 20°28'

R= 30' Δ= 103°

Exist. 2'x5' CB

181.10 Flo.

180.10 Flo.

179.64 Flo.

No Crown

+0.638% WK. 1.0'

P.C.

P.T.

P.C.

P.I. 200' V.C. 174.70

+2.51% WK. 1.0'

P.T.

2
2