

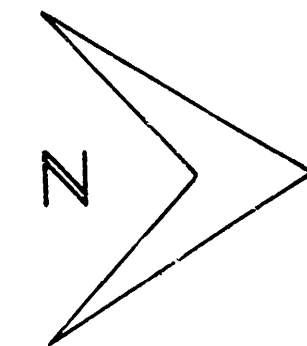


B.M. 205.08 NW Cor. Sec. 36 & University Methodist Man., NE. Cor. Yale & 21st St.
 B.M. 199.63 NW Cor. same prop. Ht. # 2284 N. Yale
 B.M. 192.11 " " in Western Top Fire Hydr. W.S. Yale @ Sta. 7+80
 B.M. 191.72 NW Cor. same with N. Side Ht. # 2400 N. Yale

See field book J.F.G. 86 for drive details.

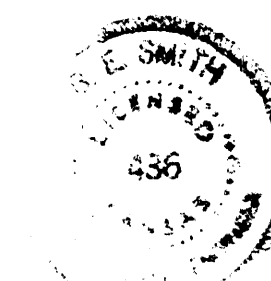


Scale: 1" = 20'

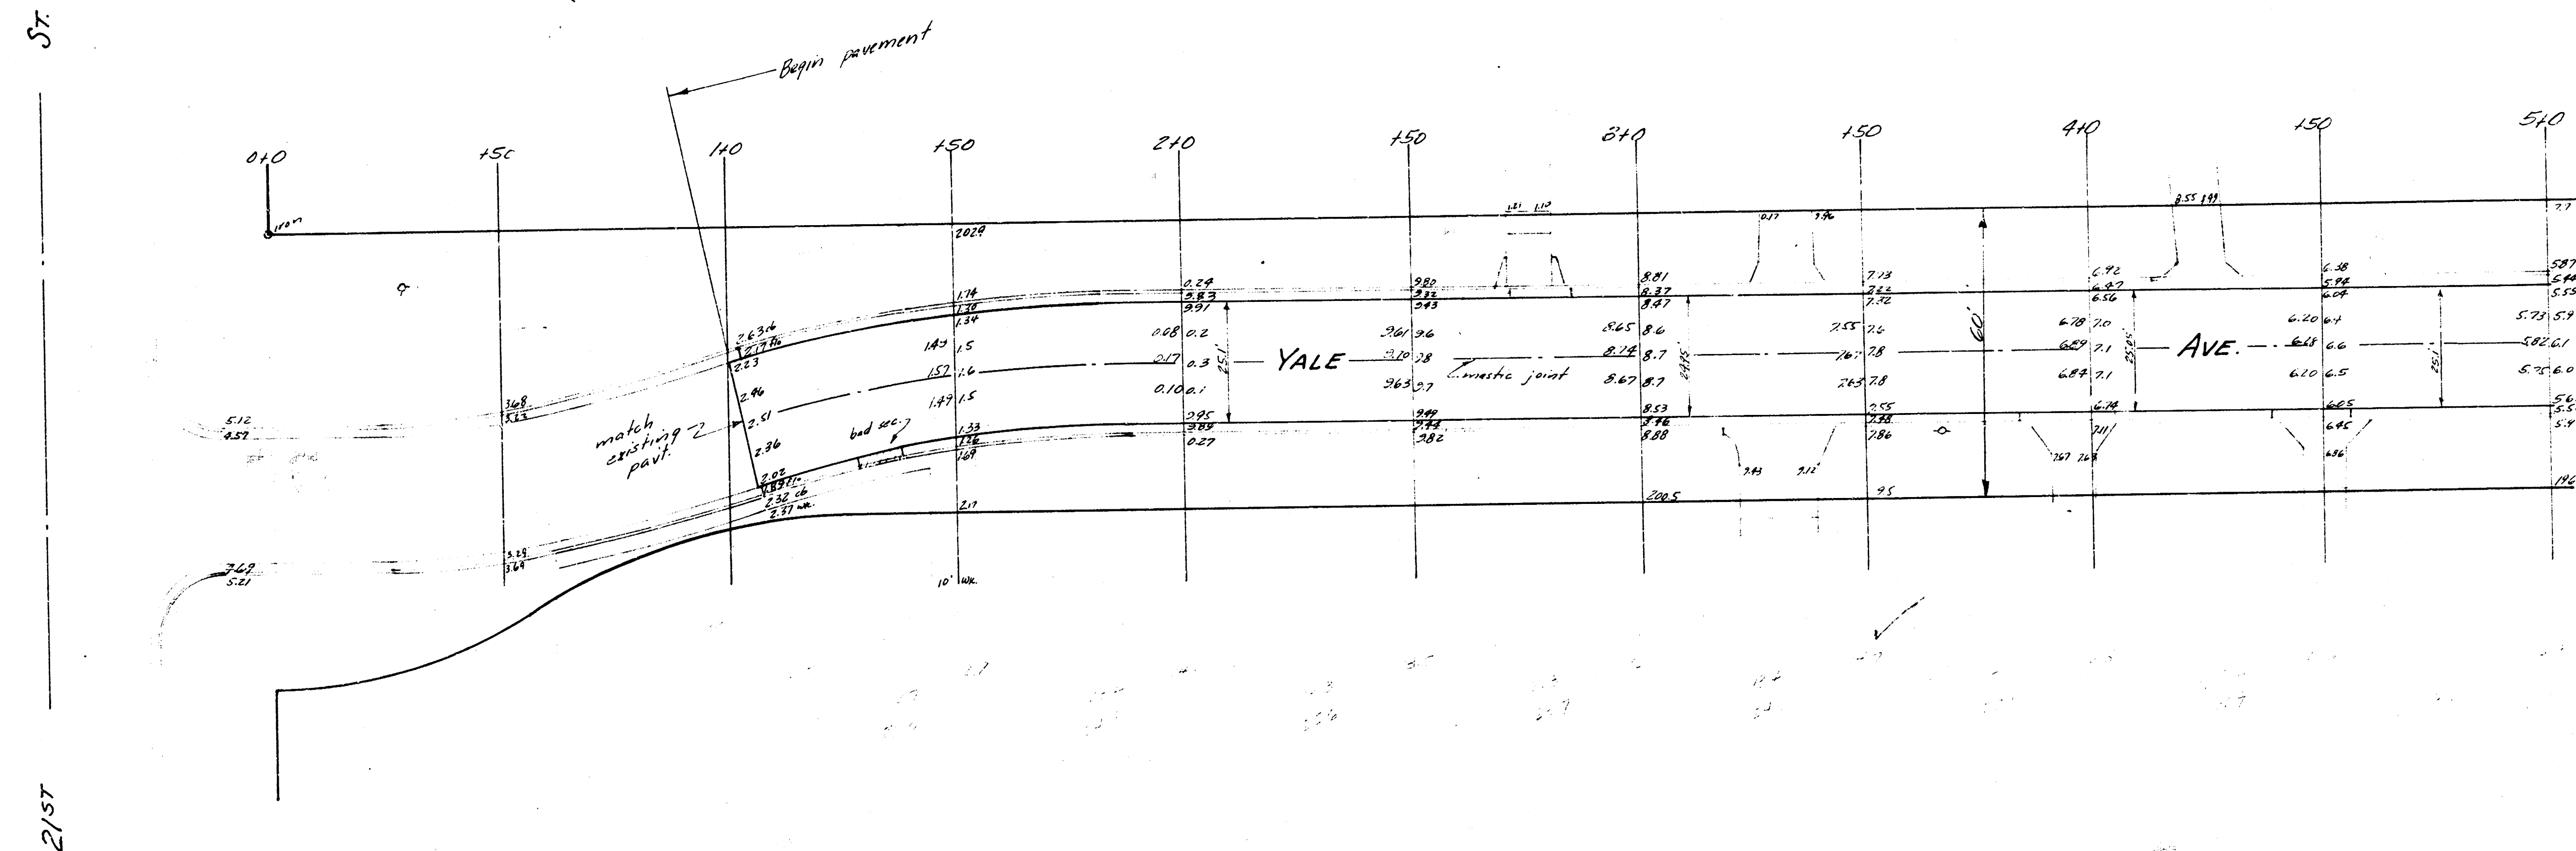


YALE AVE.
 95' N. of N.L. 21st St. to N.L. Lot 11,
 Block B, MONA-LYNN ESTATES.
 25' CONCRETE
 CITY OF WICHITA, KANSAS
 B.E. SMITH - CITY ENGINEER
 OCT, 1962 PROJ. C12-58

1/3

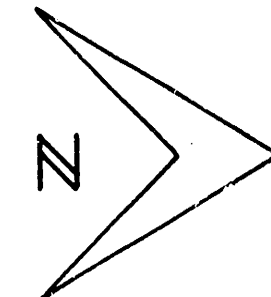


Scale: 1" = 20'

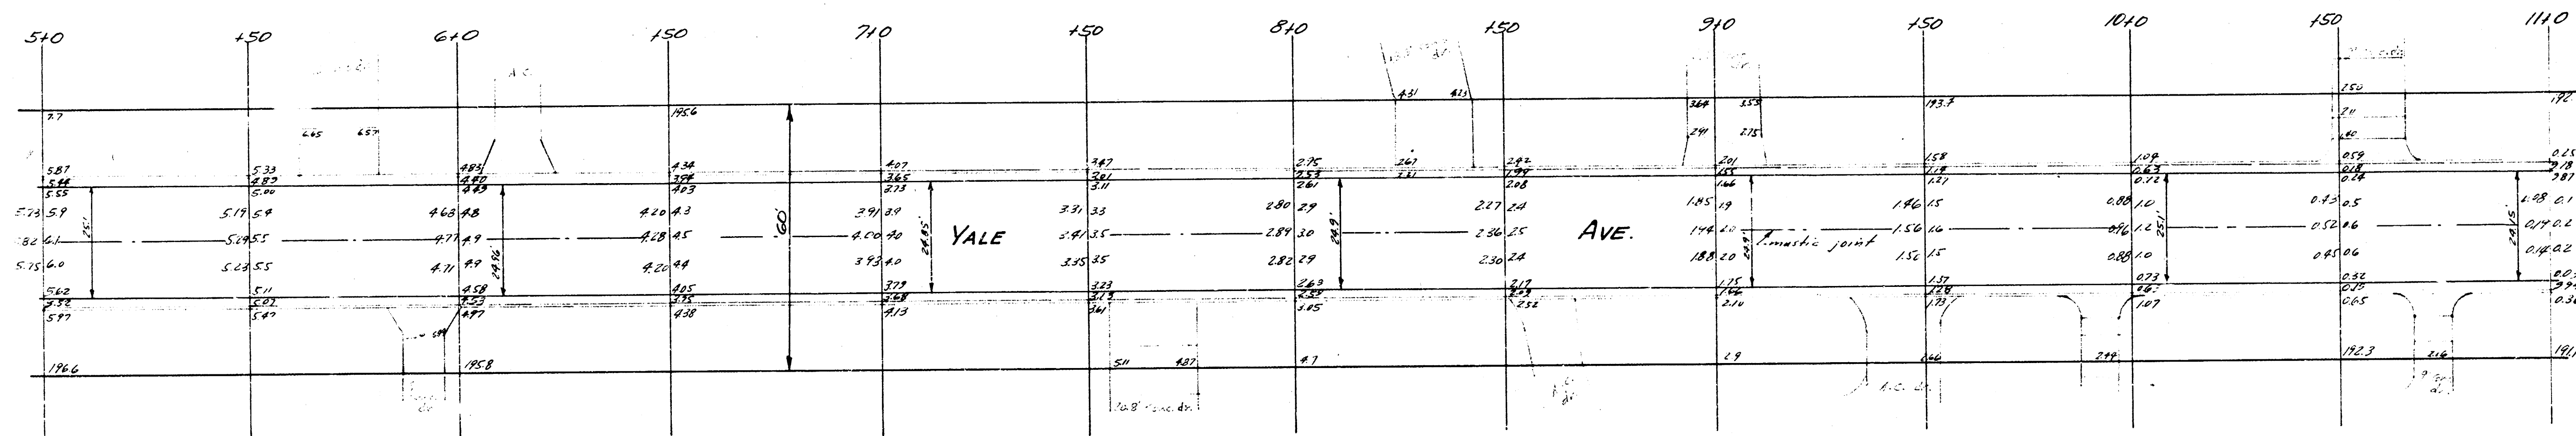


2/3

YALE AVE.
PROJ. C12-58

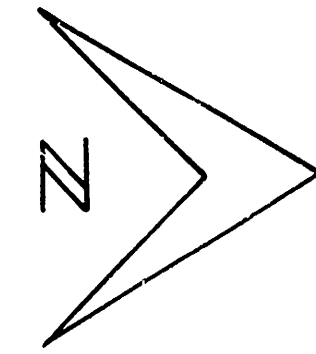

Scale: 1" = 20'
Stationing: 10' east of W.P.L.

B.M. 19192 N.W. Cor. Conc. wk. W. side 16. # 2400 N. 1/4 Sec.
B.M. 18710 "M" in Mueller Top first 16 ft. N.W. cor. 3rd & 4th

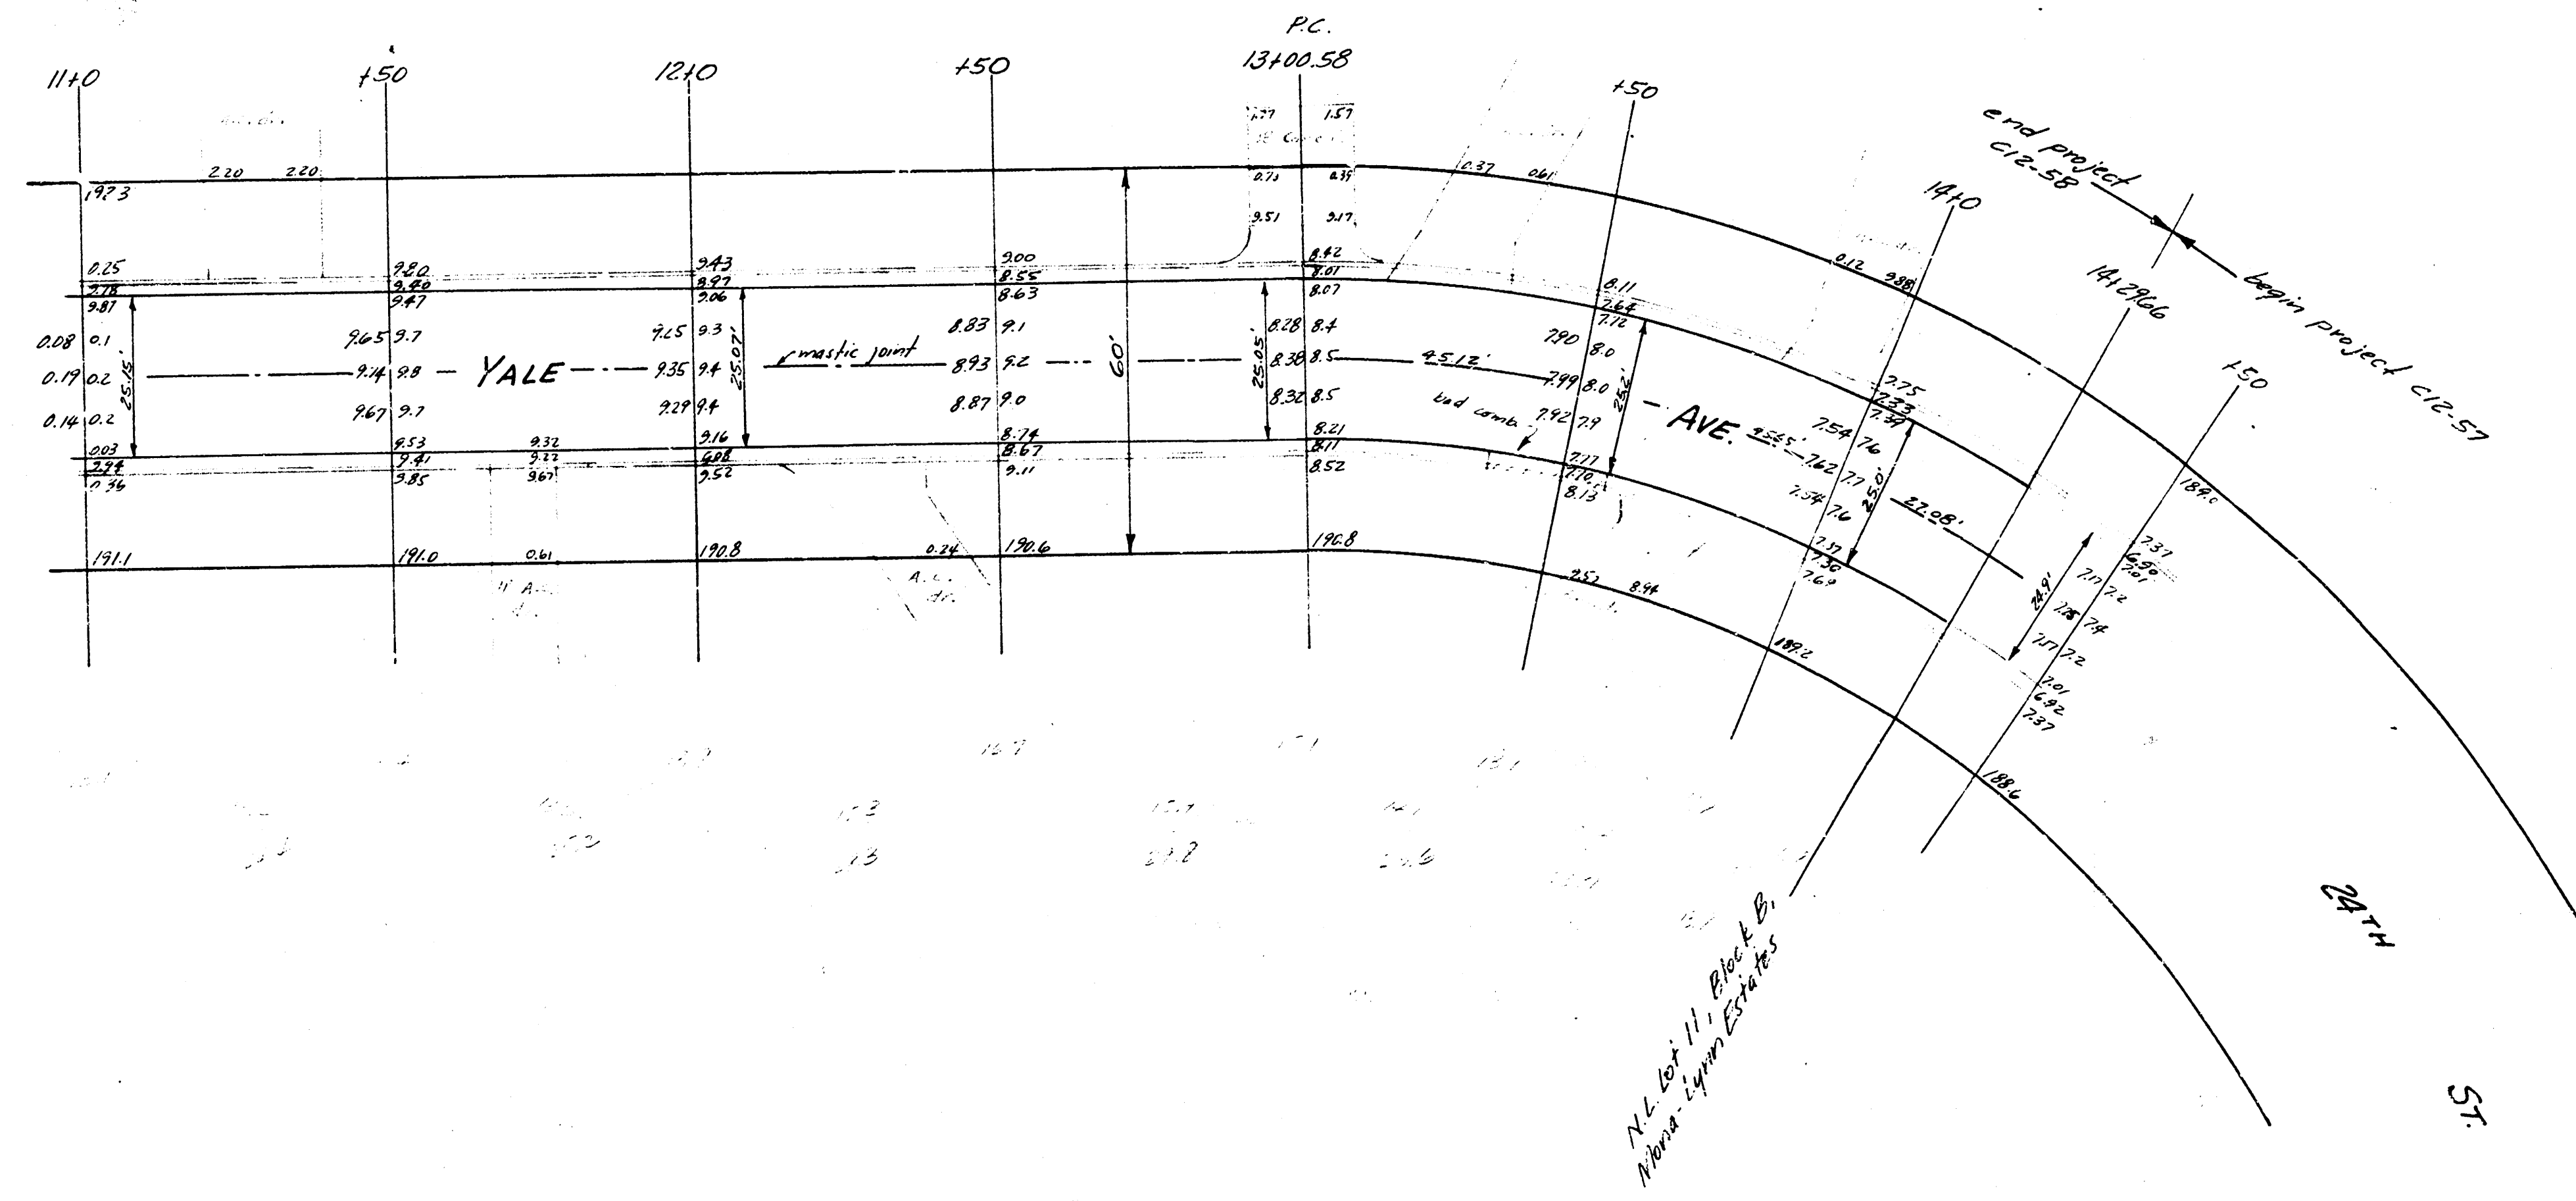

3/3

YALE AVE.
PROJ. C12-58