

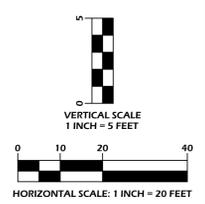


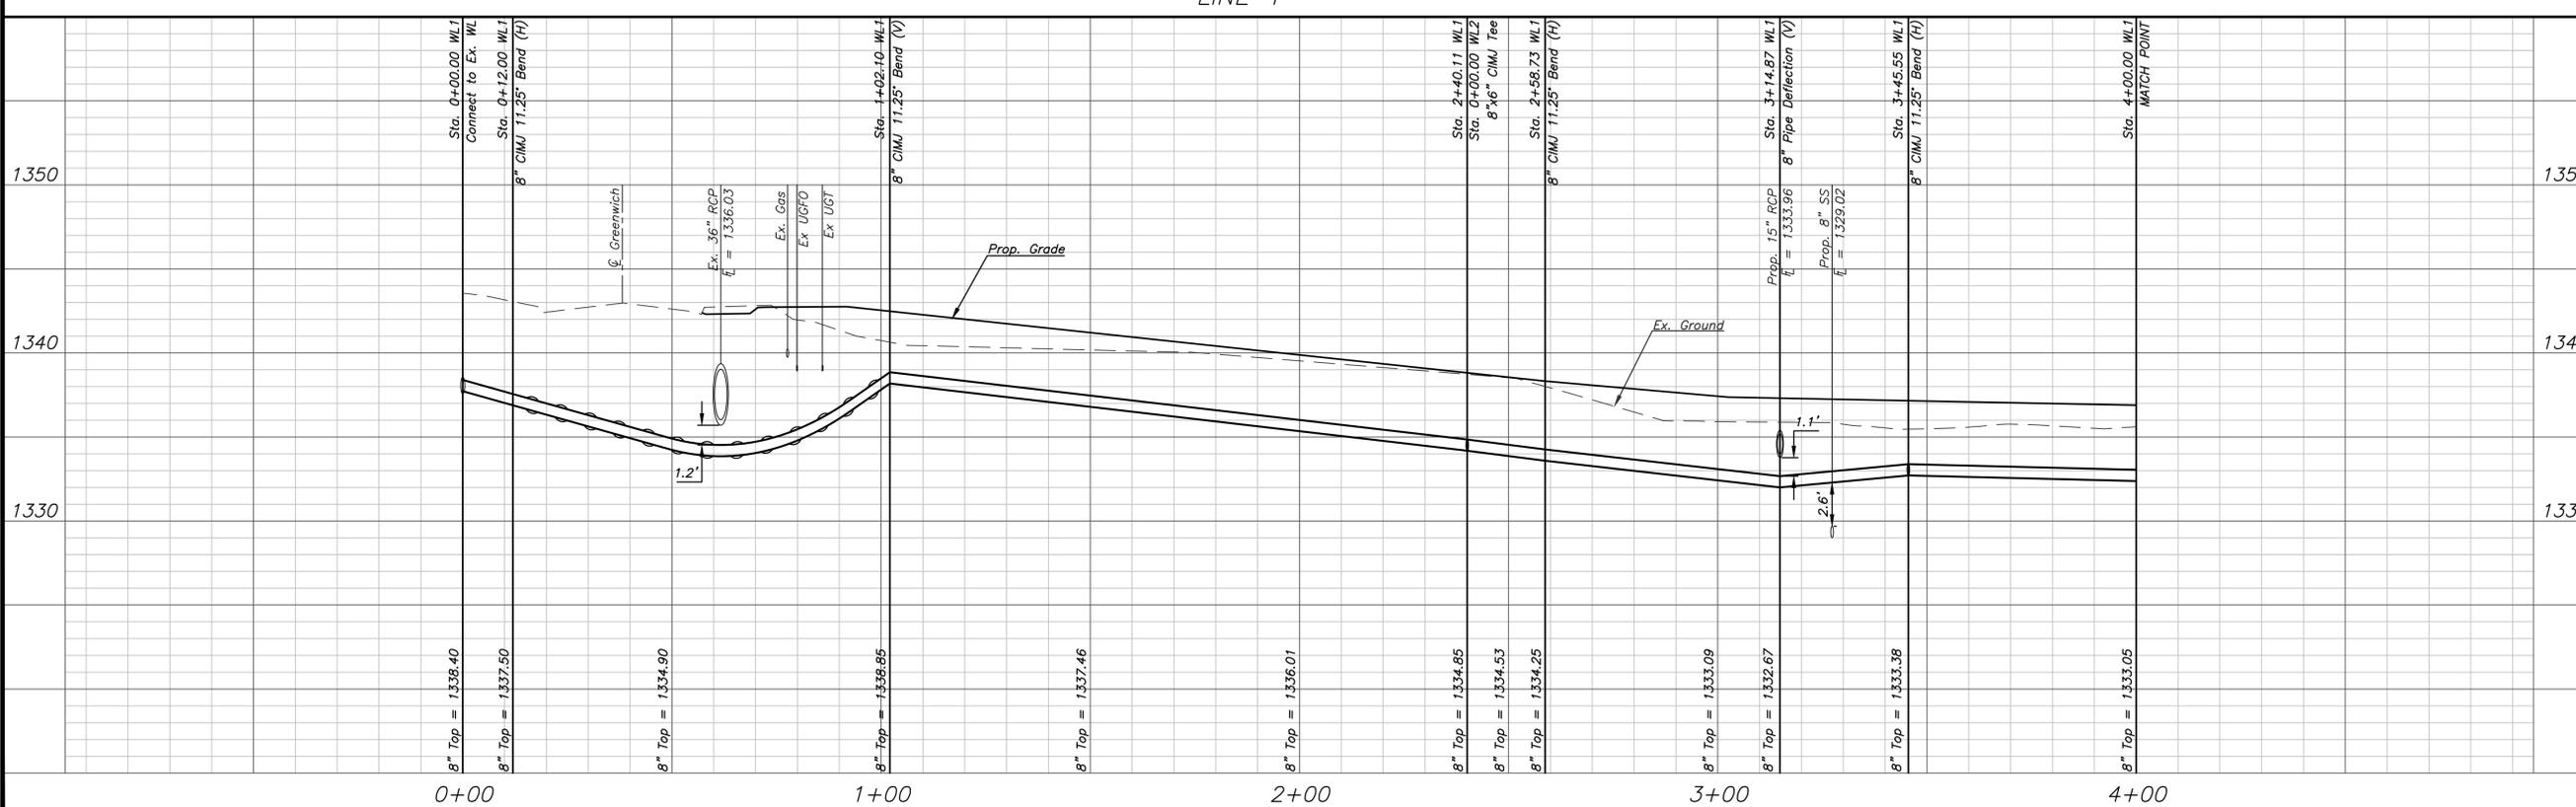

WATER DISTRIBUTION SYSTEM
GREENWICH LEGACY ADDITION
WICHITA, KANSAS

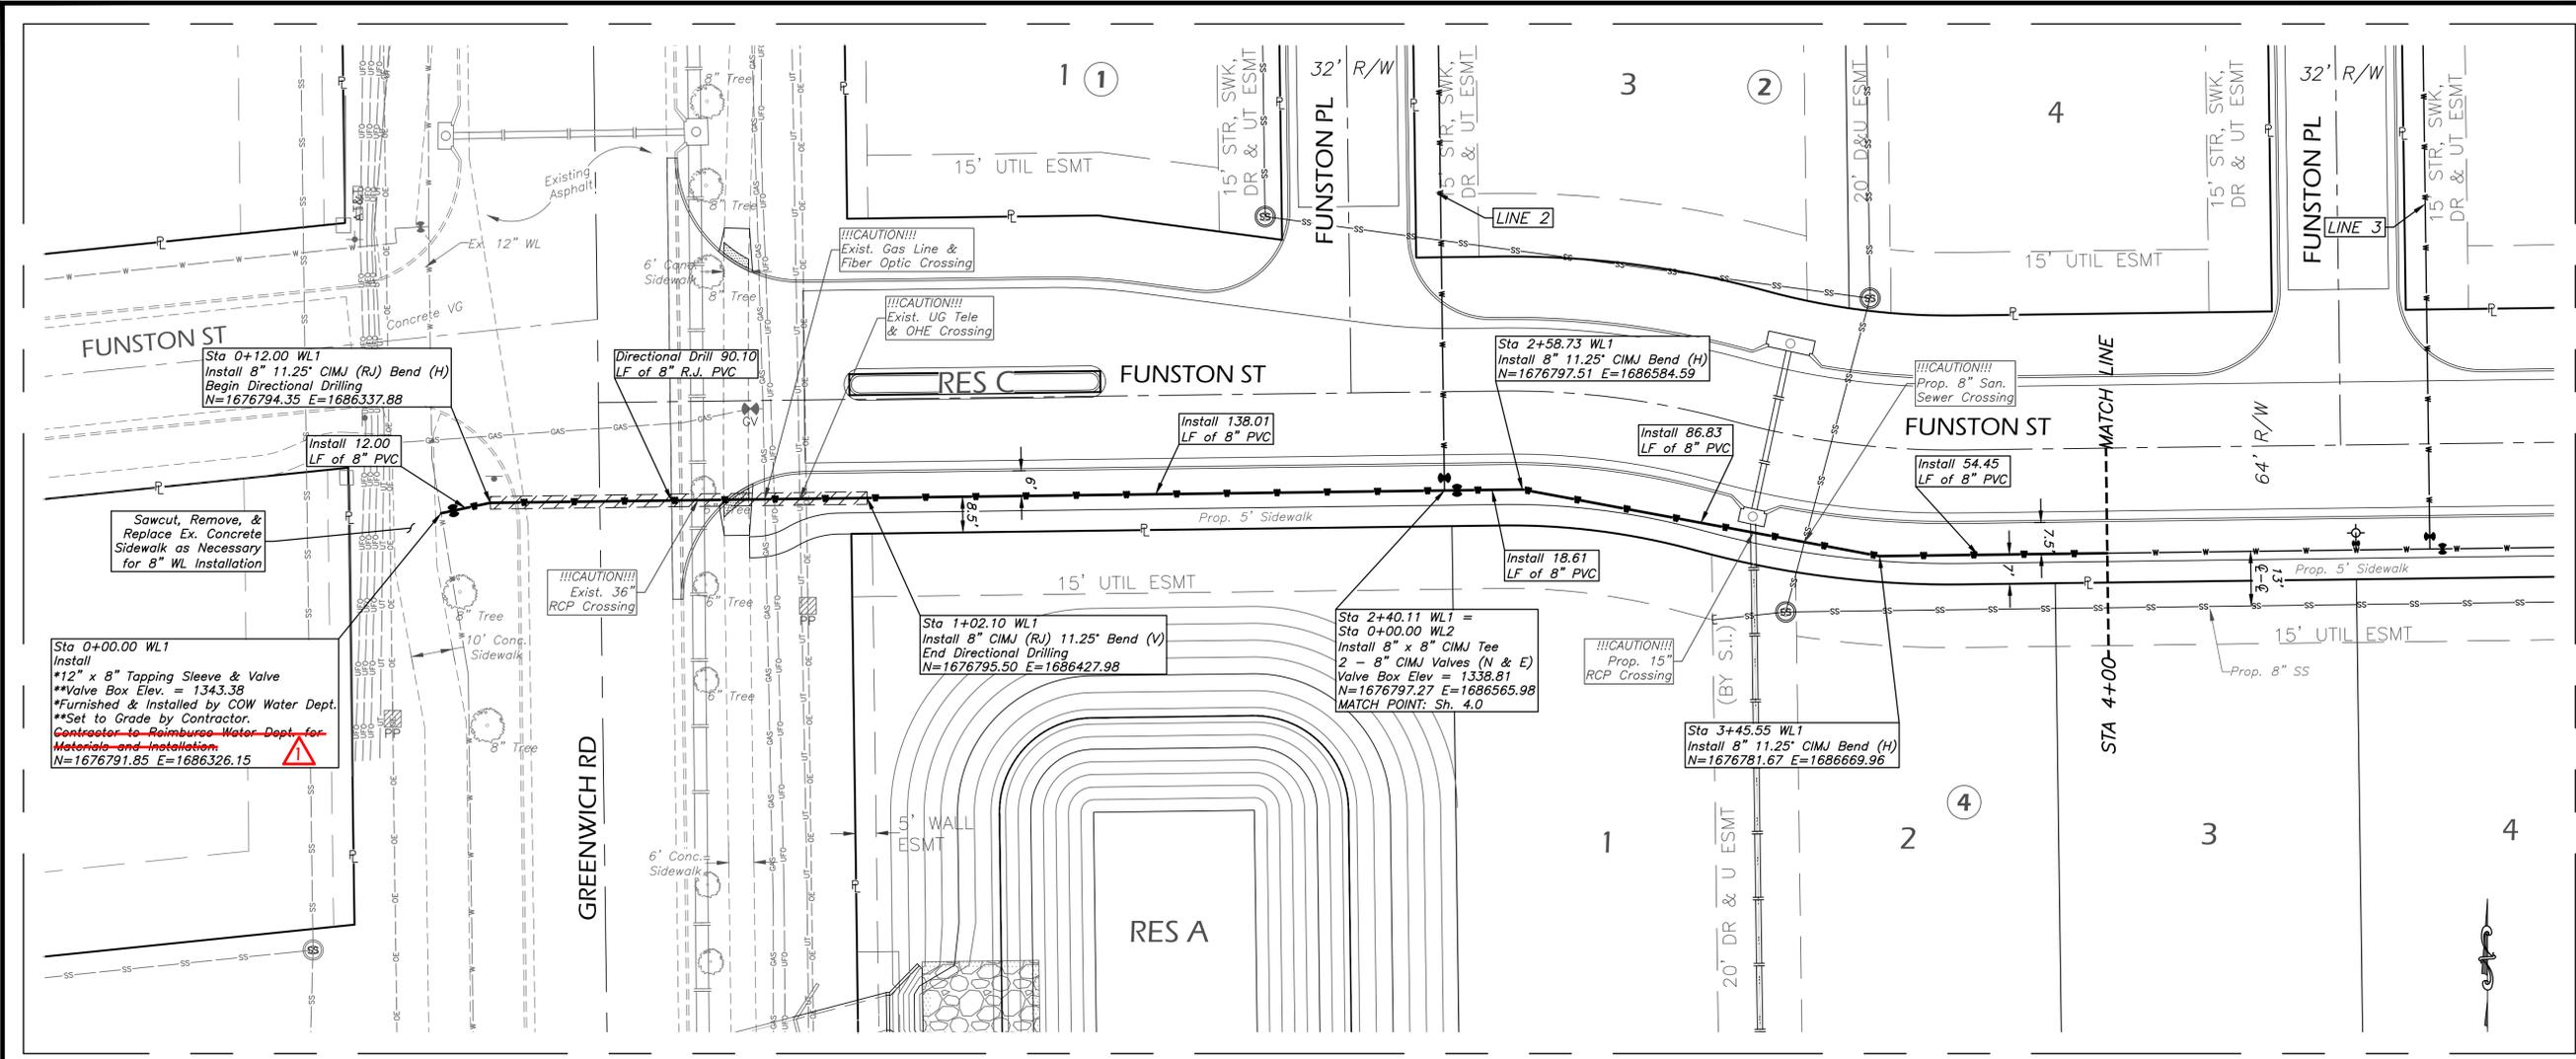

REVISIONS

ADDENDUM #1	10.14.2025
-------------	------------


KEM PROJ. 21177	DATE 08.2025
DESIGNED ZJS	DRAWN ZJS

**Plan & Profile
Line 1**


SHEET **3.0**





STORM WATER DRAIN
GREENWICH LEGACY ADDITION
WICHITA, KANSAS

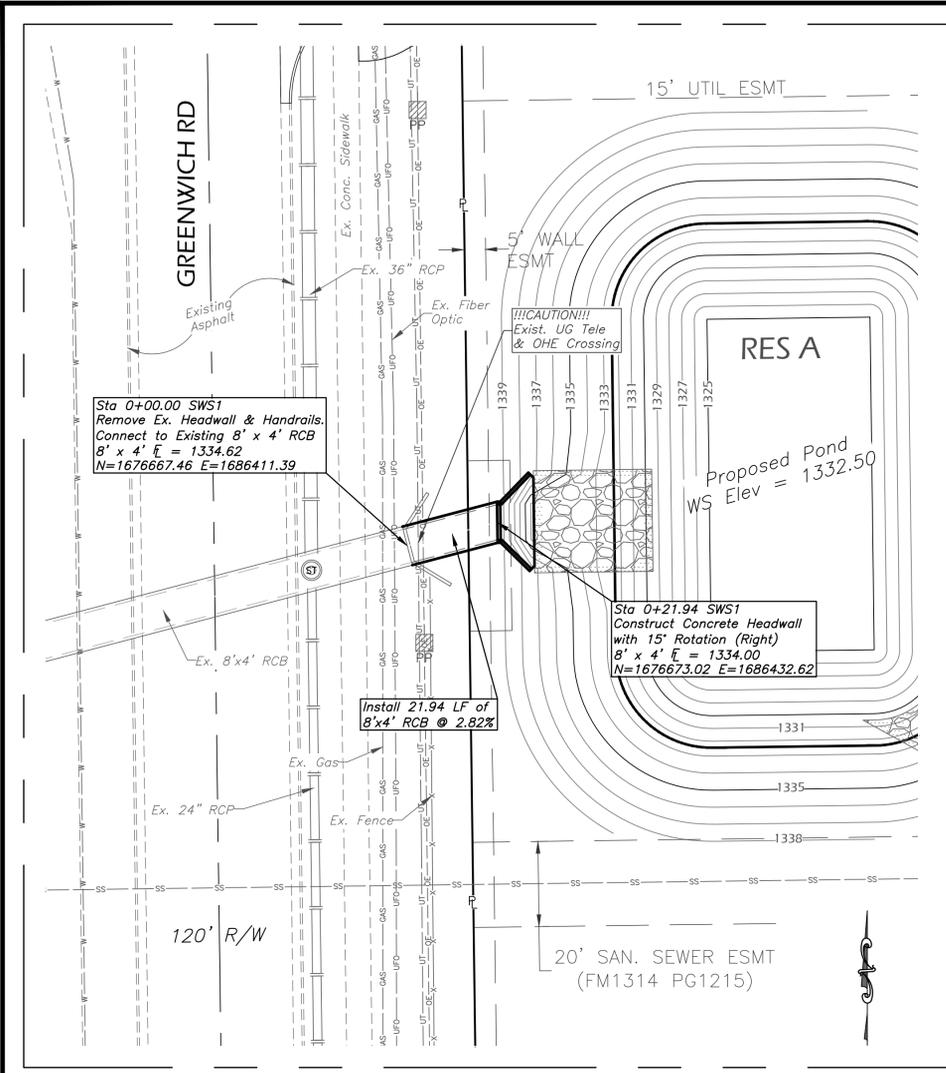


LINE 1

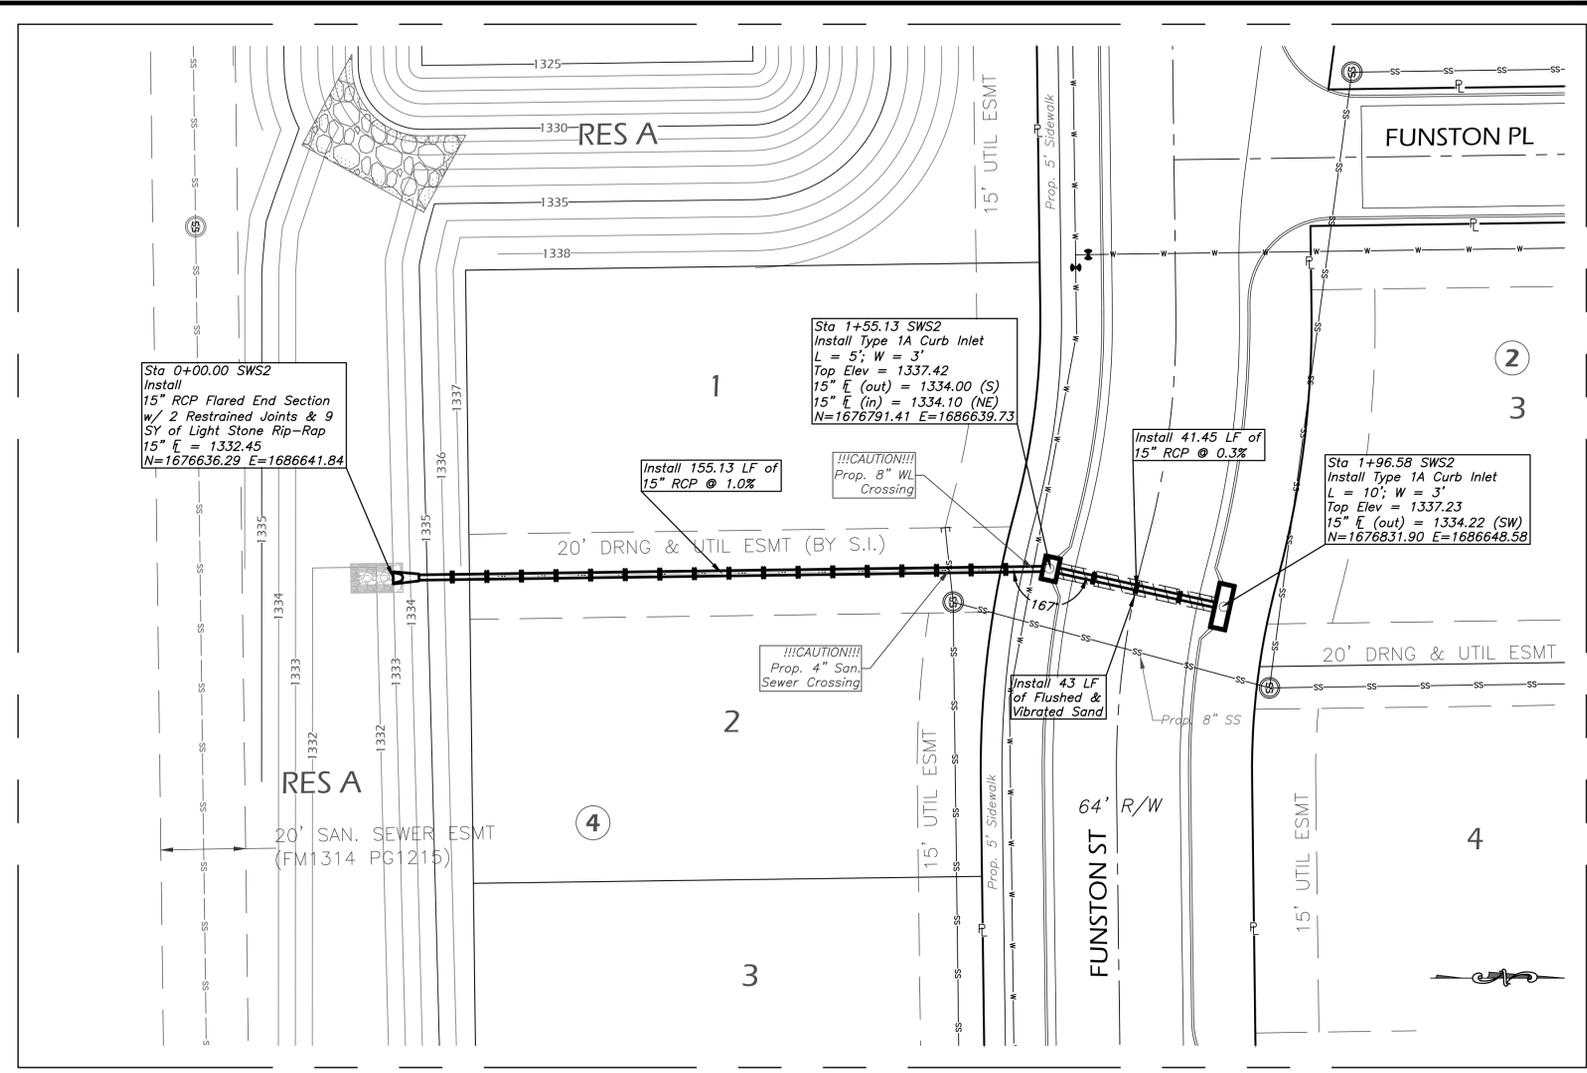

LINE 2

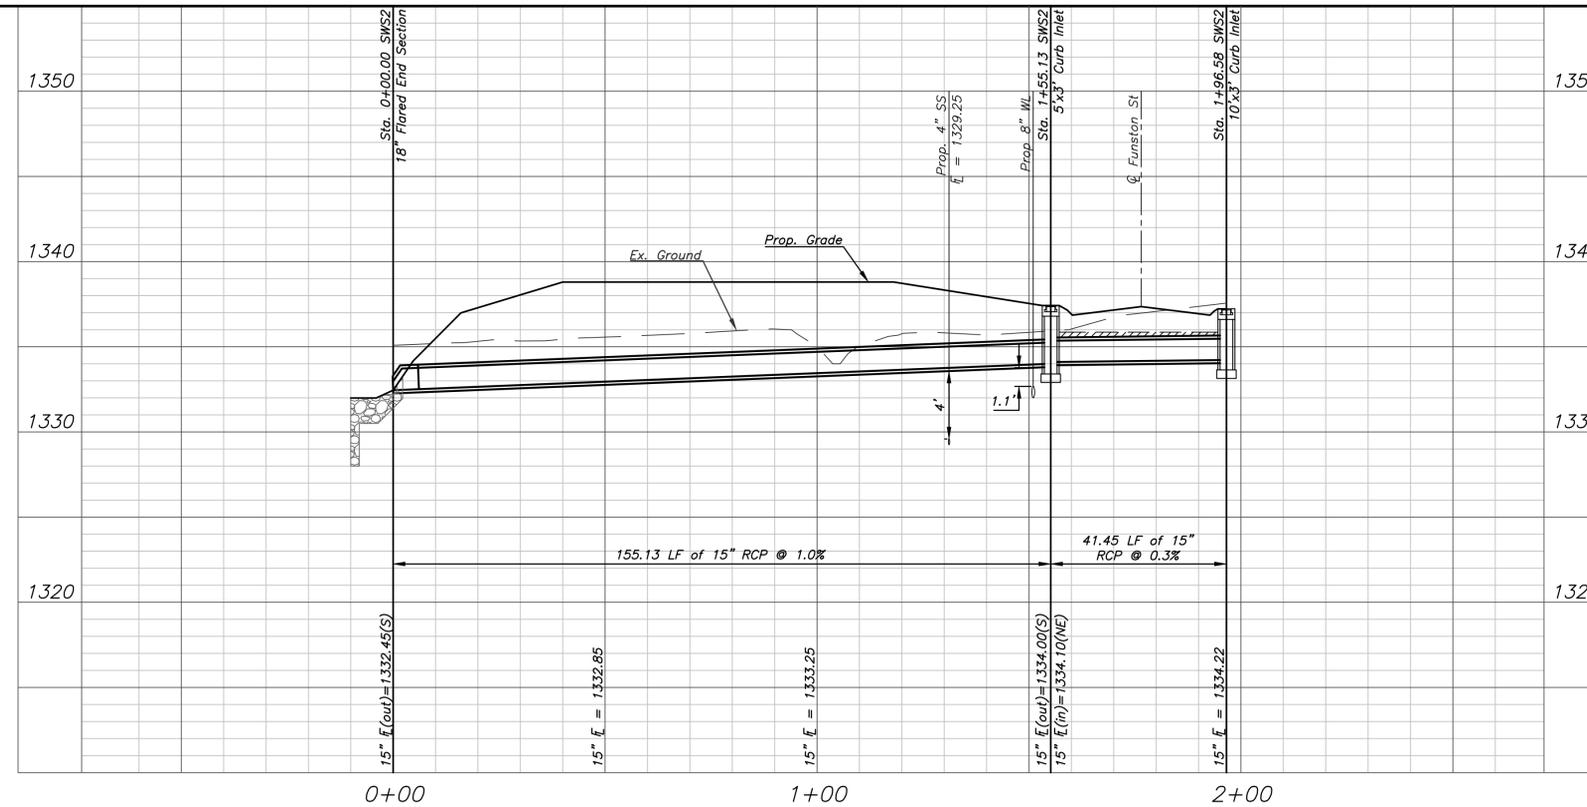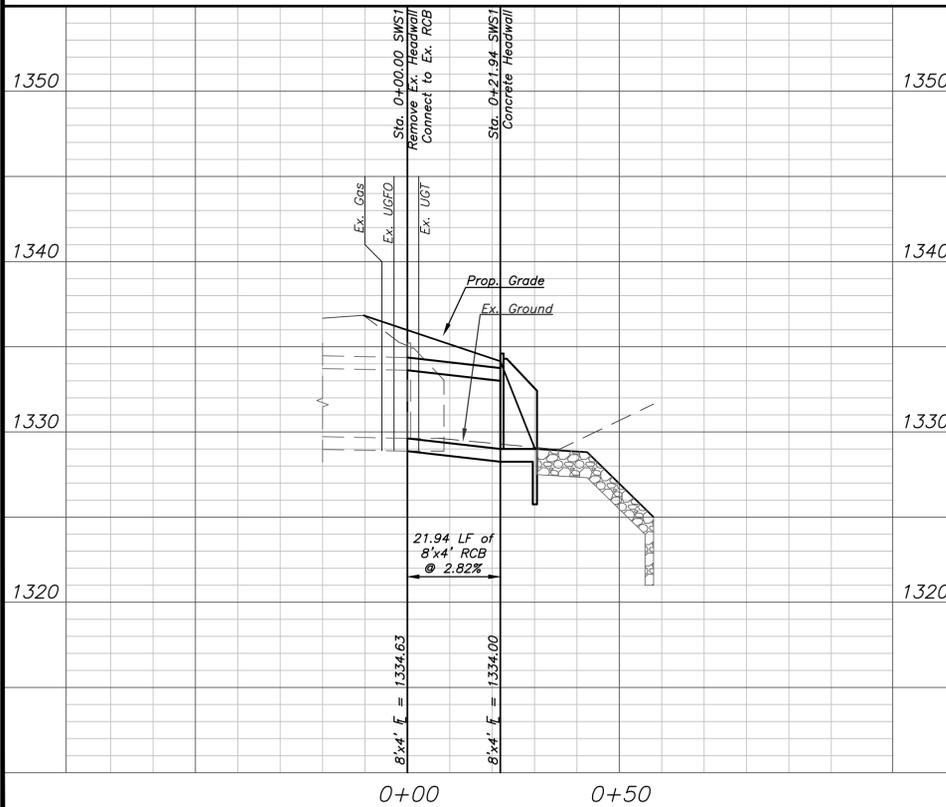

October 14, 2025

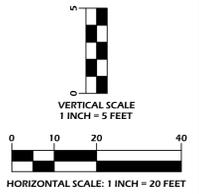


REVISIONS	
ADDENDUM #1	10.14.2025

KEM PROJ. 21177	DATE 08.2025
DESIGNED ZJS	DRAWN ZJS

Plan & Profile
Lines 1 & 2

SHEET **3.0**

October 14, 2025

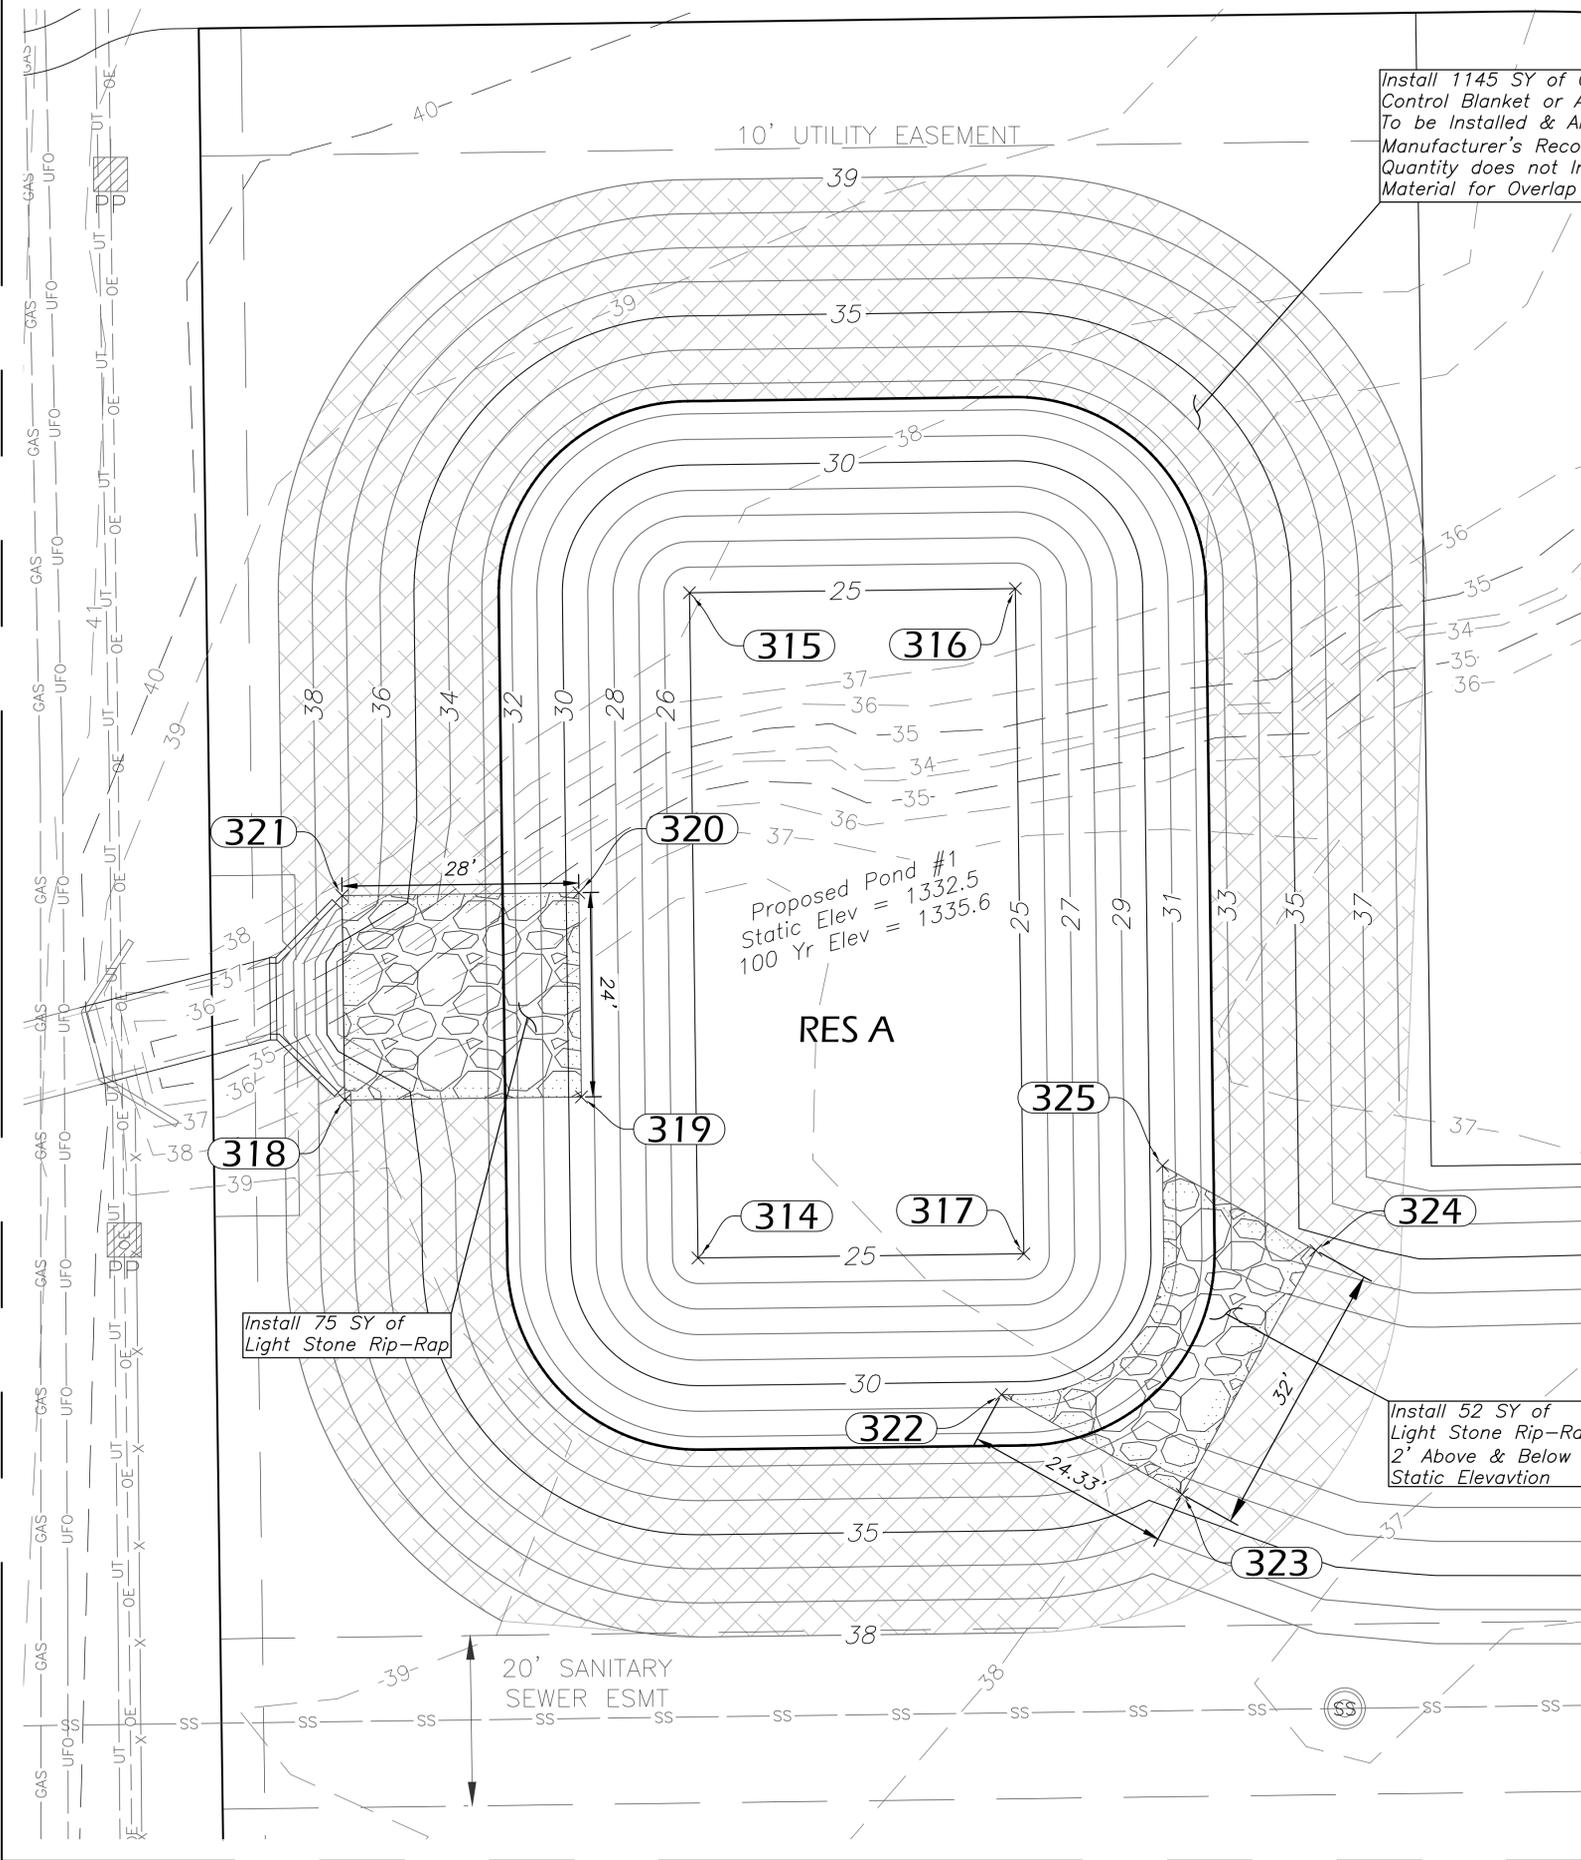

Install 1145 SY of Curlex II Erosion Control Blanket or Approved Equivalent. To be Installed & Anchored per Manufacturer's Recommendation. Quantity does not Include Excess Material for Overlap & Anchoring

Install 75 SY of Light Stone Rip-Rap


Install 52 SY of Light Stone Rip-Rap 2' Above & Below Static Elevation

Proposed Pond #1
 Static Elev = 1332.5
 100 Yr Elev = 1335.6


POND GRADING NOTES:

- Overexcavate 12" of soil for all areas within pond that are below the proposed water surface elevation.
- Construct 12" Clay Liner in 2 - 6" Lifts, using high plasticity clay (P.I. > 30 or best available on site.) ~~Refer to Costechnical Report for on-site materials.~~
- All areas within the pond limits, including side slopes above the water surface are to be compacted to 95% standard density with ±2% optimum moisture content.
- All costs associated with construction of the Clay Liner are subsidiary to Earthwork bid items.


Point Table			
Point #	Raw Description	Northing	Easting
314	Radius	1676642.58	1686483.09
315	Radius	1676720.69	1686482.09
316	Radius	1676721.18	1686520.53
317	Radius	1676643.07	1686521.53
318	Rip-Rap	1676661.13	1686441.42
319	Rip-Rap	1676661.49	1686469.35
320	Rip-Rap	1676685.48	1686469.04
321	Rip-Rap	1676685.13	1686441.11
322	Rip-Rap	1676626.53	1686518.90
323	Rip-Rap	1676614.81	1686540.21
324	Rip-Rap	1676643.47	1686555.98
325	Rip-Rap	1676653.41	1686537.90

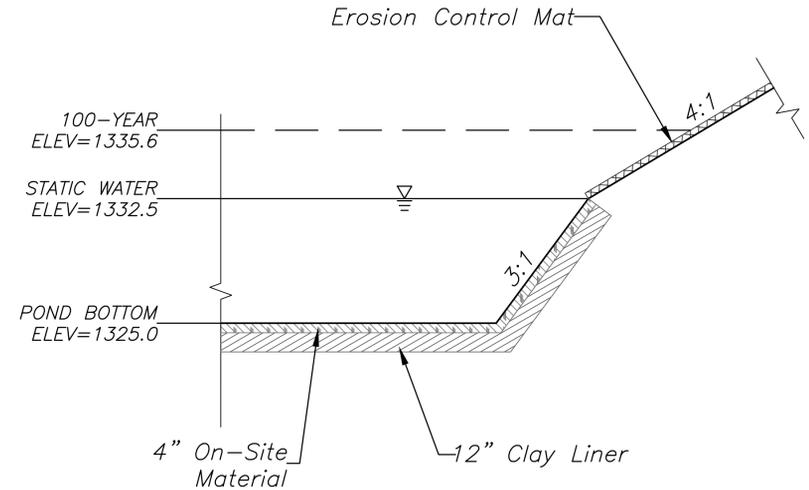

TYPICAL POND SECTION
 NOT TO SCALE

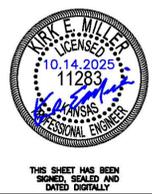

STORM WATER DRAIN
GREENWICH LEGACY ADDITION
 WICHITA, KANSAS

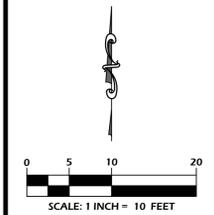


REVISIONS	
ADDENDUM #1	10.14.2025

KEM PROJ. 21177	DATE 08.2025
DESIGNED ZJS	DRAWN ZJS



STORM WATER DRAIN
GREENWICH LEGACY ADDITION
WICHITA, KANSAS

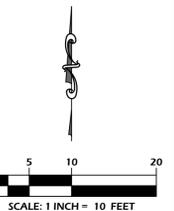

REVISIONS	
▲	ADDENDUM #1 10.14.2025

KEM PROJ. 21177	DATE 08.2025
DESIGNED ZJS	DRAWN ZJS


Pond #2 Plan

SHEET **4.1**

POND GRADING NOTES:


- Overexcavate 12" of soil for all areas within pond that are below the proposed water surface elevation.
- Construct 12" Clay Liner in 2 - 6" Lifts, using high plasticity clay (P.I. > 30 or best available on site.) ~~Refer to Geotechnical Report for on-site materials.~~
- All areas within the pond limits, including side slopes above the water surface are to be compacted to 95% standard density with ±2% optimum moisture content.
- All costs associated with construction of the Clay Liner are subsidiary to Earthwork bid items.


Point Table			
Point #	Raw Description	Northing	Easting
326	Radius	1676610.20	1687172.01
327	Radius	1676609.54	1687120.24
328	Radius	1676722.90	1687118.69
329	Radius	1676691.55	1687202.41
330	Rip-Rap	1676722.89	1687181.45
331	Rip-Rap	1676736.94	1687186.71
332	Rip-Rap	1676725.36	1687217.62
333	Rip-Rap	1676711.32	1687212.36

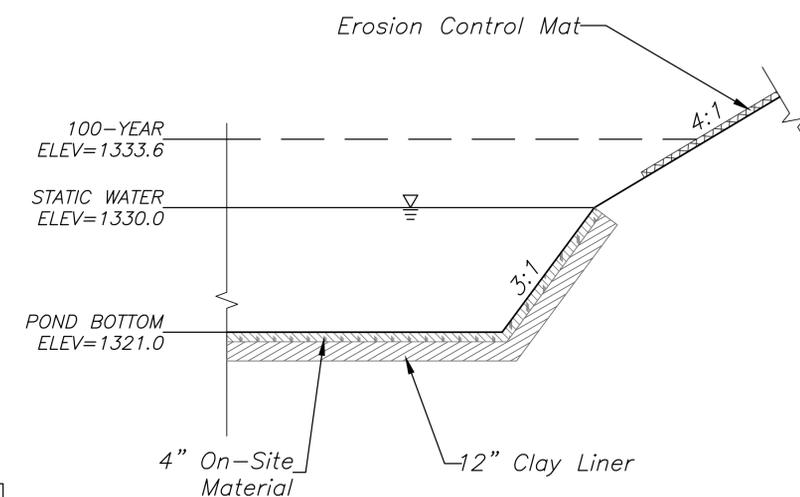

TYPICAL POND SECTION

NOT TO SCALE



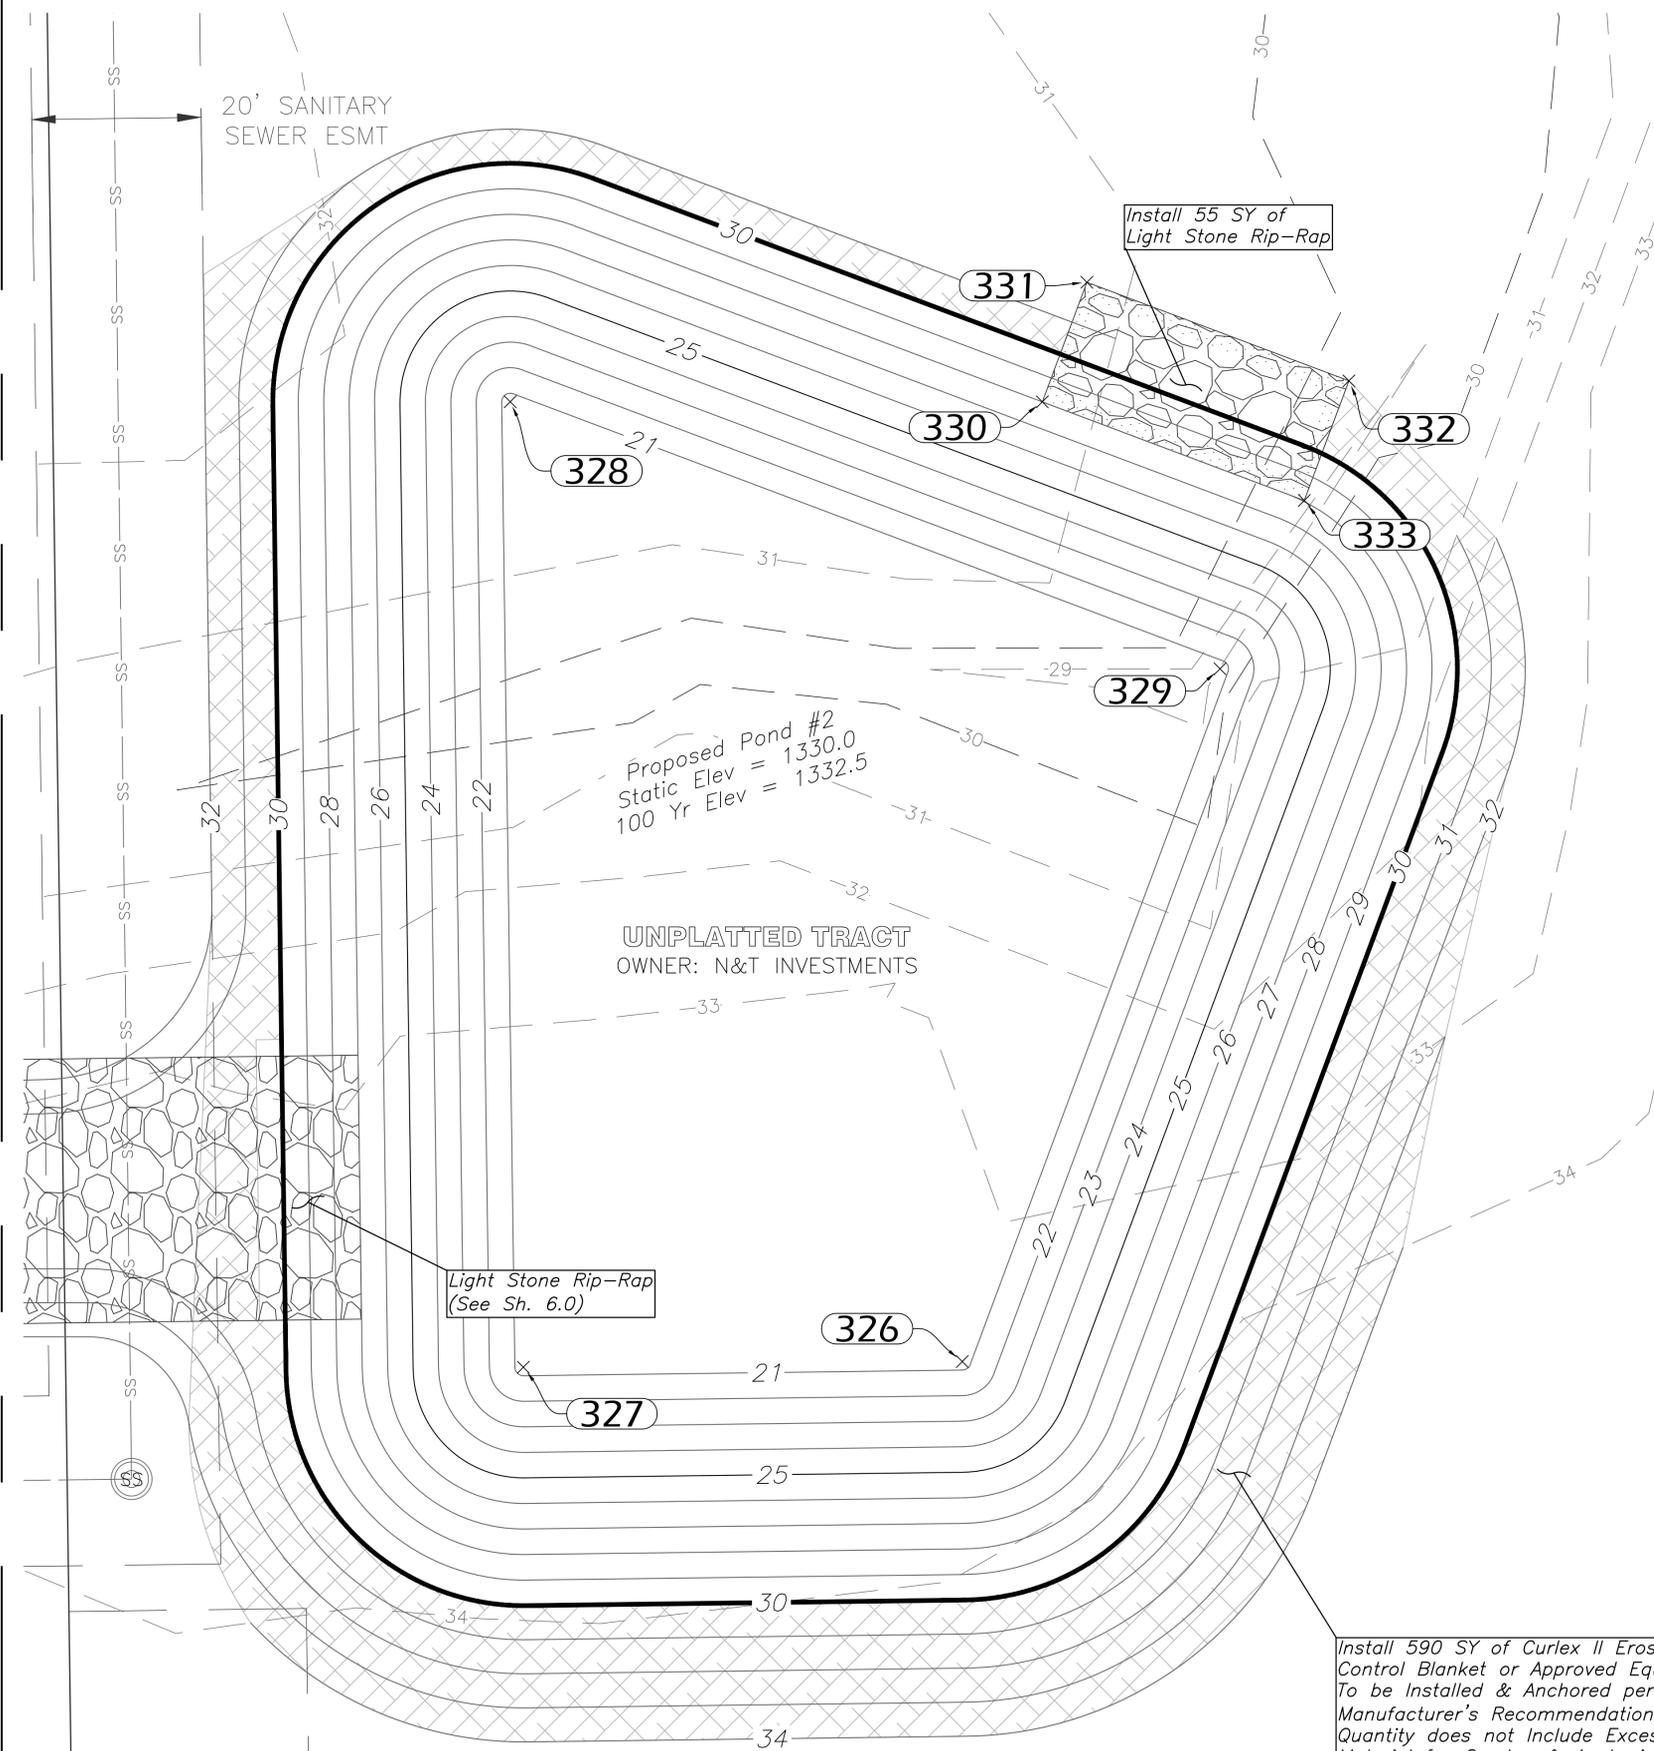


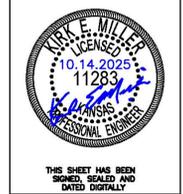

THIS SHEET HAS BEEN SIGNED, SEALED AND DATED DIGITALLY

SANITARY SEWER
GREENWICH LEGACY ADDITION
WICHITA, KANSAS

SANITARY SEWER RISER TABLE (FOR INFORMATION ONLY)							
STATION	LINE	DIRECTION	TYPE	LOT	BLOCK	4" PIPE LENGTH	
						VERT.	HORZ.
4+24.28	1	W	4" MH STUB	1	4	8.2'	19.7'

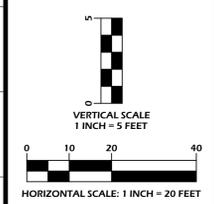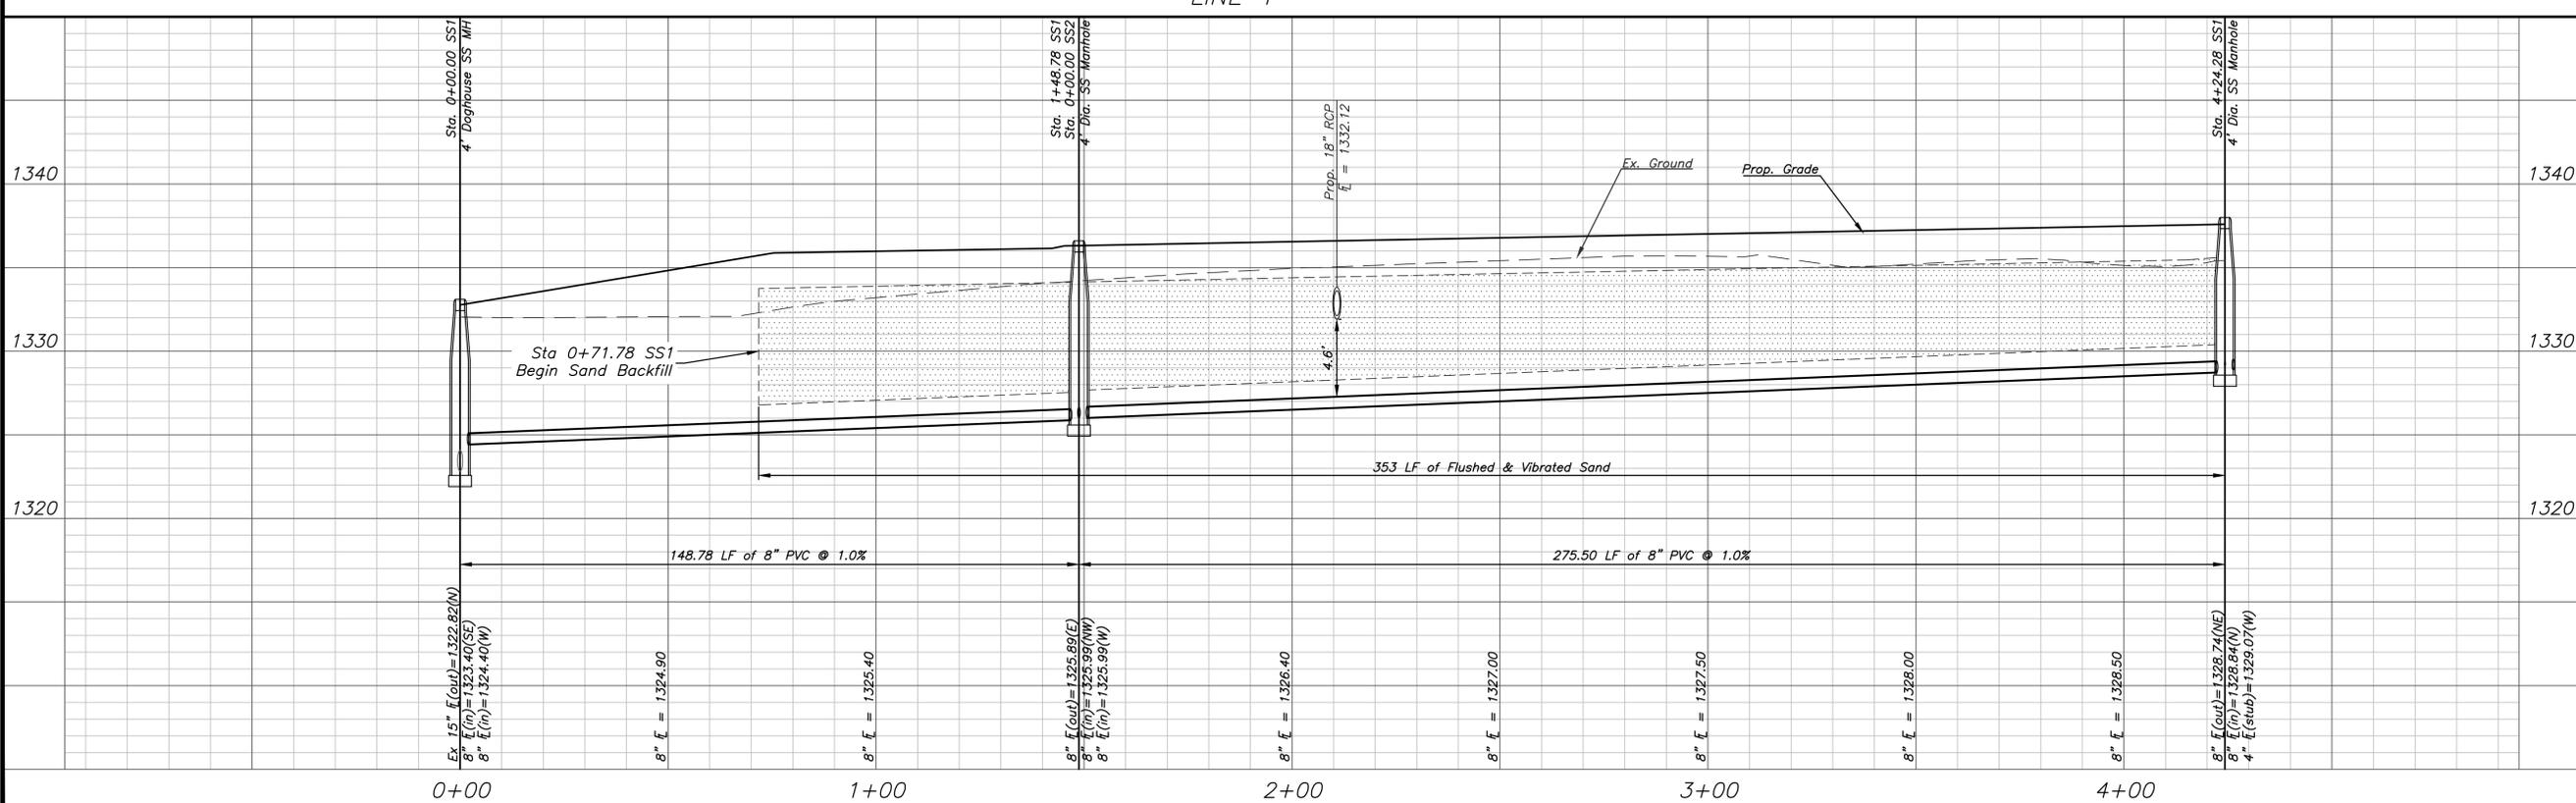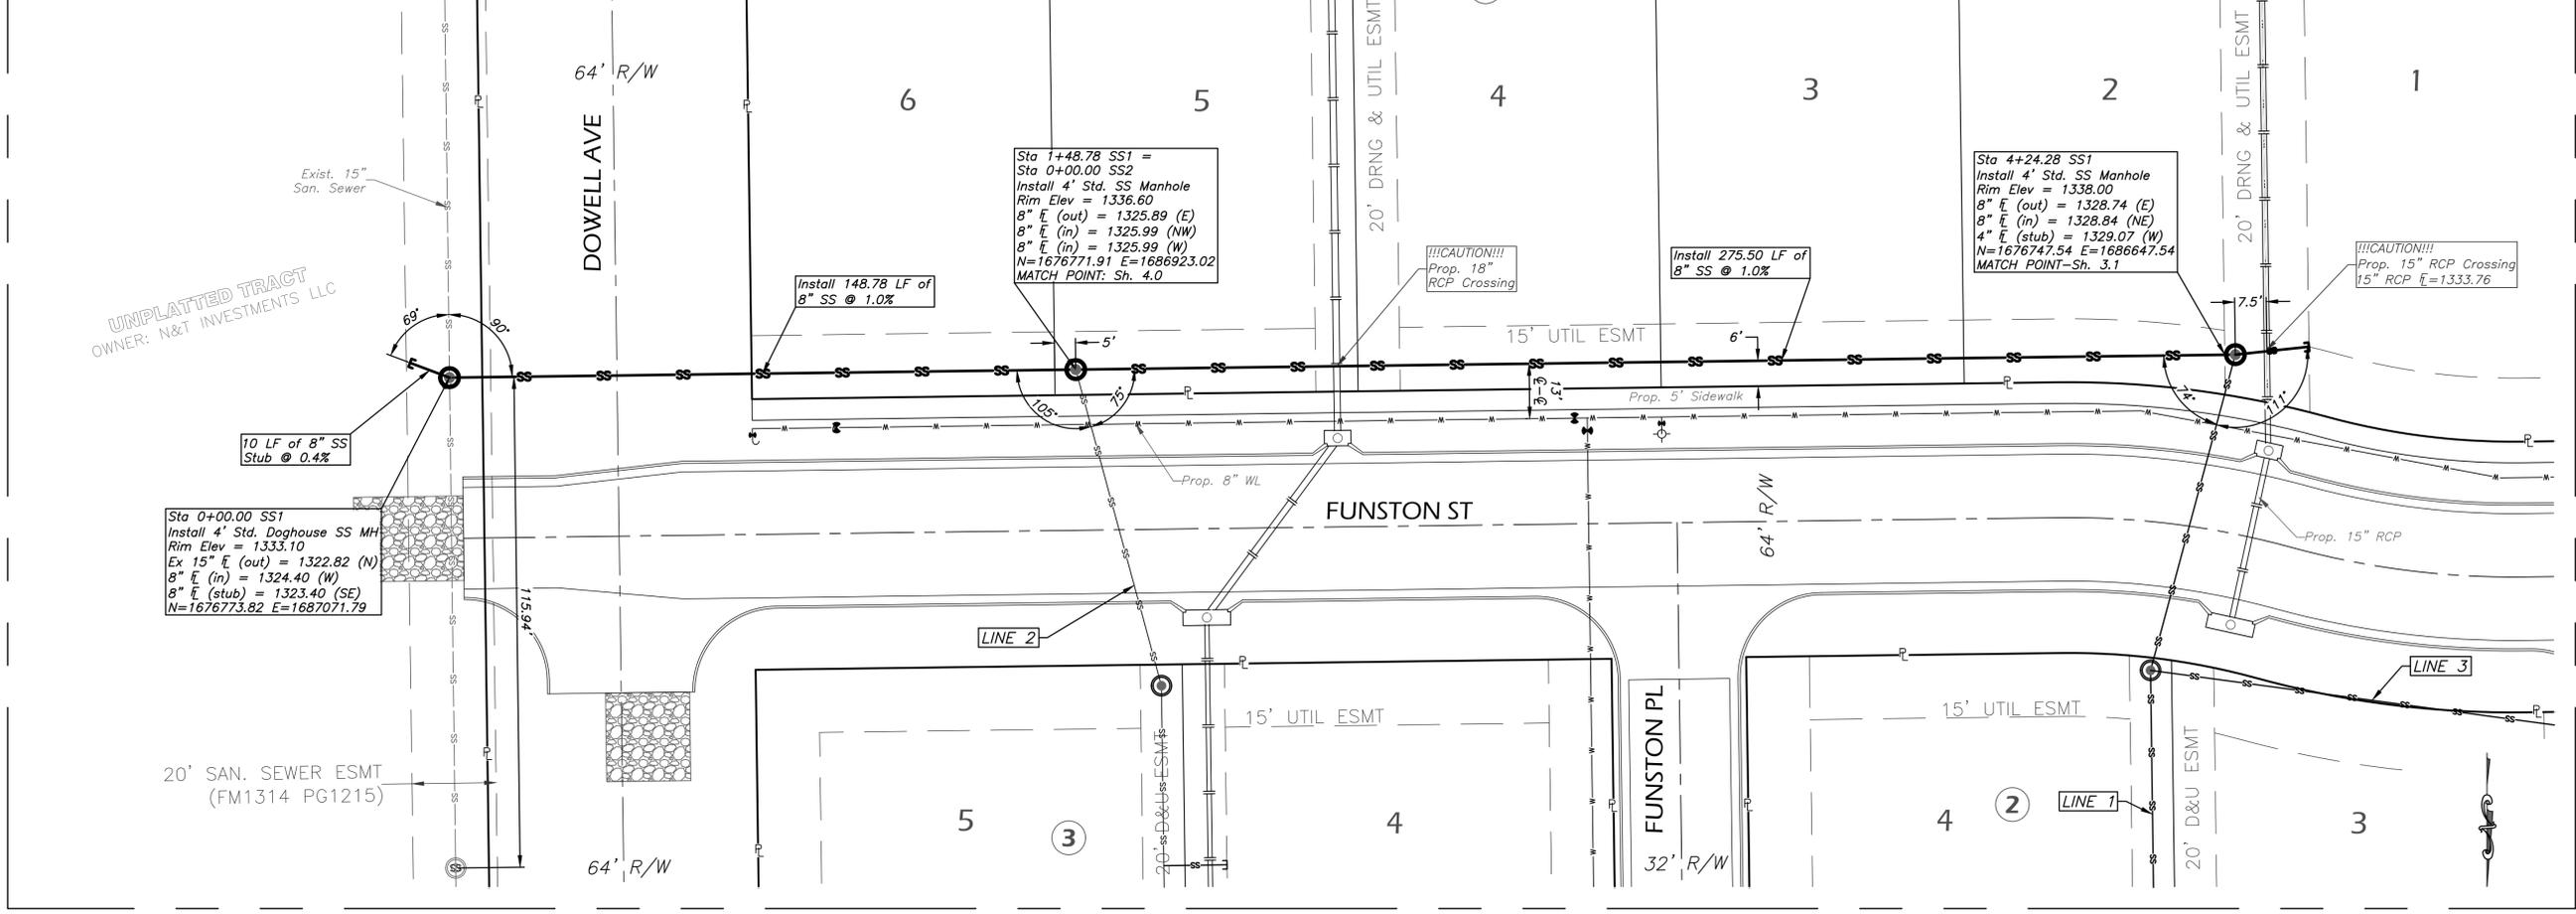

REVISIONS	
ADDENDUM #1	10.14.2025


KEM PROJ. 21177	DATE 08.2025
DESIGNED ZJS	DRAWN ZJS

Plan & Profile Line 1



THIS SHEET HAS BEEN SIGNED, SEALED AND DATED DIGITALLY

SANITARY SEWER
GREENWICH LEGACY ADDITION
 WICHITA, KANSAS


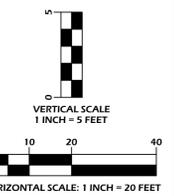


REVISIONS	
ADDENDUM #1	10.14.2025

KEM PROJ. 21177	DATE 08.2025
DESIGNED ZJS	DRAWN ZJS


Plan & Profile Line 1

SHEET **3.1**

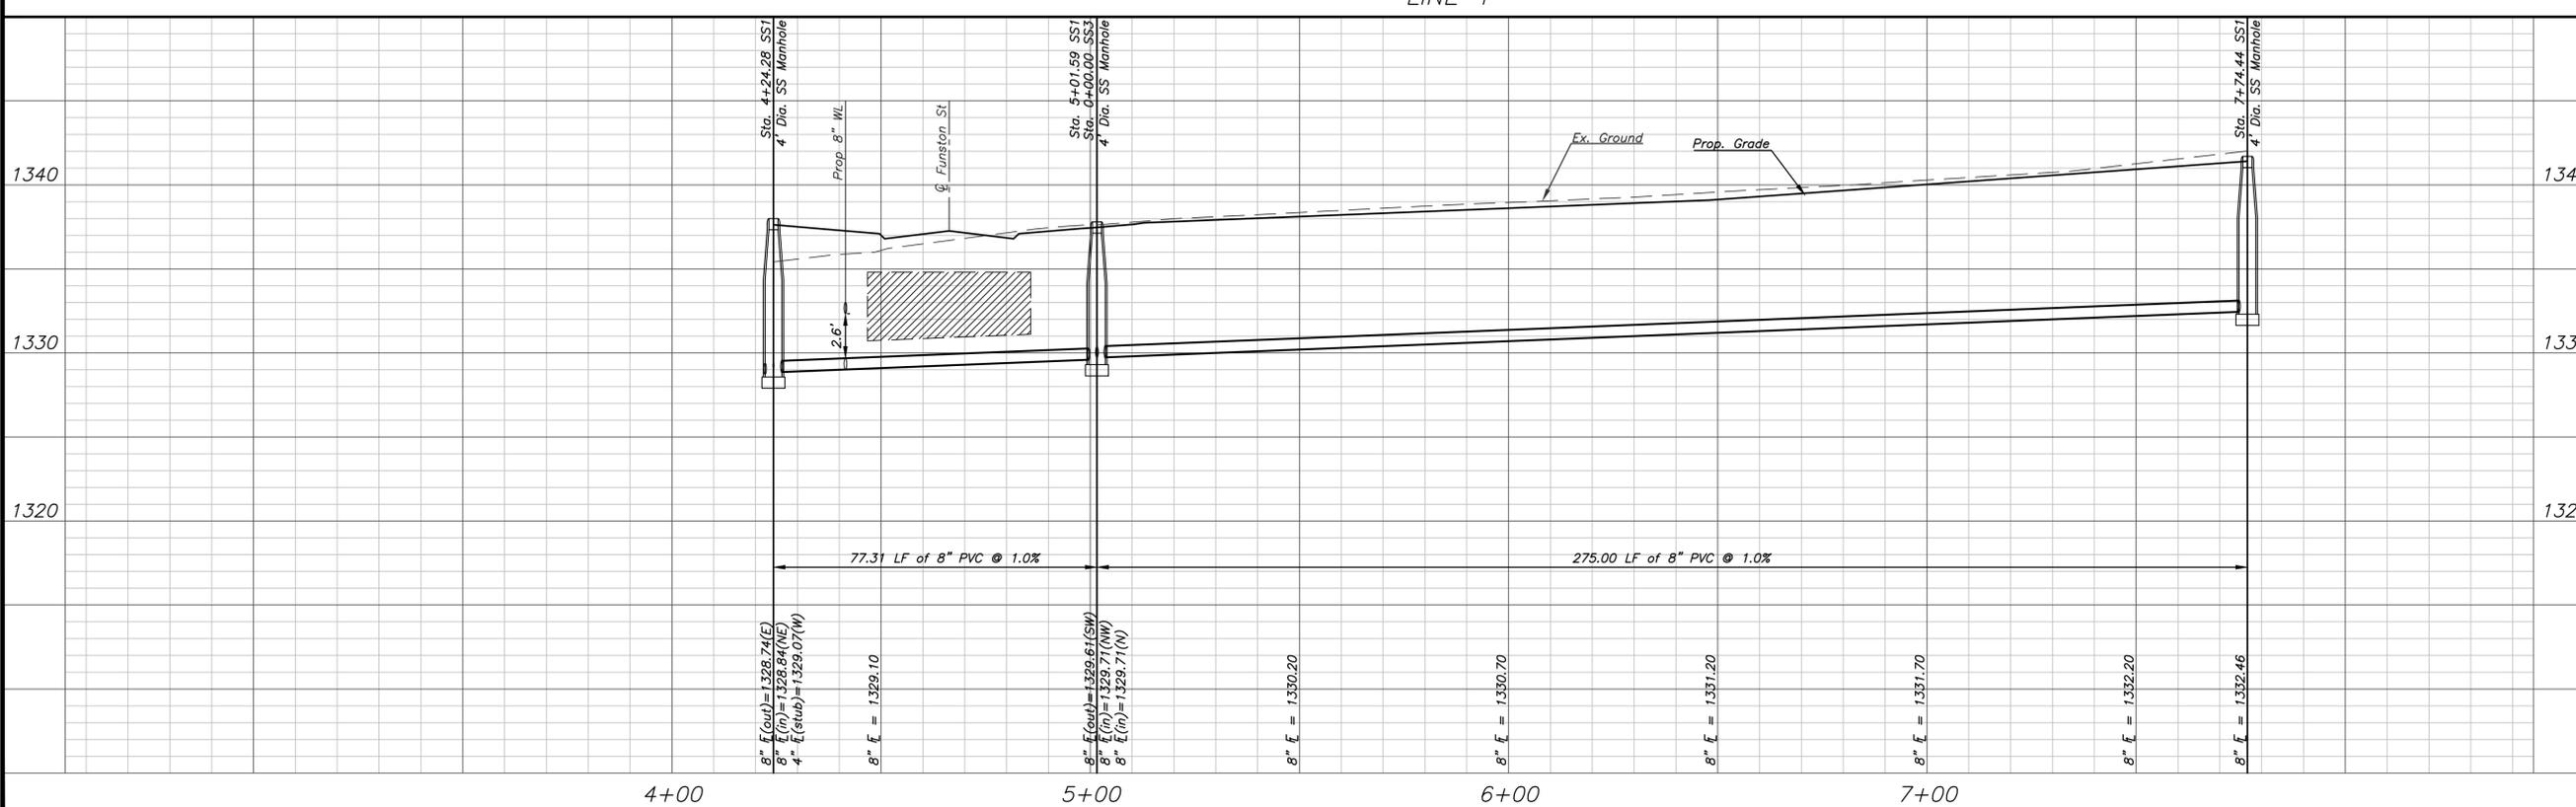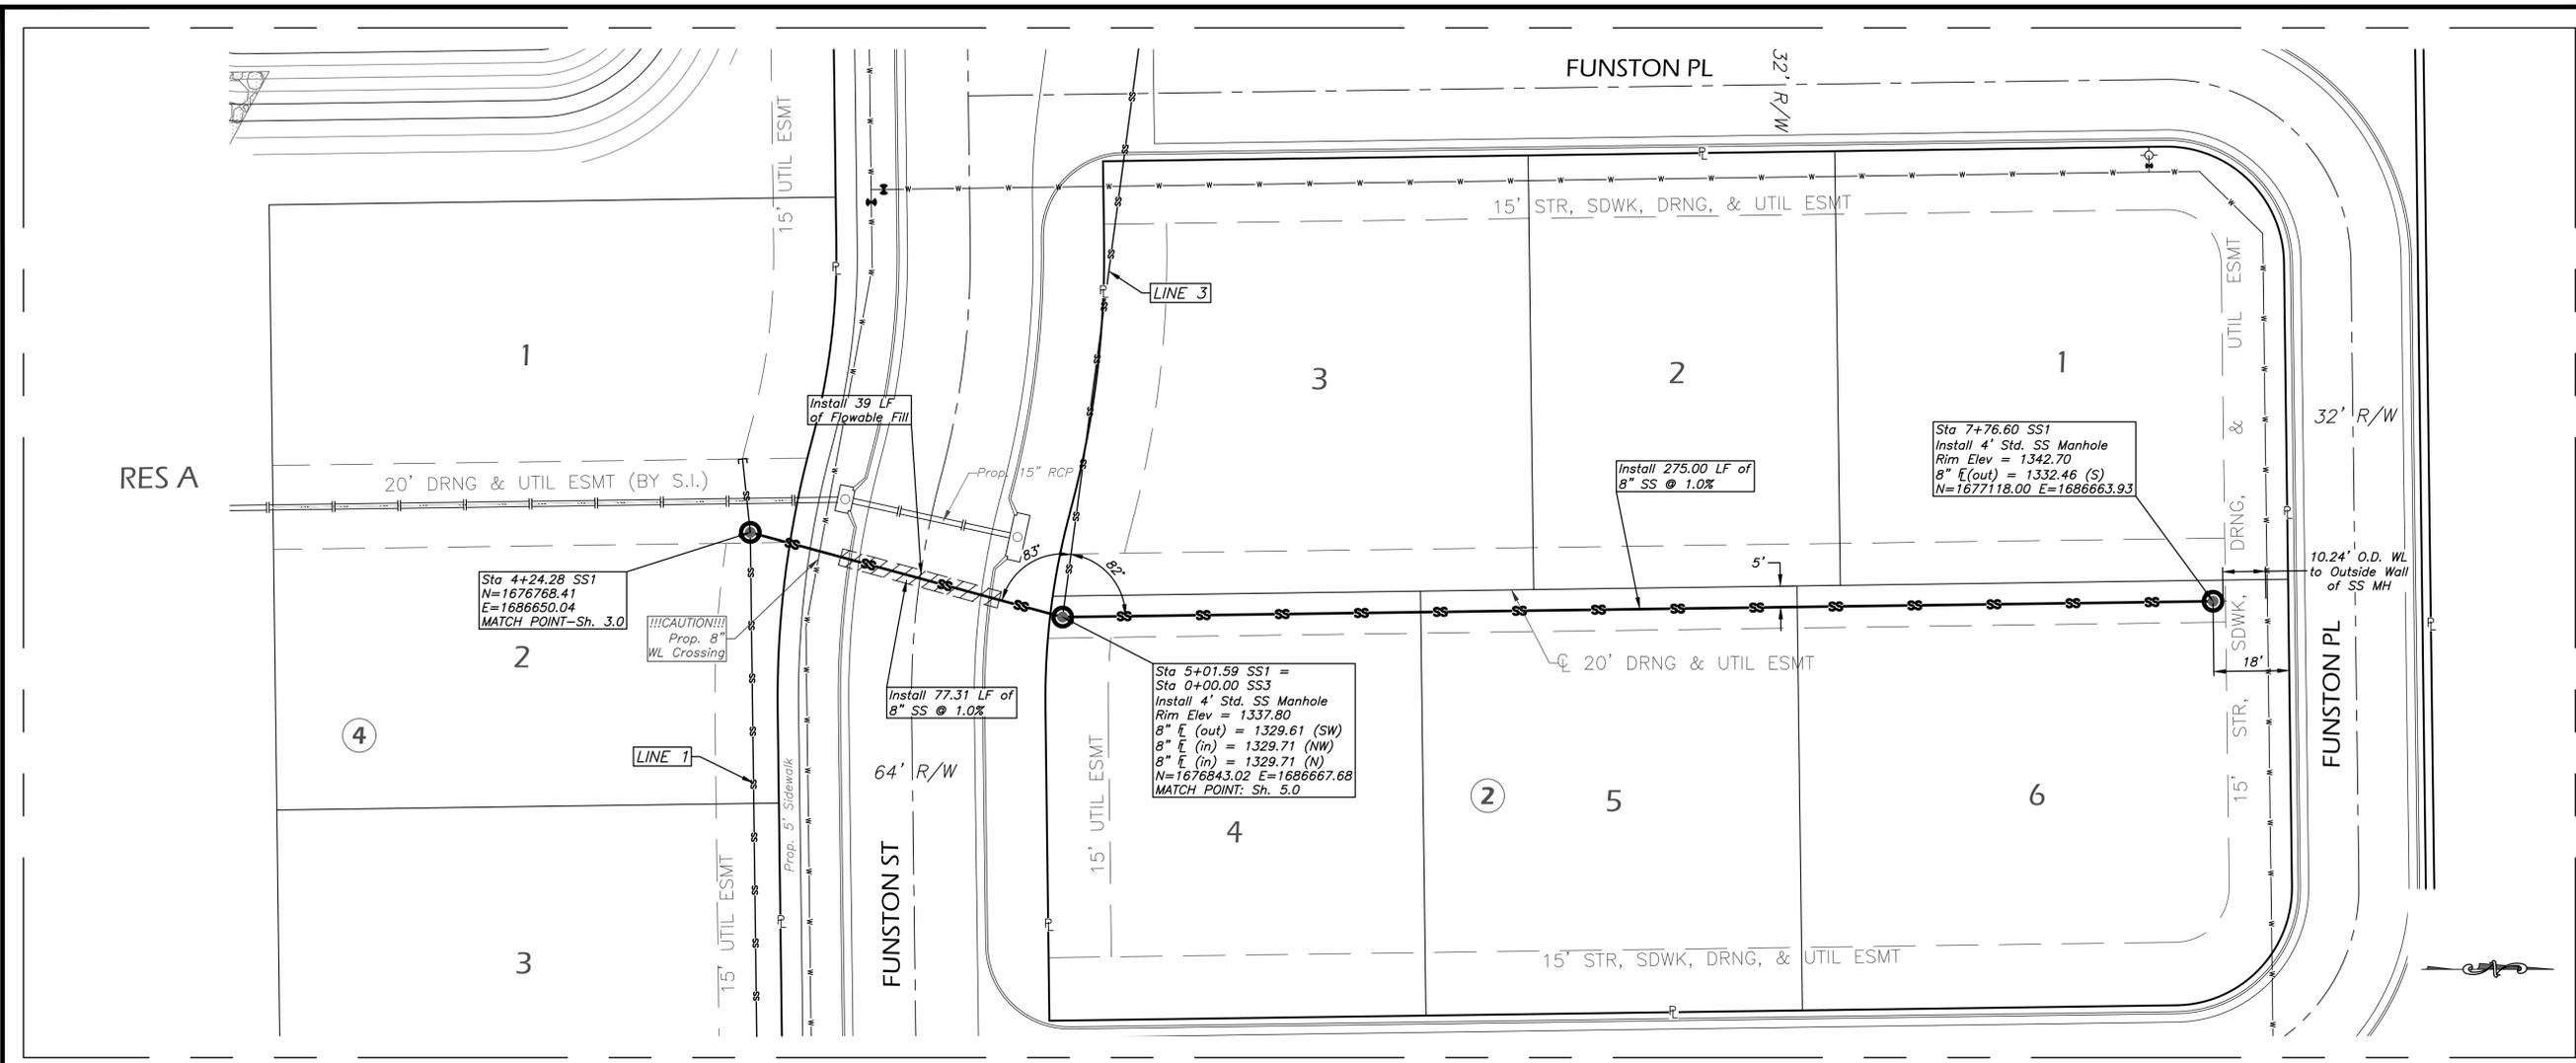



SANITARY SEWER
GREENWICH LEGACY ADDITION
 WICHITA, KANSAS

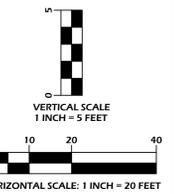

REVISIONS	
▲	ADDENDUM #1 10.14.2025

KEM PROJ. 21177	DATE 08.2025
DESIGNED ZJS	DRAWN ZJS

Plan & Profile
Line 3

SHEET **5.0**

