

6-3

B.M. 145.99 "M" in Mueller Fire Hds. Waverly & Grand
B.M. 145.98 "M" in Mueller Fire Hds. NW cor. Waverly & Zimmermanly


SHEET No. 1

Property	CITY
33.0	497
40.0	773
42.6	725.0
55.0	
62.0	
69.0	
113.0	
124.9	
371.5	
373.5	
400.5	
299.3	
155.7	
74.4	
61.3	
2275.3	

SCALE 1"=20'


GRAND TOTALS

PROPERTY	CITY
2075.3	125.0
377.8	452.4
911.9	27.9
3366.0	577.4
3366.0	577.4
3702.6	710% 577
	635.1 imp. etc.

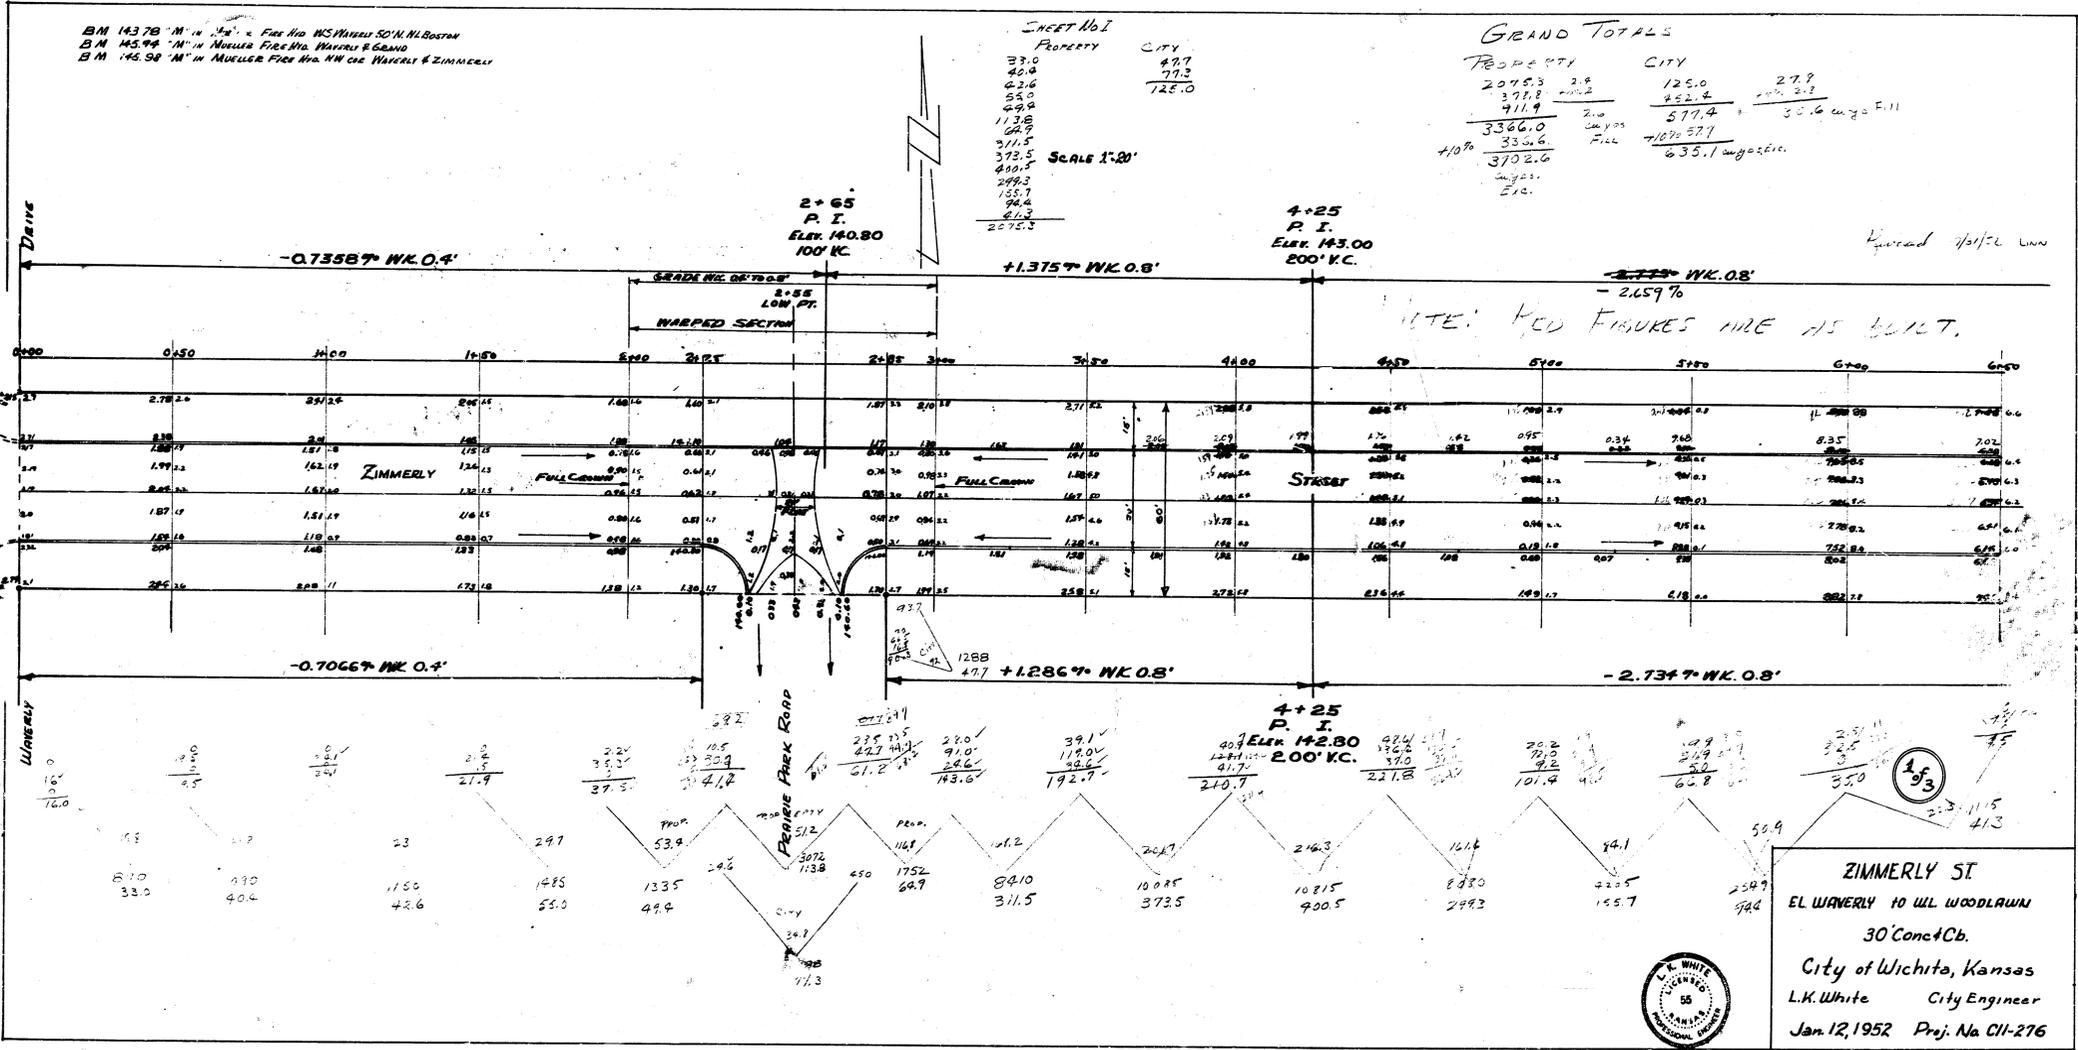

SHEET No 2 T-113
 PROPERTY 2.6 acres
 22.0
 14.1
 2.1
 45.8
 75.0
 110.5
 67.7
 377.8
 29.8
 27.8
 29.3
 13.3
 52.9
 29.1
 207.1
 457.2
 212.

SCALE 1"=20'

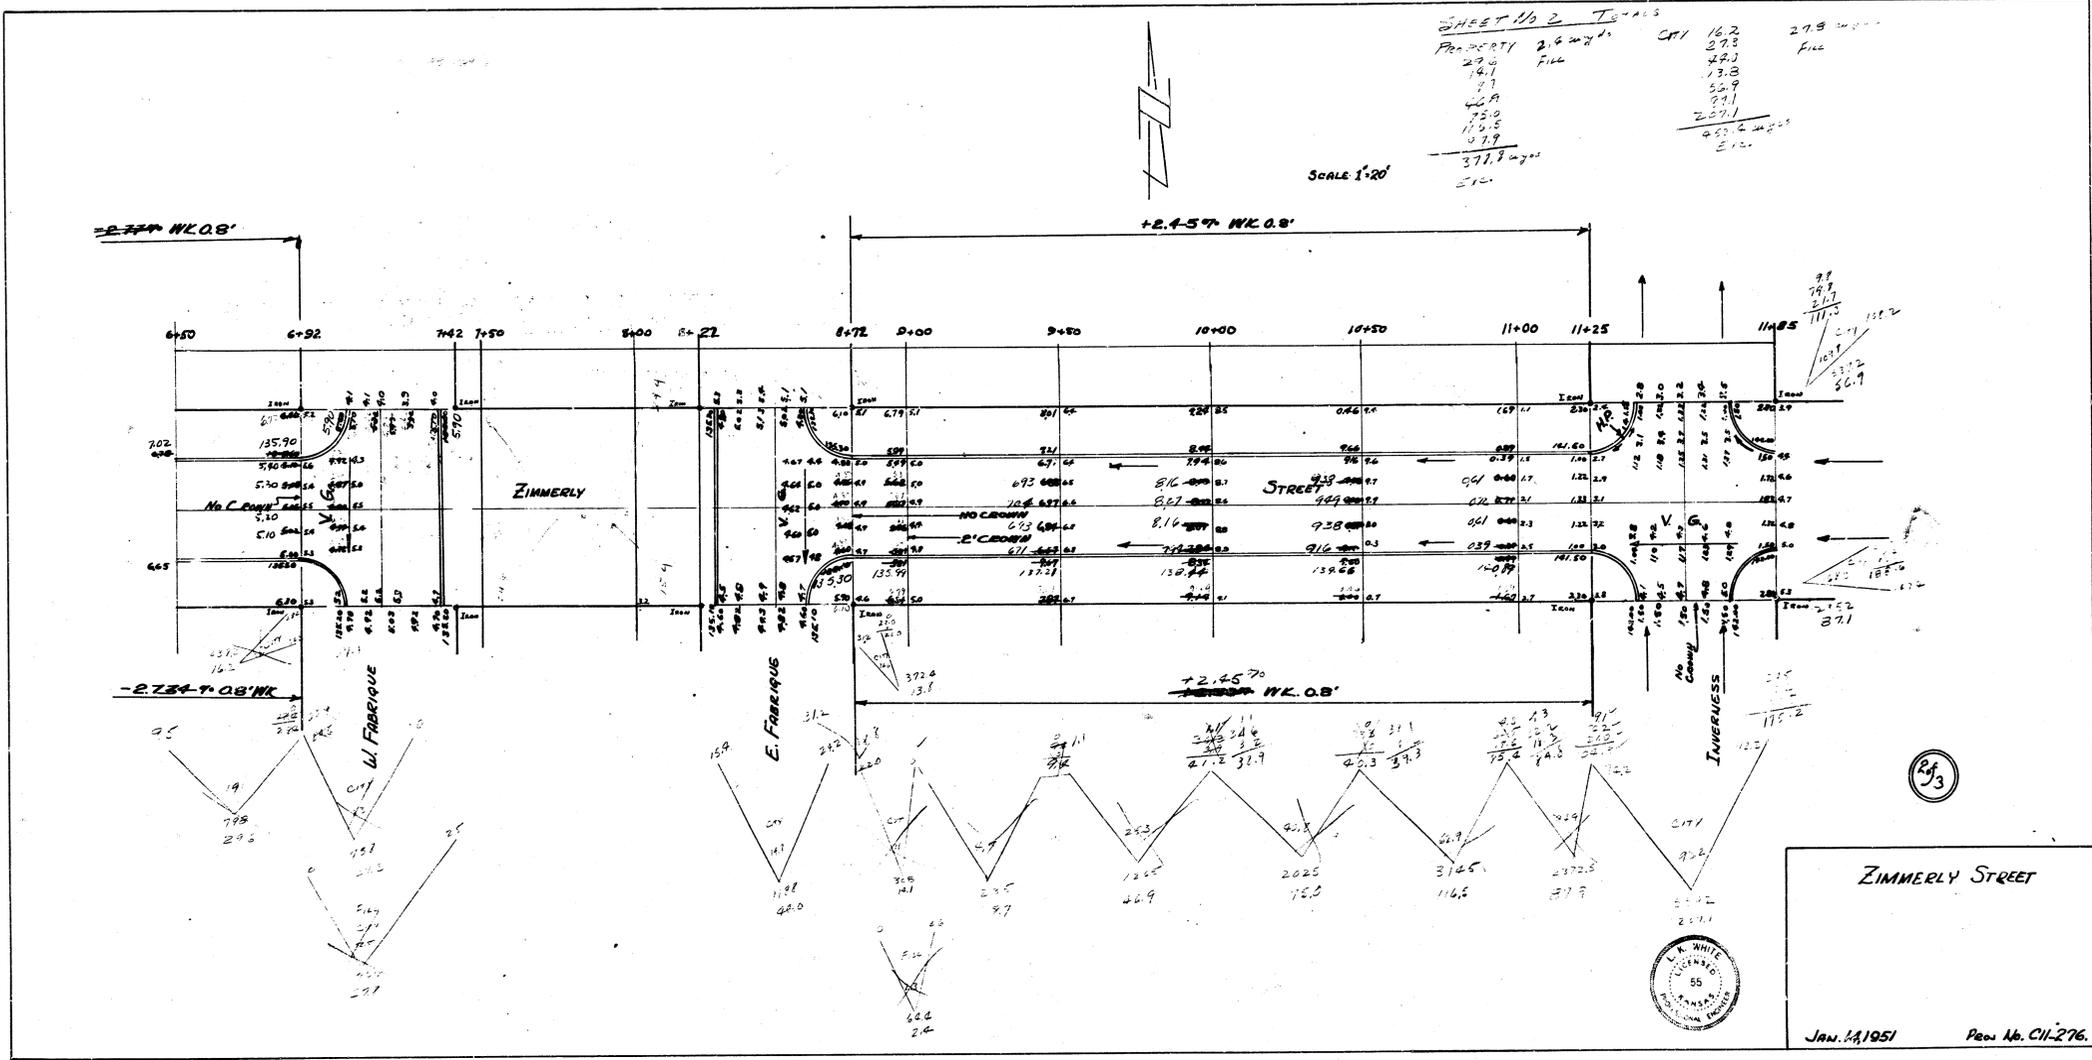


ZIMMERLY STREET
 Jan. 14, 1951
 Plan No. C11-276



SM. 8
 PROPERTY
 102.8
 272.8
 102.8
 127.3

 711.9 changes ETC.

SCALE 1"=20'

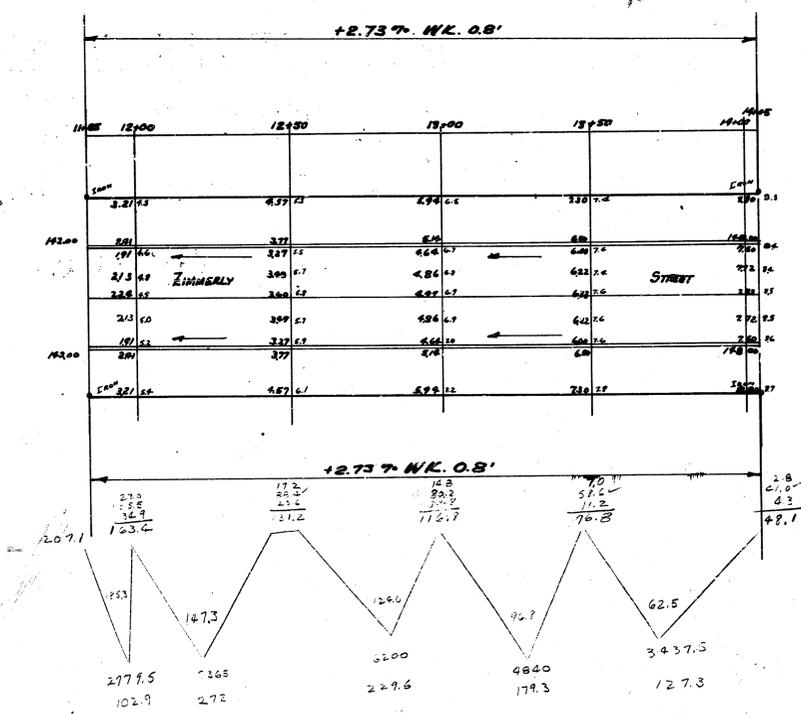

3/3

ZIMMERLY STREET



JAN. 14, 1951 Proj. No. CI-276