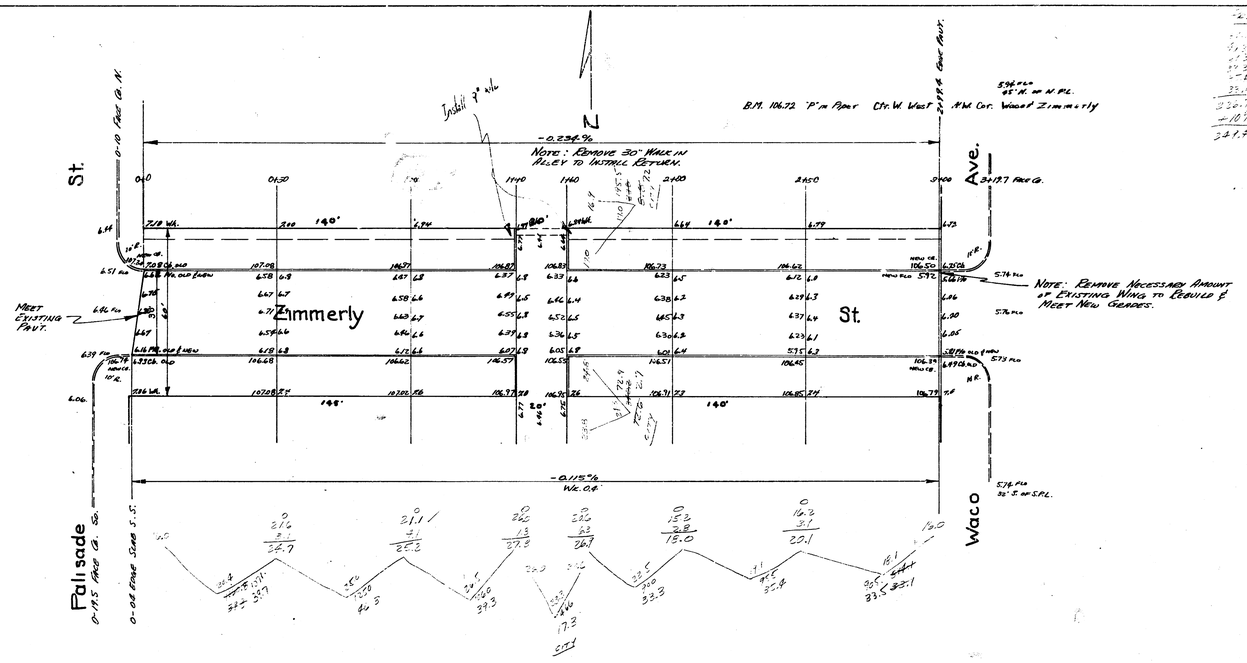

Zimmerly St.
E.L. Palisade ~ W.L. Waco
30' Conc. & Cb.
City of Wichita, Kansas
L.K. White ~ City Engineer
April 1949 Proj. #C-19-40