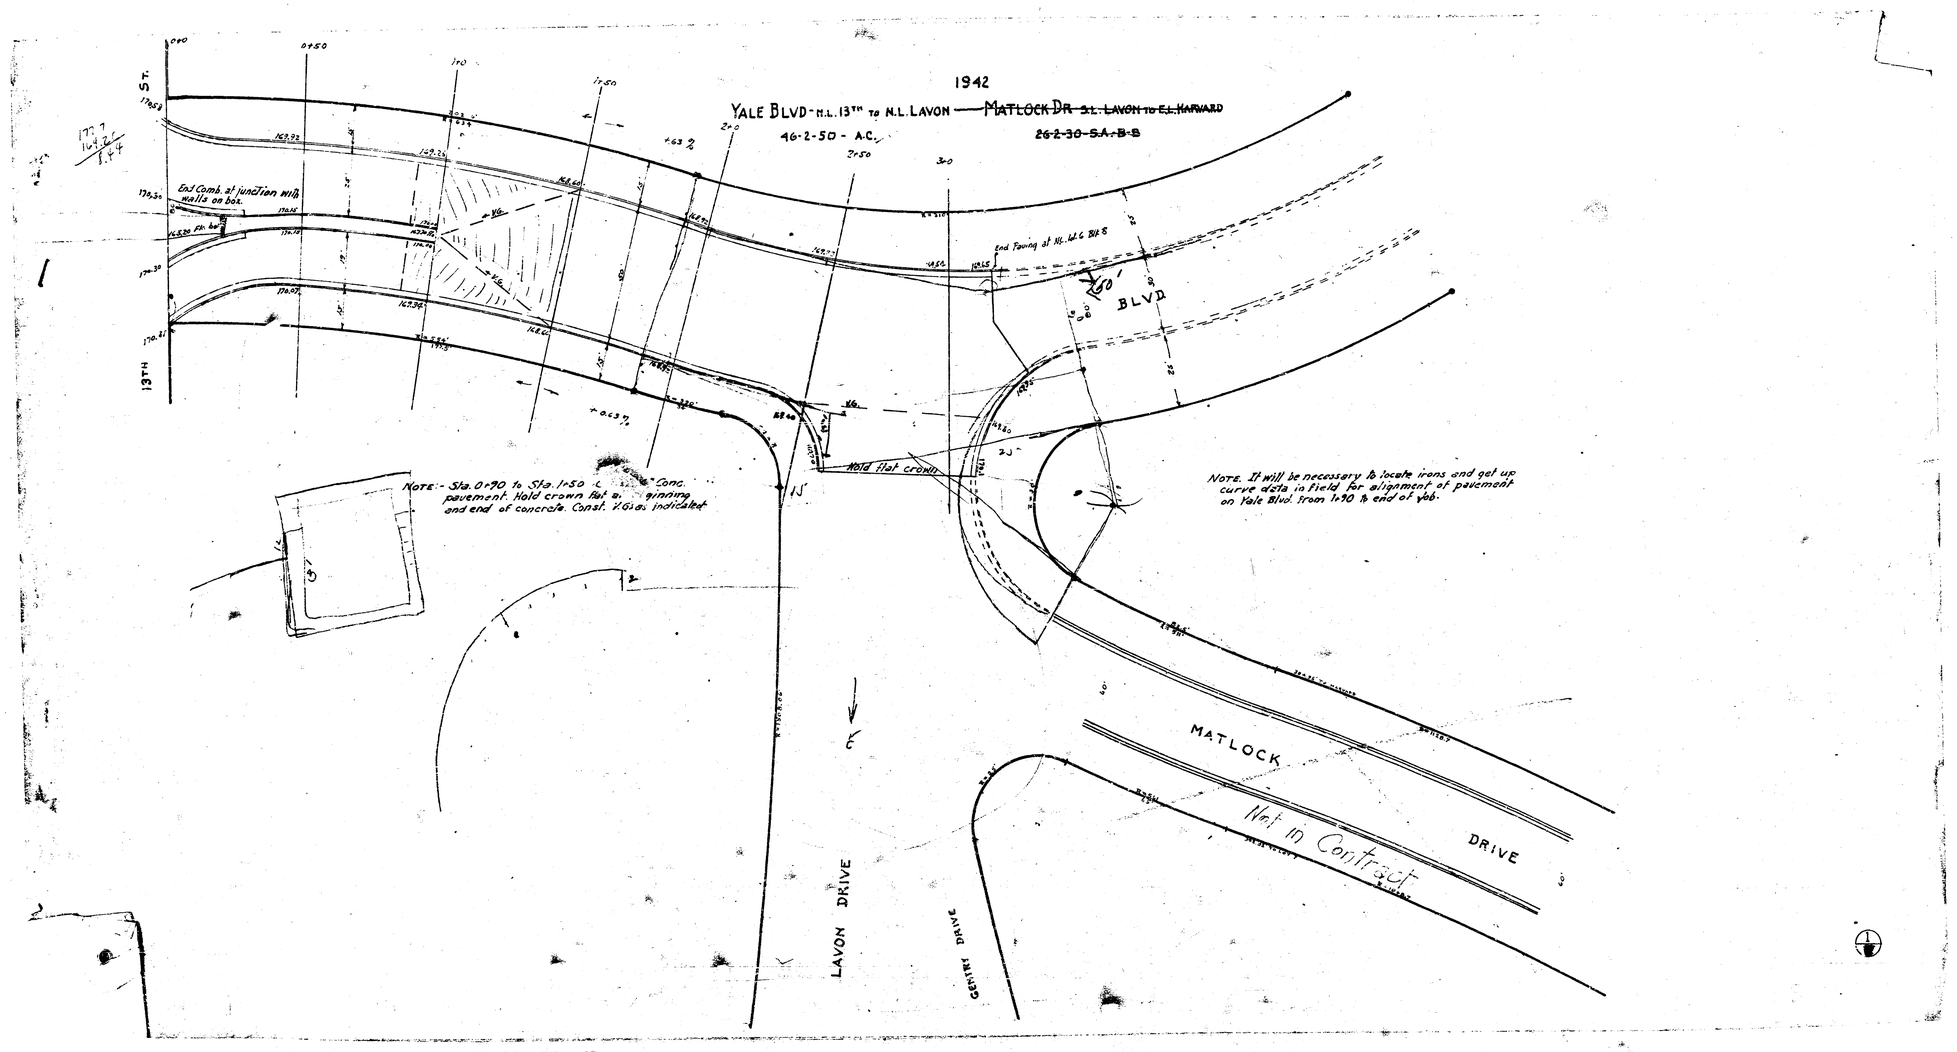
1942
YALE BLVD - N.L. 13TH TO N.L. LAVON — MATLOCK DR ~~S.L. LAVON TO E.L. HARVARD~~
46-2-50 - A.C.
~~26-2-30 - S.A.B.S~~
13TH ST.
End Comb. at junction with walls on box.
End Paving at N.L. Lot 6 Blk 8
60'
BLVD
Hold flat crown
NOTE:- Sta. 0+90 to Sta. 1+50 is Conc. pavement. Hold crown flat at beginning and end of concrete. Const. ½ Gas indicated
NOTE. It will be necessary to locate irons and get up curve data in field for alignment of pavement on Yale Blvd. from 1+90 to end of job.
MATLOCK
DRIVE
Not in Contract
LAVON DRIVE
CENTER DRIVE