
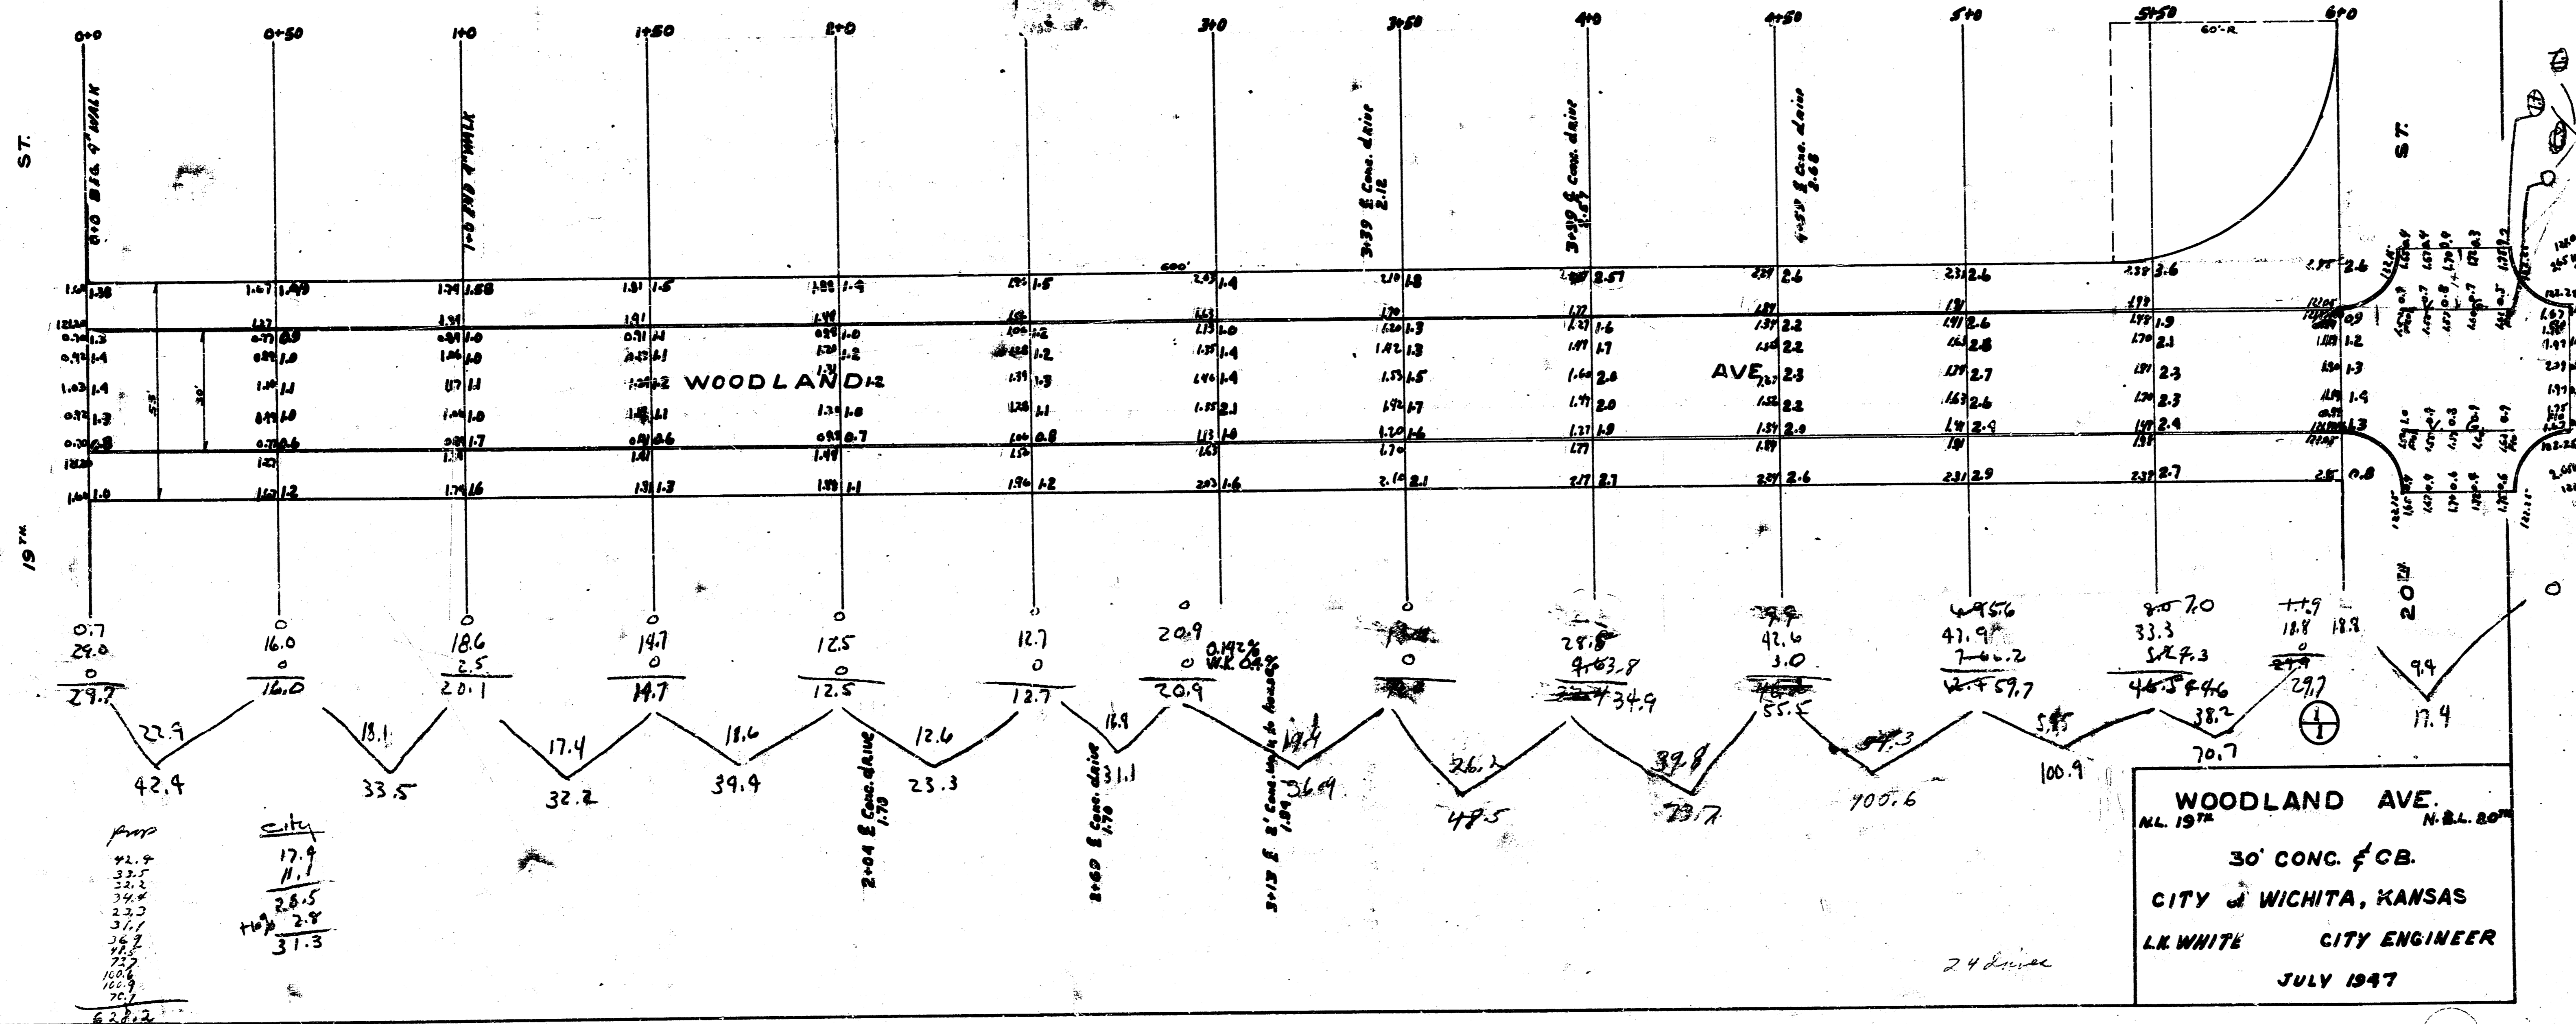


Per
K. S. White (Final Map)
Date 7/10

B.M. 121.40 "Y" on front of vic. S.W. cor. 19th & Woodland
B.M. 125.75 Top of concrete E. 2nd Woodland of S.S. 28th.

VIC. OF
0.1% %

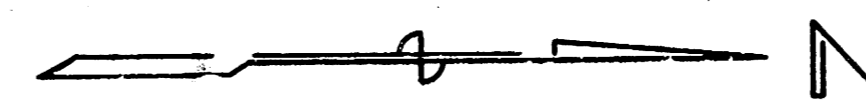

WOODLAND AVE.
N.L. 19th N.E.L. 20th
30' CONC. & CB.
CITY OF WICHITA, KANSAS
L.K. WHITE CITY ENGINEER
JULY 1947

Prop
41.9
37.5
35.2
34.4
33.0
31.1
