


BM: 150.73 "+" on Top Curb N.S. Zimmerly - 3' W of WL Eastmoor.

NOTICE:-
HALF INTERSECTIONS ON PROJ. NO. C18-50
NOT PART OF PRIVATE CONTRACT.

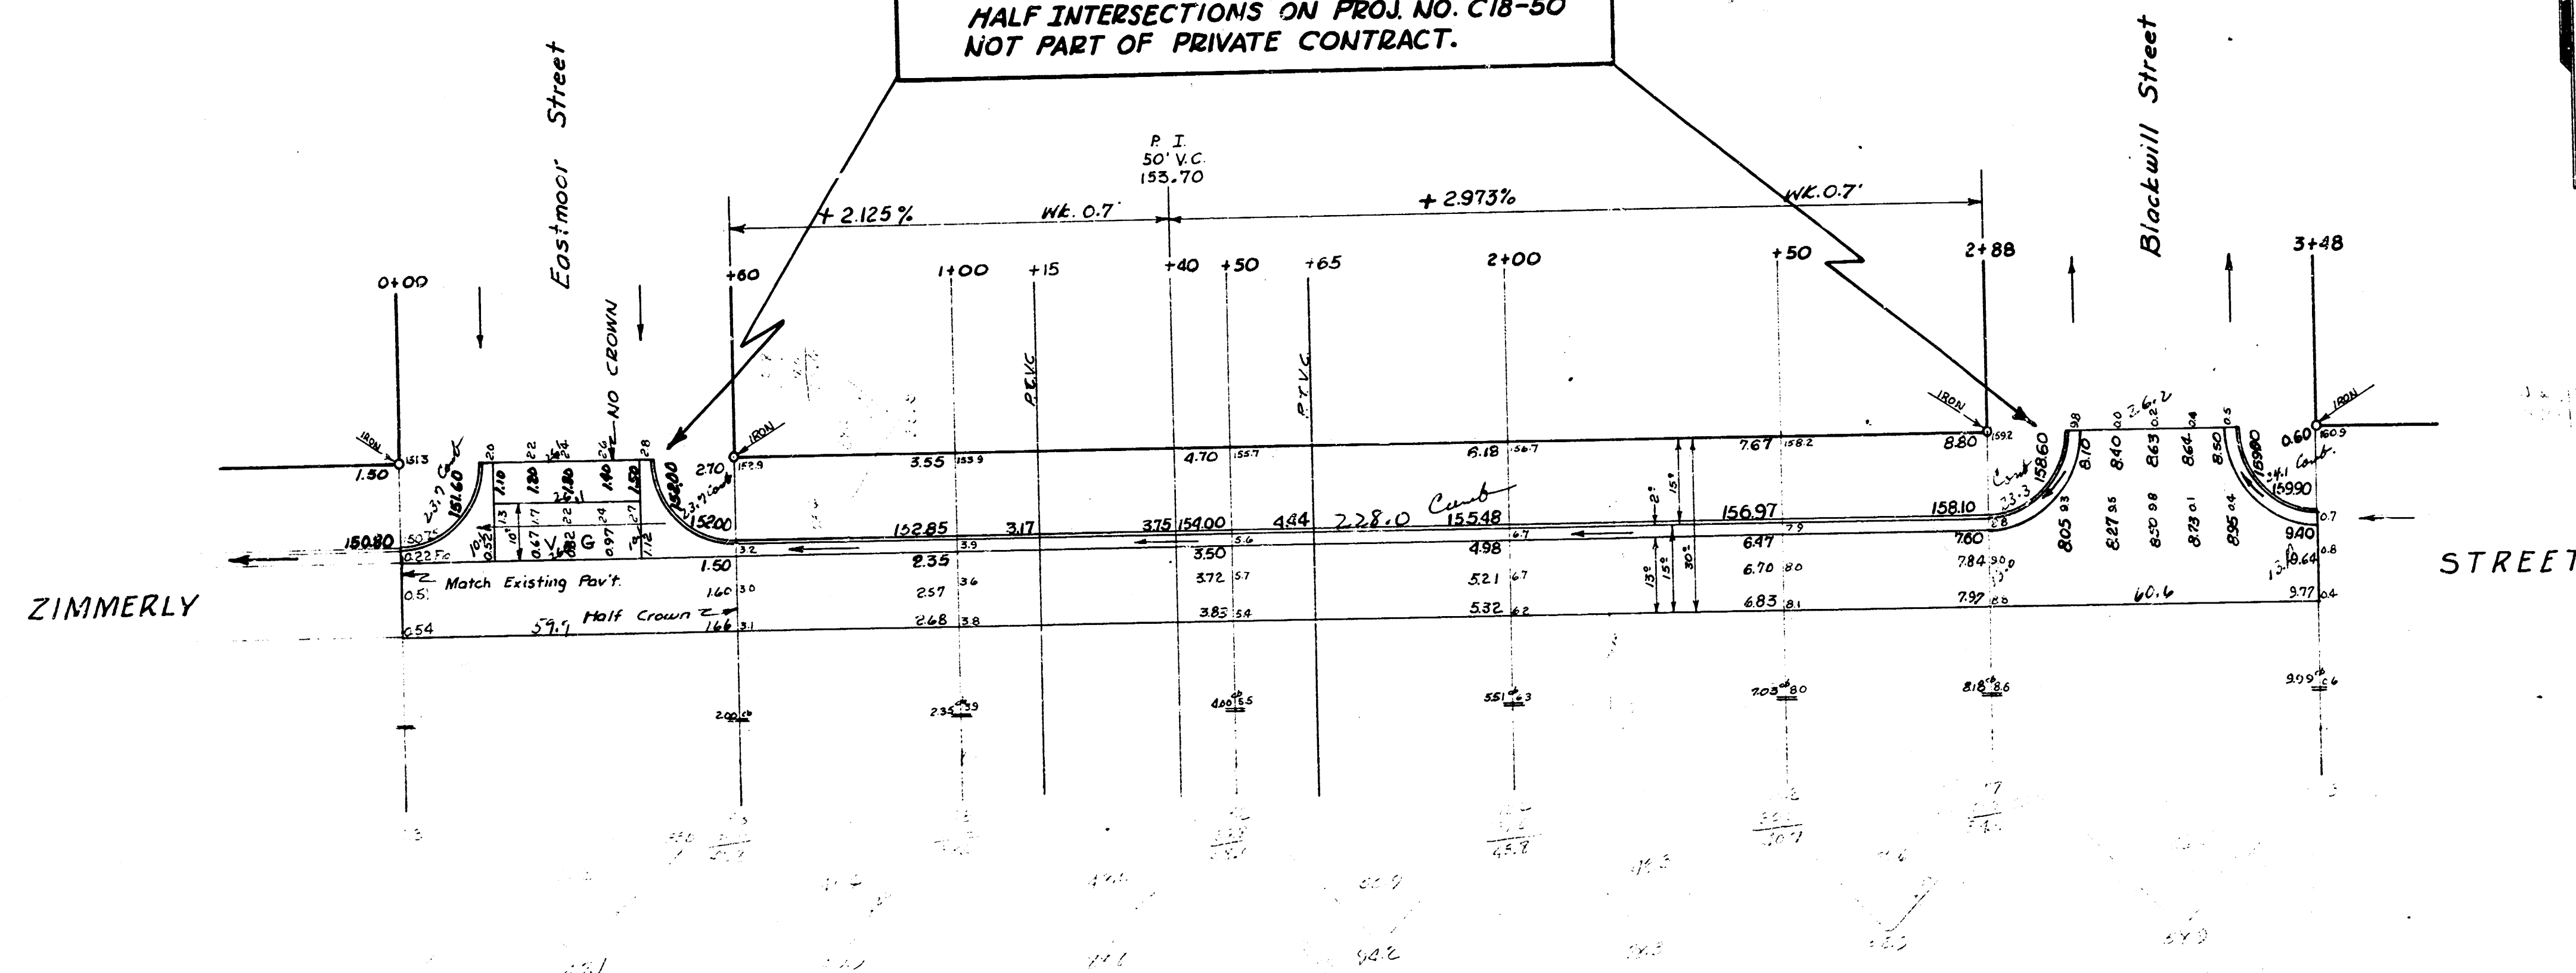

ESTIMATE OF QUANTITIES			
No Drawings figured or deductions made for same.			
Quantity	Unit	Item	Final Quantity
329.3	Sq yds	Asph. Conc. Pav't.	
	Sq yds	7" Conc. Pav't.	
	Sq. Ft.	Valley gutter	
228.0	Ls. Ft.	Combined Chd Gut.	
374.1	Cu yds	Excavation	
1140.0	Lbs	Reinf. Steel	

Note: The 1/2 lot of Blackwill's
Eastmoor was a part of proj. C18-50
There is no separate plan on C18-50

ZIMMERLY STREET
WL Eastmoor to EL Blackwill
13-2-15 AC
CITY OF WICHITA, KANSAS
B.E. SMITH CITY ENGINEER
PRIVATE JOB.