BM 102.86 Iron in Thim. ℄ Greenwood ± S.S. Zimmerly

BM. 102.58 Iron in Thim. ℄ Hydraulic ± Zimmerly

Property	Cut
38.6	1
46.7	10.1
52.4	10.4
46.6	19.3
45.3	39.8
36.1	+10% 9.3
327.8	43.8 cu yds
+10% 28.8	
357.6 cu yds Excavation	

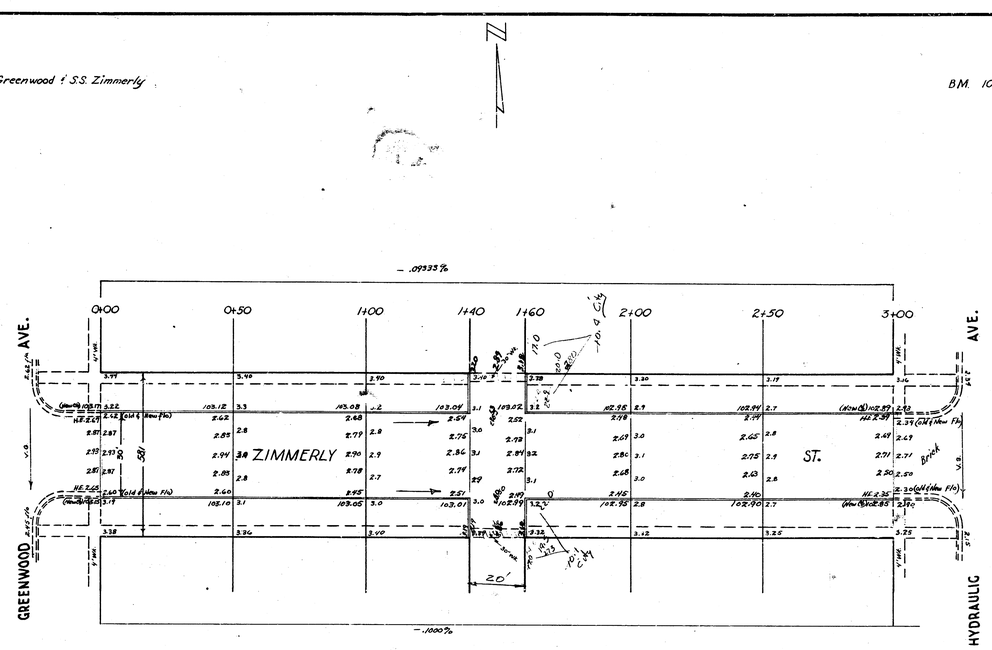

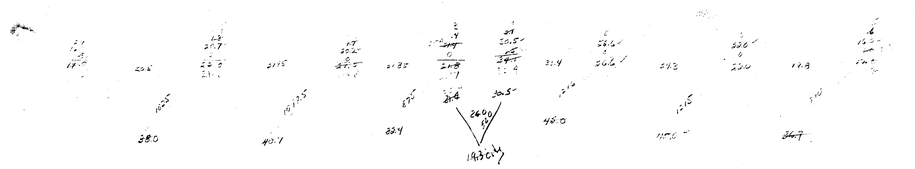

4 dr

L. K. WHITE LICENSED 35 KANSAS PROFESSIONAL ENGINEER

ZIMMERLY STREET

E.L. Greenwood to W.L. Hydraulic

30' Conc. & Cb.

CITY OF WICHITA, KANSAS

L. K. WHITE CITY ENGINEER

NOV. 1950, PROJ. NO. C10-162