


OF SHEETS




UTILITY/GRADING PLAN
1" = 20'-0"

**OBLINGER
MASON
McLIGGAGE
& VAN SICKLE
CORPORATION**

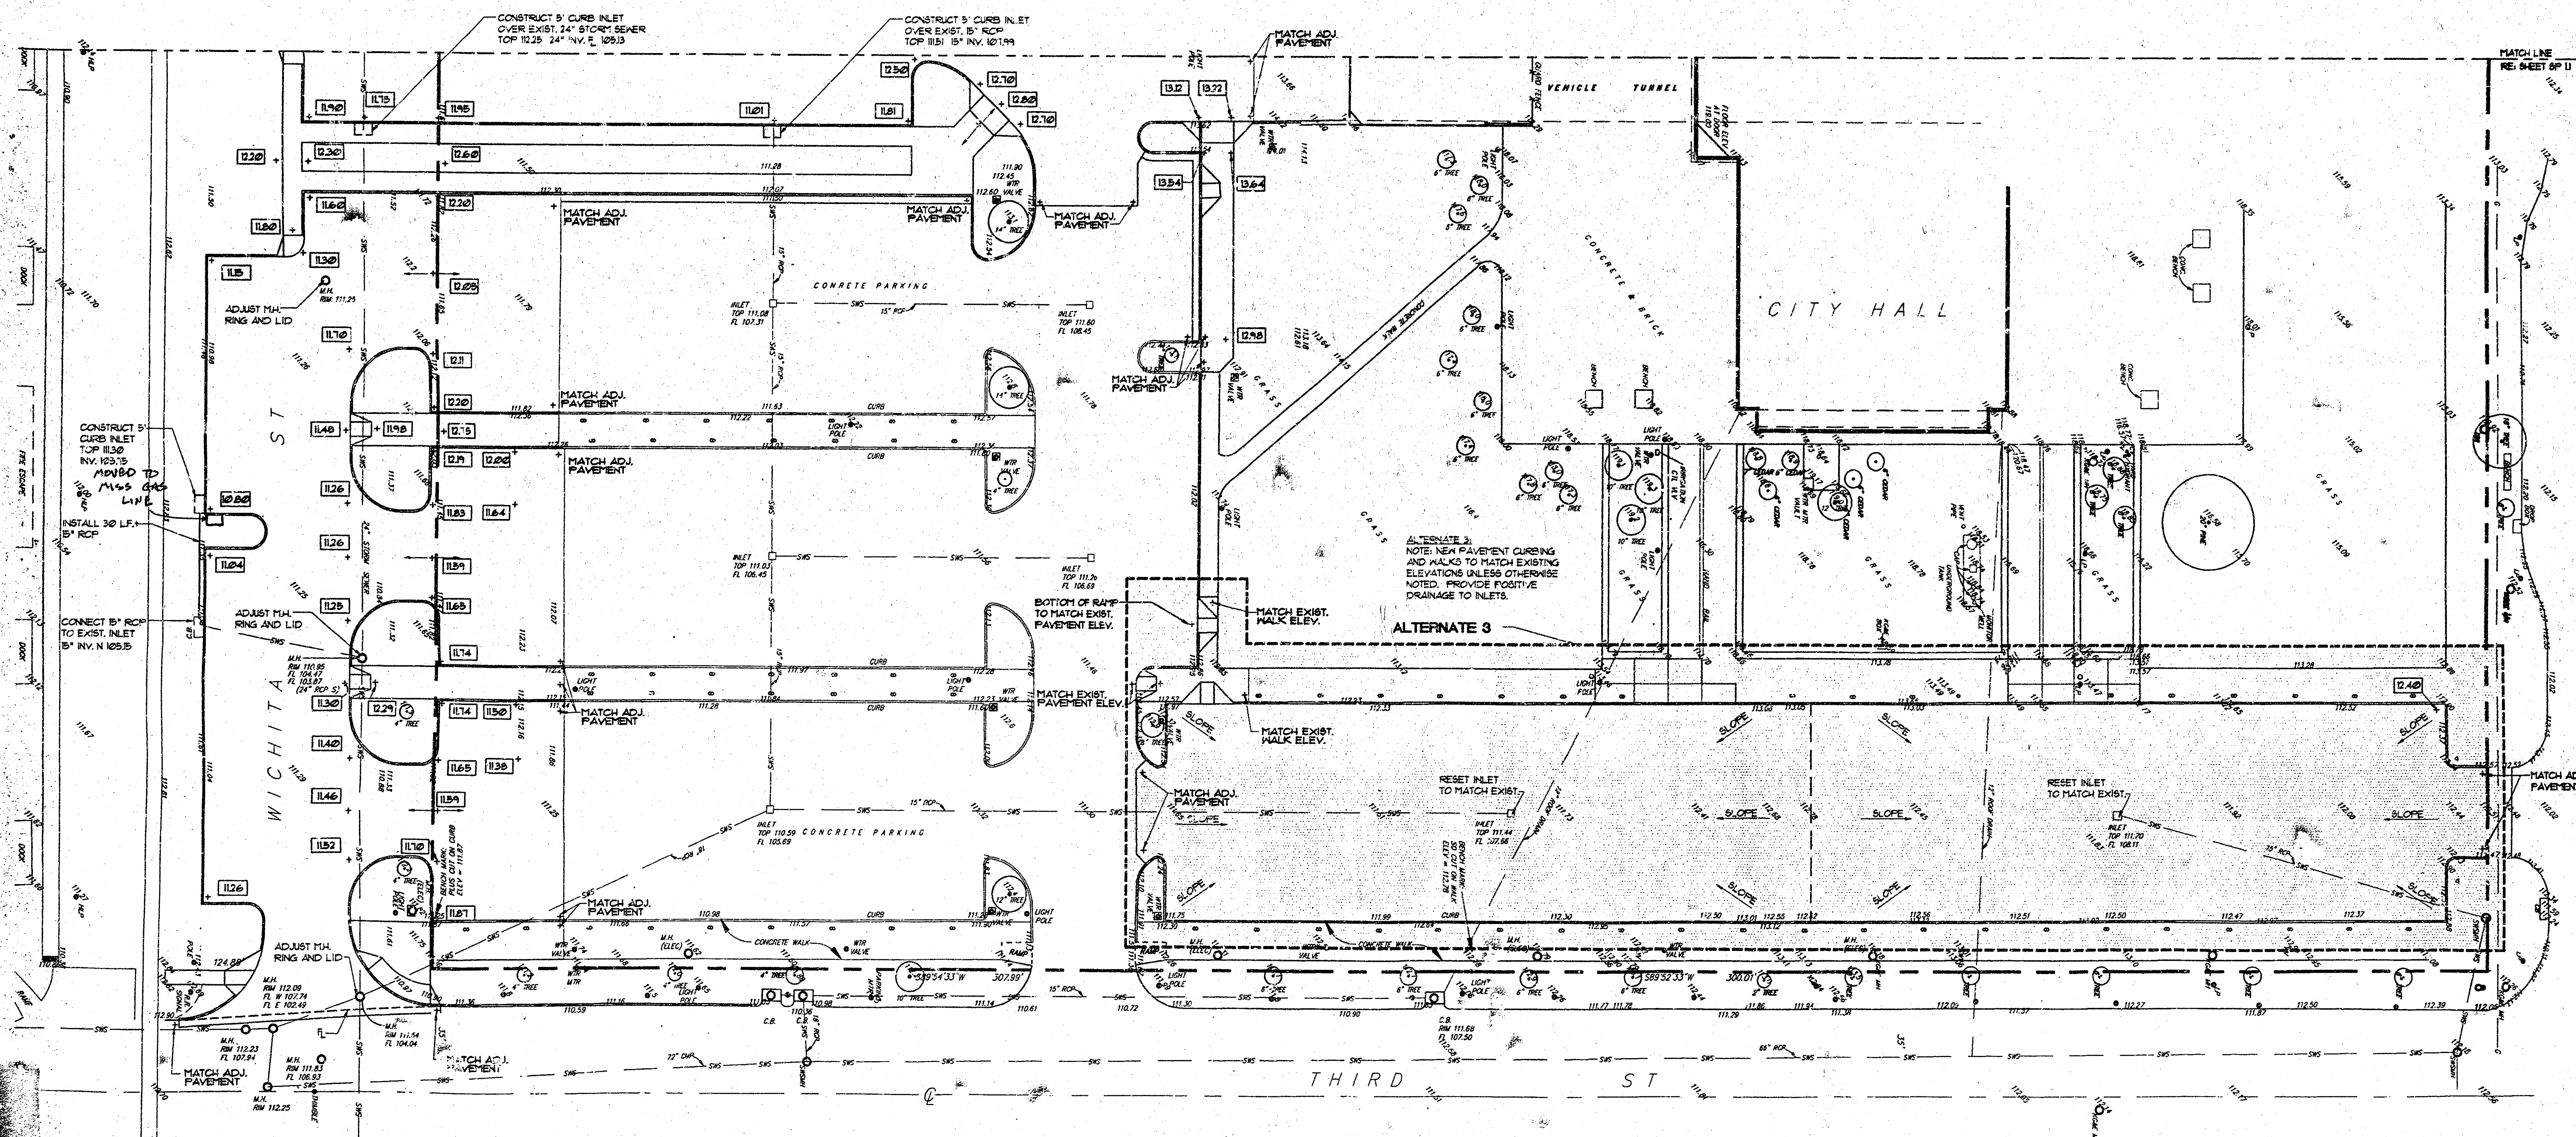

Architects, Engineers, Landscapers & Architects
P.O. Box 8848
Wichita, Kansas 67201
180 S. Washington
Wichita, Kansas 67202
(316) 862-0481
(316) 862-0485 FAX

**CITY HALL PARKING STRUCTURE
CITY OF WICHITA
WICHITA, KANSAS**

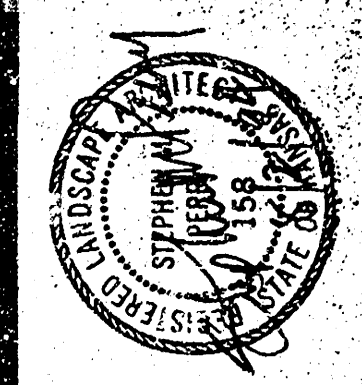

PROJECT NO. 923
DATE: AUGUST 2, 1994
REVISION:
DRAWN: CHECKED:

**SHEET
SP1.2
OF SHEETS**