

SEE REVISED SHEET



SEWER SERVICE TABLE

NUMBER	TYPE	LOCATION			FOR INFORMATION ONLY		
		LOT NO.	BLOCK NO.	LINE NO.	STATION \ DIRECTION	APPROXIMATE LENGTH 4" PIPE	
1	8" X 4" Tee Saddle	50	-	1	11+41/R	8'	10'
2	8" X 4" Tee Saddle	51	-	1	12+28/R	9'	10'
3	8" X 4" Tee Saddle	52	-	1	13+03/R	10'	10'
4	4" MH Riser	53	-	1	13+65/R	11'	10'
5	8" X 4" Tee Saddle	54	-	-	13+85/R	10'	10'
6	8" X 4" Tee Saddle	55	-	1	14+62/R	8'	10'
7	8" X 4" Tee Saddle	9	3	1	18+91/L	8'	10'

NOTE: Vertical Riser Pipe shall be extended to 2' minimum above ground water elevation and 4' maximum below proposed ground elevation.



SCALE 1" = 40' HORIZ.
1" = 5' VERT.
IRON = ●

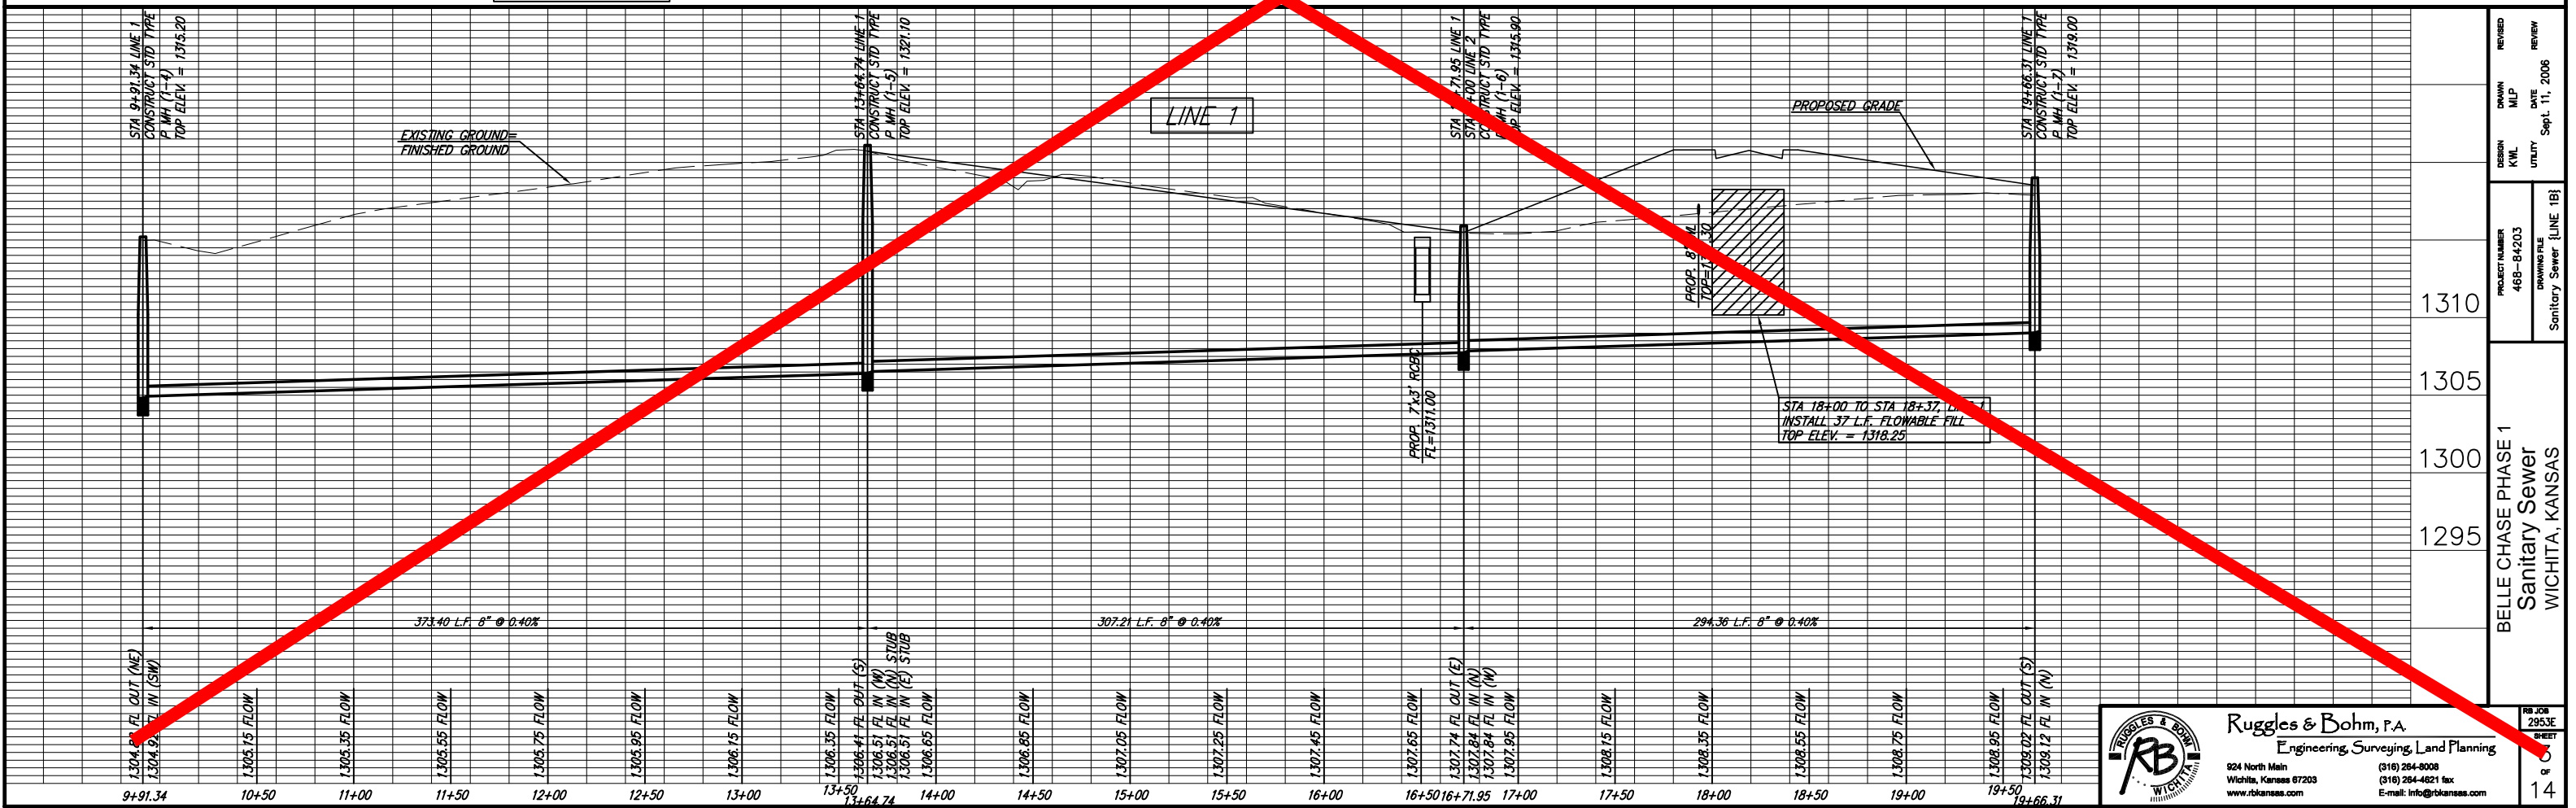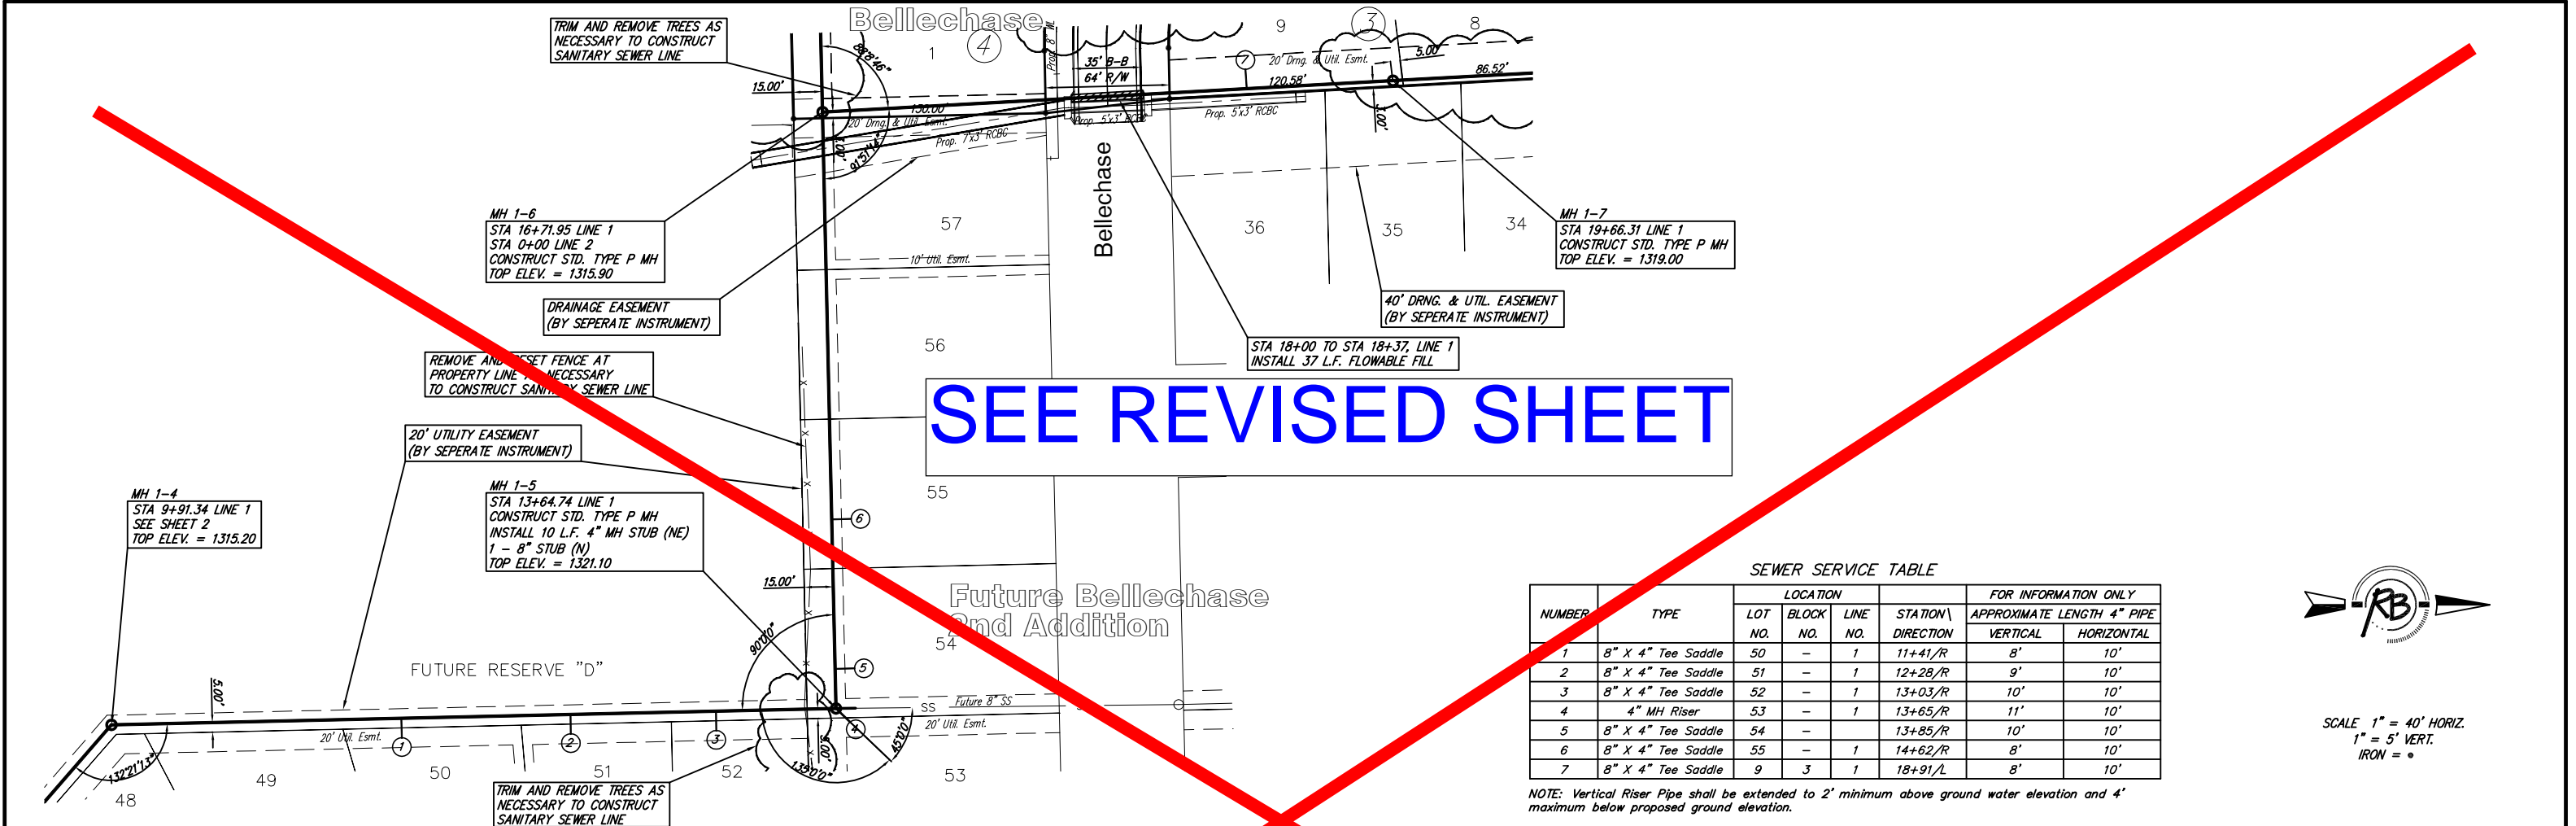

REVISIONS

NO.	DATE	BY	REVISION
1	Sept. 11, 2006	MLP	REVISED

DESIGN: KWL
DRAWING FILE: Sanitary Sewer [LINE 1B].
PROJECT NUMBER: 468-84203

BELLE CHASE PHASE 1
Sanitary Sewer
WICHITA, KANSAS

RB JOB 2953E
SHEET 14

Ruggles & Bohm, P.A.
Engineering, Surveying, Land Planning

924 North Main
Wichita, Kansas 67203
www.rbkansas.com

(316) 264-8008
(316) 264-4621 fax
E-mail: info@rbkansas.com