


SEE REVISED SHEET

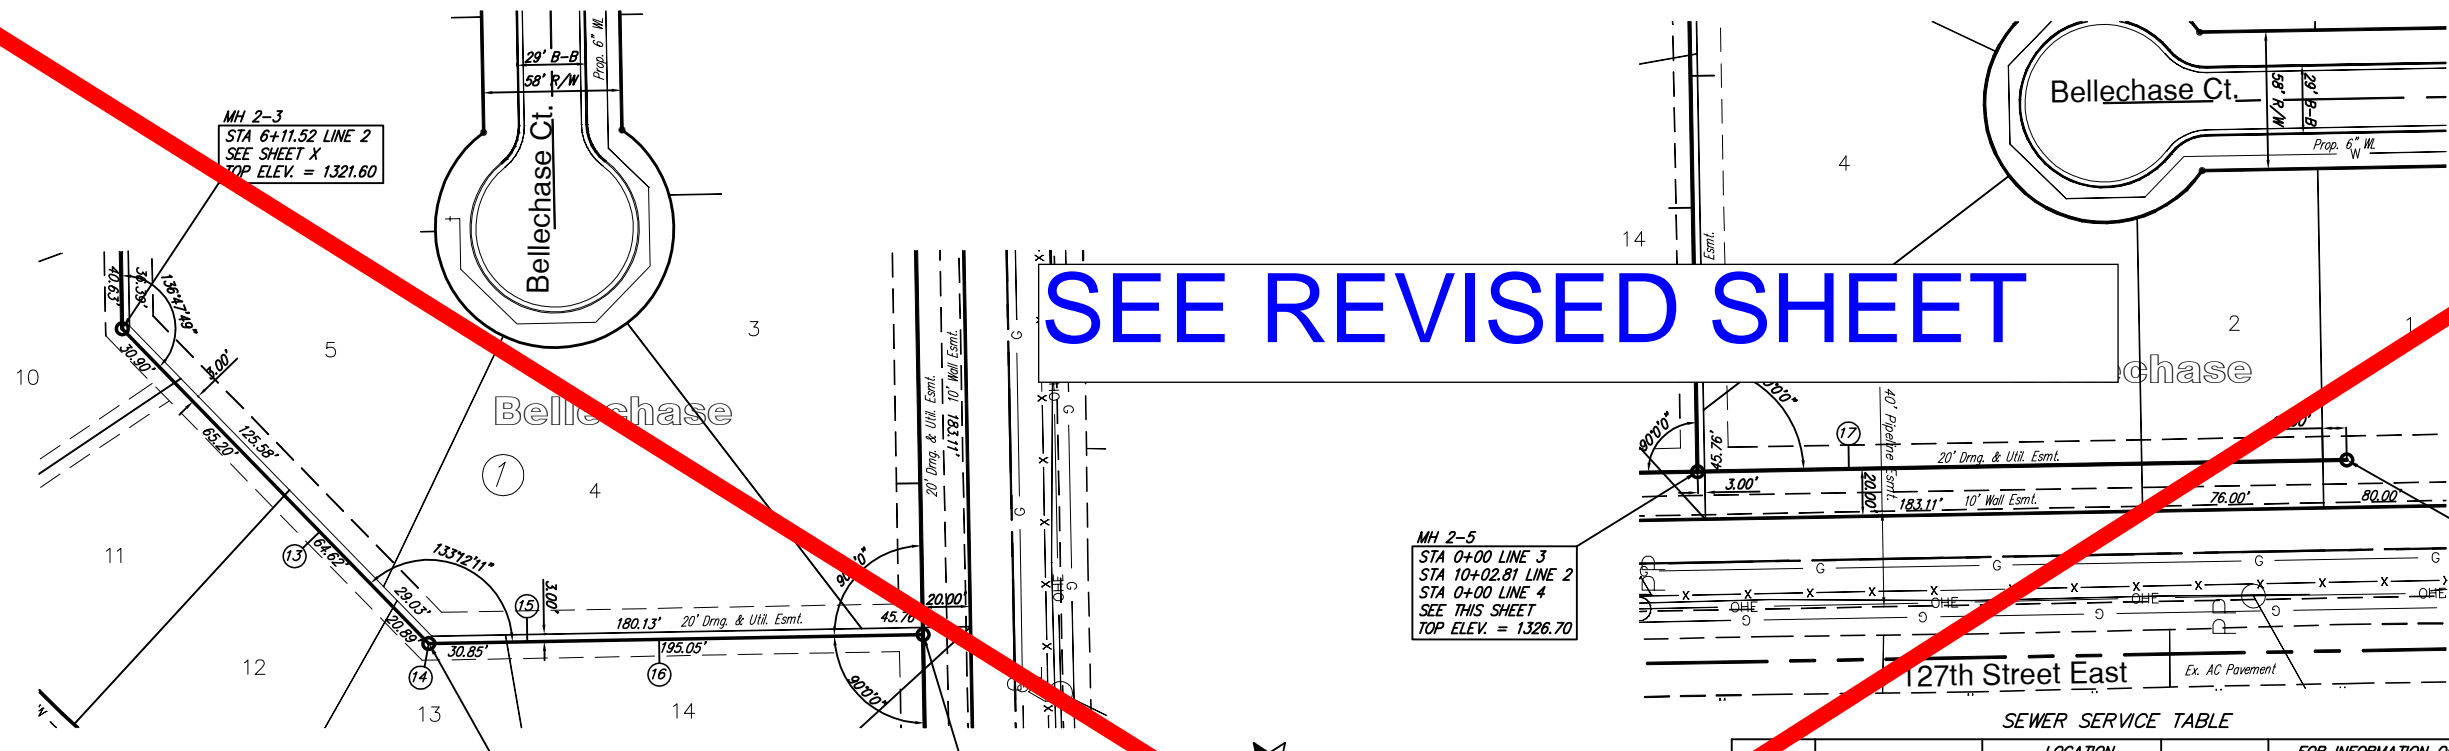

MH 2-3
STA 6+11.52 LINE 2
SEE SHEET X
TOP ELEV. = 1321.60

MH 2-4
STA 7+95.62 LINE 2
CONSTRUCT STD. TYPE P MH
TOP ELEV. = 1324.03

MH 2-5
STA 10+02.81 LINE 2
STA 0+00 LINE 3
STA 0+00 LINE 4
CONSTRUCT STD. TYPE P MH
TOP ELEV. = 1326.70

MH 2-5
STA 0+00 LINE 3
STA 10+02.81 LINE 2
STA 0+00 LINE 4
SEE THIS SHEET
TOP ELEV. = 1326.70

MH 3-1
STA 2+72.11 LINE 3
CONSTRUCT STD. TYPE P MH
TOP ELEV. = 1323.80


SEWER SERVICE TABLE

NUMBER	TYPE	LOCATION			STATION \ DIRECTION	FOR INFORMATION ONLY	
		LOT NO.	BLOCK NO.	LINE NO.		APPROXIMATE LENGTH 4" PIPE	VERTICAL
13	8" X 4" Tee Saddle	12	1	2	7+30/R	8'	10'
14	4" MH Riser	13	1	2	7+96/R	9'	10'
15	8" X 4" Tee Saddle	4	1	2	8+37/L	9'	10'
16	8" X 4" Tee Saddle	14	1	2	8+92/R	9'	10'
17	8" X 4" Tee Saddle	3	1	3	0+63/L	9'	10'

NOTE: Vertical Riser Pipe shall be extended to 2' minimum above ground water elevation and 4' maximum below proposed ground elevation.



SCALE 1" = 40' HORIZ.
1" = 5' VERT.
IRON = ●

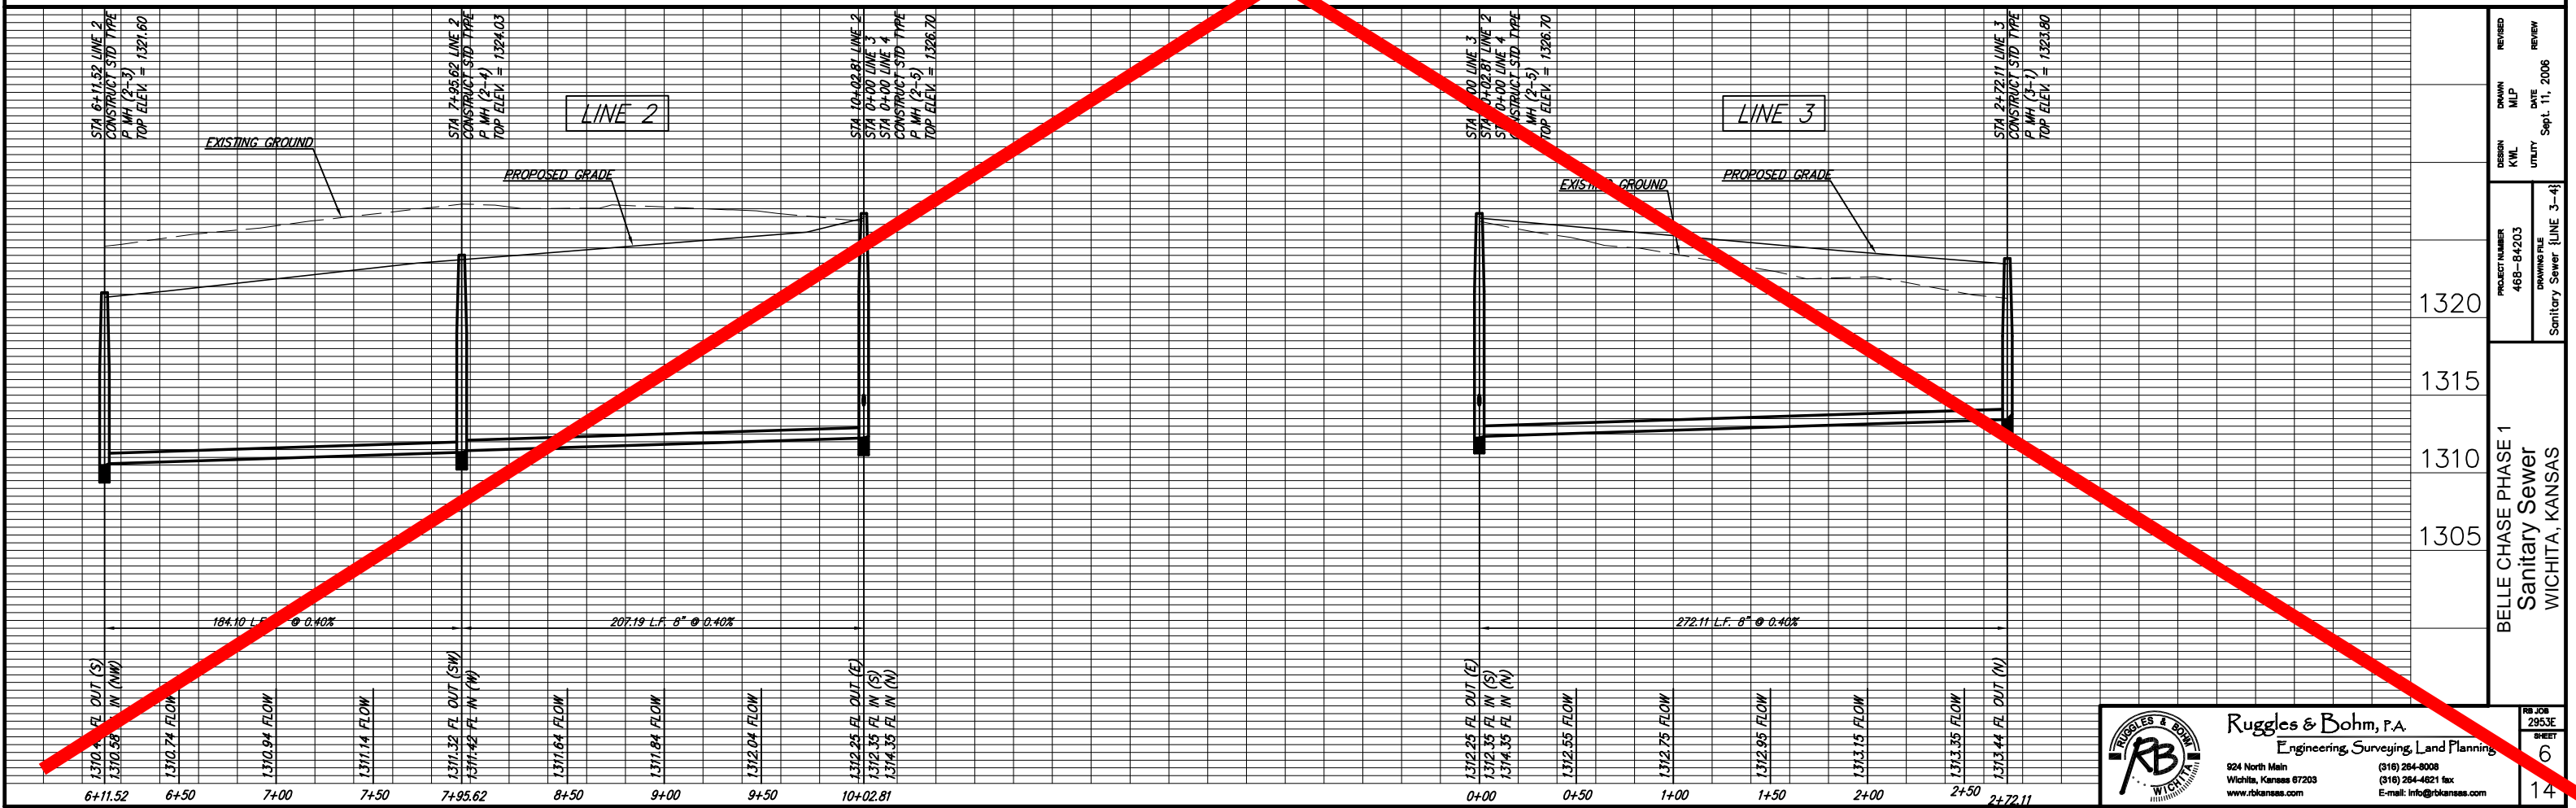

LINE 2

LINE 3

1320
1315
1310
1305

REVISIONS

NO.	DATE	BY	REVISION
1	Sept. 11, 2006	MLP	REVIEW

DESIGN: KWL
DRAWING FILE: Sanitary Sewer (LINE 3-4)

PROJECT NUMBER: 468-84203
PROJECT NAME: Belle Chase Phase 1 Sanitary Sewer WICHITA, KANSAS

RB JOB: 2953E
SHEET: 6
14

Ruggles & Bohm, P.A.
Engineering, Surveying, Land Planning

924 North Main
Wichita, Kansas 67203
www.rbkansas.com

(316) 264-8008
(316) 264-4621 fax
E-mail: info@rbkansas.com