



SEE REVISED SHEET

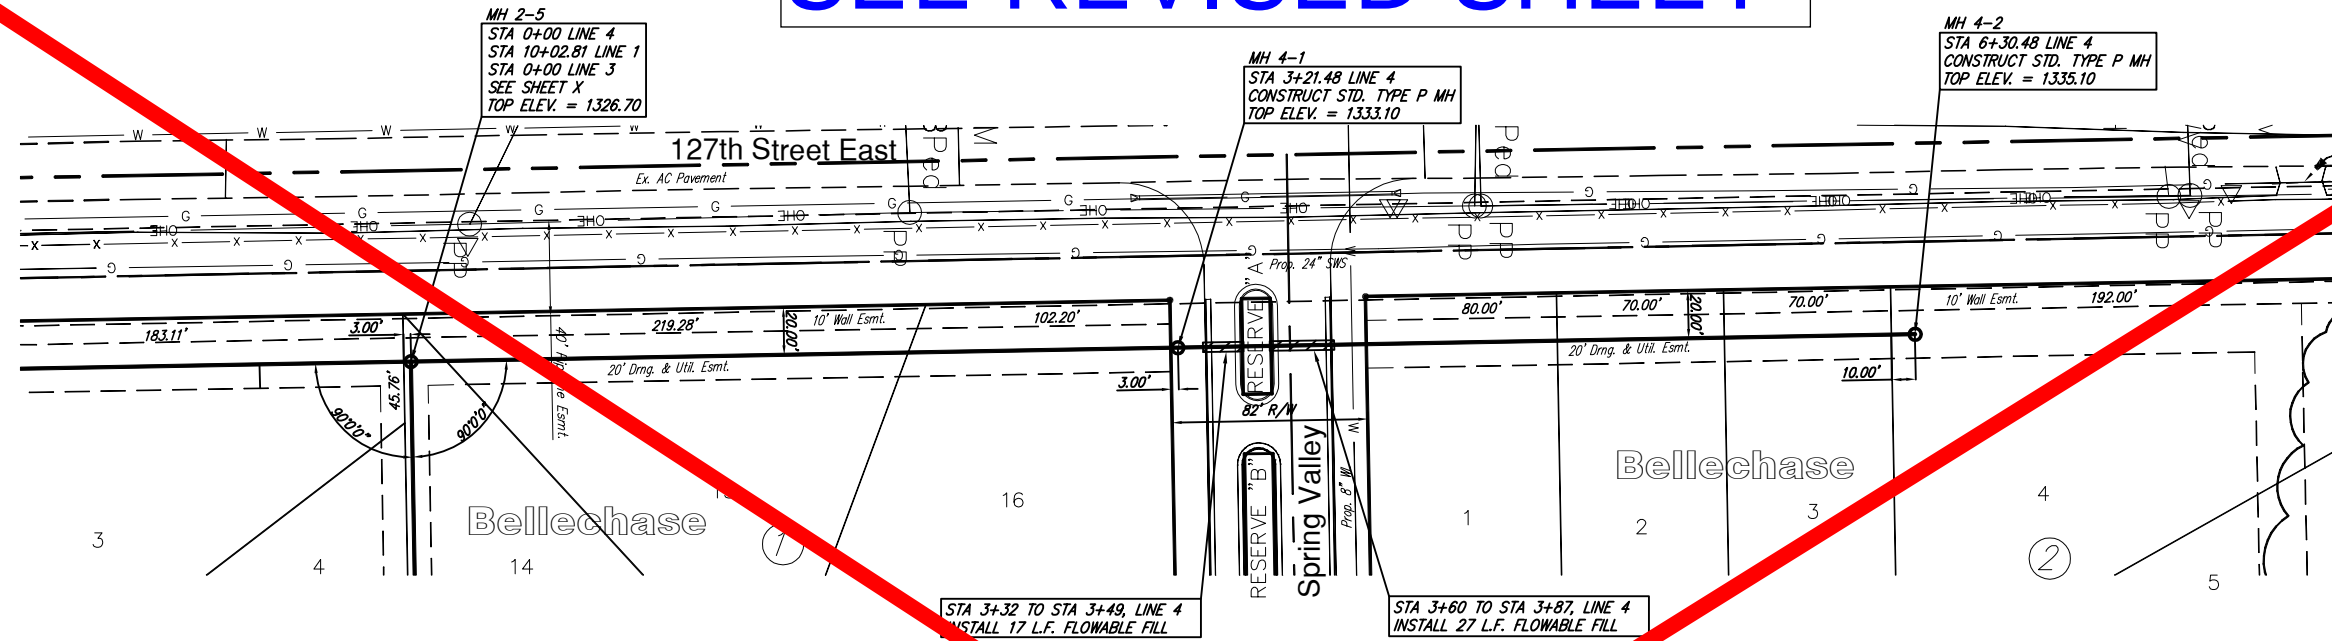

SCALE 1" = 40' HORIZ.
1" = 5' VERT.
IRON = ●

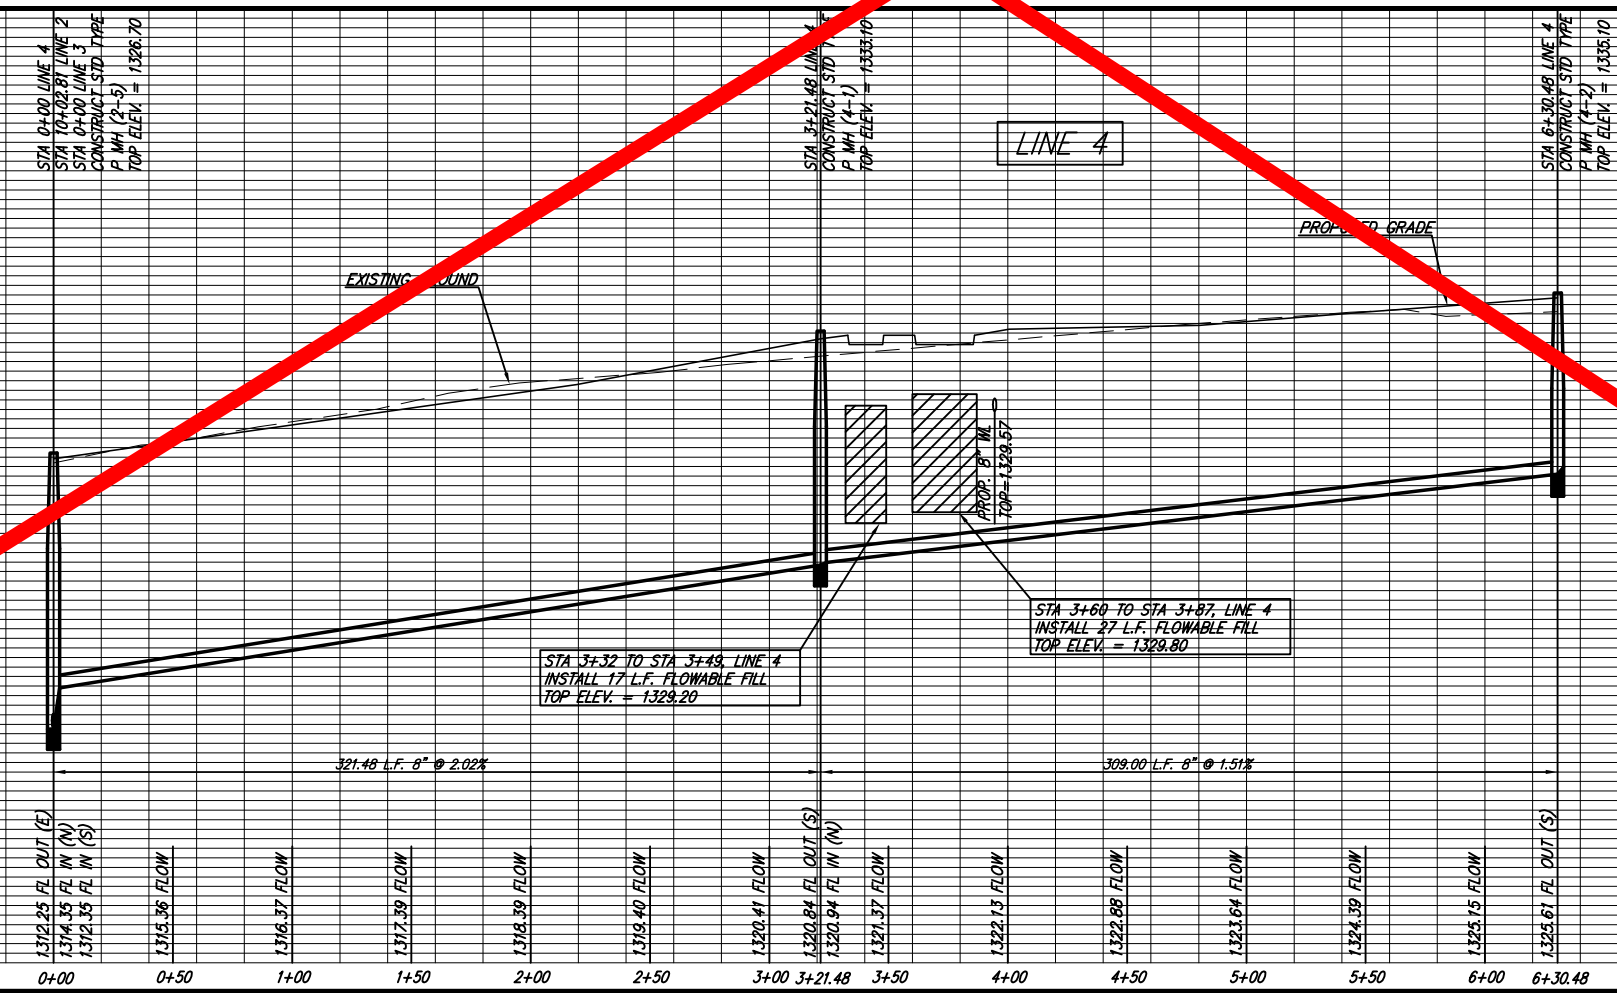

REVISION	DATE	BY	APP'D
DESIGN	MLP	KWL	MLP
PROJECT NUMBER	468-84203	PROJECT	1330
DRAWING FILE	Sanitary Sewer (LINE 3-4)	DATE	Sept. 11, 2006
PROJECT	BELLE CHASE PHASE 1	ELEVATION	1325
PROJECT	Sanitary Sewer	ELEVATION	1320
PROJECT	WICHITA, KANSAS	ELEVATION	1315

Ruggles & Bohm, P.A.
Engineering, Surveying, Land Planning

924 North Main
Wichita, Kansas 67203
www.rbkansas.com

(316) 264-8008
(316) 264-4621 fax
E-mail: info@rbkansas.com

RB JOB 2953E
SHEET 7
OF 4