BENCHMARK:
"□" at Back of Walk 50'± West & 50'± South of ℄ of Tyler & Central Intersection
Elev. = 145.03 City Datum

APPROVED AS NOTED
BY CITY ENGINEER OF WICHITA
Sanitary Sewers
Storm Sewers VRH 8/24/95
Driveway Approaches
Water Mains
Paving

NOTE TO CONTRACTORS

Inspection and testing for this project is to be provided by a Licensed Consulting Engineering Firm under contract with the Owner/Developer. Said inspection to be in accordance with the City of Wichita standard construction engineering practices and certified by a Licensed Professional Engineer. No work shall be performed in dedicated easements or public right-of-way by the Contractor without such inspection nor shall any work be commenced without written authorization by the City Engineer. All Construction and materials shall comply with the City of Wichita Specifications and Standards (on file and available in the City Engineer's Office).

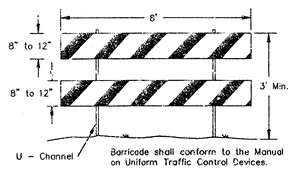

TYPE II BARRICADE DETAIL
NOT TO SCALE

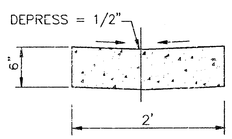

CONCRETE VALLEY GUTTER DETAIL
NOT TO SCALE

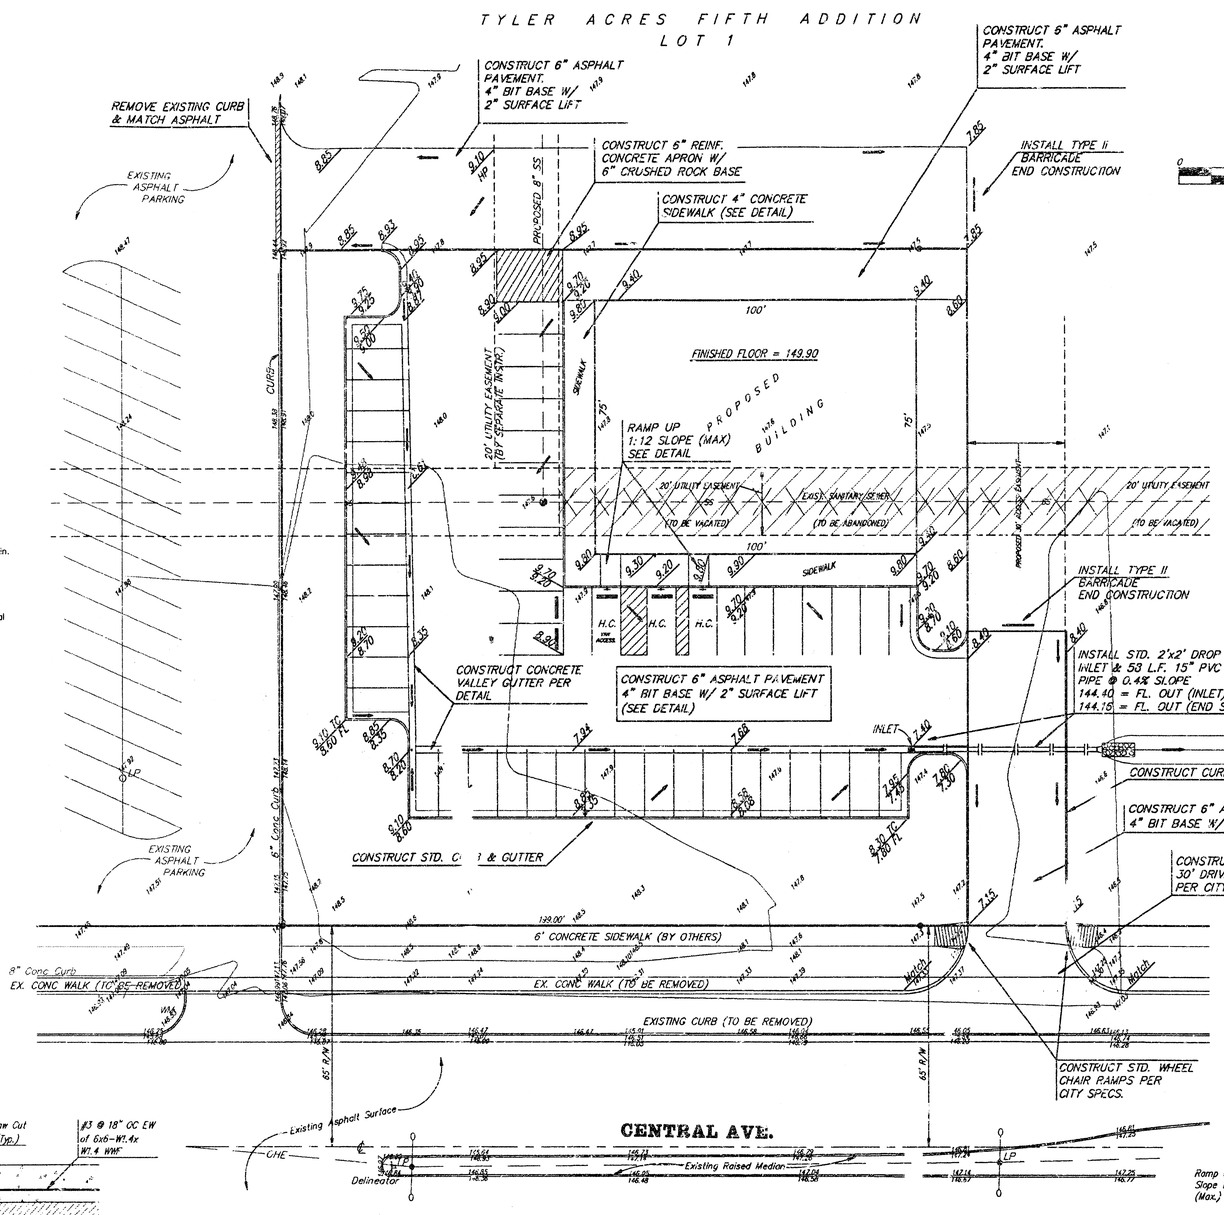



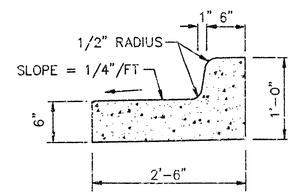

STD. CURB & GUTTER DETAILS
NOT TO SCALE

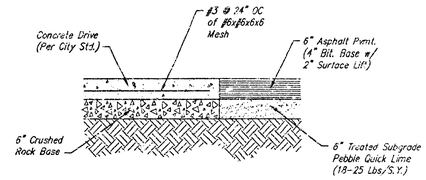

PAVEMENT DETAILS
NOT TO SCALE

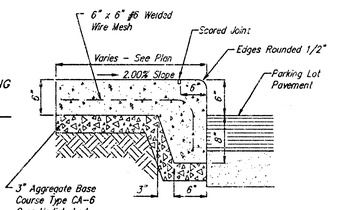

SIDEWALK CURB DETAILS
NOT TO SCALE

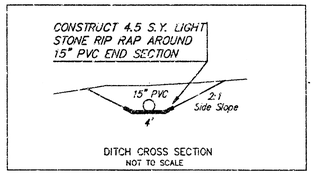

DITCH CROSS SECTION
NOT TO SCALE

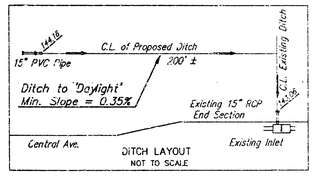

DITCH LAYOUT
NOT TO SCALE

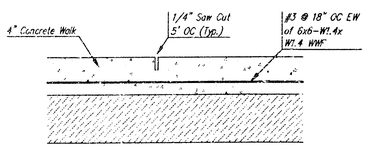

SIDEWALK DETAIL
NOT TO SCALE

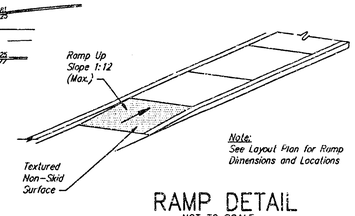

RAMP DETAIL
NOT TO SCALE

Note:
See Layout Plan for Ramp Dimensions and Locations

At time the end section was install. But this project has been added on going to east now, it is a parking area for a business

REVISED 8-14-95 PER CITY COMMENTS
REVISED 8-23-95 FOR DRAINAGE

HOLLYWOOD ENTERTAINMENT
SITE GRADING
PLAN

BAUGHMAN COMPANY P.A.
ENGINEERING, SURVEYING, & PLANNING
316-262-7271 • 315 ELLIS • WICHITA, KANSAS 67211

PROJECT NUMBER 580 PPS (807881)
SHEET 4 of 4

DESIGN	DRAWN	APPROVED	DATE	SCALE
NBW	MGC/MSP		7/19/95	1"=20'

HOLLYWD\GRADE

8-1-8-8