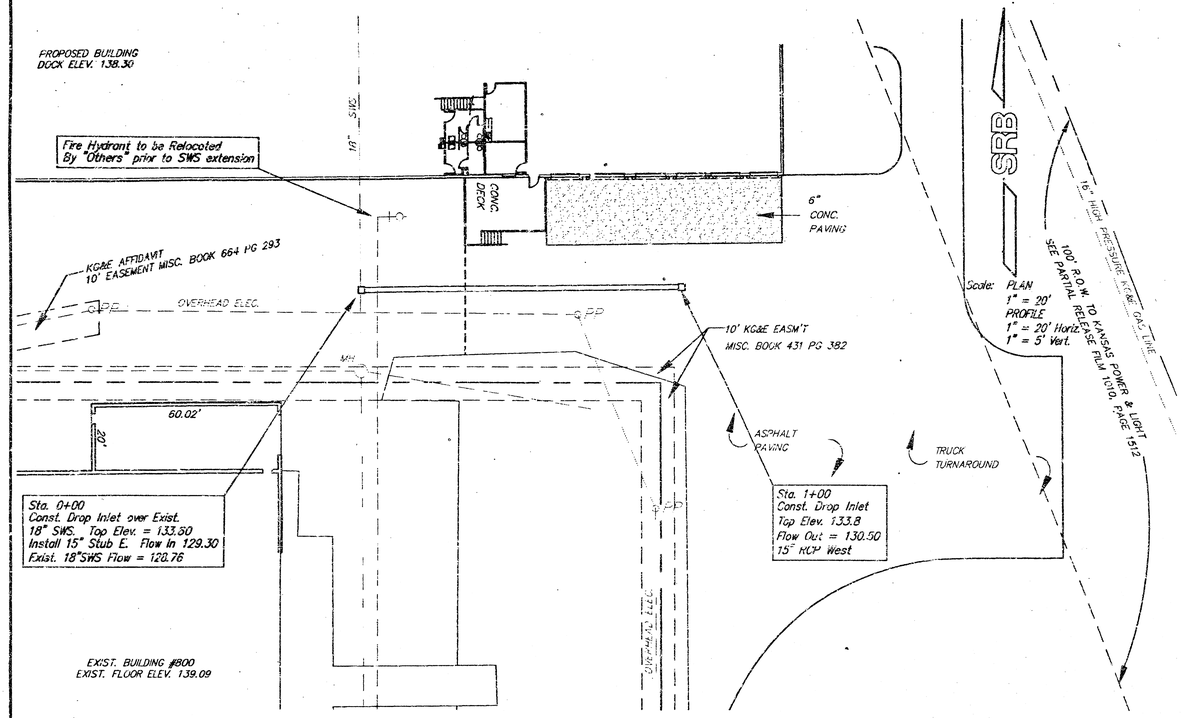

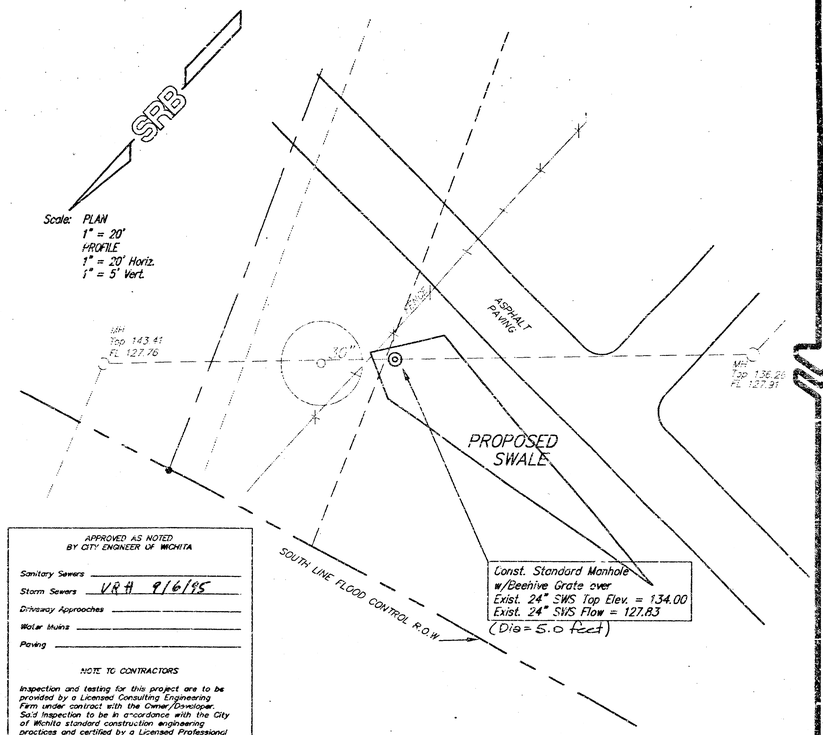

APPROVED AS NOTED
BY CITY ENGINEER OF WICHITA

Sanitary Sewers _____

Storm Sewers VRH 9/6/95

Driveway Approaches _____

Water Mains _____

Paving _____

NOTE TO CONTRACTORS

Inspection and testing for this project are to be provided by a Licensed Consulting Engineering Firm under contract with the Owner/Developer. Said inspection to be in accordance with the City of Wichita standard construction engineering practices and certified by a Licensed Professional Engineer. No work shall be performed in dedicated easements or public right of-way by the Contractor without such inspection, nor shall any work be commenced without written authorization by the City Engineer.

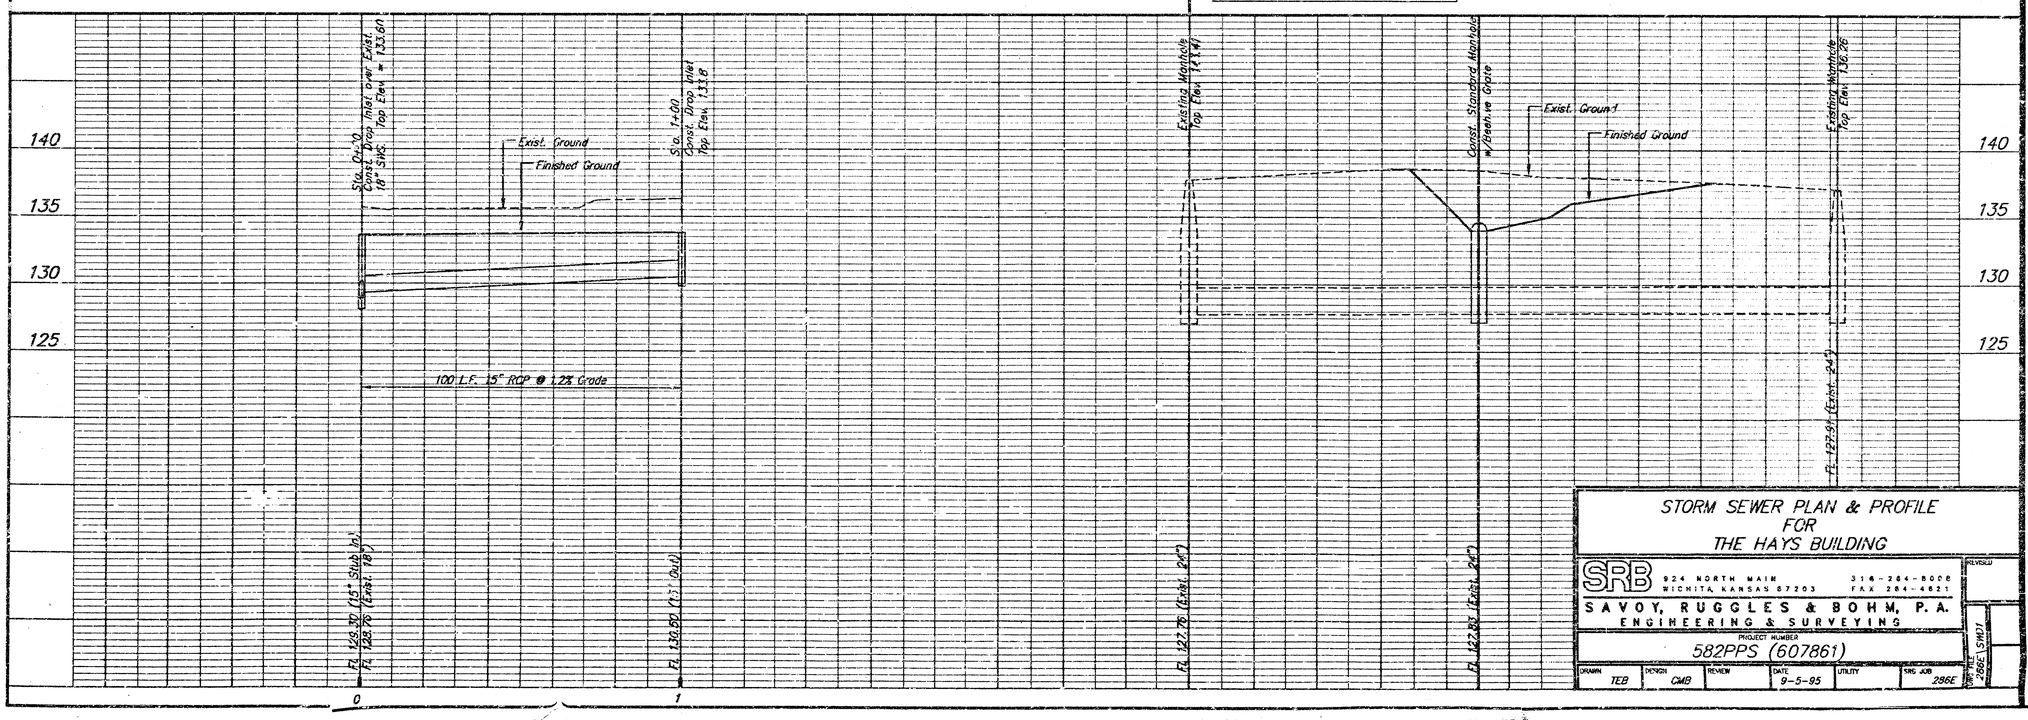

STORM SEWER PLAN & PROFILE
FOR
THE HAYS BUILDING

SRB 924 NORTH MAIN WICHITA, KANSAS 67203 316-264-8008 FAX 264-4621

SAVOY, RUGGLES & BOHM, P.A.
ENGINEERING & SURVEYING

PROJECT NUMBER 582PPS (607861)

DRAWN	DESIGN	REVIEW	DATE	UTILITY	SRB JOB
TEB	CMB		9-5-95		286E

REVISED

FILE 286E\SHD1

DATE DRAWN
5-26-95
REVISIONS

PRINTS ISSUED

PRICING 6-20-95

JEFFKIEHEL ASSOCIATES
ARCHITECTURE
TABLE OF ORGANIZATION, INC. (CORP.)
5700 E. KELLOGG WICHITA, KANSAS 67218 PHONE 316-683-5600

DATE

A NEW BUILDING
for
THE HAYES COMPANY
WICHITA, KANSAS

CONSULTING ARCHITECT LICENSED 11631 KANSAS PROFESSIONAL ENGINEER

PROJECT NUMBER
95050

SHEET TITLE
SITE ARCHITECTURAL PLAN

SHEET NUMBER
SG1.4

OF SHEETS

C:\PROJECTS\FINAL\286E\SHD1 Tue Sep 5 08:18:51 1995 Plotted by Tom Brooks

A-1-A-8T