General Notes:

1. All work on this project shall conform to the Standard Specifications for Storm Sewer Construction of the City of Wichita.
2. All areas disturbed by Contractor's operations shall be restored in accordance with City of Wichita Administrative Regulation AR-78.
3. The Contractor shall notify Kansas One-Call (687-2470) a minimum of 48 hours prior to any excavation.

Bench Mark:

"□" Cut on top of curb @ NE corner Lot 4, Block 1, Whispering Pines Estates; Elevation = 145.10 City Datum.

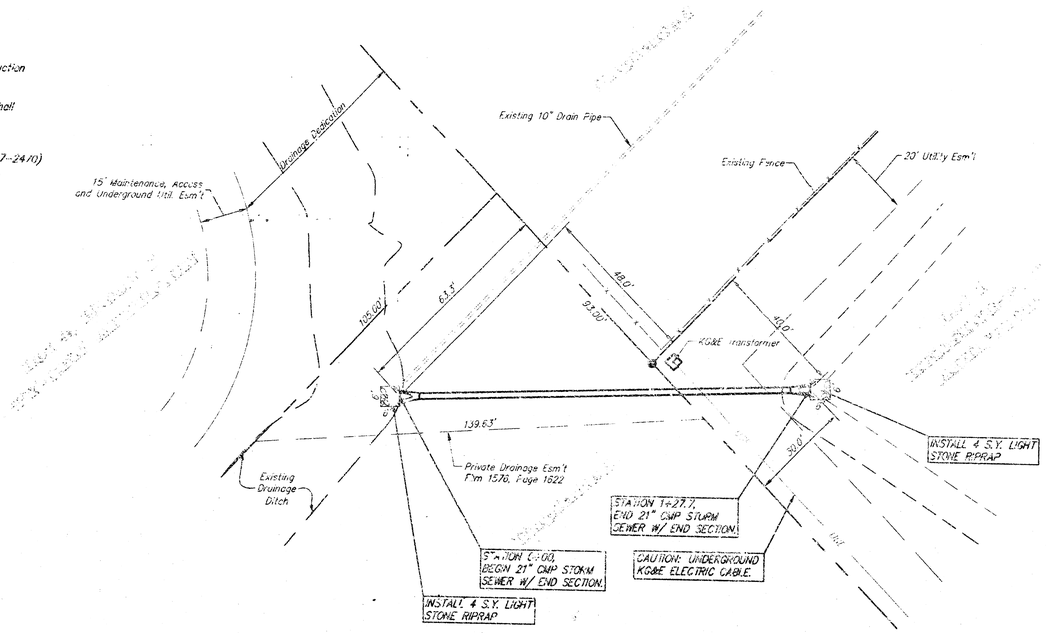

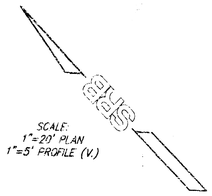

APPROVED AS NOTED BY CITY ENGINEER OF WICHITA

Sanitary Sewers _____

Storm Sewers URH 1/12/96

Driveway Approaches _____

Water Mains _____

Paving _____

NOTE TO CONTRACTORS

Inspection and testing for this project are to be provided by a Licensed Consulting Engineering Firm under contract with the Owner/Developer. Said Inspection to be in accordance with the City of Wichita standard construction engineering practices and certified by a Licensed Professional Engineer. No work shall be performed in dedicated easements or public right-of-way by the Contractor without such inspection, nor shall any work be commenced without written authorization by the City Engineer.

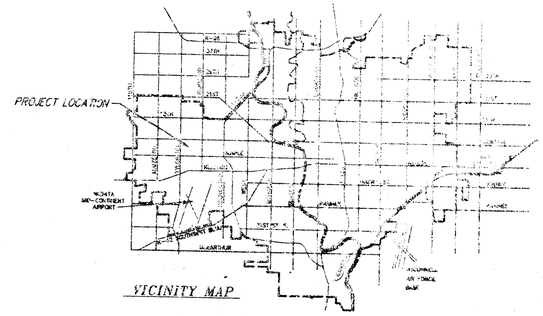

VICINITY MAP

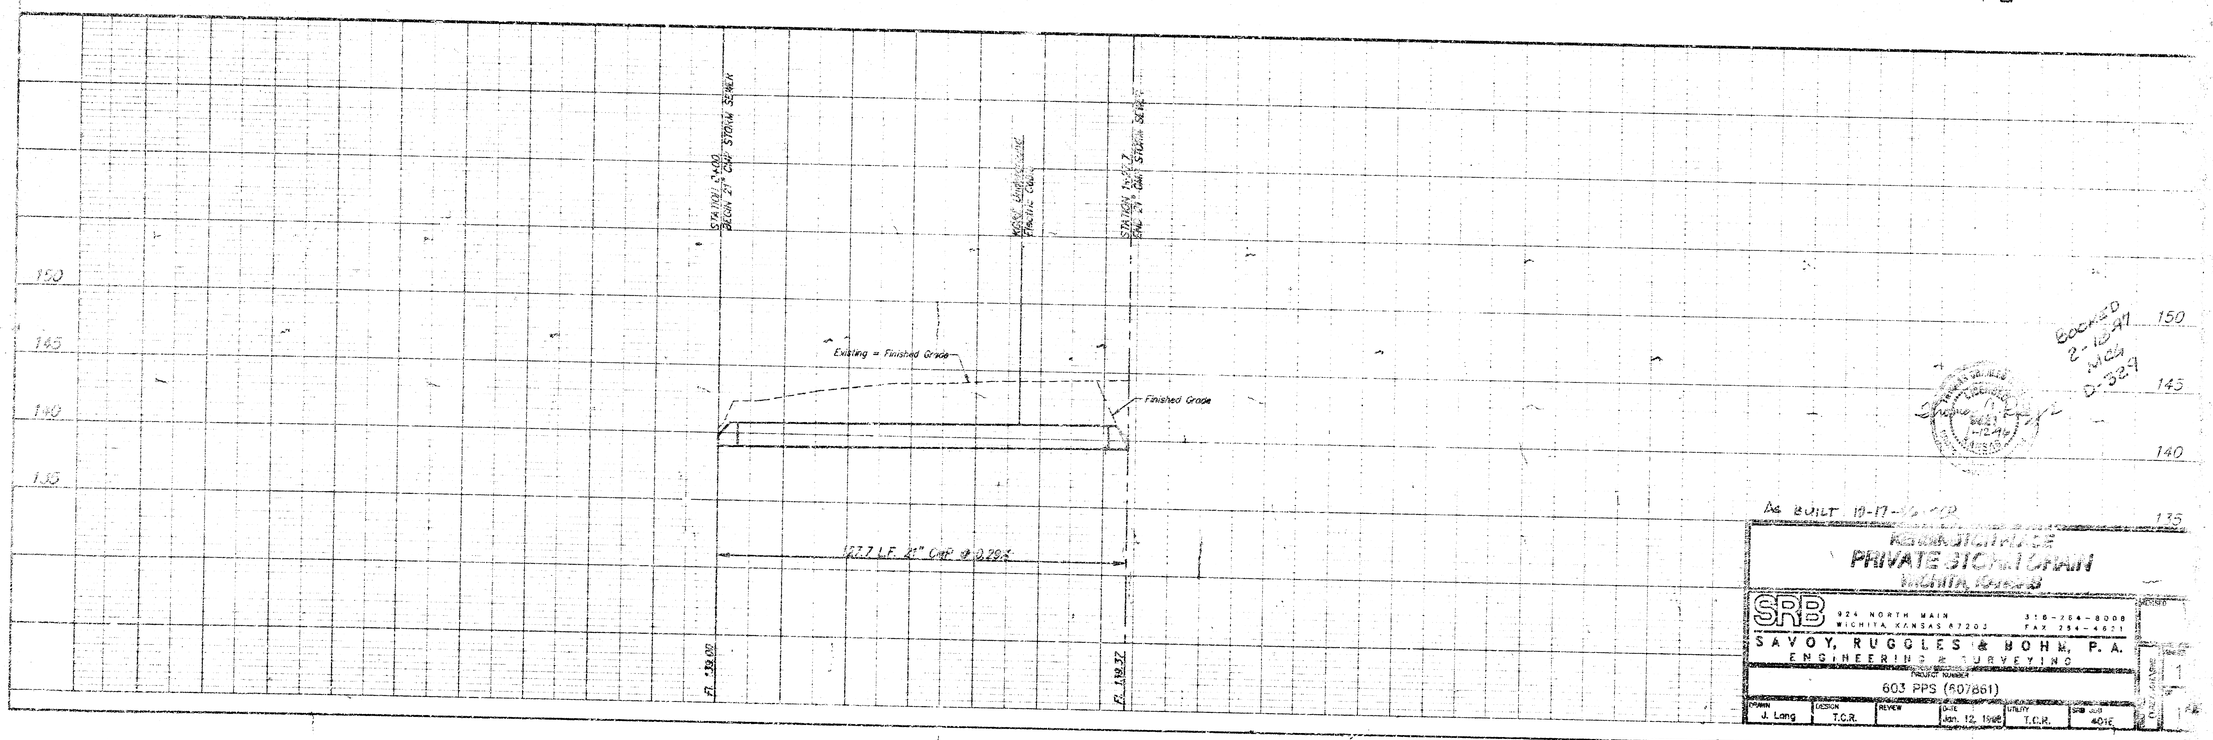

BOOKED 2-18-97 MCG D-329

As BUILT 10-17-96 [illegible]

KENNINGTON PLACE
PRIVATE STORM DRAIN
WICHITA, KANSAS

SRB 924 NORTH MAIN WICHITA, KANSAS 67203 316-264-8008 FAX 264-4621

SAVOY, RUGGLES & BOHM, P.A.
ENGINEERING & SURVEYING

PROJECT NUMBER 603 PPS (607861)

DRAWN	DESIGN	REVIEW	DATE	UTILITY	SRB JOB
J. Lang	T.C.R.		Jan. 12, 1996	T.C.R.	401E

401E