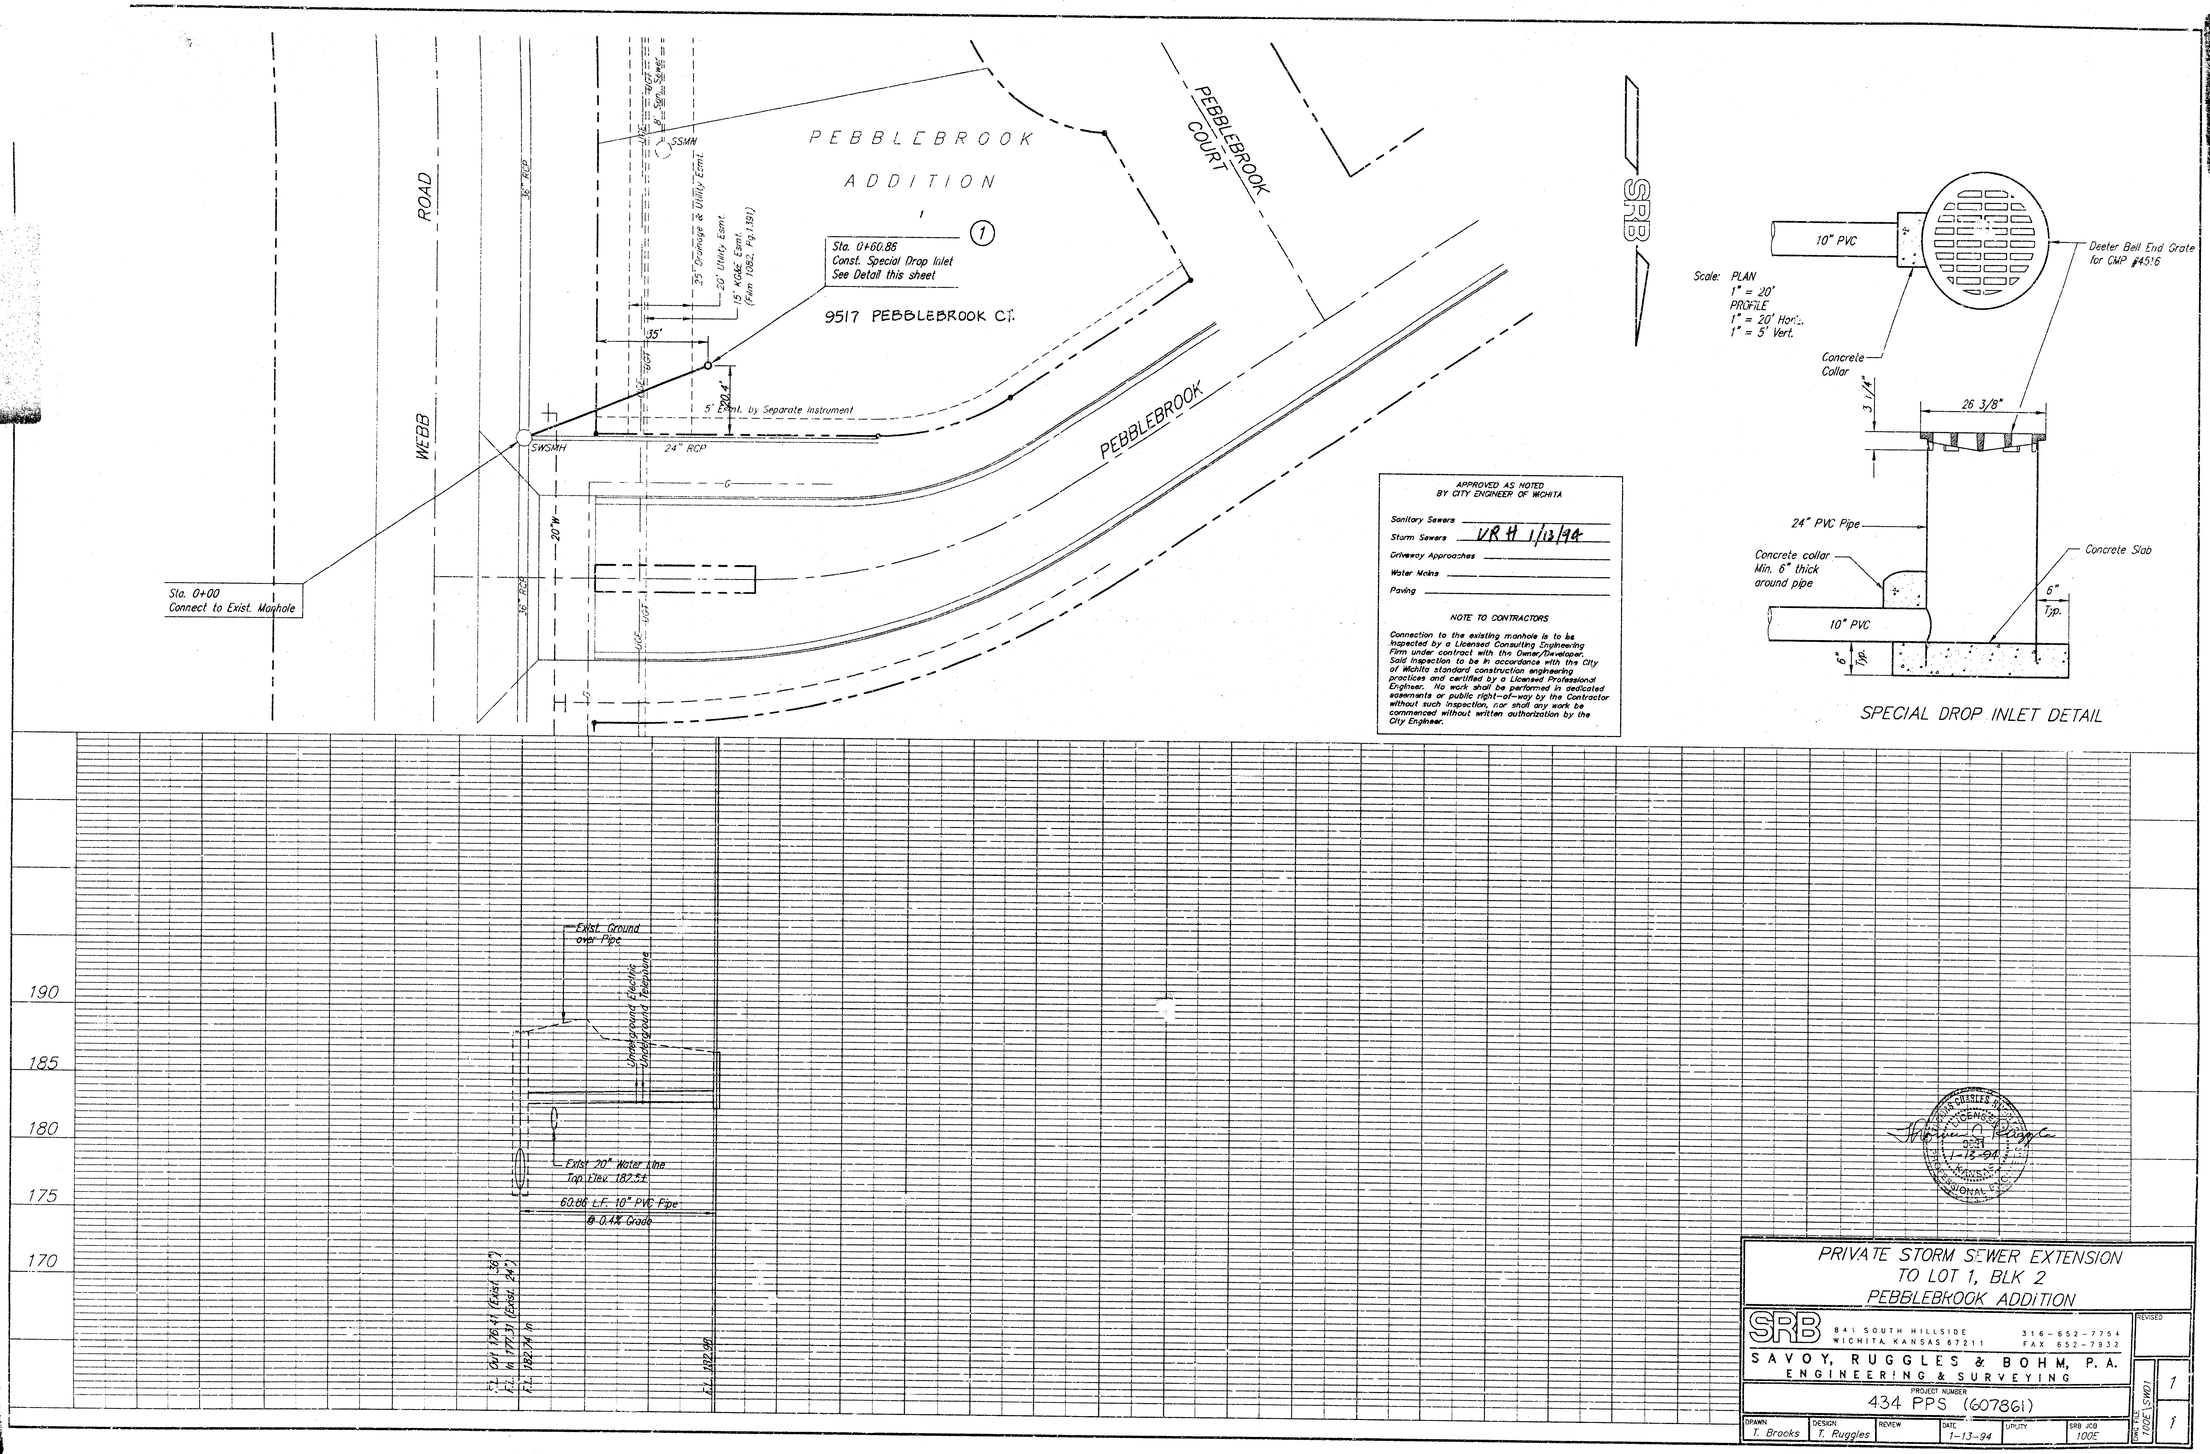

PRIVATE STORM SEWER EXTENSION
TO LOT 1, BLK 2
PEBBLEBROOK ADDITION

SRB 841 SOUTH HILLSIDE WICHITA, KANSAS 67211 316-652-7754 FAX 652-7932

SAVOY, RUGGLES & BOHM, P.A.
ENGINEERING & SURVEYING

PROJECT NUMBER 434 PPS (607861)

DRAWN	DESIGN	REVIEW	DATE	UTILITY	SRB JOB
T. Brooks	T. Ruggles		1-13-94		100E

REVISED

DWG FILE 100E\SW01 1 1

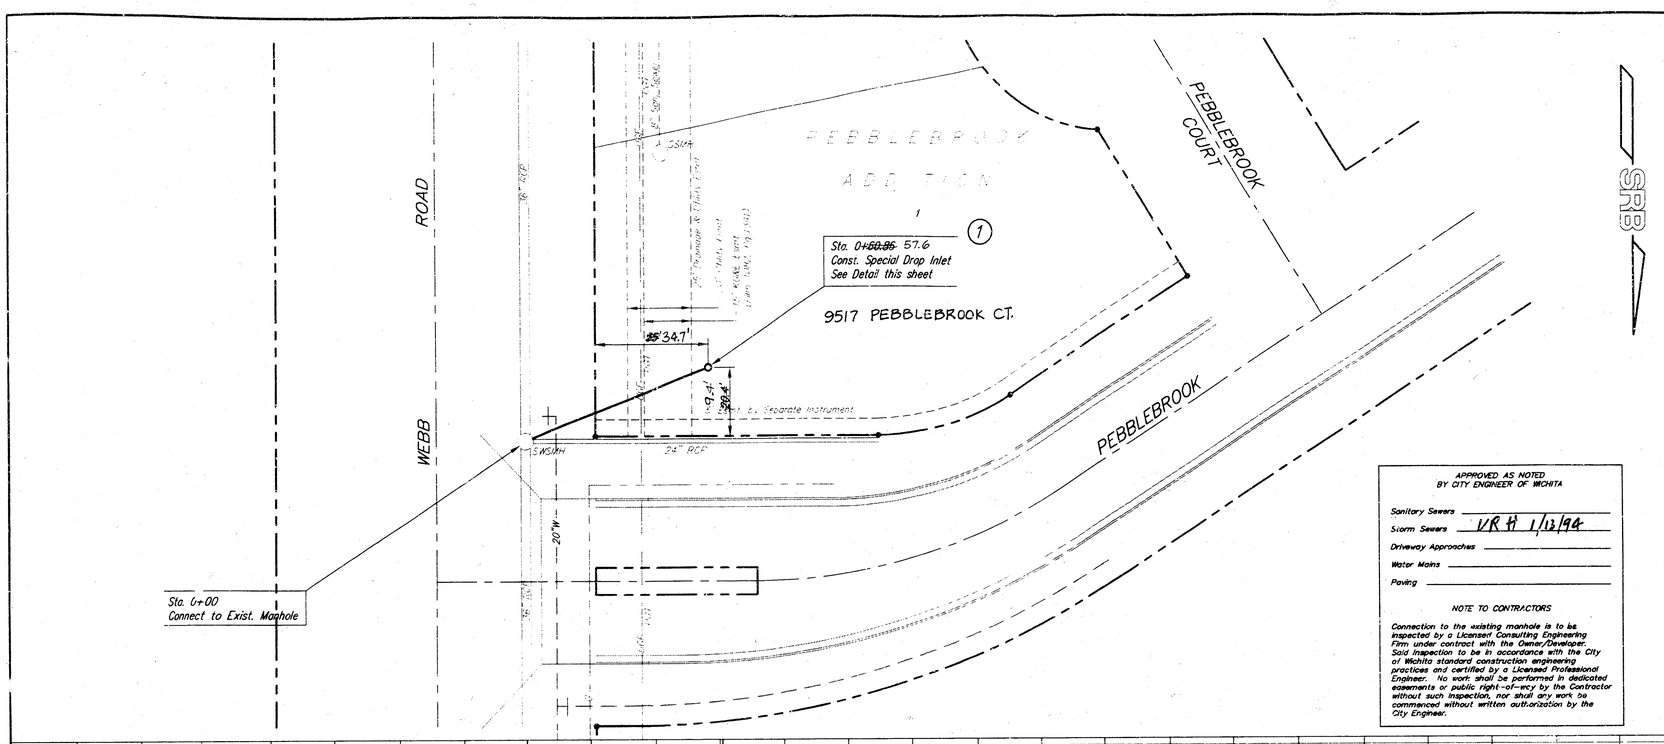

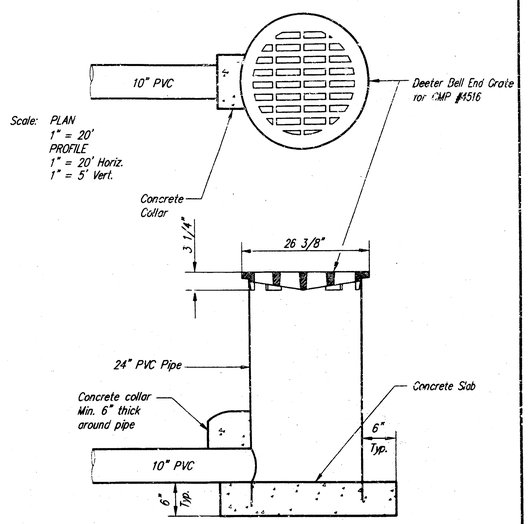

SPECIAL DROP INLET DETAIL

APPROVED AS NOTED
BY CITY ENGINEER OF WICHITA

Sanitary Sewers _____
Storm Sewers VRH 1/13/94
Driveway Approaches _____
Water Mains _____
Paving _____

NOTE TO CONTRACTORS

Connection to the existing manhole is to be inspected by a Licensed Consulting Engineering Firm under contract with the Owner/Developer. Said inspection to be in accordance with the City of Wichita standard construction engineering practices and certified by a Licensed Professional Engineer. No work shall be performed in dedicated easements or public right-of-way by the Contractor without such inspection, nor shall any work be commenced without written authorization by the City Engineer.

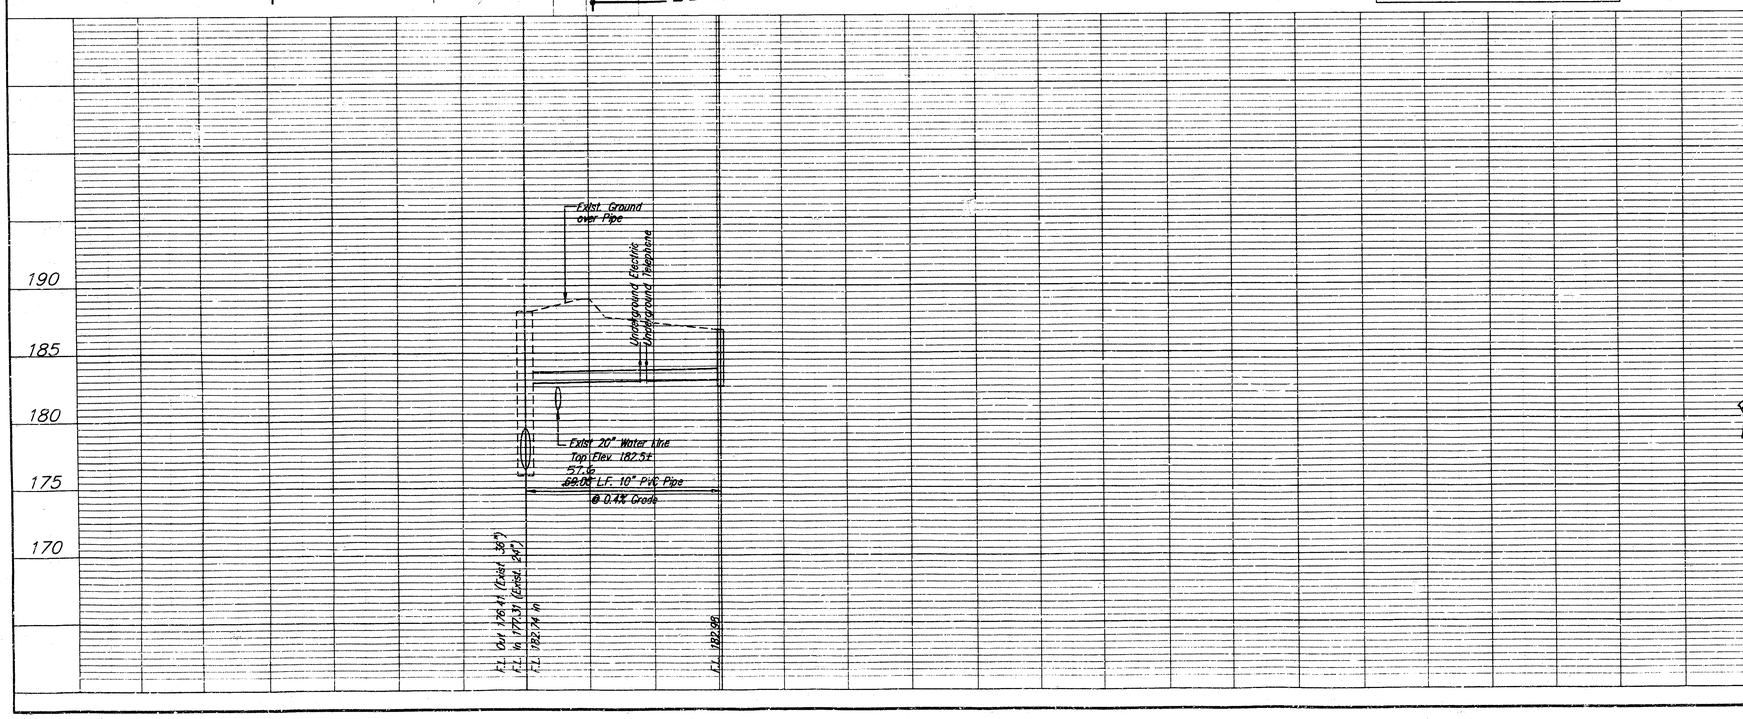

Booked 4-6-94 MCG D-205

Revised as built 1-28-94 JCR

PRIVATE STORM SEWER EXTENSION
TO LOT 1, BLK 2
PEBBLEBROOK ADDITION

SRB 841 SOUTH HILLSIDE WICHITA, KANSAS 67211 316-652-7754 FAX 652-7912

SAVOY, RUGGLES & BOHM, P.A.
ENGINEERING & SURVEYING

PROJECT NUMBER 434 PPS (607861)

DRAWN	DESIGN	REVIEW	DATE	UTILITY	SRB JOB
T. Brooks	T. Ruggles		1-13-94		100E

DWG FILE 100E SWD1 1 1