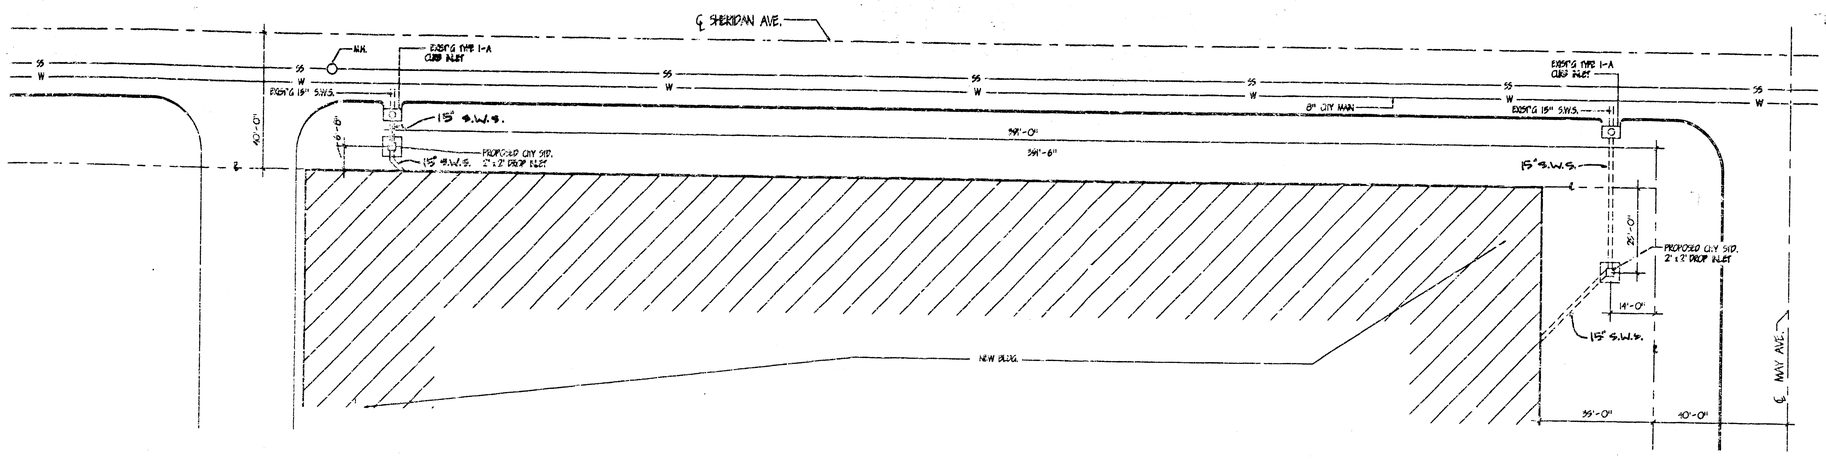

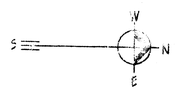

PRIVATE STORM WATER SEWER
SERVING LOT 1, BLOCK "A", METAL-FAB ADDITION
1" = 20'-0"

B.M. #33 60¢ SPIKE STEP IN S.E. FACE OF P.P. 2 S.W. CORNER SHERIDAN & MAY EL. 107.64 PER CITY DATUM

INSPECTION AND TESTING FOR THIS PROJECT TO BE PROVIDED BY A LICENSED CONSULTING ENGINEERING FIRM UNDER CONTRACT WITH THE OWNER/DEVELOPER. SAID INSPECTION TO BE IN ACCORDANCE WITH THE CITY OF WICHITA STANDARD CONSTRUCTION ENGINEERING PRACTICES AND CERTIFIED BY A LICENSED PROFESSIONAL ENGINEER. NO WORK SHALL BE PREFORMED INDEDICATED EASEMENTS OR PUBLIC RIGHT-OF-WAY BY THE CONTRACTOR WITHOUT SUCH INSPECTIONS, NOR SHALL ANY WORK BE COMMENCED IN DEDICATED EASEMENTS OR PUBLIC RIGHT-OF-WAY WITHOUT WRITTEN AUTHORIZATION BY THE CITY ENGINEER.

APPROVED AS NOTED
BY CITY ENGINEER OF WICHITA

SANITARY SEWERS _____
STORM SEWERS VRH 7/29/94
DRIVEWAY APPROACHES _____
WATER MAINS _____
PAVING _____

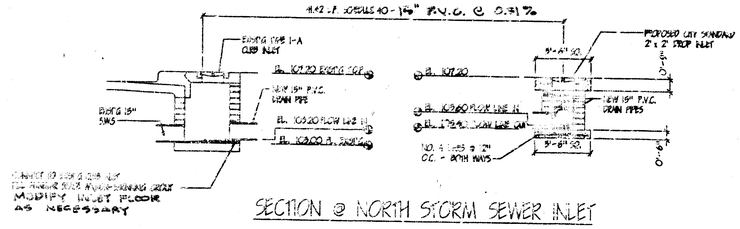

SECTION @ NORTH STORM SEWER INLET

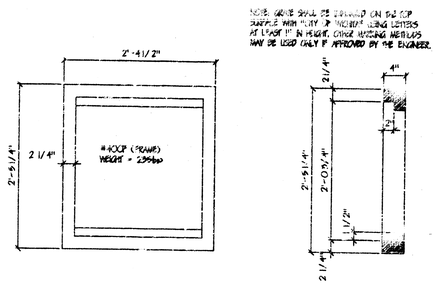

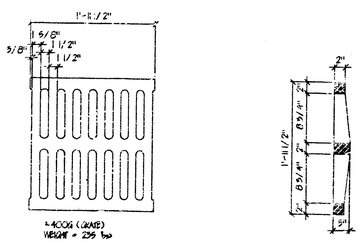

FRAME & GRATE DETAIL

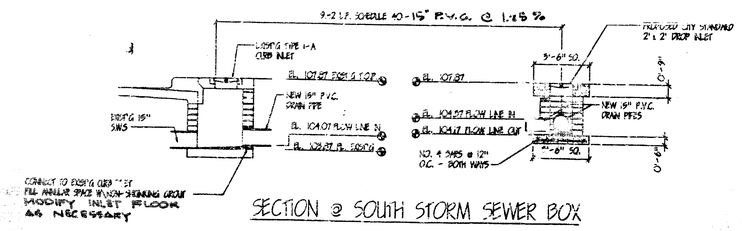

SECTION @ SOUTH STORM SEWER BOX

PRIVATE PROJECT NO. 484PPS (607861)

BOOKED F-21 MCG

Drawings prepared under the direction of,
Don C. Moehring II – Consulting Engineer

By Don C. Moehring II

AS BUILT PLANS
S.E. ANDERSON, P.E.
DECEMBER, 1995

EVANS BUILDING CO., INC.
9801 WEST YORK
WICHITA, KANSAS 67277

METAL - FAB INC.

PROPERTY

E B C

REVISIONS
NO. DATE DWN

DATE : 7/25/94
DR. BY : M.W.
CK. BY :
SCALE :
PROJECT 94-122
SHEET SP-1a
OF

10-1-5-3