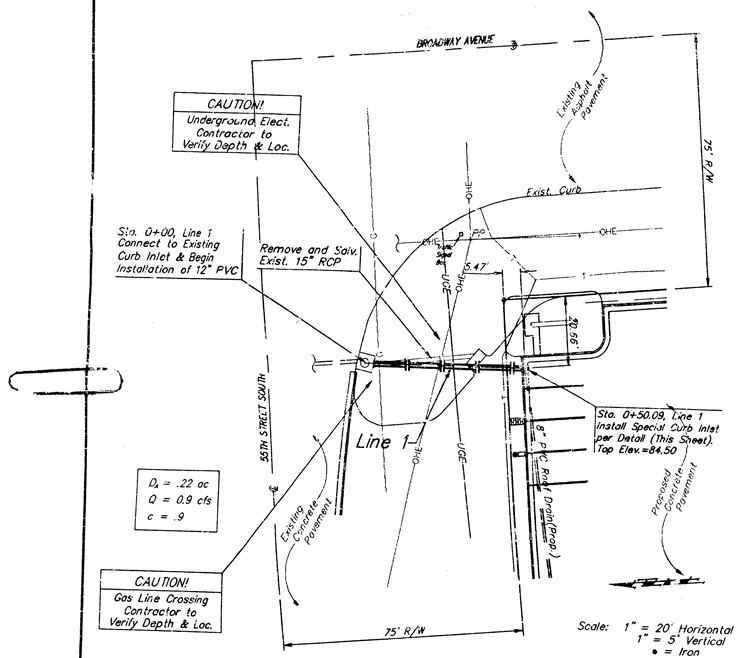

Scale: 1" = 20' Horizontal
1" = 5' Vertical
• = Iron

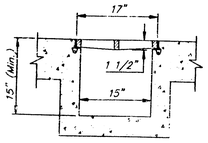

TRENCH DRAIN DETAIL

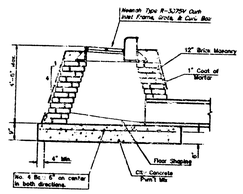

MODIFIED SPECIAL SHALLOW TYPE "B" MANHOLE

Scale: 1" = 20' Horizontal
1" = 5' Vertical
• = Iron

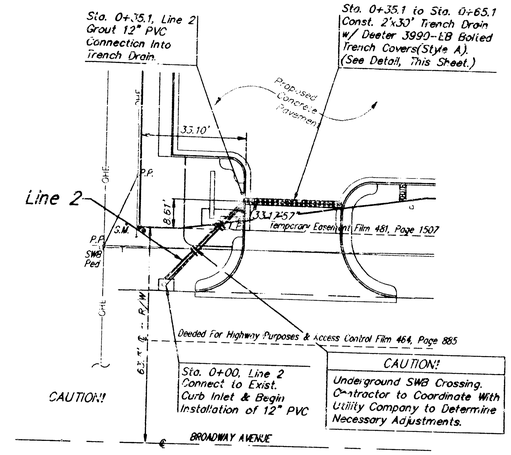

D_A = .64 ac
Q = 2.6 cfs
c = 9

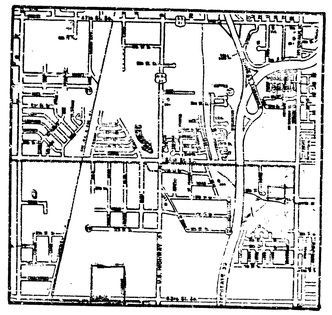

VICINITY MAP

GENERAL NOTES

1. Contractor will be required to provide notice to utility companies a minimum of twenty-four (24) hours prior to any excavation as follows:

   Kansas One-Call 687-2470

2. Existing utilities and their locations as shown on the plans represent the best information obtainable for design. Location information has been obtained from the various utility companies and is either from company records or company field-provided locations. The Contractor will be required to work around existing utilities which do not conflict with proposed construction.
3. The Contractor is to verify utility locations prior to construction for this project.
4. Traffic affected by the construction of this project shall be handled in accordance with the latest edition of the Manual on Uniform Traffic Control Devices.
5. All disturbed areas shall be seeded with Rebel II fescue at the rate of 300 lbs. per acre. Fertilizer (13-13-13) shall be applied at the rate of 100 lbs. per acre.
6. Lines 1 & 2 for this project are to be privately maintained.

Benchmark:
City of Wichita Benchmark. Top of Hubguard at the N.W. COrner of RCBC at the N.W. Corner of the intersection of Broadway Avenue and 55th Street South

Elevation = 84.47

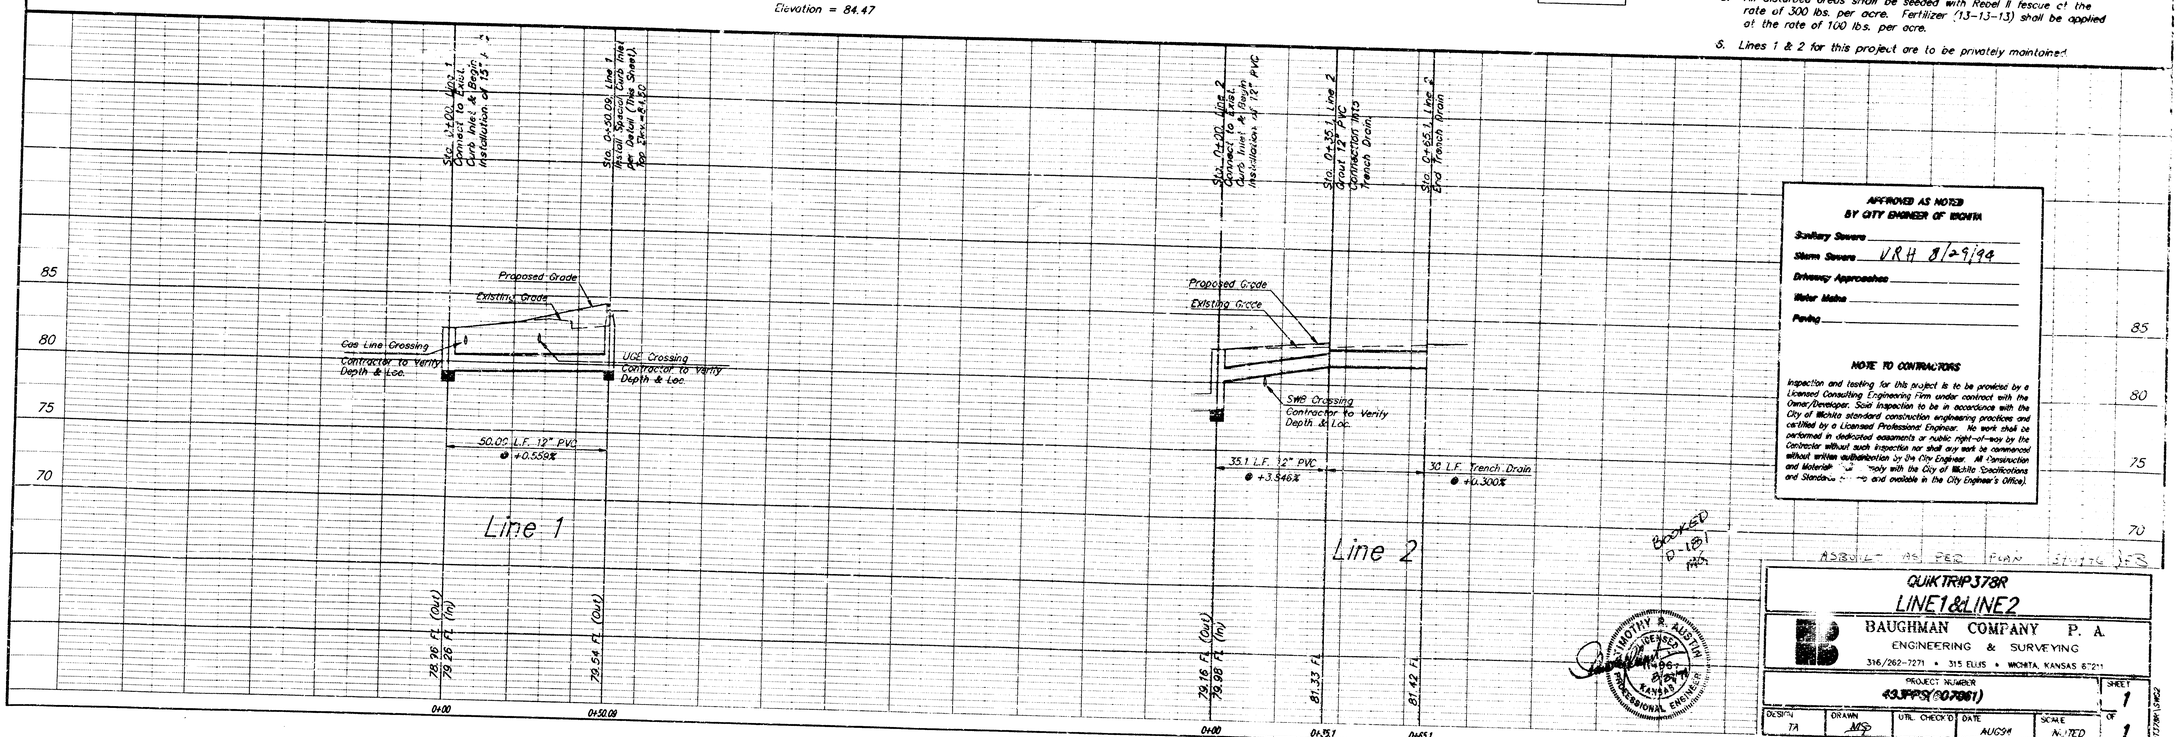

APPROVED AS NOTED
BY CITY ENGINEER OF WICHITA

Sanitary Sewers _____
Storm Sewers VRH 8/29/94
Driveway Approaches _____
Water Mains _____
Paving _____

NOTE TO CONTRACTORS

Inspection and testing for this project is to be provided by a Licensed Consulting Engineering Firm under contract with the Owner/Developer. Said inspection to be in accordance with the City of Wichita standard construction engineering practices and certified by a Licensed Professional Engineer. No work shall be performed in dedicated easements or public right-of-way by the Contractor without such inspection nor shall any work be commenced without written authorization by the City Engineer. All Construction and Material ... shall comply with the City of Wichita Specifications and Standards ... and available in the City Engineer's Office).

ASBUILT AS PER PLAN STATED BELOW

BOOKED B-151 PG 20

QUIKTRIP378R
LINE1&LINE2

BAUGHMAN COMPANY P. A.
ENGINEERING & SURVEYING
316/262-7271 • 315 ELLIS • WICHITA, KANSAS 67211

PROJECT NUMBER 43-3PPS(078661)

SHEET 1 OF 1

DESIGN	DRAWN	UTIL. CHECK'D	DATE	SCALE
TA	MSP		AUG94	NOTED

LICENSED 11496 KANSAS PROFESSIONAL ENGINEER
TIMOTHY R. AUSTIN

18-3-3-1