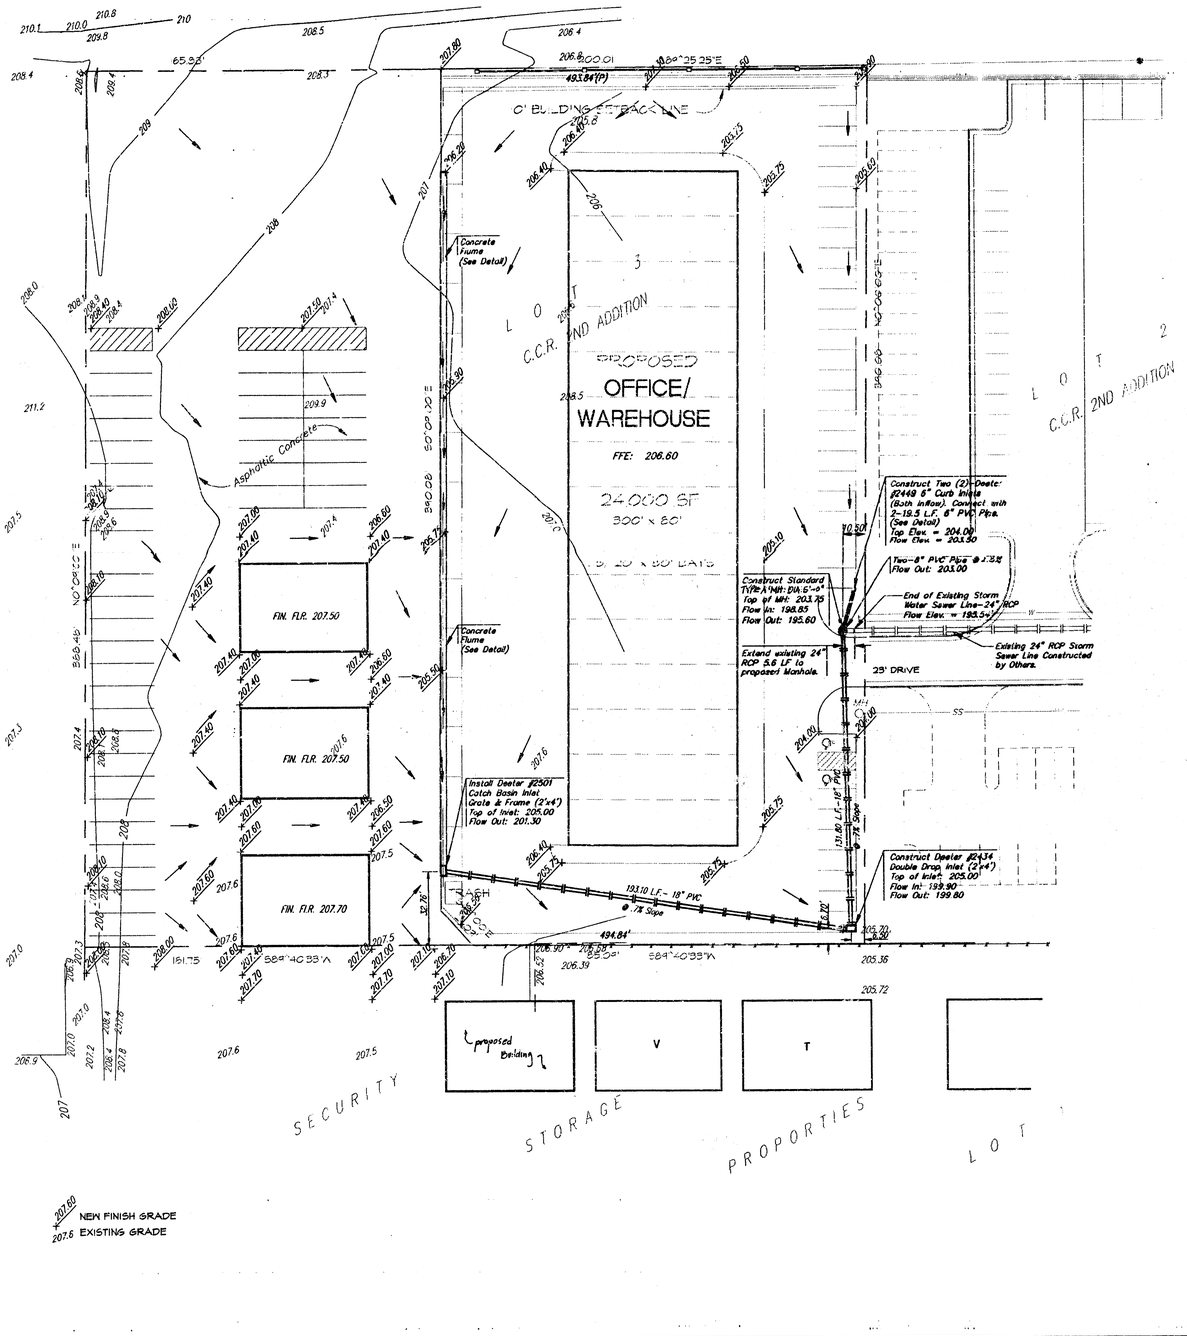

207.60 NEW FINISH GRADE
207.6 EXISTING GRADE

GENERAL NOTES

1. Contractor will be required to provide notice to utility companies a minimum of twenty-four (24) hours prior to any excavation, as follows:

Kansas One-Call	687-2470

The Contractor must notify the following in case of an emergency:

Cablevision	262-4270/263-2061
K.P.L. Gas Service Company	383-8650
Kansas Gas & Electric Company	383-8600
Arkla Gas Company	942-8350
Southwestern Bell Telephone Co.	1-571-2611
City of Wichita Water Department	268-4908
City of Wichita Sewer Department	268-4071

2. Exist. utilities and their locations, as shown on the plans, represent the best information obtainable for design. Location information has been obtained from the various utility companies and is either from company record drawings or company-provided field locations. The Contractor will be required to work around existing utilities which do not conflict with proposed construction.
3. The Contractor to verify utility locations prior to construction of this project.
4. The Contractor shall be responsible for preserving property irons. The Contractor will be required to re-establish any property irons which are damaged or destroyed by his construction operations. Such irons shall be re-established by a licensed land surveyor in accordance with state laws.

APPROVED AS NOTED BY CITY ENGINEER OF WICHITA

Sanitary Sewers _____
Storm Sewers VRH 5/31/95
Driveway Approaches _____
Water Mains _____
Paving _____

NOTE TO CONTRACTORS

Inspection and testing for this project is to be provided by a Licensed Consulting Engineering Firm under contract with the Owner/Developer. Said inspection to be in accordance with the City of Wichita standard construction engineering practices and certified by a Licensed Professional Engineer. No work shall be performed in dedicated easements or public right-of-way by the Contractor without such inspection nor shall any work be commenced without written authorization by the City Engineer. All Construction and Materials shall comply with the City of Wichita Specifications and Standards (on file and available in the City Engineer's Office).

INLET	C	Q_5	Q_{100}
1	0.9	2.05 cfs	3.32 cfs
2	0.9	1.65 cfs	2.65 cfs
3	0.9	8.20 cfs	13.25 cfs

DRAINAGE AREA: 3.0 acres

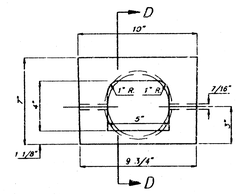

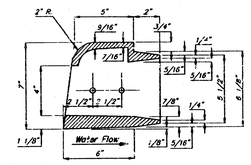

SECTION D-D

DEETER CURB DRAIN #2449 - 6" CURB (IN-FLOW) EST. WT. = 40 LBS.

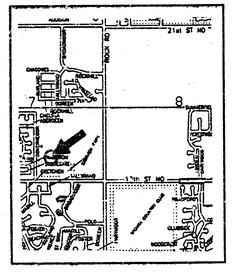

LOCATION MAP
NOT TO SCALE

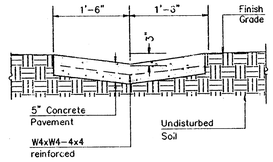

CONCRETE FLUME
NOT TO SCALE

NORTH
Scale: 1"=30'-0"

BRENT WOOTEN LICENSED 8470 KANSAS PROFESSIONAL ENGINEER 5/26/95

SECURITY STORAGE PROPERTIES
STORM WATER IMPROVEMENTS

BAUGHMAN COMPANY P. A.
ENGINEERING, SURVEYING, & PLANNING
WICHITA, KANSAS

PROJECT NUMBER 559PPS (607861)

DESIGN	DRAWN	APPROVED	DATE	SCALE
NBW/JJL	JJL	NBW	MAY 1995	1"=30'

SHEET 1 OF 1

95-05-025
SECURITY - WC