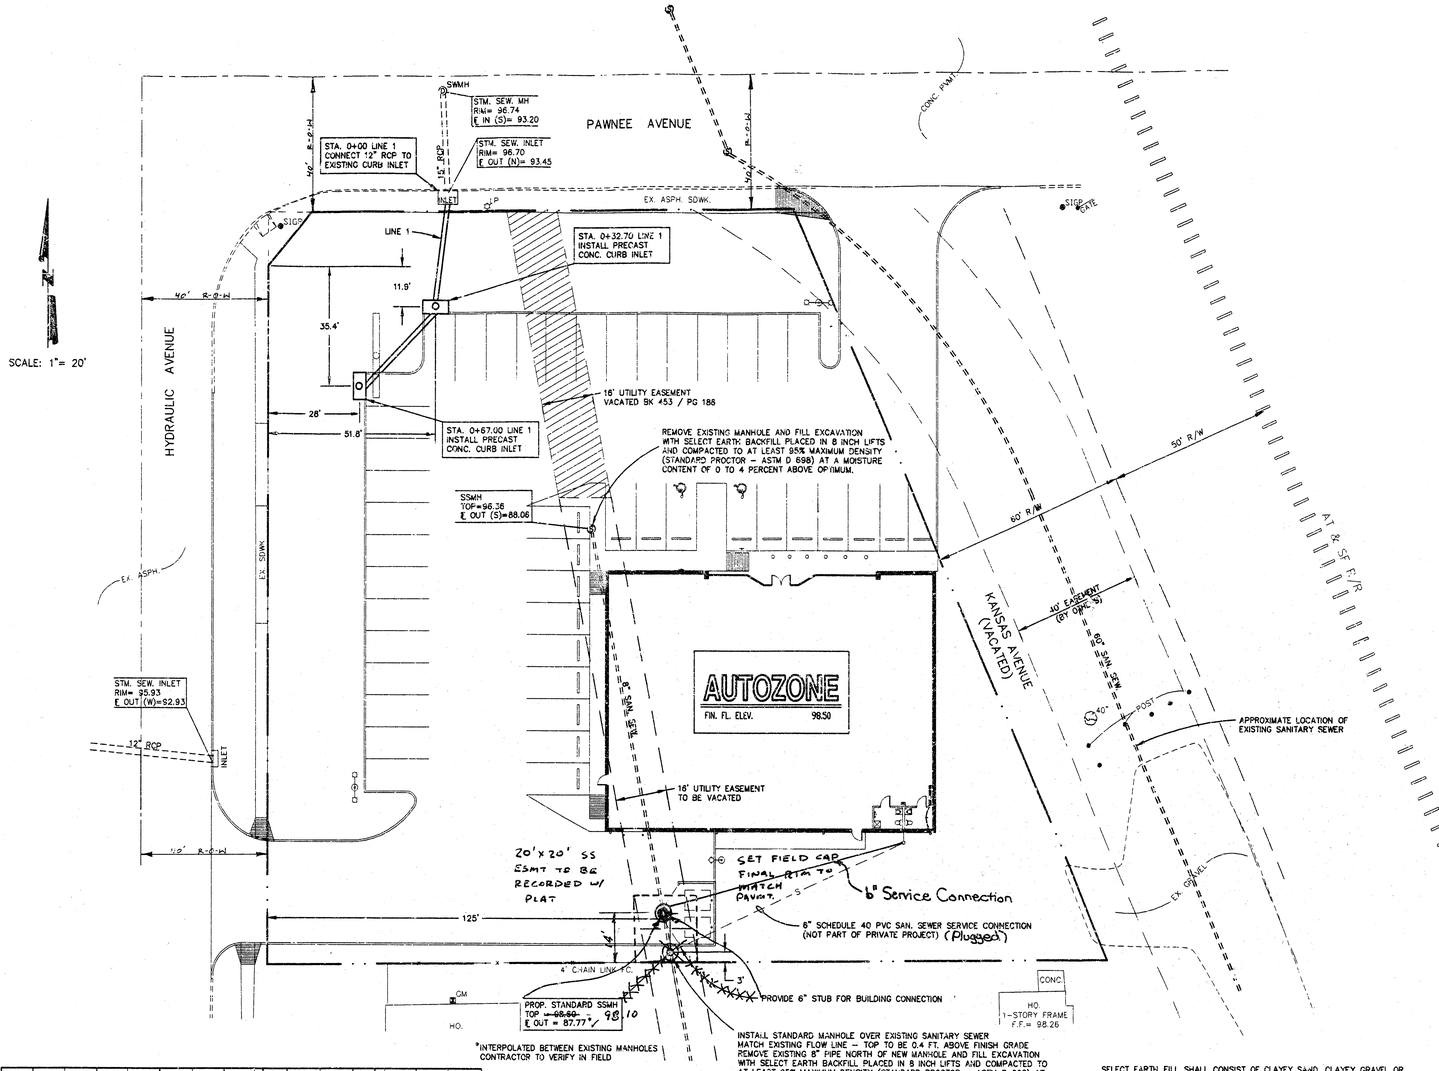


STORMWATER SYSTEM EXTENSION &
REMOVAL OF SANITARY SEWER
LOTS 1, 2, 3, 8, 9 & 10, PAWNEE ADDITION
CITY OF WICHITA
MICHAEL E. LINDEBAK, P.E. : CITY ENGINEER
PRIVATE PROJECT NO.: 660PPS (607861)

PROPOSED SITE IMPROVEMENTS PROVIDED BY:

AutoZone
STORE DEVELOPMENT PHONE (901) 495-8719
60 MADISON AVENUE MEMPHIS, TENNESSEE 38103 FAX (901) 495-8901


TOPOGRAPHIC & BOUNDARY SURVEY PERFORMED BY:
COOK, FLATT & STROBEL

SEE SURVEY FOR COMPLETE LEGAL DESCRIPTION INFORMATION.


BENCHMARK

BRASS DISK IN RAILROAD SIGNAL BASE
200± EAST OF HYDRAULIC AND 25'±
SOUTH OF PAWNEE. ELEV. 100.45


ELEVATION DATUM SHOWN IS CITY OF WICHITA DATUM,
ELEVATIONS SHOWN PLUS 1187.4 = SEA LEVEL DATUM.

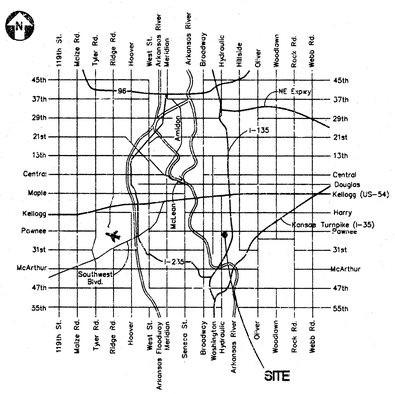

LOCATION MAP
NOT TO SCALE

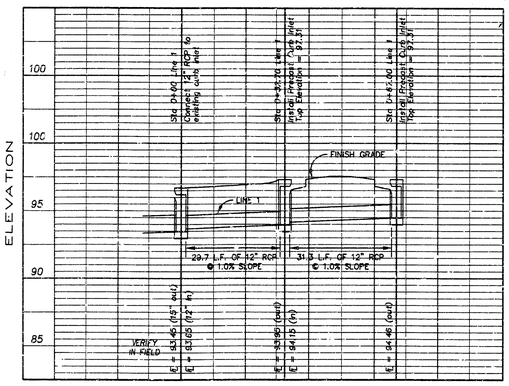

DRAINAGE PROFILE
HOR. SCALE: 1" = 20'
VERT. SCALE: 1" = 5'

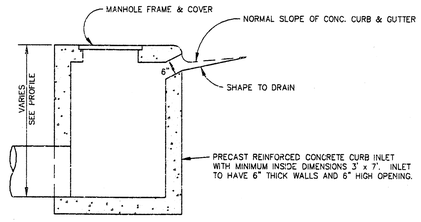

CURB INLET DETAIL
NTS

SELECT EARTH FILL SHALL CONSIST OF CLAYEY SAND, CLAYEY GRAVEL OR SANDY CLAY CLASSIFYING AS SC, GC OR CL IN ACCORDANCE WITH THE USCS OR INORGANIC LOW PLASTICITY LEAN CLAY CONTAINING AN APPRECIABLE PERCENTAGE OF GRAVEL OR ROCK FRAGMENTS ALSO CLASSIFYING AS CL OR WELL GRADED CRUSHED STONE. USE OF SHALE AND SHALEY CLAY FILL IS PROHIBITED UNLESS PREAPPROVED BY THE GEOTECHNICAL ENGINEER.

FIELD DENSITY AND MOISTURE RELATIONSHIP TESTS SHALL BE PERFORMED TO INSURE COMPLIANCE WITH PROJECT SPECIFICATIONS. THE MINIMUM TESTING FREQUENCY SHALL BE ONE FIELD DENSITY TEST FOR EACH 2500 SQ. FT. OF FILL LIFT BUT NO LESS THAN THREE TESTS PER LIFT.

GENERAL CONSTRUCTION NOTES

1. CONSTRUCTION METHODS, CONSTRUCTION MATERIALS AND TESTING PROCEDURES SHALL CONFORM TO THE CITY OF WICHITA'S TECHNICAL SPECIFICATIONS FOR PUBLIC IMPROVEMENTS.
2. THE CONTRACTOR SHALL PROVIDE PERFORMANCE AND MAINTENANCE BONDS AS REQUIRED BY THE CITY OF WICHITA.
3. THE CONTRACTOR SHALL SECURE THE SERVICES OF AN ENGINEERING FIRM TO PROVIDE CONSTRUCTION STAKING AND INSPECTION AND VACUUM TESTING OF THE COMPLETED SEWER SYSTEM.
4. THE CONTRACTOR SHALL VERIFY LOCATION AND ELEVATION OF THE EXISTING SANITARY SEWER MAIN PRIOR TO BEGINNING CONSTRUCTION.
5. THE CONTRACTOR SHALL BE RESPONSIBLE FOR ANY DAMAGE AND SUBSEQUENT REPAIR OF UNDERGROUND UTILITIES OR PERTINENT OBSTRUCTIONS DURING THE COURSE OF HIS OR HER OPERATIONS ON THE CONSTRUCTION SITE OR THE IMMEDIATE AREA. CALL KANSAS ONE-CALL (1-800-344-7233) PRIOR TO BEGINNING CONSTRUCTION.
6. ALL DISTURBED UNPAVED AREAS SHALL BE SEEDED AND MULCHED.
7. LINE 1 FOR THIS PROJECT IS TO BE PRIVATELY MAINTAINED.

SANITARY SEWER ONLY.
INSPECTOR: LYLE POWERS, BAUGHMAN CO.
ASBUILT: 2/10/97 JEFF BRADLEY, BAUGHMAN CO.
APPROVED AS NOTED
By CITY ENGINEER OF WICHITA

Booked San. Sew. 4-17-97 JKB From Pis Boiths

Sanitary Sewers VRH 11/12/96
Storm Sewers VRH 11/12/96
Driveway Approaches
Water Mains
Paving

NOTE TO CONTRACTOR

INSPECTION AND TESTING FOR THIS PROJECT IS TO BE PROVIDED BY A LICENSED CONSULTING ENGINEERING FIRM UNDER CONTRACT WITH THE OWNER/DEVELOPER. SAID INSPECTION TO BE IN ACCORDANCE WITH THE CITY OF WICHITA STANDARD CONSTRUCTION ENGINEERING PRACTICES AND CERTIFIED BY A LICENSED PROFESSIONAL ENGINEER. NO WORK SHALL BE PERFORMED IN DEDICATED EASEMENTS OR THE PUBLIC RIGHT-OF-WAY BY THE CONTRACTOR WITHOUT SUCH INSPECTION NOR SHALL ANY WORK BE COMMENCED IN DEDICATED EASEMENTS OR PUBLIC RIGHT-OF-WAY WITHOUT WRITTEN AUTHORIZATION BY THE CITY ENGINEER.

REVISIONS	BY

SWS EXTENSION & REMOVAL OF SANITARY SEWER
FOR
AUTOZONE
PAWNEE AVENUE
WICHITA, KANSAS

PRIVATE PROJECT


Palmerton & Parrish, Inc.
2535 - K East Division 3416 East 13th Street
Springfield, MO 65803 Joplin, MO 64801
(417) 864-6000 (417) 624-2005

JOB NO.	DATE
069825	10/30/96
DRAWN	CHECKED
KRB	BRP
SCALE	
AS SHOWN	

DRAWING NO.
69825PPR

C1.1A

STORMWATER SYSTEM EXTENSION & REMOVAL OF SANITARY SEWER
LOTS 1, 2, 3, 8, 9 & 10, PAWNEE ADDITION
CITY OF WICHITA
MICHAEL E. LINDEBAK, P.E. : CITY ENGINEER
PRIVATE PROJECT NO.: 660PPS (607861)

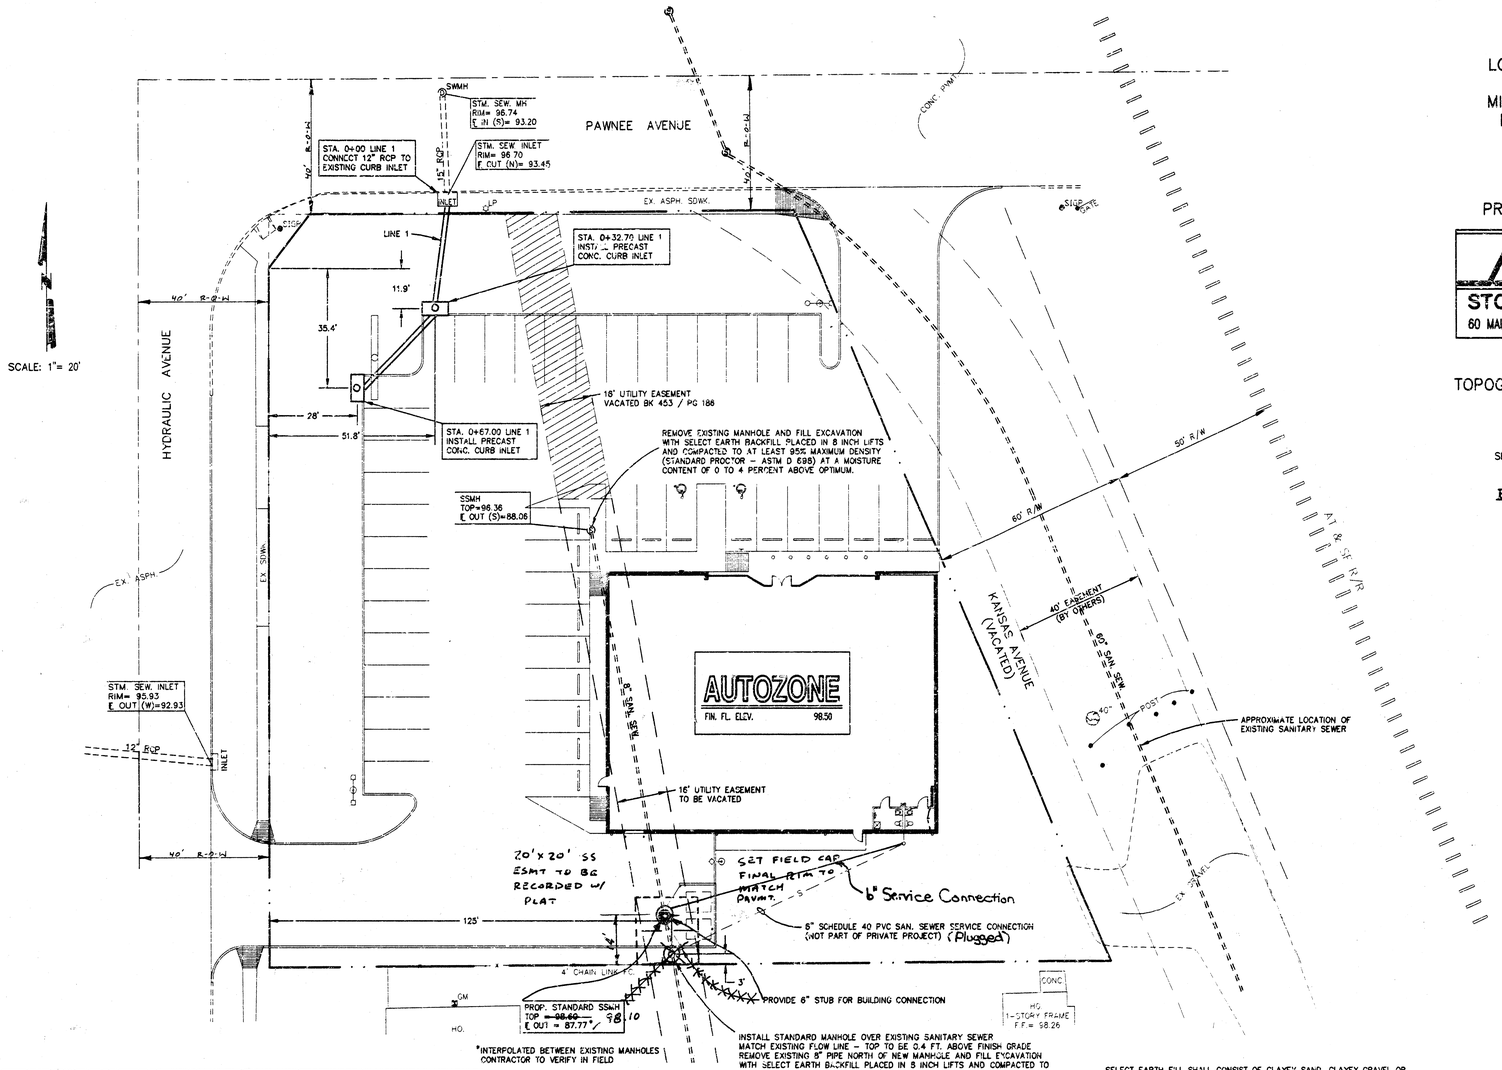

PROPOSED SITE IMPROVEMENTS PROVIDED BY:

AutoZone
STORE DEVELOPMENT PHONE (901) 495-8719
60 MADISON AVENUE MEMPHIS, TENNESSEE 38103 FAX (901) 495-8901


TOPOGRAPHIC & BOUNDARY SURVEY PERFORMED BY:
COOK, FLATT & STROBEL

SEE SURVEY FOR COMPLETE LEGAL DESCRIPTION INFORMATION.

BENCHMARK

BRASS DISK IN RAILROAD SIGNAL BASE
200'± EAST OF HYDRAULIC AND 25'± SOUTH OF PAWNEE. ELEV. 100.45


ELEVATION DATUM SHOWN IS CITY OF WICHITA DATUM.
ELEVATIONS SHOWN PLUS 1187.4 = SEA LEVEL DATUM.

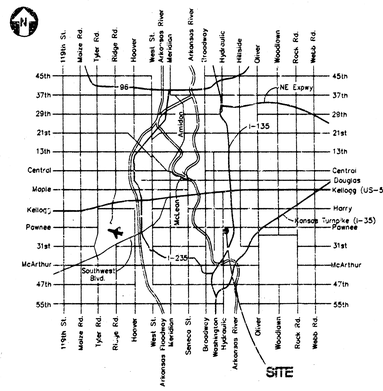


LOCATION MAP
NOT TO SCALE

SANITARY SEWER ONLY:
INSPECTOR: LYLE POWERS, BAUGHMAN CO.
ASBUILT: 2/10/97 JEFF BRADLEY, BAUGHMAN CO.
APPROVED AS NOTED
By CITY ENGINEER OF WICHITA
Sanitary Sewers VRH 11/12/96
Storm Sewers VRH 11/12/96
Driveway Approaches
Water Mains
Paving

Booked San. Sew. 4-17-97 JKB From As Builts

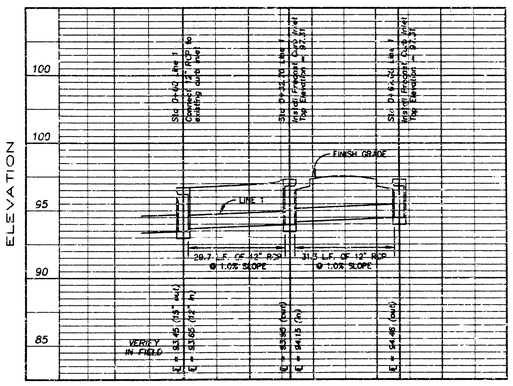

DRAINAGE PROFILE
HOR. SCALE: 1" = 20'
VERT. SCALE: 1" = 5'

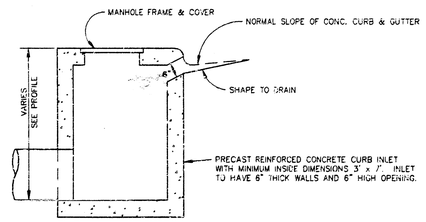

CURB INLET DETAIL
NTS

SELECT EARTH FILL SHALL CONSIST OF CLAYEY SAND, CLAYEY GRAVEL OR SANDY CLAY CLASSIFYING AS SC, GC OR CL IN ACCORDANCE WITH THE USCS OR INORGANIC LOW PLASTICITY LEAN CLAY CONTAINING AN APPRECIABLE PERCENTAGE OF GRAVEL OR ROCK FRAGMENTS ALSO CLASSIFYING AS CL OR WELL GRADED CRUSHED STONE. USE OF SHALE AND SHALEY CLAY FILL IS PROHIBITED UNLESS PREAPPROVED BY THE GEOTECHNICAL ENGINEER.

FIELD DENSITY AND MOISTURE RELATIONSHIP TESTS SHALL BE PERFORMED TO INSURE COMPLIANCE WITH PROJECT SPECIFICATIONS. THE MINIMUM TESTING FREQUENCY SHALL BE ONE FIELD DENSITY TEST FOR EACH 2500 SQ. FT. OF FILL LIFT BUT NO LESS THAN THREE TESTS PER LIFT.

GENERAL CONSTRUCTION NOTES

1. CONSTRUCTION METHODS, CONSTRUCTION MATERIALS AND TESTING PROCEDURES SHALL CONFORM TO THE CITY OF WICHITA'S TECHNICAL SPECIFICATIONS FOR PUBLIC IMPROVEMENTS.
2. THE CONTRACTOR SHALL PROVIDE PERFORMANCE AND MAINTENANCE BONDS AS REQUIRED BY THE CITY OF WICHITA.
3. THE CONTRACTOR SHALL SECURE THE SERVICES OF AN ENGINEERING FIRM TO PROVIDE CONSTRUCTION STAKING AND INSPECTION AND VACUUM TESTING OF THE COMPLETED SEWER SYSTEM.
4. THE CONTRACTOR SHALL VERIFY LOCATION AND ELEVATION OF THE EXISTING SANITARY SEWER MAIN PRIOR TO BEGINNING CONSTRUCTION.
5. THE CONTRACTOR SHALL BE RESPONSIBLE FOR ANY DAMAGE AND SUBSEQUENT REPAIR OF UNDERGROUND UTILITIES OR PERTINENT OBSTRUCTIONS DURING THE COURSE OF HIS OR HER OPERATIONS ON THE CONSTRUCTION SITE OR THE IMMEDIATE AREA. CALL KANSAS ONE-CALL (1-800-344-7233) PRIOR TO BEGINNING CONSTRUCTION.
6. ALL DISTURBED UNPAVED AREAS SHALL BE SEEDED AND MULCHED.
7. LINE 1 FOR THIS PROJECT IS TO BE PRIVATELY MAINTAINED.

NOTE TO CONTRACTOR

INSPECTION AND TESTING FOR THIS PROJECT IS TO BE PROVIDED BY A LICENSED CONSULTING ENGINEERING FIRM UNDER CONTRACT WITH THE OWNER/DEVELOPER. SAID INSPECTION TO BE IN ACCORDANCE WITH THE CITY OF WICHITA STANDARD CONSTRUCTION ENGINEERING PRACTICES AND CERTIFIED BY A LICENSED PROFESSIONAL ENGINEER. NO WORK SHALL BE PERFORMED IN DEDICATED EASEMENTS OR THE PUBLIC RIGHT-OF-WAY BY THE CONTRACTOR WITHOUT SUCH INSPECTION NOR SHALL ANY WORK BE COMMENCED IN DEDICATED EASEMENTS OR PUBLIC RIGHT-OF-WAY WITHOUT WRITTEN AUTHORIZATION BY THE CITY ENGINEER.

REVISIONS	BY

SWS EXTENSION & REMOVAL OF SANITARY SEWER
FOR
AUTOZONE
PAWNEE AVENUE
WICHITA, KANSAS

PRIVATE PROJECT

Palmerton & Parrish, Inc.
2835 – K East Division Springfield, MO 65803 (417) 864-6000
3416 East 13th Street Joplin, MO 64801 (417) 624-2005

Brad R. Parrish
REGISTERED PROFESSIONAL ENGINEER

JOB NO.	DATE
069825	12/30/96
DRAWN	CHECKED
KRB	BRP
SCALE	
AS SHOWN	

DRAWING NO.
69825PPR

C1.1A

18-S-4-10