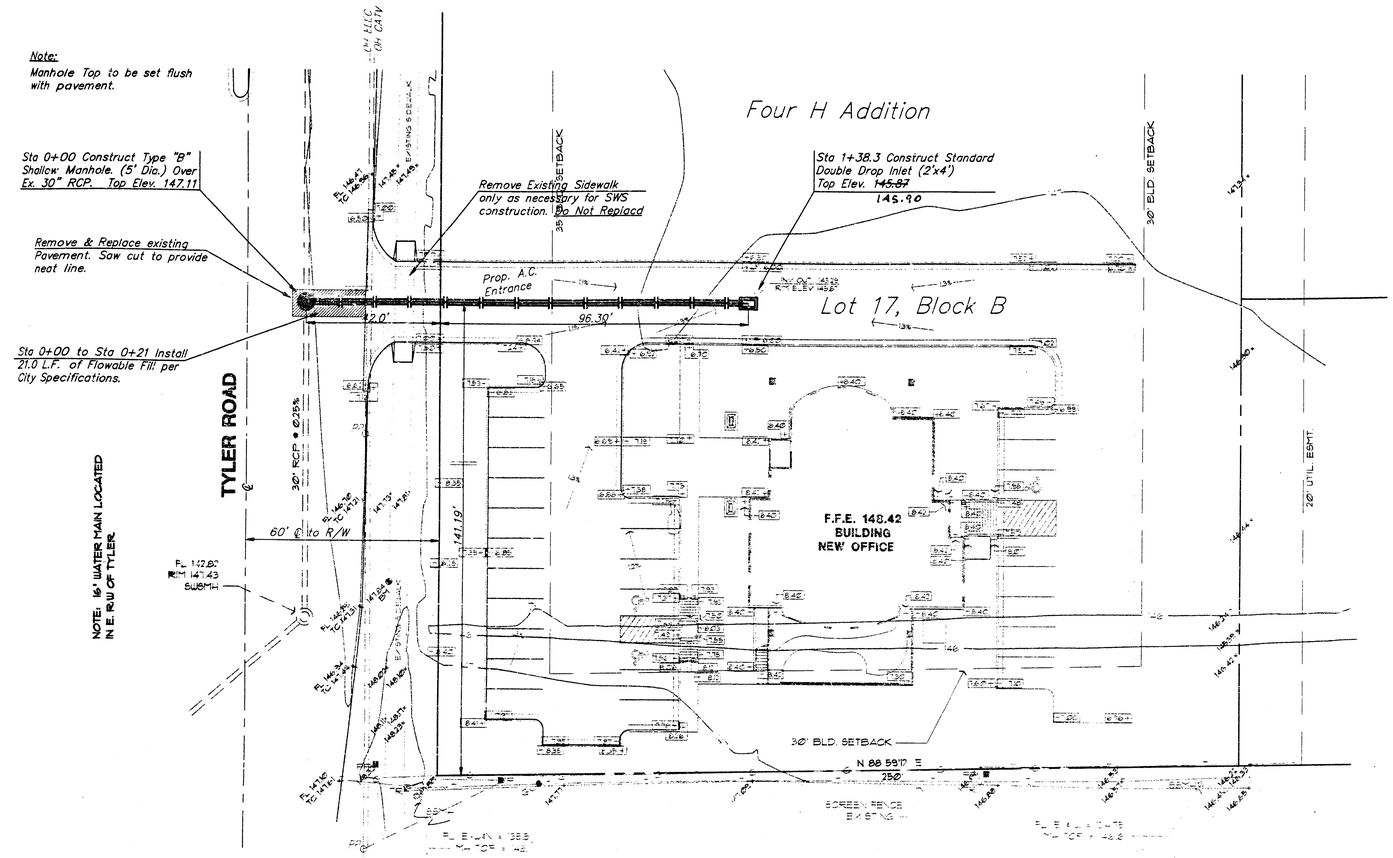


1. Contractor will be required to provide notice to utility companies a minimum of twenty-four (24) hours prior to any excavation, as follows:

Kansas One-Call	687-2470


The Contractor must notify the following in case of an emergency:

Cablevision	262-4270
or	263-2061
K.G.E. Gas Service Company	383-8650
Kansas Gas & Electric Company	383-8600
Peoples Natural Gas Company	942-7600
Southwestern Bell Telephone Company	1-571-2611
City of Wichita Water Department	268-4908
City of Wichita Sewer Maintenance	268-4071

2. Interurban traffic generated outside the project area and local business or apartment traffic generated within the project area are to be carried through construction as further promulgated by project special provisions. A minumum of one lane of south-bound traffic shall be provided at all times during construction.

3. Underground utility service lines and overhead utility pole lines are to be adjusted as necessary by others prior to construction unless the plans specifically call for their adjustment by the Contractor or unless the plans specifically identify a utility to be adjusted by its owner during construction. Existing utilities and their location, as shown on the plans, represent the best information obtainable for design. Location information has been obtained from the various utility companies and is either from company record drawings or company provided field locations. The Contractor will be required to work around existing utilities within the right-of-way which do not conflict with proposed construction.

4. A saw cut of at least one-half the depth of existing surface courses or one-fourth the depth of the existing total pavement thickness shall be provided at locations where proposed construction abuts an existing surface course or pavement for which partial removal of that surface or pavement is required, except when such saw cuts are within three (3) feet of an existing joint the removal shall be extended to the existing joint. Such saw cuts will not be paid for directly and this cost shall be considered as subsidiary to the removal of the surface or pavement.

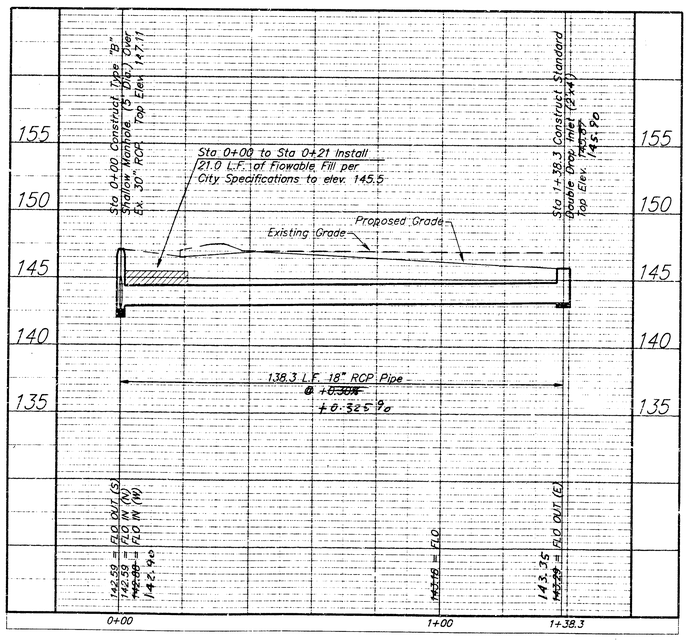

BY CITY ENGINEER OF WICHITA

Sanitary Sewers _____

Storm Sewers VRH 10/21/96

Street Approaches _____

Water Mains _____

Paving _____

INSPECTOR: LYLE POWERS
BAUGHMAN CO.

ASBUILT: 1/29/97 JFB
BAUGHMAN CO.

BOOKED 5-12-97 MCS B-264


STORM WATER SEWER TO SERVE PART OF LOT 17, BLK E. FOUR H ADDITION

Private Project Number
665 PPS (607861)

CITY OF WICHITA, KANSAS
Michael E. Lindebak, P.E. City Engineer

10/18/96

BAUGHMAN COMPANY P.A.
ENGINEERING, SURVEYING, & PLANNING
316-262-7271 • 315 ELLIS • WICHITA, KANSAS 67211

 

architects engineers interior design planners
105 N. Washington
Wichita, Kansas 67202
316.262.4700
fax 316.262.0902

LICENSED 13744 KANSAS PROFESSIONAL ENGINEER

©copyright 1996
Wilson Darnell Mann PA

ORTHODONTIC CLINIC for DR. DEAN BAESEL

TYLER
WICHITA, KANSAS

PRINTS ISSUED
9-18-96

WDM No.	d.b.	B.P.
95184	d.b.	B.P.

STORM WATER DRAINAGE PLAN

Sheet 1 of 2