
CONSTRUCTION PLANS FOR
STORM WATER SEWER AND SANITARY SEWER
TO SERVE
LOT 1, BLOCK 1, PEPPERWOOD LAKES
IN
THE CITY OF WICHITA,
SEDGWICK COUNTY, KANSAS
MICHAEL E. LINDEBAK, P.E. - CITY ENGINEER

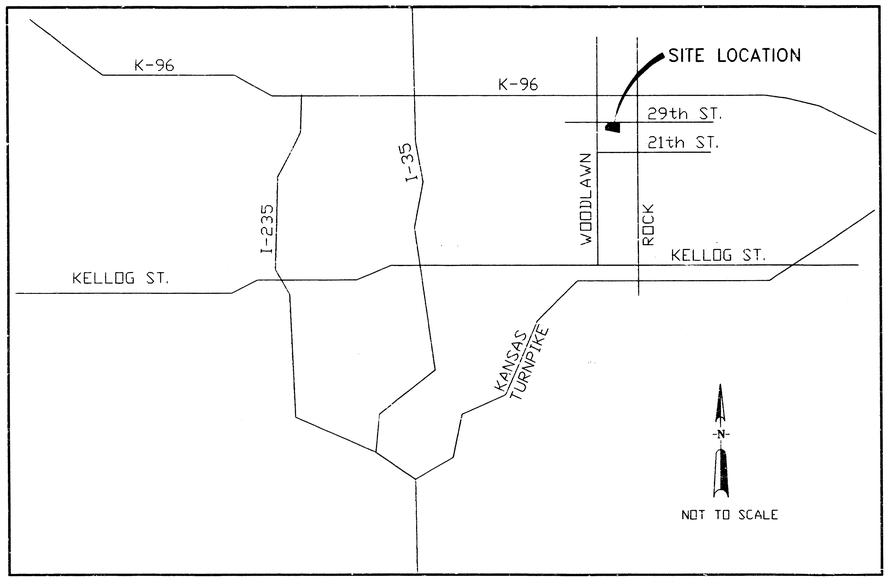

BENCHMARK
City of Wichita Benchmark
N.W. Corner RCBC. 100'±
South of 29th, on Governeour St.
DLK 8-93. El.=1370.86 msl
(183.46 City)

GENERAL NOTES:

1. Contractor will be required to provide notice to Utility companies a minimum of twenty-four (24) hours prior to any excavtion, as follows:
   Kansas One-Call 687-2470
   KG&E 264-1141
   KANEB 262-1408
2. The contractor shall be responsible for preserving property corners.
3. Contractor shall not start work on the Project until the project inspector is assigned to the project and is present on site. Any work done without inspection will be required to be uncovered for inspection.
4. The contractor shall notify pipeline and Electrical companies at least 24 hours in advance of any work being performed across and/or adjacent to pipelines and overhead Electrical.
5. All work shall be done in accordance with and conform to the City of Wichita Standard Specifications.

INDEX OF SHEETS

SHEET 1 COVER SHEET
SHEET 2 DETAIL SHEET - CITY OF WICHITA STANDARD
SHEET 3 STORM WATER SEWER
SHEET 4 STORM WATER SEWER
SHEET 5 SANITARY SEWER
SHEET 6 SANITARY SEWER
SHEET 7 SITE PLAN

DRAINAGE BOOKED 9-1-98 MCG D-402

DOUGLAS M. DAHMS 13826 PROFESSIONAL ENGINEER KANSAS

Drake Construction

CITY OF WICHITA PROJECT NO. 741-PPS (607861)

SEPTEMBER 1997

PLANS PREPARED BY
DOUGLAS M. DAHMS P.E.
ARVADA, COLO.

SPECIAL NOTE TO SANITARY SEWER CONTRACTOR:

NO SANITARY SEWER SERVICE LINE CONNECTIONS ARE TO BE MADE TO THE SANITARY SEWER LINES UNTIL ALL TESTING, INCLUDING ALL NECESSARY AIR AND TELEVISING TESTS, HAVE OCCURRED. NO SANITARY SEWER SERVICE LINES SHALL BE PLACED UNTIL ALL NECESSARY APPROVALS HAVE BEEN GRANTED BY THE CITY OF WICHITA FOR THE SEWER LINES. THE SEWER CONTRACTOR SHALL BE RESPONSIBLE FOR, AND MUST OBTAIN THE NECESSARY PERMITS TO INSTALL. THE SEWER SERVICE LINES FROM THE OFFICE OF CENTRAL INSPECTION (CONTACT BETTY ROARK @ 268-4341) PRIOR TO INSTALLING THE SANITARY SEWER SERVICES.

Sanitary Sewer Booked P-30 8/11/98 R. Loomis

APPROVED AS NOTED
BY CITY ENGINEER OF WICHITA


Sanitary Sewers VRH 10/16/97
Storm Sewers VRH 10/16/97


NOTE TO CONTRACTORS


Inspection and testing for this project is to be provided by a Licenced consulting Engineering Firm under contract with the Owner/Developer. Said Inspection to be in accordance with the City of Wichita standard construction engineering practices and certified by a Licenced Professional Engineer. No work shall be performed in dedicated easements or public-right-of-way by the Contractor without such inspection nor shall any work be commenced without written authorization by the City Engineer. All Construction and Materials shall comply with the City of Wichita Specifications and Standards (on file and available in the City Engineer's Office).

SEWER APPURTENANCES DETAILS

ADOPTED AS STANDARD DESIGN BY CITY OF WICHITA

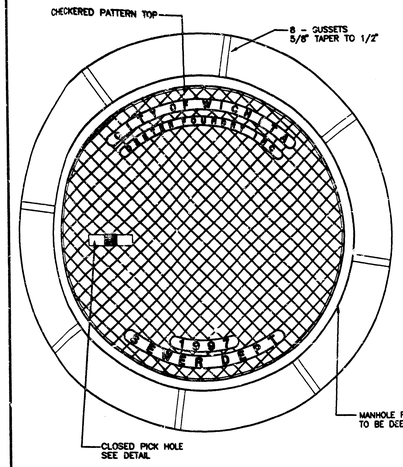

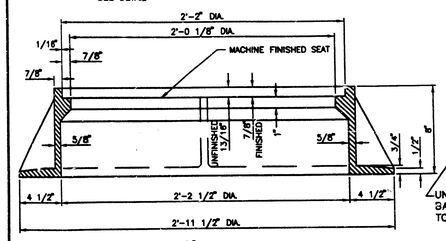


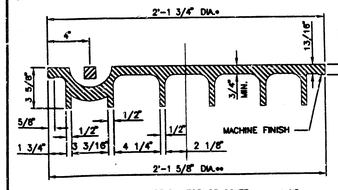

*OUTSIDE DIA. TOP OF COVER
**OUTSIDE DIA. BOTTOM OF COVER


MANHOLE FRAME AND COVER

(TOTAL WEIGHT = 430 LBS.)

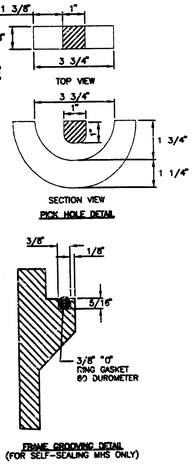


MANHOLE FRAME AND COVER NOTES


1. CAST IRON MANHOLE FRAME AND COVER SHALL CONFORM TO ASTM A-48, CLASS 30, OR BETTER.
2. THE FRAMES AND COVERS SHALL BE OF A NONROCKING TYPE OR WITH MACHINED BEARING SURFACES SO FITTING PARTS WILL NOT RATTLE OR ROCK UNDER TRAFFIC.
3. MANHOLE CASTINGS SHALL BE DEETER FOUNDRY INC. NO. 1261 OR APPROVED EQUAL, UNLESS OTHERWISE SPECIFIED IN THE SPECIAL CONDITIONS. (MINIMUM WT.=430 LBS.) ALL MANHOLE CASTINGS, REGARDLESS OF TYPE, SHALL BE CONSIDERED SUBSIDIARY TO THE UNIT PRICES BID FOR THE VARIOUS MANHOLE TYPES.
4. GRIND ALL BURRS SMOOTH, CLEAN THOROUGHLY, THEN APPLY SHOP COAT OF ASPHALT BASE PAINT.
5. THE MANUFACTURER SHALL SUBMIT SHOP DRAWINGS TO THE ENGINEER FOR APPROVAL PRIOR TO MANUFACTURE. THE ENGINEER SHALL RETAIN THE RIGHT TO REJECT CASTINGS NOT CONFORMING TO THE SPECIFICATIONS OR THE APPROVED SHOP DRAWINGS.
6. WHERE SELF-SEALING MANHOLE FRAMES ARE SPECIFIED ON THE PLANS, THE MANHOLE FRAME SHALL BE FURNISHED WITH AN APPROVED "O" RING GASKET GROOVED INTO THE BEARING SURFACE OF THE MANHOLE FRAME (PER DETAIL). THE "O" RING GASKET SHALL NOT BE INSTALLED IN THE MANHOLE FRAME UNTIL AFTER FINAL INSPECTION AND ACCEPTANCE OF THE PROJECT BY THE ENGINEER. THE CONTRACTOR SHALL SUPPLY TO THE OWNER ONE (1) REPLACEMENT "O" RING GASKET FOR EACH SELF-SEALING MANHOLE SPECIFIED.

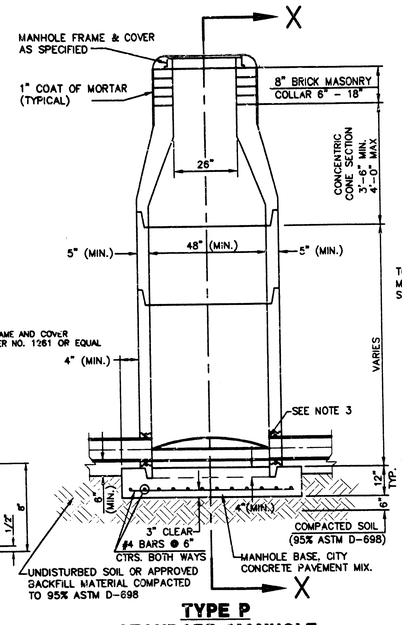


TYPE P STANDARD MANHOLE

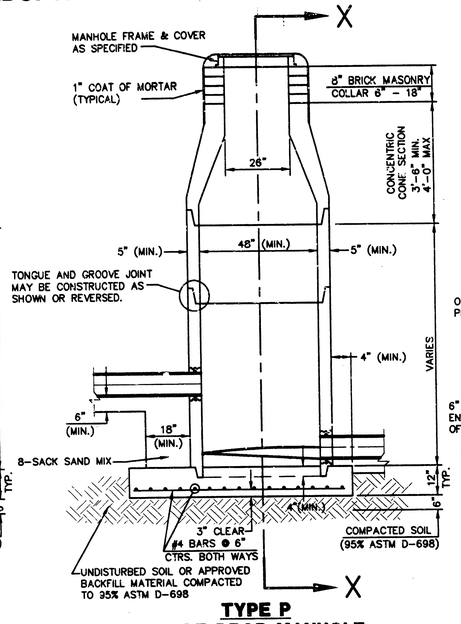

TYPE P INSIDE DROP MANHOLE

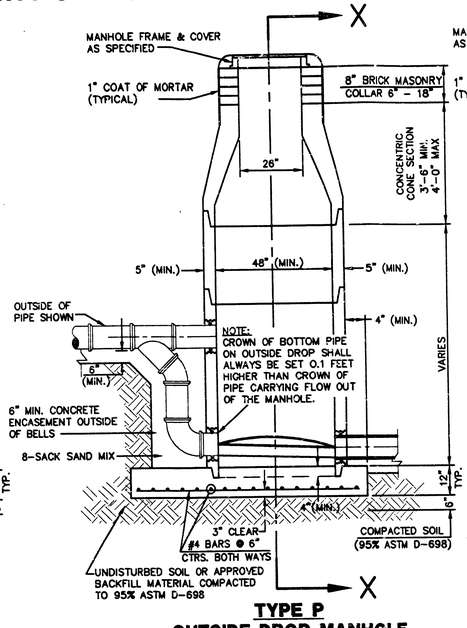

TYPE P OUTSIDE DROP MANHOLE

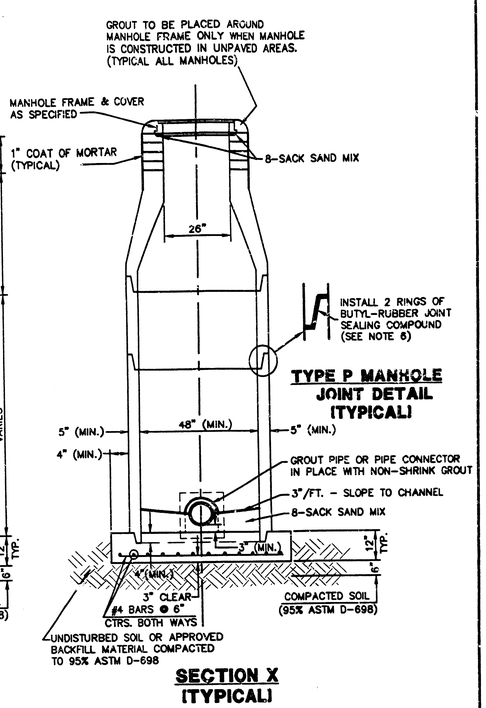


TYPE P MANHOLE JOINT DETAIL (TYPICAL)

SECTION X (TYPICAL)

GENERAL NOTES - PRECAST MANHOLE NOTES

1. ALL PRECAST CONCRETE MANHOLE SECTIONS SHALL CONFORM TO THE LATEST REVISIONS OF A.S.T.M. C478 AS MODIFIED BY THE SPECIFICATIONS.
2. NON-SHRINK GROUT SHALL BE NON-METALLIC TYPE.
3. APPROVED FLEXIBLE WATERSTOP GASKETS SHALL BE INSTALLED TO JOIN THE SEWER TO THE MANHOLE WALL WHEN A.B.S. COMPOSITE PIPE OR P.V.C. PIPE IS USED. FOR OTHER TYPES OF PIPE THE SEWER SHALL BE GROUTED IN PLACE WITH NON-SHRINK GROUT. THE SEWER PIPE SHALL BE SUPPORTED WITH CONCRETE ENCASEMENT A MINIMUM OF 3 FEET FROM THE MANHOLE WALL AND TO THE FIRST JOINT FOR V.C.P. SUCH THAT THE JOINT REMAINS FLEXIBLE.
4. ALL INSIDE SURFACES OF THE CONCRETE MANHOLE WHICH WOULD BE EXPOSED TO SEWER GAS SHALL BE COATED WITH 2 COATS TNEMEC SERIES 66 HI-BUILD EPOXOLINE, DRY THICKNESS OF 8 MILS (MIN.)
5. EXTERIOR MANHOLE WALLS SHALL BE COATED WITH 1 COAT MOBILARMA 633 BITUMINUS COATING.
6. JOINT SEALING COMPOUND SHALL BE KENT SEAL NO. 2 OR APPROVED EQUAL.
7. PRECAST MANHOLES SHALL BE SET AT LEAST 4 INCHES INTO THE MANHOLE BASE.
8. TOP OF MANHOLE FLOOR SLAB SHALL BE AT LEAST 3 INCHES BELOW THE FLOW LINE OF THE OUTLET PIPE TO INSURE SUFFICIENT MINIMUM THICKNESS OF SHAPED INVERT.
9. LIFTING HOLES SHALL BE FILLED WITH NON-SHRINK GROUT AND THE INTERIOR SURFACE COATED AS SPECIFIED.
10. MORTAR USED IN MASONRY CONSTRUCTION SHALL CONTAIN 8 SACKS OF CEMENT PER CUBIC YARD. CONCRETE USED IN MANHOLE BASES SHALL CONFORM TO THE REQUIREMENTS OF CONCRETE FOR CONCRETE PAVEMENT CONSTRUCTION AS SPECIFIED IN THE CITY STANDARD PAVING SPECIFICATIONS USING CITY CONCRETE PAVEMENT MIX WITHOUT AIR ENTRAINING ADMIXTURE. MORTAR SHALL BE PLACED AROUND THE MANHOLE RING AS SHOWN ON THE DRAWINGS WHEN MANHOLES ARE CONSTRUCTED IN UNPAVED AREAS. MANHOLES CONSTRUCTED WHERE PIPE SIZES ARE SMALLER THAN 24" SHALL HAVE AN INSIDE DIAMETER OF 4'. MANHOLES CONSTRUCTED WHERE PIPE SIZES ARE 24" OR LARGER SHALL HAVE AN INSIDE DIAMETER OF 5'. COMPLETED MANHOLE SHALL BE WITHOUT LEAKS AND WATER TIGHT.
11. REINFORCING STEEL SHALL BE INSTALLED IN THE MANHOLE BASES AND SHALL CONSIST OF NO. 4 BARS PLACED ON 6" CENTERS IN BOTH DIRECTIONS. THE MANHOLE BASE REINFORCEMENT SHALL BE PLACED AT LEAST 3" ABOVE THE BOTTOM OF THE MANHOLE BASE. ALL COSTS FOR FURNISHING AND INSTALLING REINFORCING STEEL SHALL BE INCLUDED IN THE UNIT PRICE BID FOR THE MANHOLE.
12. OPENINGS SHALL BE CUT INTO THE MANHOLE WALL WHEN OUTSIDE DROPS ARE CONSTRUCTED ON EXISTING MANHOLES. SUCH OPENINGS CUT INTO EXISTING MANHOLES SHALL BE AS SMALL AS PRACTICAL TO FACILITATE INSTALLING AND GROUTING THE NEW PIPE IN PLACE. WATERSTOP GASKETS SHALL BE USED WITH P.V.C. AND A.B.S. COMPOSITE PIPE. THE NEW PIPE SHALL BE GROUTED INTO THE OPENING USING AN APPROVED NONSHRINK GROUT FOR THE FULL MANHOLE WALL THICKNESS. THE EXTERIOR OF THE COMPLETED CONNECTION SHALL BE SEALED WITH AN APPROVED BITUMINOUS COATING SUCH THAT THE CONNECTION WILL BE WATER TIGHT. FLOOR OF MANHOLE SHALL BE MODIFIED TO FORM NEW FLOW CHANNEL FOR THE NEW CONNECTION AS INDICATED BY THE DRAWING. THIS WORK, INCLUDING MODIFICATION OF MANHOLE FLOOR, SHALL BE PAID FOR AT THE UNIT PRICE BID FOR OUTSIDE DROP STACK CONSTRUCTED ON EXISTING MANHOLE.
13. THE FLOORS OF ALL MANHOLES SHALL BE SHAPED WITH FLOW CHANNELS SUCH THAT THE MANHOLES WILL BE SELF CLEANING AND FREE OF AREAS WHERE SOLIDS COULD BE DEPOSITED AS SEWAGE FLOWS THROUGH THE MANHOLE FROM ALL INLET PIPES TO THE OUTLET PIPE. FLOW CHANNELS SHALL BE FORMED TO MATCH THE BOTTOM HALVES OF THE INFLOWING PIPES AND THE OUTFLOWING PIPE AS SHOWN BY THE DRAWINGS EXCEPT FOR INSIDE DROP MANHOLES. FLOW CHANNELS FOR INSIDE DROP MANHOLES SHALL BE CONSTRUCTED AS INDICATED BY THE DRAWING. MANHOLE FLOORS SHALL HAVE SLOPES OF 3 INCHES PER FOOT IN THE AREAS OUTSIDE OF THE FLOW CHANNELS SLOPED TOWARD THE FLOW CHANNELS. PIPES LAID THROUGH MANHOLES SHALL HAVE THE TOP HALF REMOVED TO NEAT LINES FOR THE FULL INSIDE DIAMETER OF THE MANHOLE. MANHOLE FLOORS SHALL THEN BE SHAPED AROUND THE BOTTOM HALF OF THE PIPE WHICH FORMS THE FLOW CHANNEL.
14. PIPES INSTALLED WITHIN THE EXCAVATION MADE FOR THE MANHOLE SHALL BE CRADLED WITH CONCRETE TO THE LIMITS OF THE MANHOLE EXCAVATION. WHEN CLAY PIPE IS USED, THE CRADLE SHALL EXTEND TO THE FIRST JOINT OUTSIDE THE MANHOLE. THE CRADLE SHALL BE TERMINATED AT THE CLAY PIPE JOINT IN A MANNER WHICH WILL MAINTAIN THE FLEXIBILITY OF THE JOINT. COST OF CRADLE WITHIN MANHOLE EXCAVATION OR TO CLAY PIPE JOINTS ADJACENT TO MANHOLE SHALL BE INCLUDED IN THE UNIT PRICE BID FOR THE MANHOLE.
15. MANHOLE COVER CASTINGS AND MANHOLE FRAME CASTINGS SHALL CONFORM TO THE REQUIREMENTS AS INDICATED IN THE STANDARD SPECIFICATIONS AND AS SHOWN IN THE STANDARD DETAIL DRAWING.
16. THE VERTICAL DROP IN INSIDE DROP MANHOLES SHALL NOT EXCEED 2' FOR INFLOWING PIPES. THE CROWNS OF INFLOWING PIPES SHALL NEVER BE SET LOWER THAN THE CROWN OF THE OUTFLOWING PIPE.
17. STANDARD MANHOLES AND STANDARD INSIDE DROP MANHOLES SHALL BE BID AS STANDARD MANHOLES FOR THE TYPE AND DIAMETER INDICATED. OUTSIDE DROP MANHOLES SHALL BE BID AS STANDARD OUTSIDE DROP MANHOLES FOR THE TYPE AND DIAMETER INDICATED. ALL MANHOLE DIAMETERS WILL BE 4' UNLESS INDICATED OTHERWISE.
18. A BRICK MASONRY COLLAR SHALL BE INSTALLED BETWEEN THE CAST IRON FRAME AND THE CONCENTRIC CONE. THE COLLAR WILL HAVE 8" WALLS AND A VERTICAL HEIGHT OF 6" MINIMUM AND 18" MAXIMUM. A 1" COAT OF MORTAR WILL BE PLASTERED ON THE OUTSIDE OF THE COLLAR.

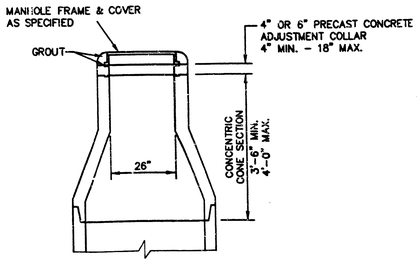

ALTERNATE CONSTRUCTION IN UNPAVED AREAS

REVISED: 6-12-86

2/6

MANHOLE DETAILS


CITY OF WICHITA, KANSAS

Design C.O.W.	Checked by	Checked by
Drawn by	Date	Date APRIL 1997 Job No. 96066802


I:\LIBRARY\CIVIL\SAN\WICHITA\MHDTLS-2 Thu Oct 16 10:16:25 1997


H:\CIVIL\96066\SAN\CHURCH\60LBRR 4-21-97 6:57:49 am CST


NOTE: GRATES SHALL BE IMPRINTED ON THE TOP SURFACE WITH "CITY OF WICHITA" USING LETTERS AT LEAST 1" IN HEIGHT. OTHER MARKING METHODS MAY BE USED ONLY IF APPROVED BY THE ENGINEER.

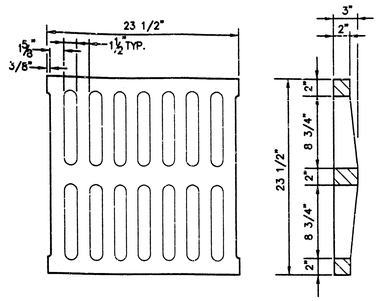


24"x24" GRATE DETAIL

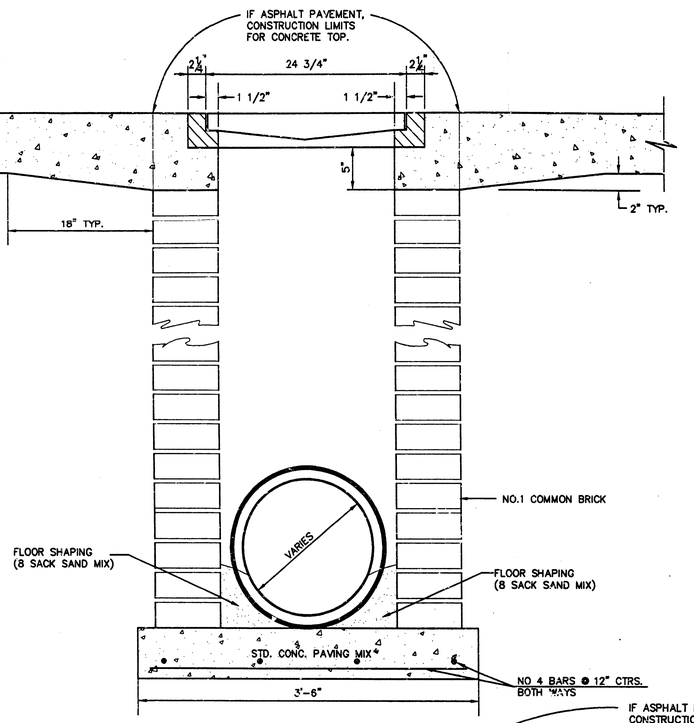


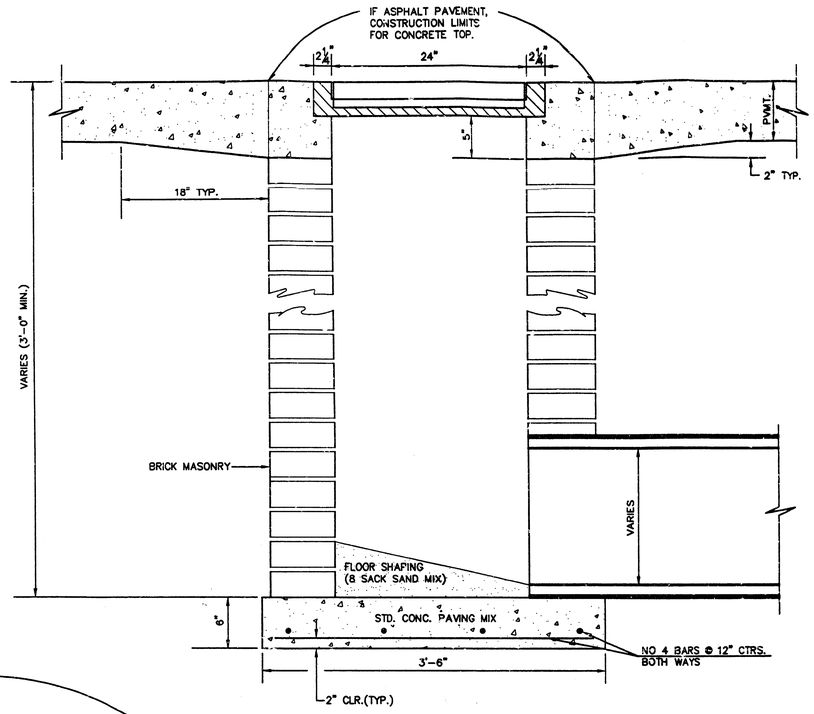

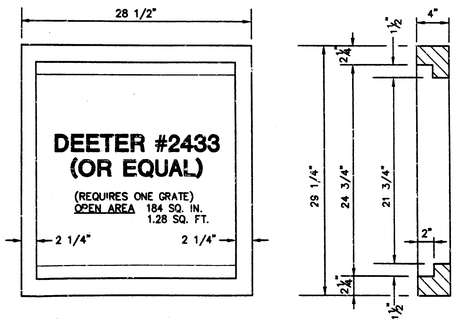


SINGLE 24"x24" FRAME DETAIL

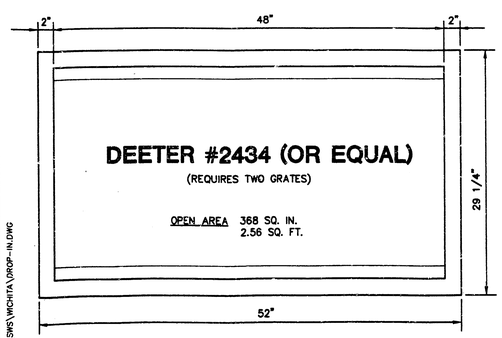

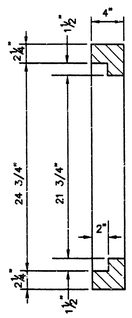

DOUBLE 24"x24" FRAME DETAIL

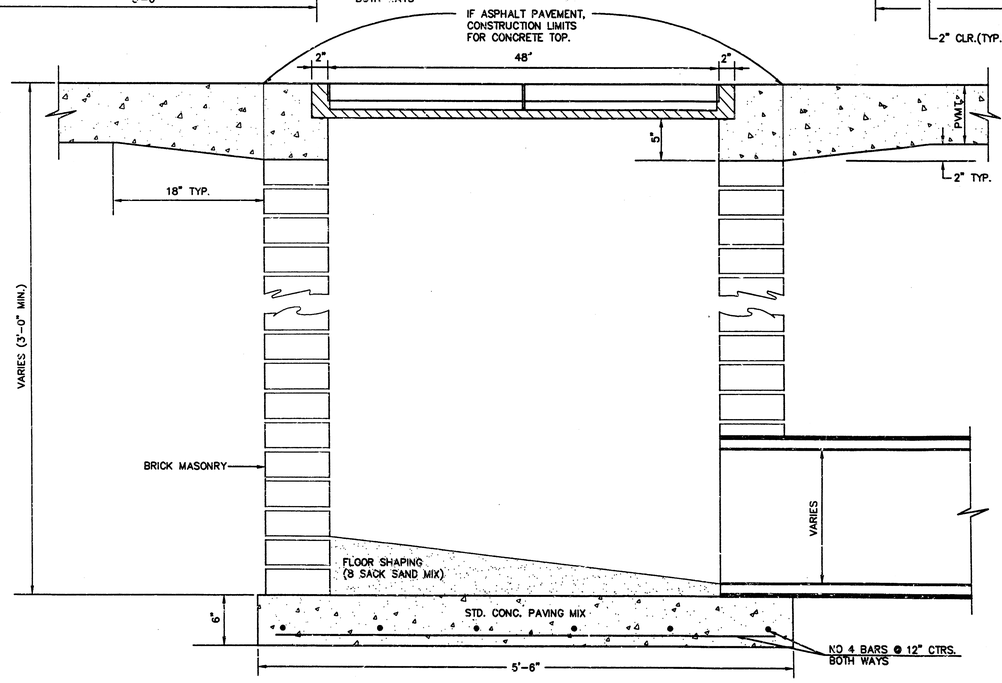

ORIFICE EQUATION		
$Q=C*A*\sqrt{2gh}$ C=0.60		
h (DEPTH)	#2433 (SINGLE)	#2434 (DOUBLE)
0.1	1.95 cfs	3.89 cfs
0.2	2.75 cfs	5.50 cfs
0.3	3.37 cfs	6.74 cfs
0.4	3.89 cfs	7.78 cfs
0.5	4.35 cfs	8.70 cfs
0.6	4.77 cfs	9.53 cfs
0.7	5.15 cfs	10.30 cfs
0.8	5.50 cfs	11.01 cfs
0.9	5.84 cfs	11.67 cfs
1.0	6.15 cfs	12.30 cfs

REVISED: 5-8-90 JNJ


DROP INLET DETAILS


CITY OF WICHITA, KANSAS

Design C.O.W.	Checked by	Checked by	
Drawn by	Date	Date	Job No.

F:\LIBRARY\CIVIL\SWS\WICHITA\DROP-IN.DWG

I:\MAP\DWG\121/15/1991 10:35:55 AM

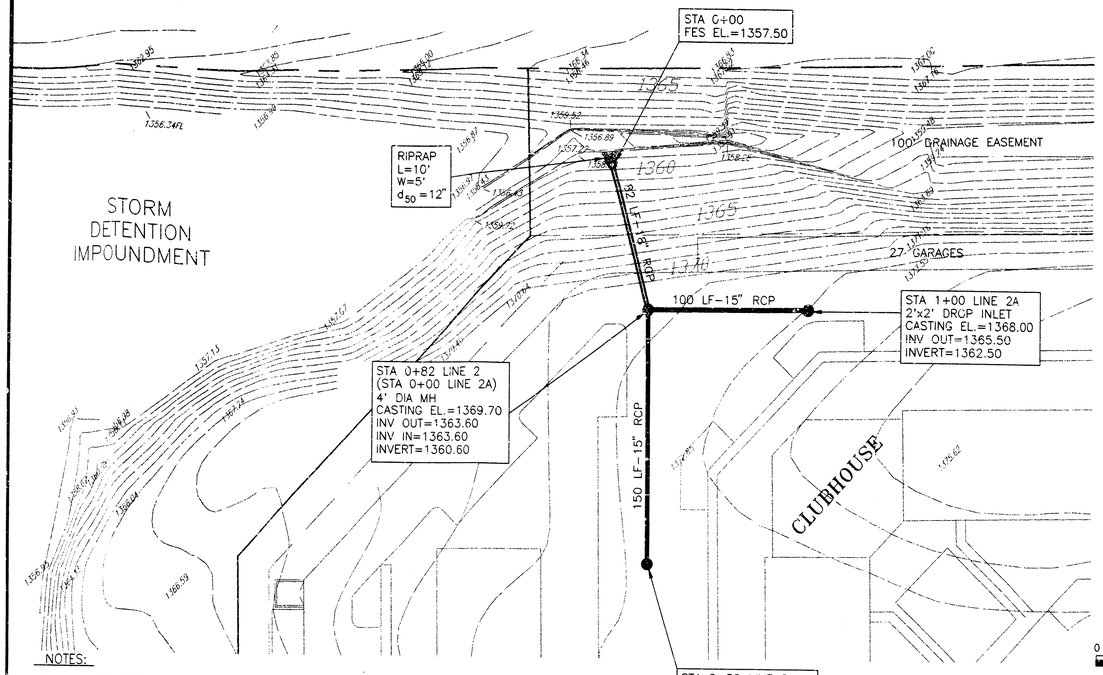

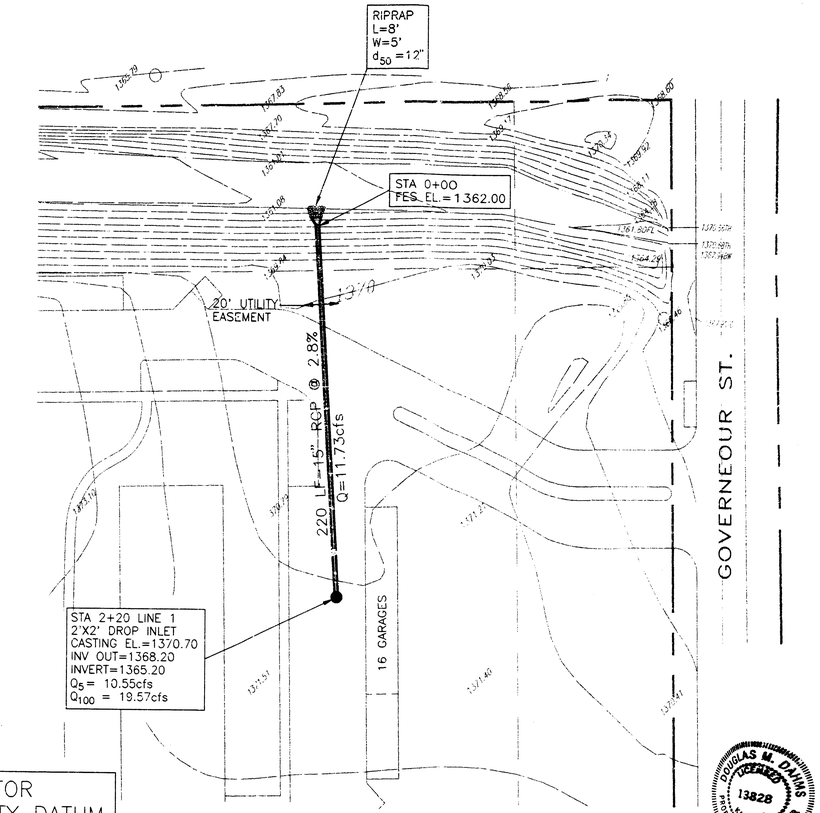


0 40 80
SCALE 1" = 40'

NOTES:

1. ALL INLETS AND MANHOLE STRUCTURES HAVE 3' SILT TRAPS IN THE BOTTOM OF BARREL SECTION. CONTRACTOR TO CLEAN ALL SILT TRAPS AFTER THE COMPLETION OF CONSTRUCTION, PRIOR TO ACCEPTANCE BY OWNER. ALL PIPE FLOWS ARE COMPUTED FOR NON-PRESURIZED PIPE CONDITIONS.
2. CONTRACTOR TO PLACE STRAW BALES OR STAKED SILT FENCE AROUND ALL INLETS AFTER CONSTRUCTION FOR EROSION CONTROL.

CONVERSION FACTOR
USGS = 1187.4 + CITY DATUM

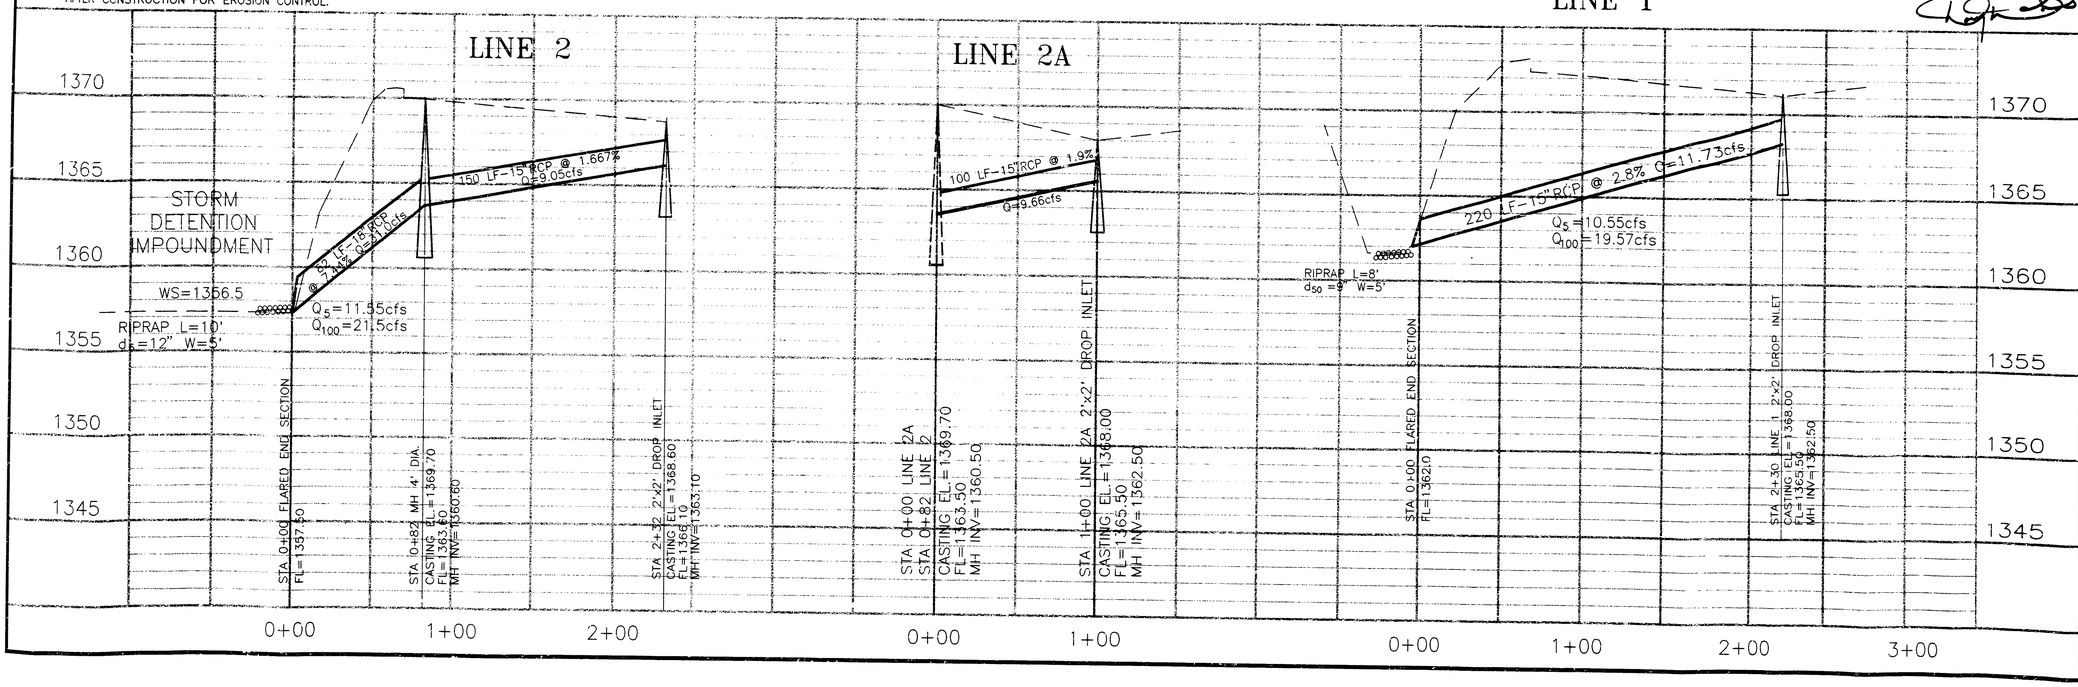

LINE 1


DOUGLAS M. DAHMS
LICENSED
13828
KANSAS
PROFESSIONAL ENGINEER


LOT 1, BLOCK 1
PEPPERWOOD LAKES
741 PPS (607861)

Douglas M. Dahms P.E.
ENGINEERING
CONSULTANTS
6368 Holman Ct. Arvada Col. 80004


STORM SEWER PLAN
SHEET 3

DATE:
SEPT, 1997

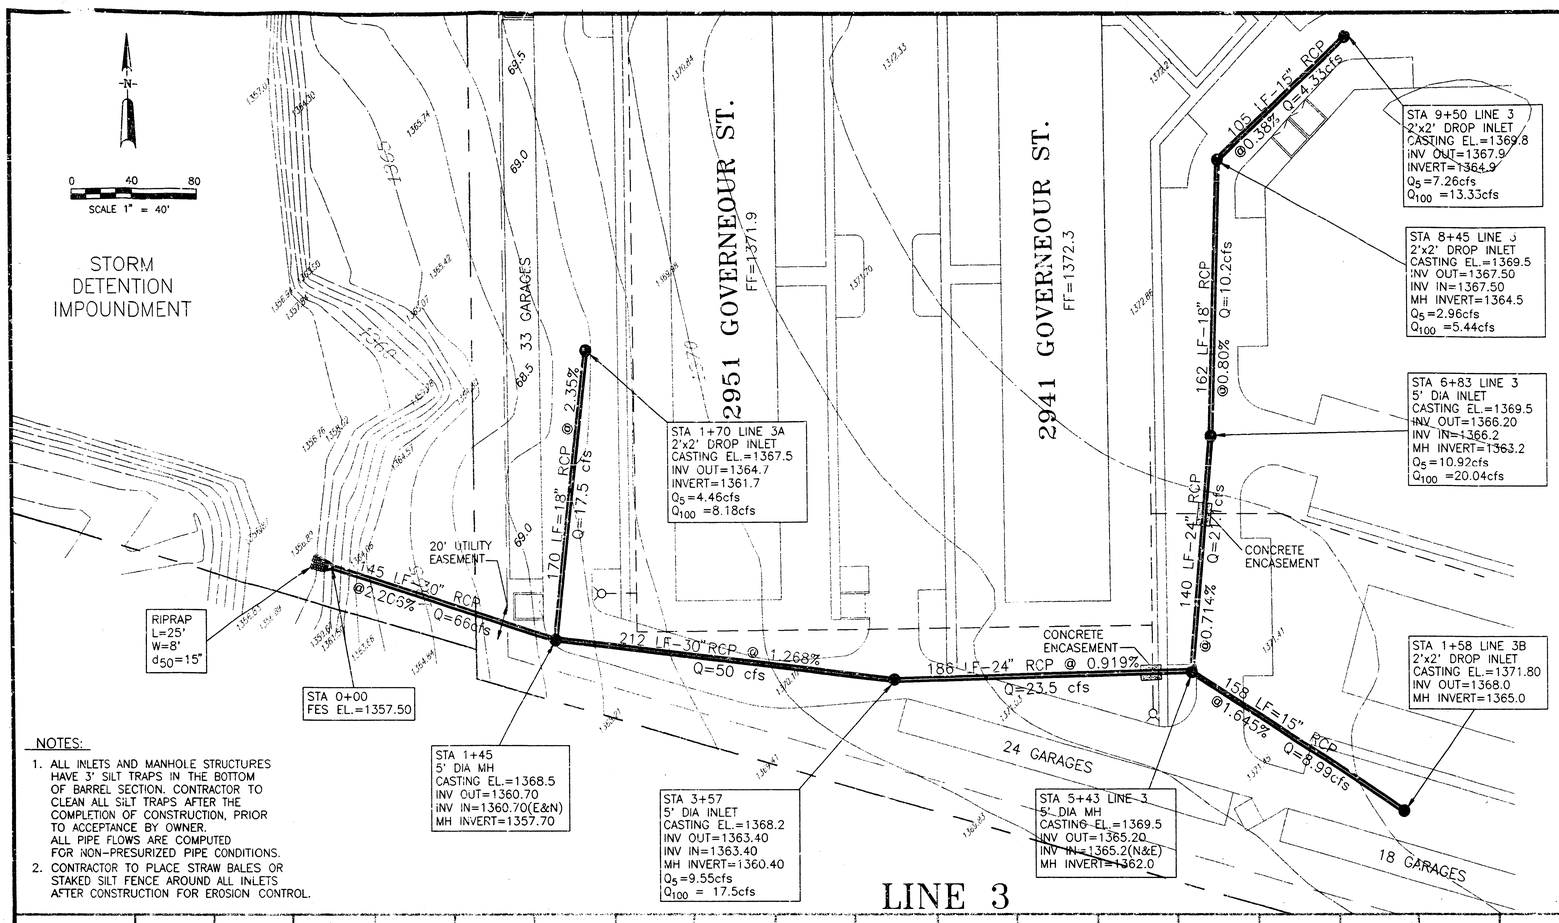

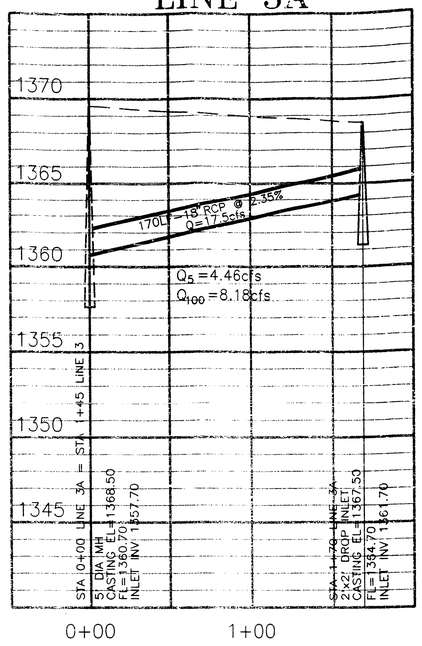

CONVERSION FACTOR
USGS = 1187.4 + CITY DATUM

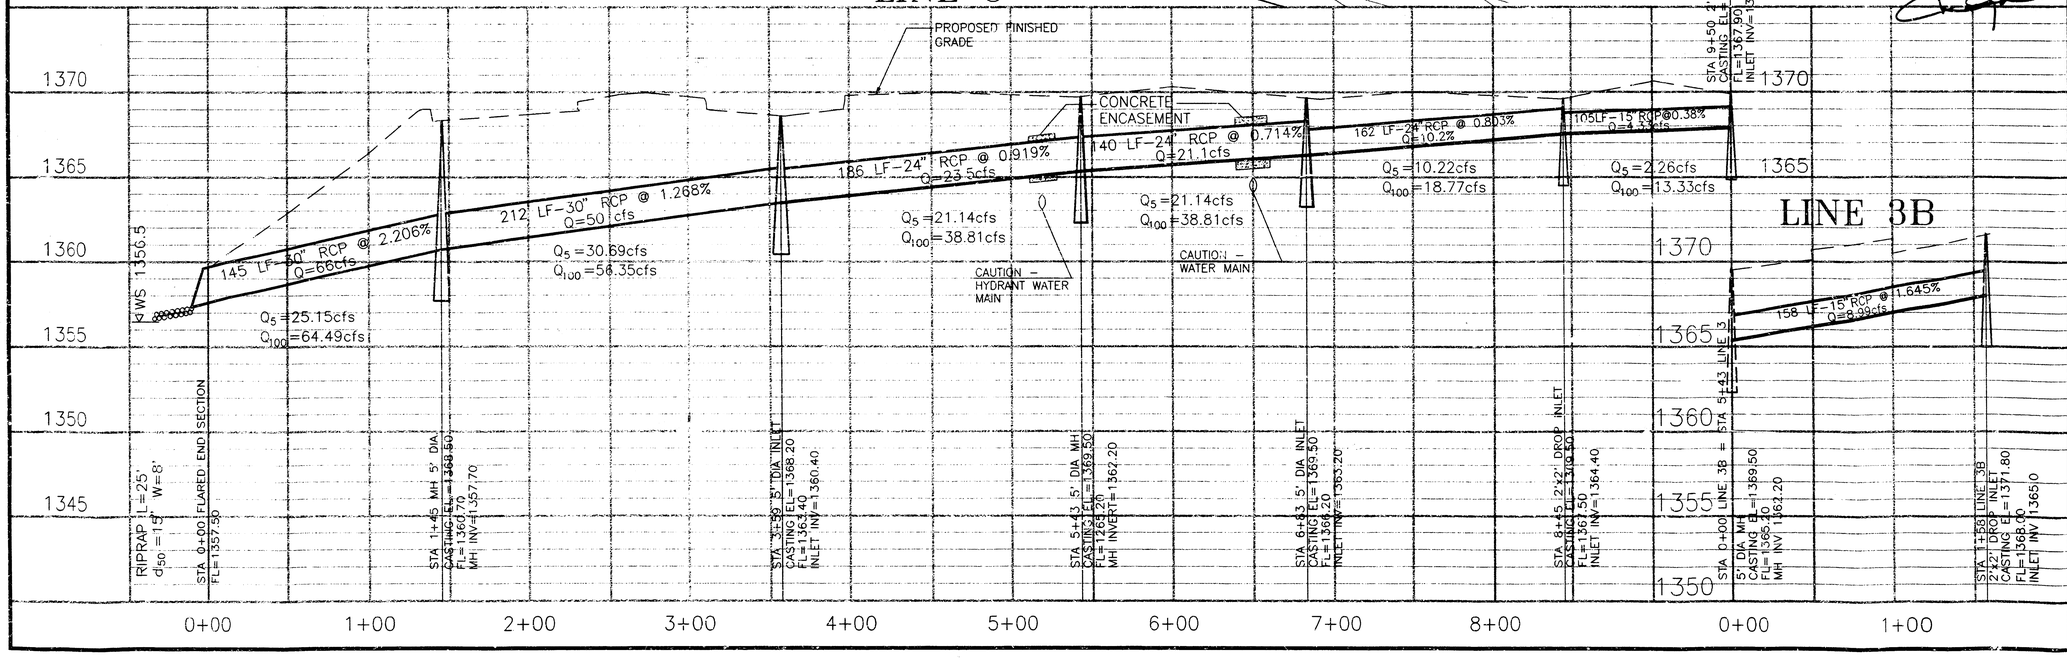

DOUGLAS M. DAHMS
13828
KANSAS
REGISTERED PROFESSIONAL ENGINEER


LOT 1, BLOCK 1
PEPPERWOOD LAKES
741 PPS (607861)

Douglas M. Dahms P.E.
ENGINEERING CONSULTANTS
6368 Holman Ct. Arvada Col. 80004

STORM SEWER PLAN
SHEET 4


DATE:
SEPT, 1997

NOTE: MANHOLE CASTINGS TO BE STANDARD CITY OF WICHITA SPECIFICATIONS, FOR SANITARY SEWER M.H.s. MANHOLE BARREL SECTION TO MEET CITY SPECIFICATION.

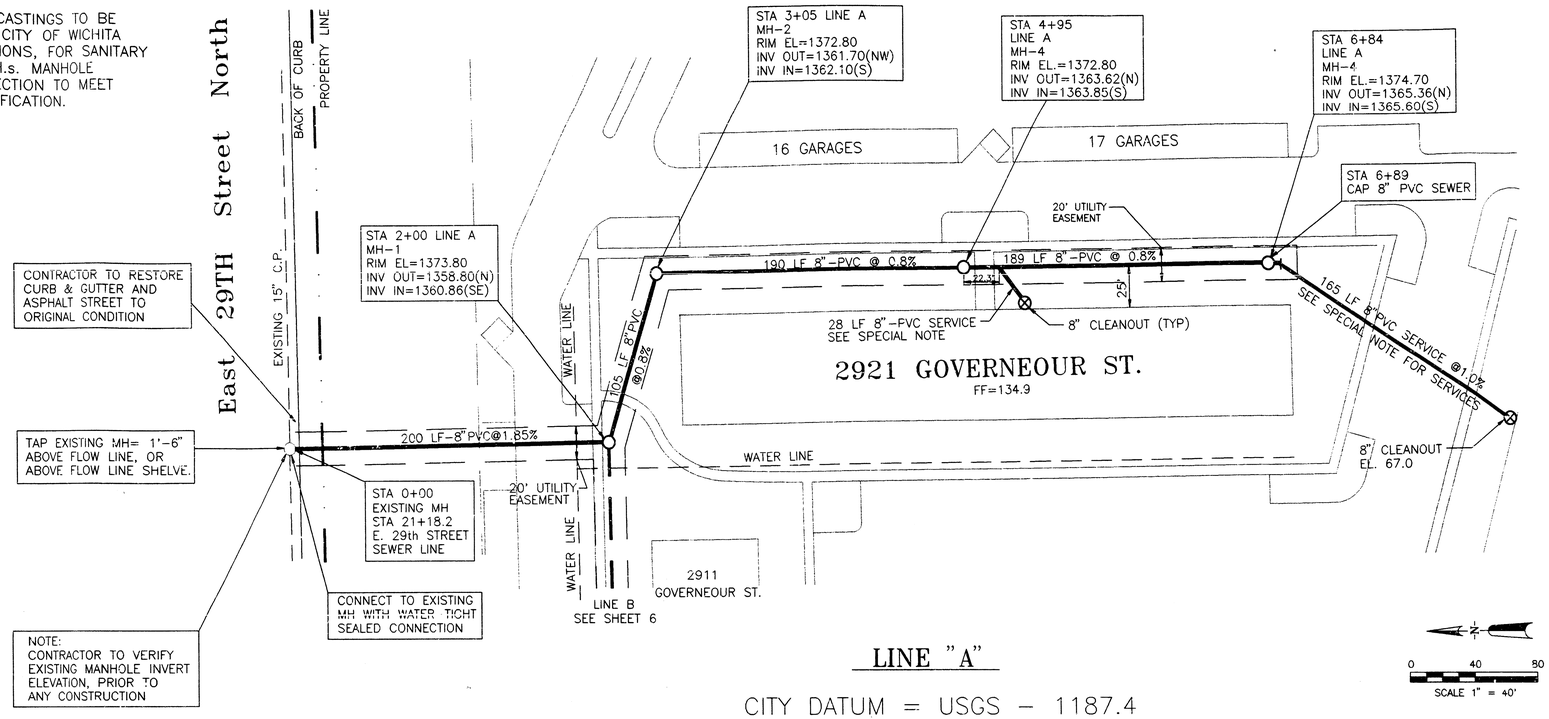

LINE "A"

CITY DATUM = USGS - 1187.4

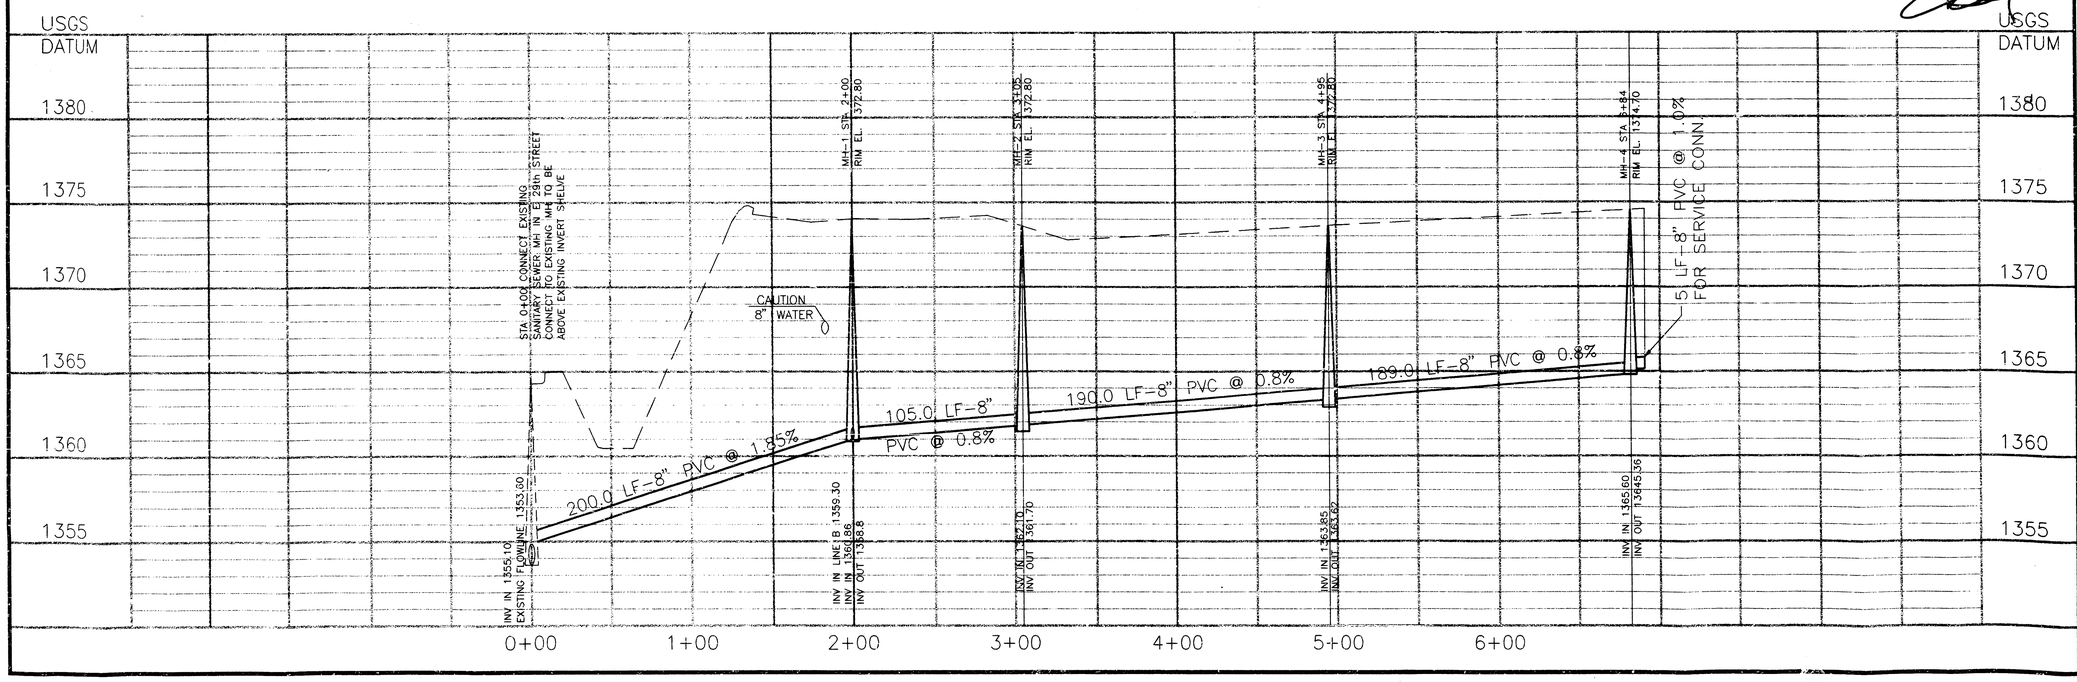

LOT 1, BLOCK 1
PEPPERWOOD LAKES
741 PPS (607861)


DOUGLAS K. DAHMS
LICENSED
13829
KANSAS
PROFESSIONAL ENGINEER

Douglas M. Dahms P.E.
ENGINEERING CONSULTANTS
6368 Holman Ct. Arvada Col. 80004


SANITARY SEWER PLAN

SHEET 5

DATE:
AUG, 1997

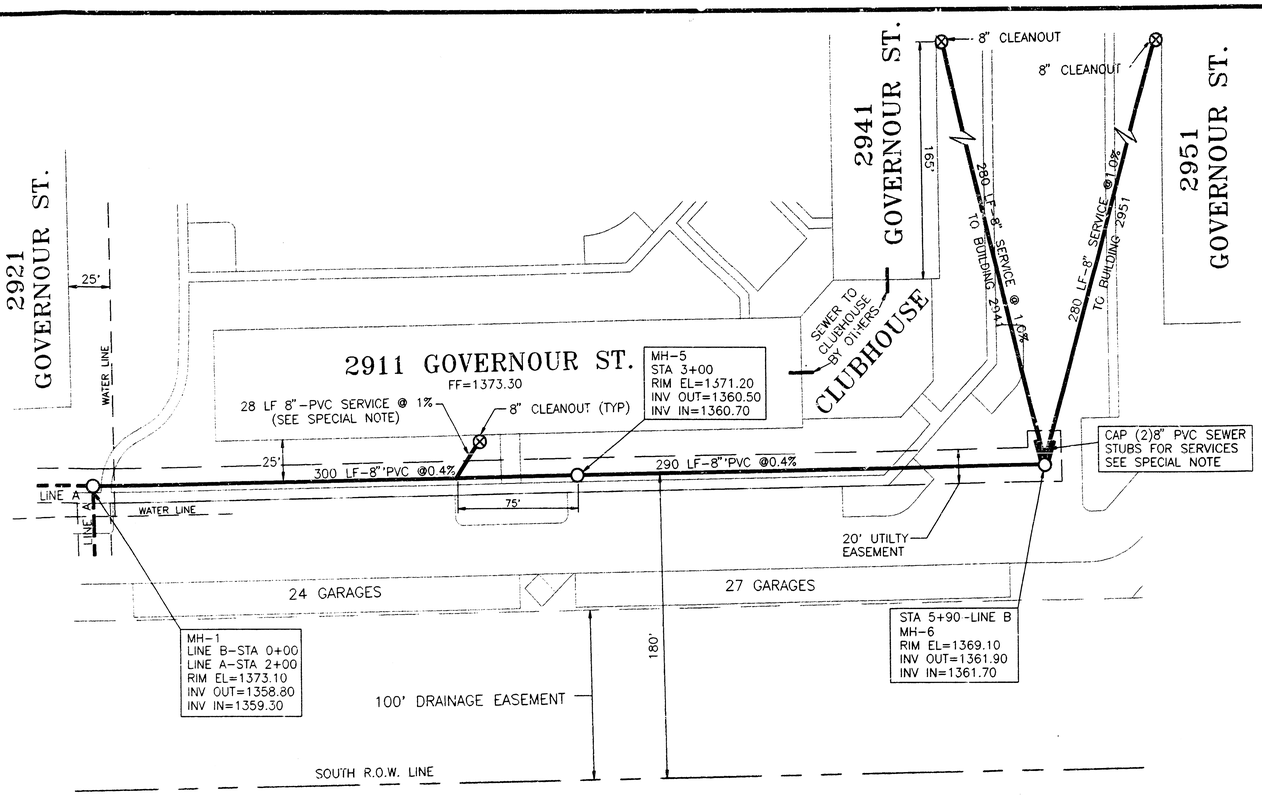

NOTE: MANHOLE CASTINGS TO BE STANDARD CITY OF WICHITA SPECIFICATIONS, FOR SANITARY SEWER M.H.s. MANHOLE BARREL SECTION TO MEET CITY SPECIFICATION.

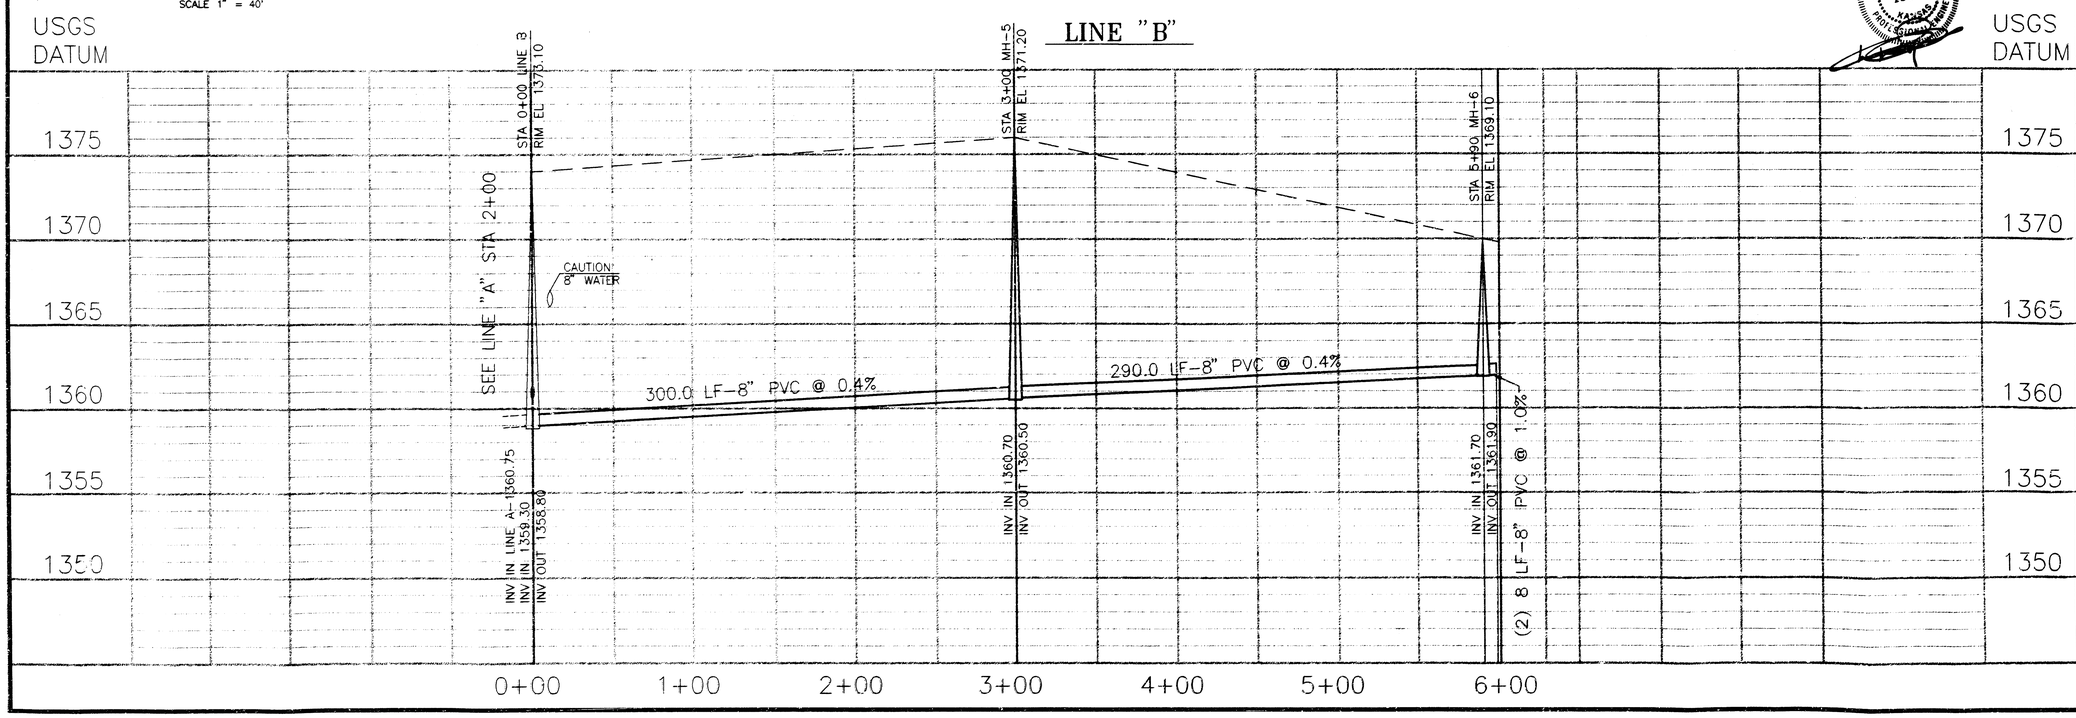

DOUGLAS M. DAHMS LICENSED 13828 KANSAS PROFESSIONAL ENGINEER


LOT 1, BLOCK 1
PEPPERWOOD LAKES
741 PPS (607861)

Douglas M. Dahms P.E.
Engineering Consultants
6368 Holman Ct. Arvada Col. 80004

SANITARY SEWER PLAN

SHEET 6

DATE: SEPT, 1997

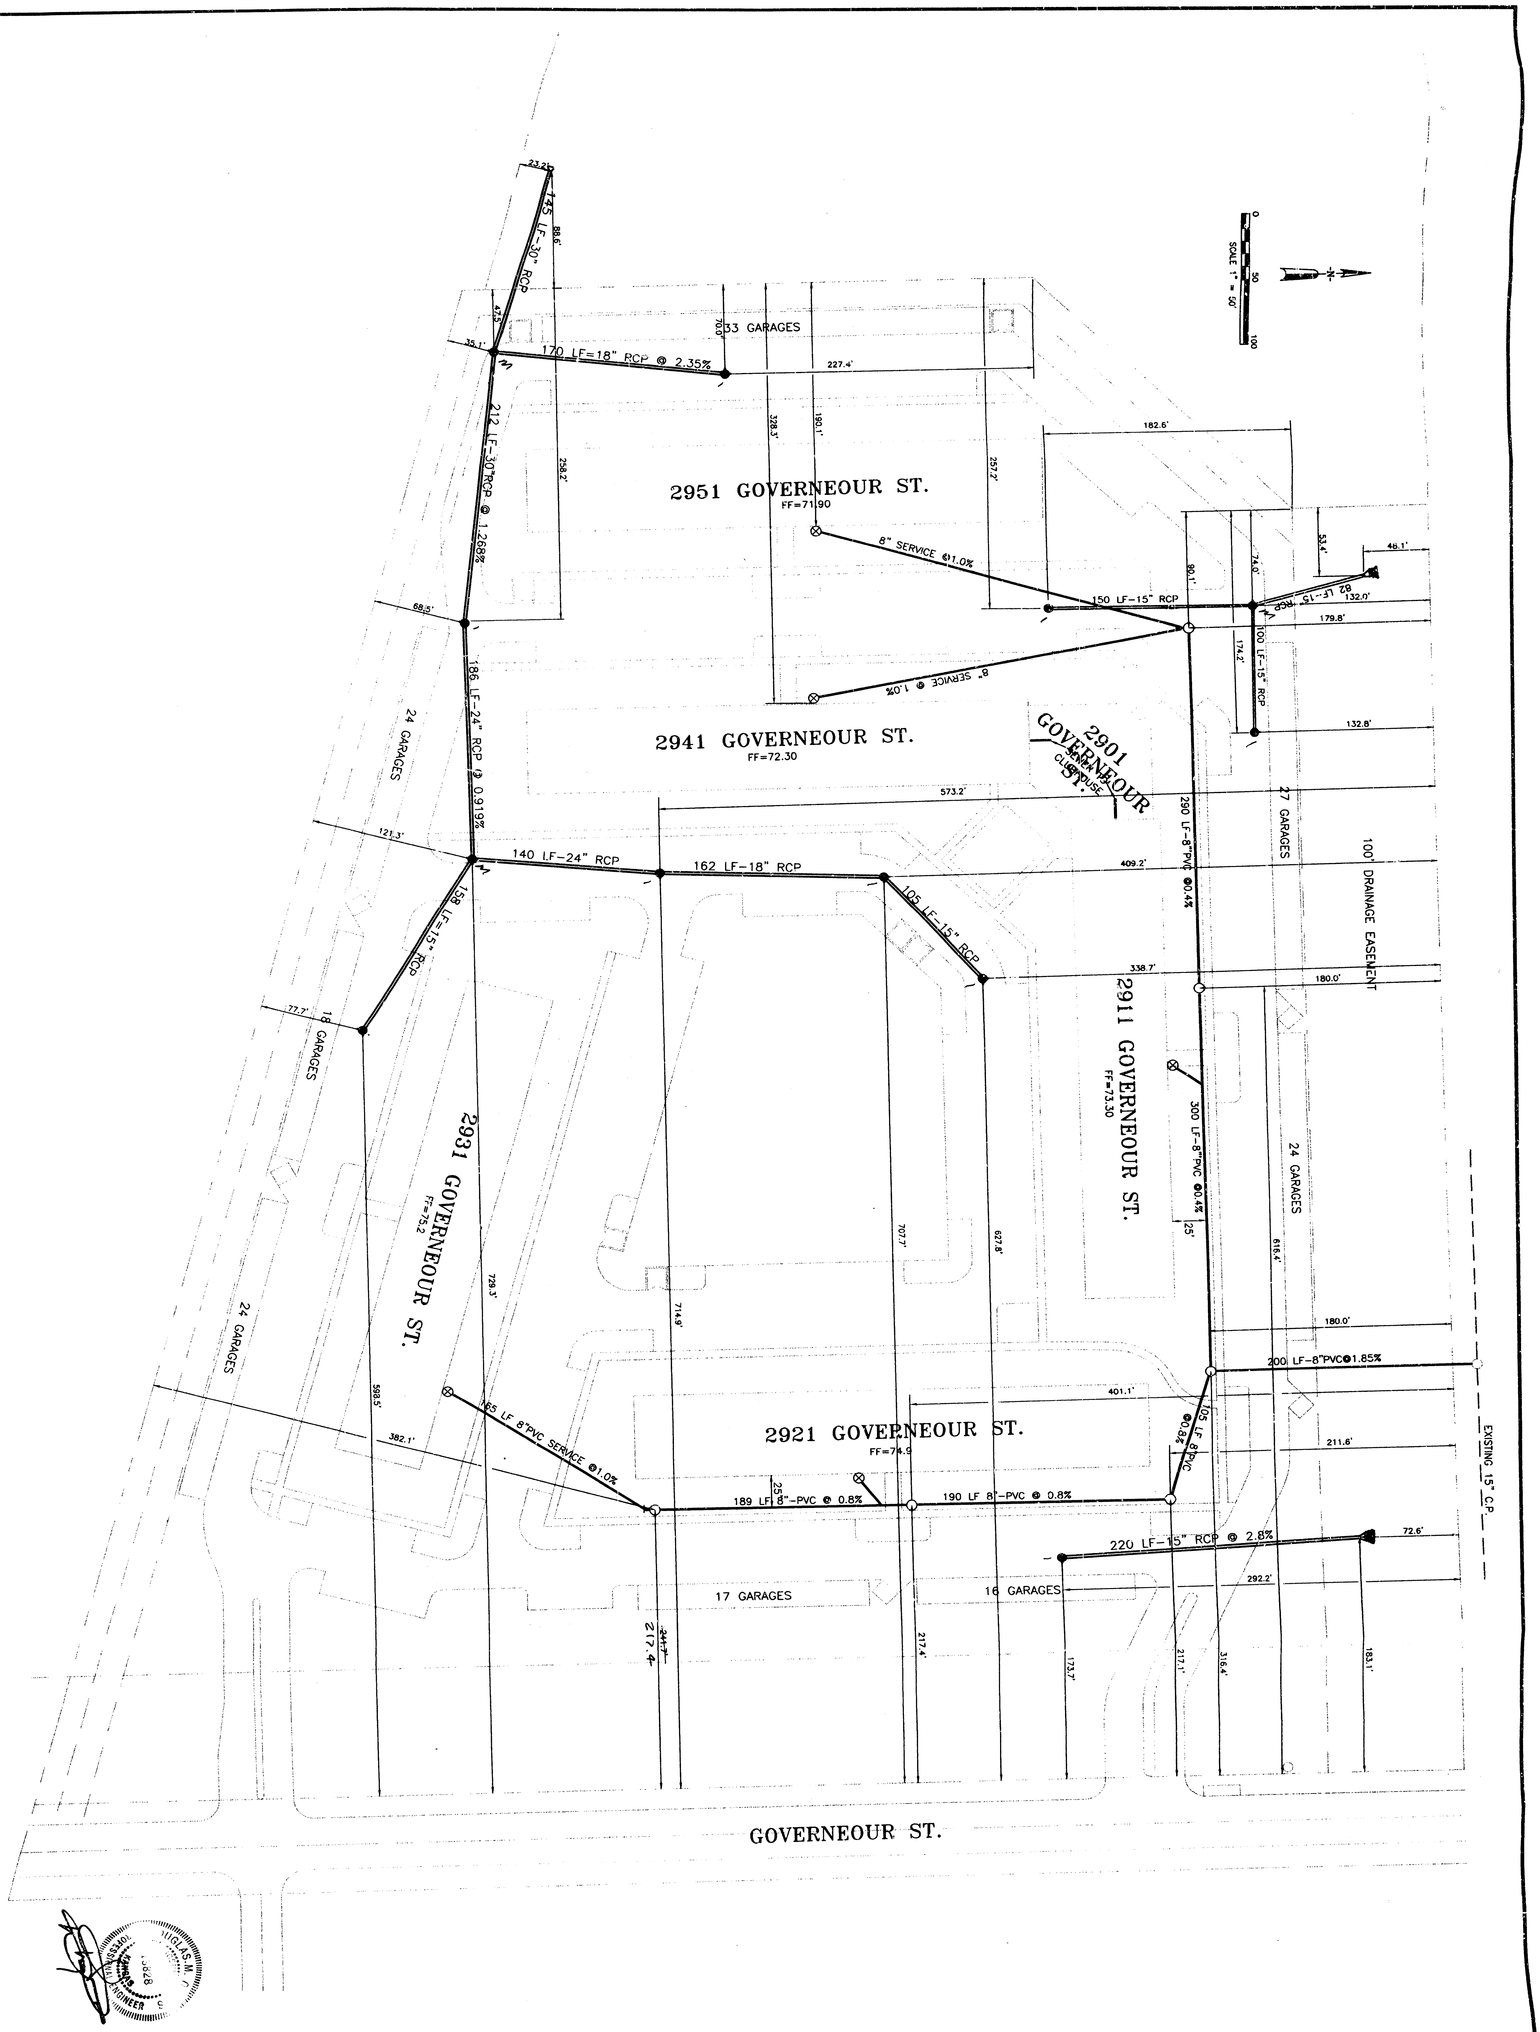

SITE PLAN


SHEET 7

DATE: SEPT, 1997

Douglas M Dahms P.E.
ENGINEERING
CONSULTANTS
6368 Holman Ct. Arvada Col. 80004

LOT 1, BLOCK 1
PEPPERWOOD LAKES
741 PPS (607861)

AS BUILT
CONSTRUCTION PLANS FOR
STORM WATER SEWER
TO SERVE
LOT 1, BLOCK 1, PEPPERWOOD LAKES
IN
THE CITY OF WICHITA,
SEDGWICK COUNTY, KANSAS
MICHAEL E. LINDEBAK, P.E. - CITY ENGINEER

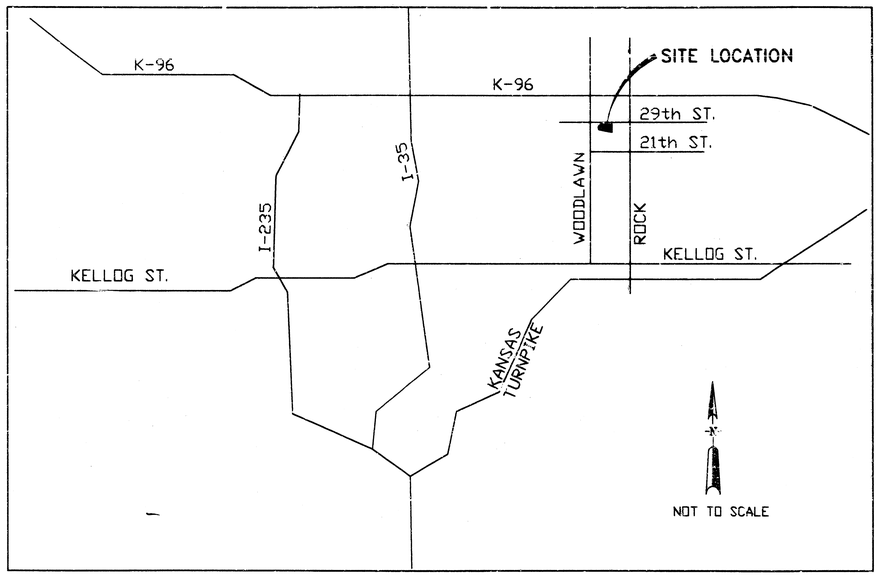

BENCHMARK
City of Wichita Benchmark
N.W. Corner RCBC. 100'±
South of 29th, on Governeour St.
DLK 3--93. El.=1370.86 msl
(183.46 City)

GENERAL NOTES:

1. Contractor will be required to provide notice to Utility companies a minimum of twenty-four (24) hours prior to any excavtion, as follows:
   Kansas One-Call 687-2470
   KG&E 264-1141
   KANEB 262-1408
2. The contractor shall be responsible for preserving property corners.
3. Contractor shall not start work on the Project until the project inspector is assigned to the project and is present on site. Any work done without inspection will be required to be uncovered for inspection.
4. The contractor shall notify pipelins and Electrical companies at least 24 hours in advance of any work being performed across and/or adjacent to pipelines and overhead Electrical.
5. All work shall be done in accordance with and conform to the City of Wichita Standard Specifications.

INDEX OF SHEETS

SHEET 1 COVER SHEET
SHEET 2 DETAIL SHEET- CITY OF WICHITA STANDARDS
SHEET 3 STORM WATER SEWER
SHEET 4 STORM WATER SEWER
~~SHEET 5 SANITARY SEWER~~
~~SHEET 6 SANITARY SEWER~~
~~SHEET 7 SITE PLAN~~



CITY OF WICHITA PROJECT NO. 741-PPS W (607861)

SEPTEMBER 1997

PLANS PREPARED BY
DOUGLAS M. DAHMS P.E.
ARVADA, COLO.

SPECIAL NOTE TO SANITARY SEWER CONTRACTOR:

NO SANITARY SEWER SERVICE LINE CONNECTIONS ARE TO BE MADE TO THE SANITARY SEWER LINES UNTIL ALL TESTING, INCLUDING ALL NECESSARY AIR AND TELEVISING TESTS, HAVE OCCURRED. NO SANITARY SEWER SERVICE LINES SHALL BE PLACED UNTIL ALL NECESSARY APPROVALS HAVE BEEN GRANTED BY THE CITY OF WICHITA FOR THE SEWER LINES. THE SEWER CONTRACTOR SHALL BE RESPONSIBLE FOR, AND MUST OBTAIN THE NECESSARY PERMITS TO INSTALL THE SEWER SERVICE LINES FROM THE OFFICE OF CENTRAL INSPECTION (CONTACT BETTY ROARK @ 268-4341) PRIOR TO INSTALLING THE SANITARY SEWER SERVICES.

APPROVED AS NOTED
BY CITY ENGINEER OF WICHITA


Sanitary Sewers_____

Storm Sewers_____

NOTE TO CONTRACTORS

Inspection and tasting for this project is to be provided by a Licenced consulting Engineering Firm under contract with the Owner/Developer. Said inspection to be in accordance with the City of Wichita standard construction engineering practices and certified by a Licenced Professional Engineer. No work shall be performed in dedicated easements or public-right-of-way by the Contractor without such inspection nor shall any work be commenced without written authorization by the City Engineer. All Construction and Materials shall comply with the City of Wichita Specifications and Standards (on file and available in the City Engineer's Office).

As Built - 4/98

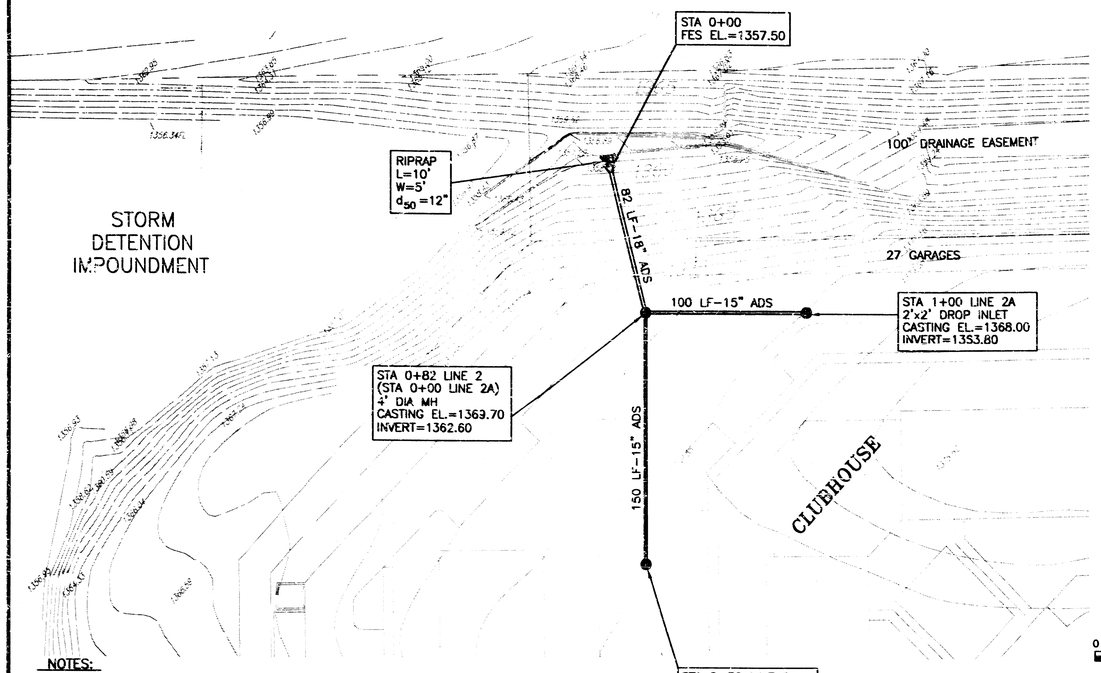


NOTES:

1. ALL INLETS AND MANHOLE STRUCTURES HAVE 3' SILT TRAPS IN THE BOTTOM OF BARREL SECTION. CONTRACTOR TO CLEAN ALL SILT TRAPS AFTER THE COMPLETION OF CONSTRUCTION, PRIOR TO ACCEPTANCE BY OWNER. ALL PIPE FLOWS ARE COMPUTED FOR NON-PRESURIZED PIPE CONDITIONS.
2. CONTRACTOR TO PLACE STRAW BALES OR STAKED SILT FENCE AROUND ALL INLETS AFTER CONSTRUCTION FOR EROSION CONTROL.

ALL ADS PIPE SHALL BE DOUBLED WALL, WITH n=0.010 AND SHALL MEET CITY OF WICHITA STANDARD SPECIFICATIONS.

LINE 2

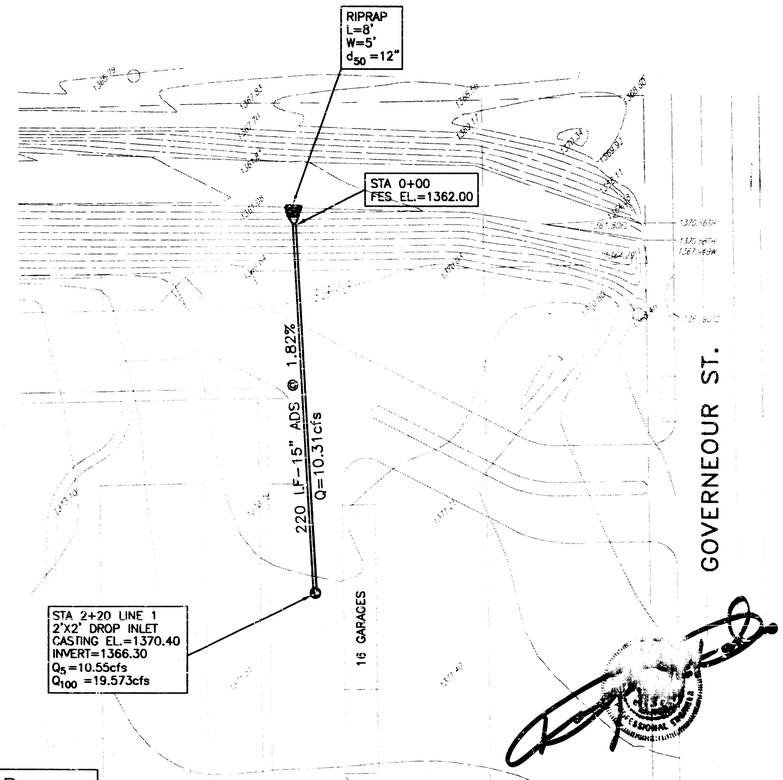


LINE 1


CONVERSION FACTOR
USGS = 1187.4 + CITY DATUM

0 40 80
SCALE 1" = 40'

AS BUILT

LOT 1, BLOCK 1
PEPPERWOOD LAKES
741 PPS (607861)

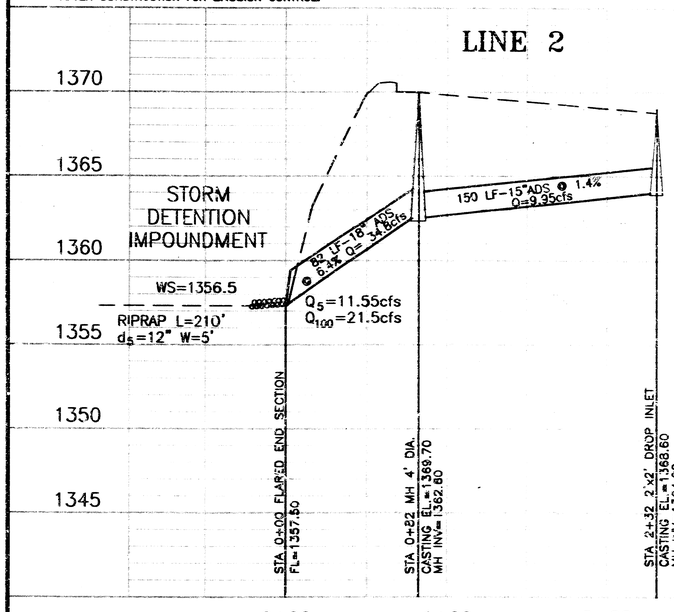

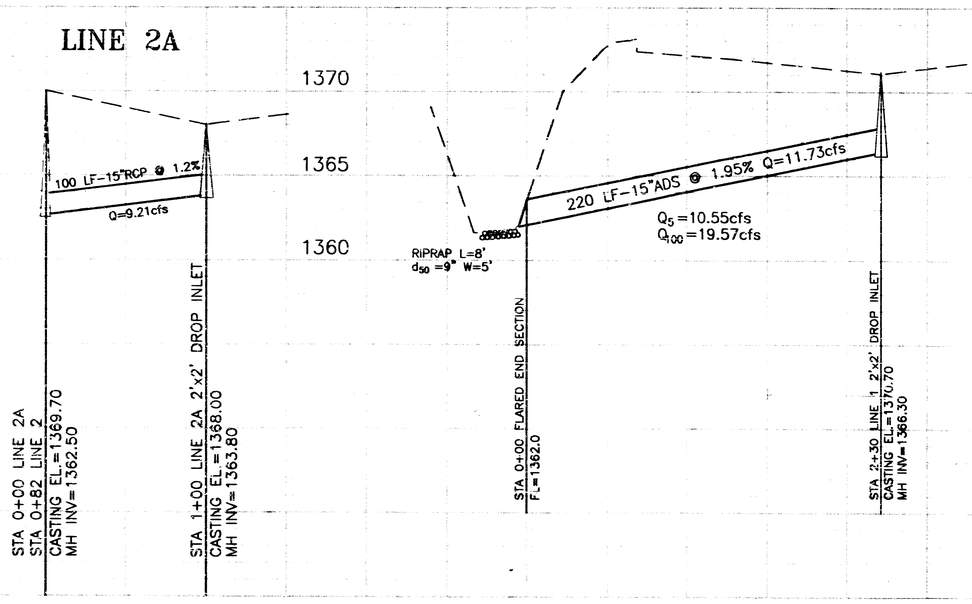


As Built - 4/98

Douglas M. Dahms P.E.
ENGINEERING CONSULTANTS
6368 Holman Ct. Arvada Col. 80004

STORM SEWER PLAN
SHEET 3

DATE:
SEPT, 1997

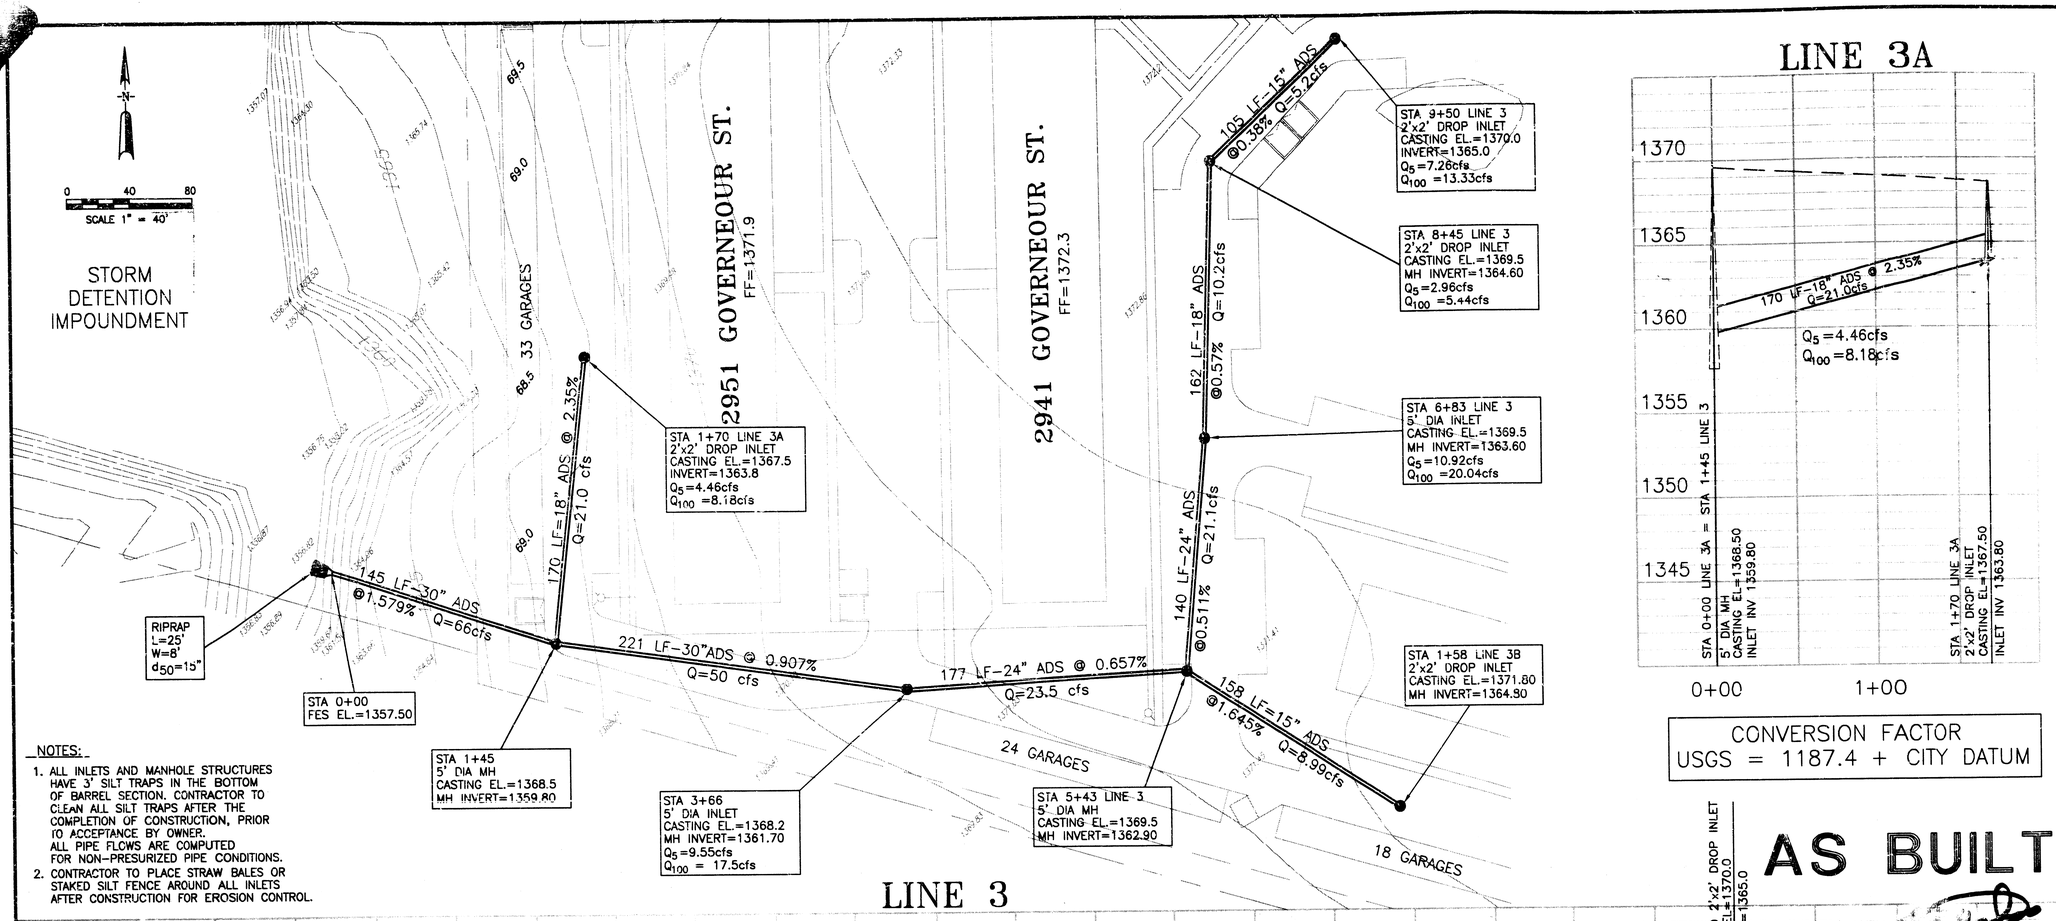


NOTES:

1. ALL INLETS AND MANHOLE STRUCTURES HAVE 3' SILT TRAPS IN THE BOTTOM OF BARREL SECTION. CONTRACTOR TO CLEAN ALL SILT TRAPS AFTER THE COMPLETION OF CONSTRUCTION, PRIOR TO ACCEPTANCE BY OWNER. ALL PIPE FLOWS ARE COMPUTED FOR NON-PRESURIZED PIPE CONDITIONS.
2. CONTRACTOR TO PLACE STRAW BALES OR STAKED SILT FENCE AROUND ALL INLETS AFTER CONSTRUCTION FOR EROSION CONTROL.

LINE 3A

CONVERSION FACTOR
USGS = 1187.4 + CITY DATUM

LINE 3

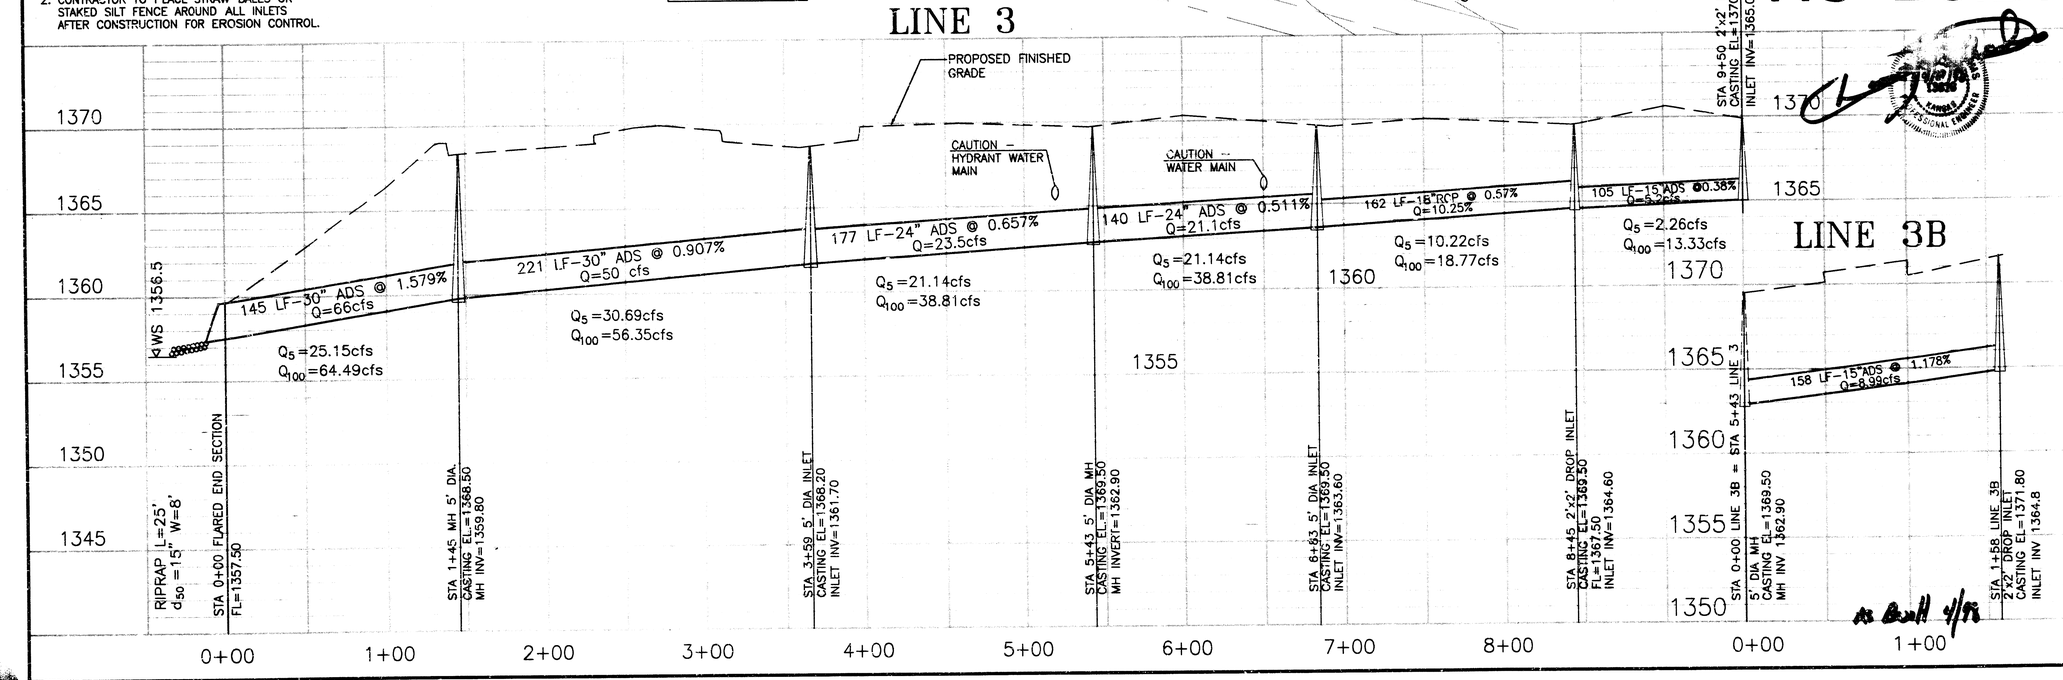

LINE 3B

AS BUILT


LOT 1, BLOCK 1
PEPPERWOOD LAKES
741 PPS (607861)

Douglas M. Dahms P.E.
ENGINEERING CONSULTANTS
6368 Holman Ct. Arvada Col. 80004

STORM SEWER PLAN
SHEET 4


DATE:
SEPT, 1997

NOTE: MANHOLE CASTINGS TO BE STANDARD CITY OF WICHITA SPECIFICATIONS, FOR SANITARY SEWER M.H.s. MANHOLE BARREL SECTION TO MEET CITY SPECIFICATION.

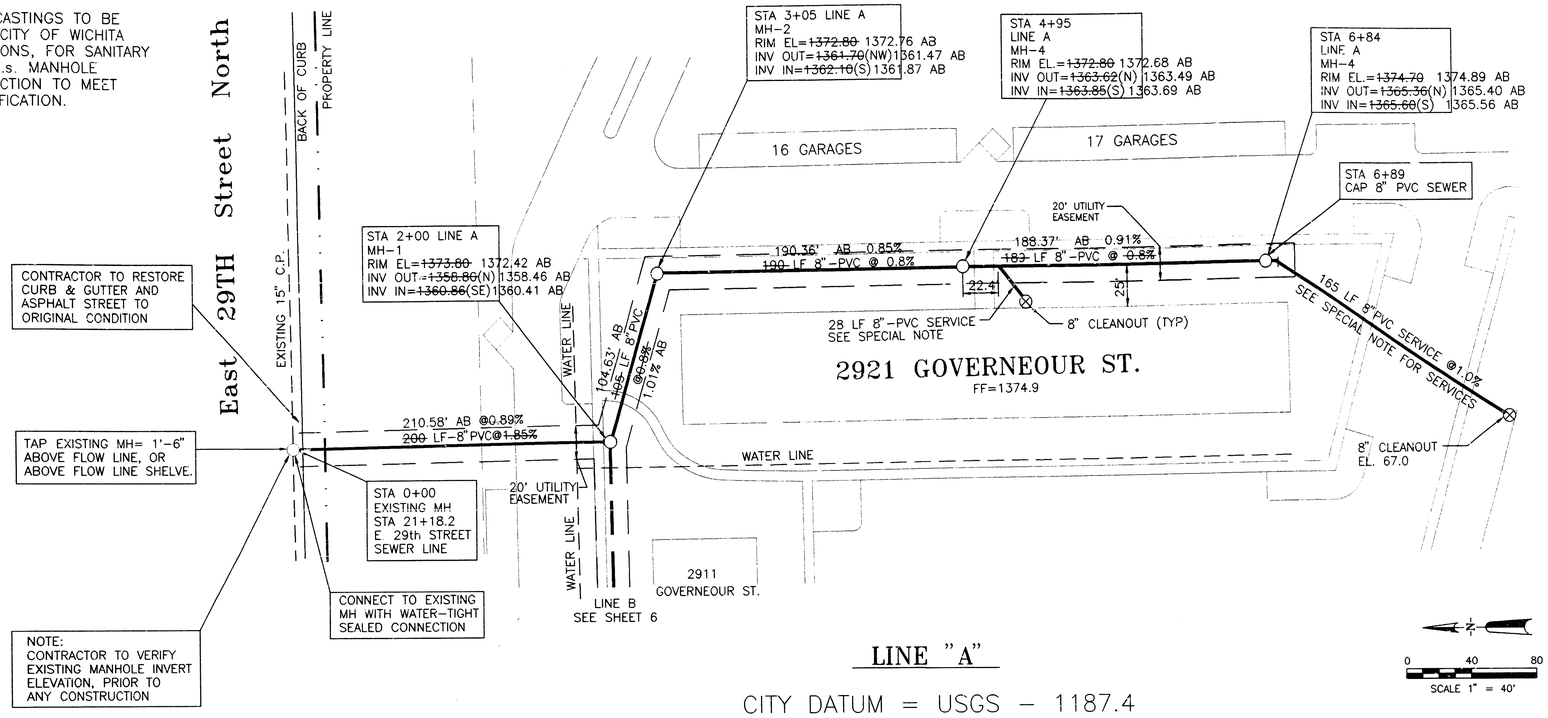

LINE "A"

CITY DATUM = USGS – 1187.4

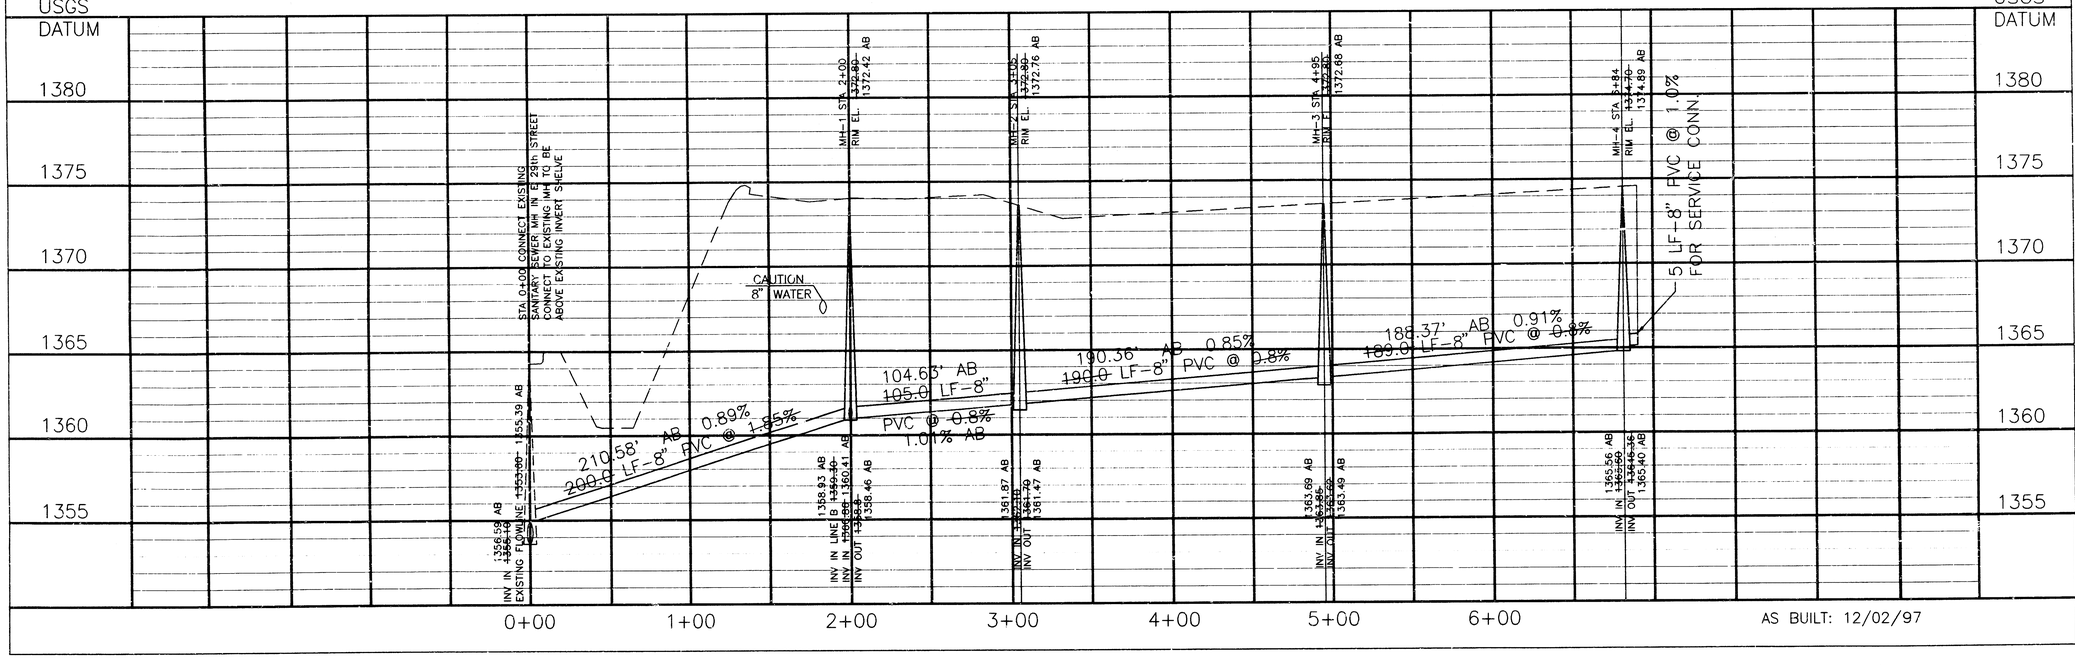

LOT 1, BLOCK 1
PEPPERWOOD LAKES
741 PPS (607861)


Douglas M. Dahms P.E.
ENGINEERING CONSULTANTS
6368 Holman Ct. Arvada Col. 80004

SANITARY SEWER PLAN

SHEET 5


DATE: AUG, 1997

I:\MAP\1997\97112\DWG10-24\SAM40-1 Tue Dec 02 12:42:27 1997

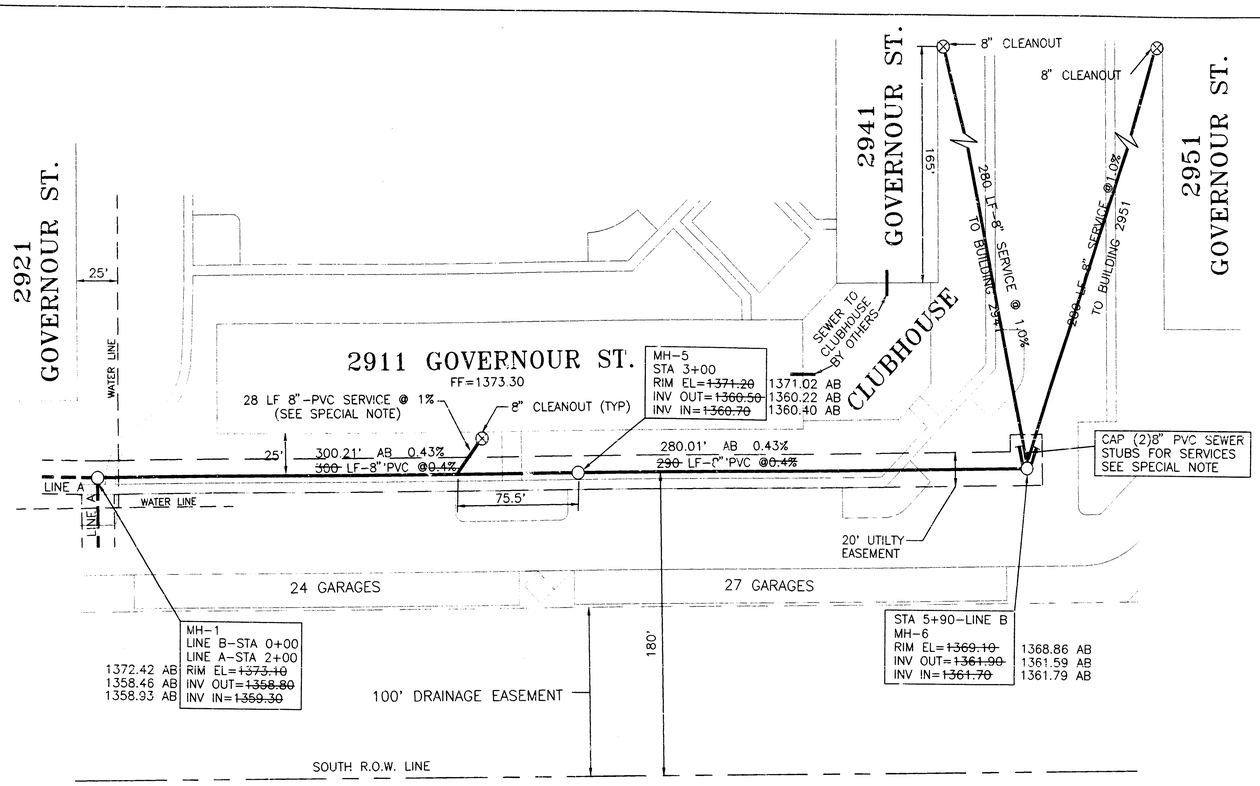

East 29TH Street North

NOTE: MANHOLE CASTINGS TO BE STANDARD CITY OF WICHITA SPECIFICATIONS, FOR SANITAR SEWER M.H.s. MANHOLE BARREL SECTION TO MEET CITY SPECIFICATION.

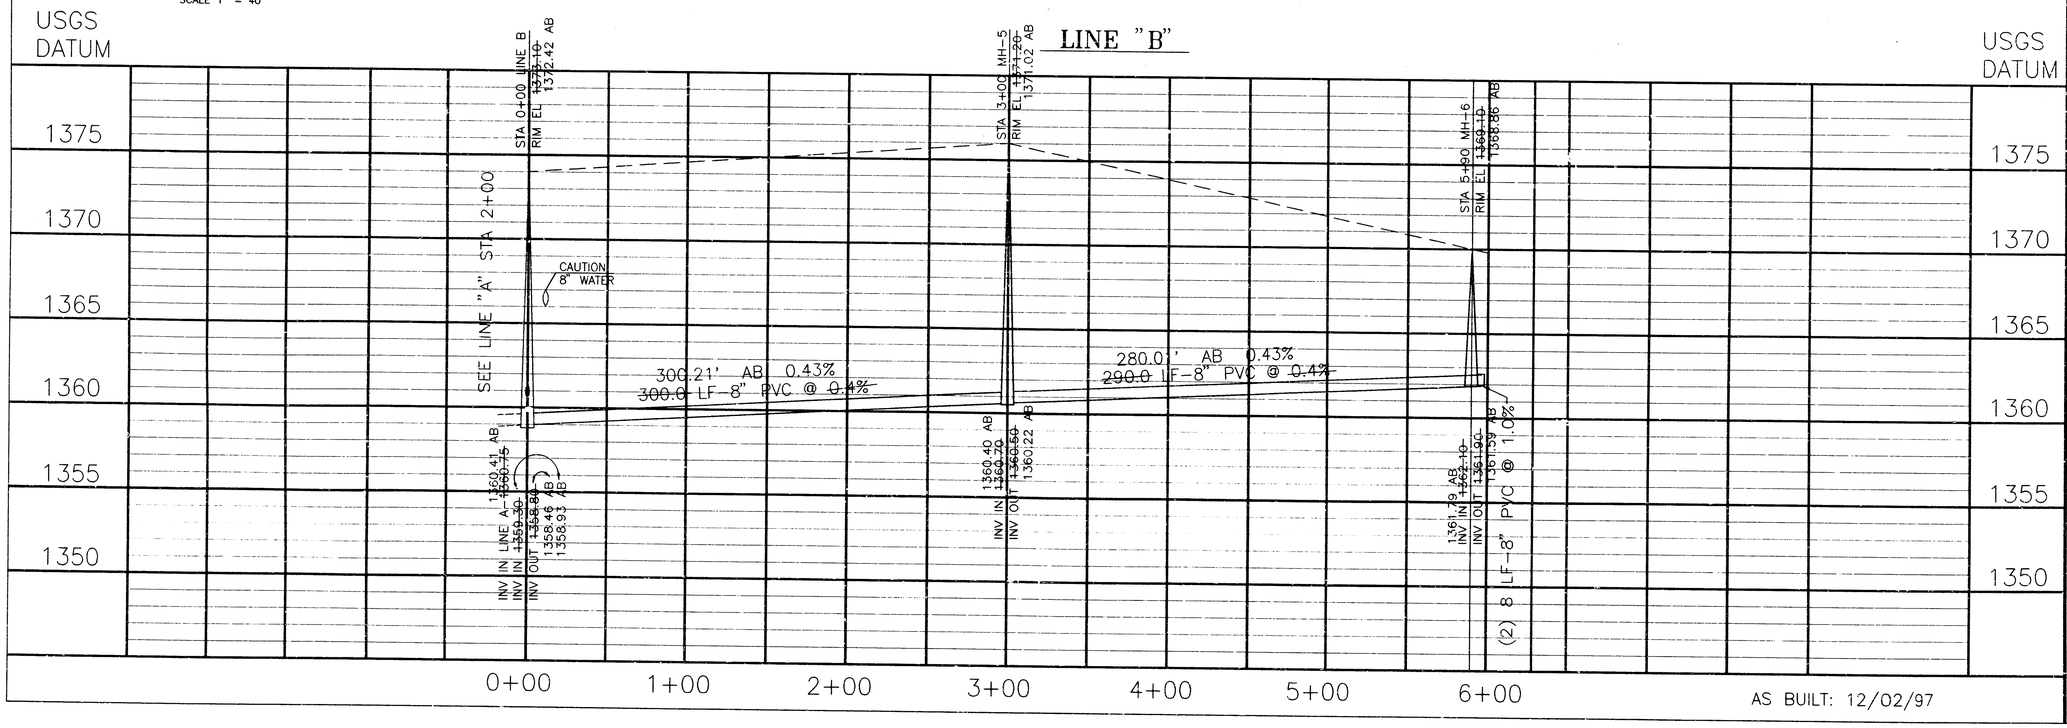

LOT 1, BLOCK 1
PEPPERWOOD LAKES
741 PPS (607861)

Douglas M. Dahms P.E.
ENGINEERING CONSULTANTS
6366 Holman Ct. Arvada Col. 80004

SANITARY SEWER PLAN

SHEET 6

DATE: SEPT, 1997

I:\MAP\1997\97112\DWG\0-2A\SAN10-2 Tue Dec 07 12:37:41 1997