

FLUME DETAIL

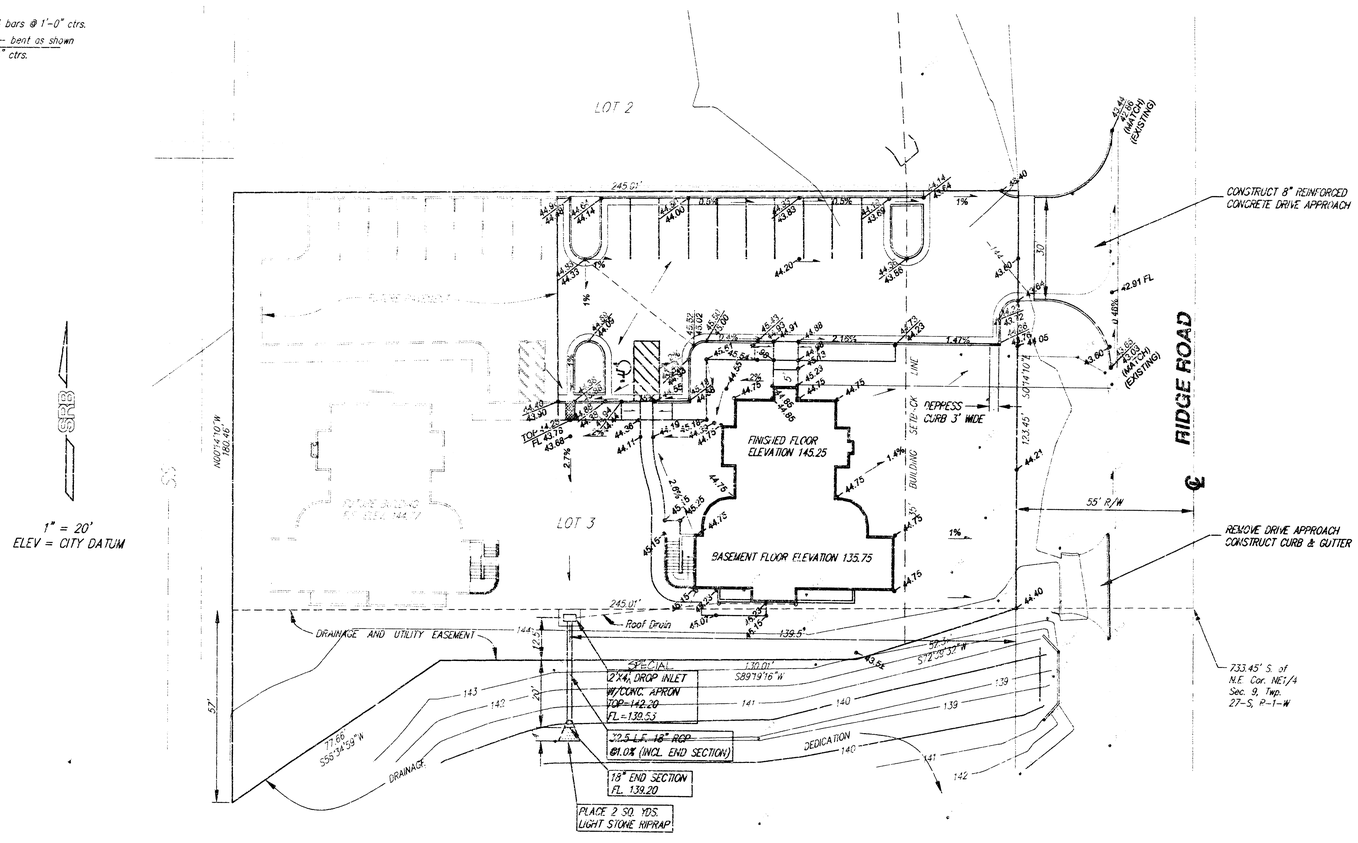

1" = 20'
ELEV = CITY DATUM

BOOKED
6-5-00
MCG
D-162

APPROVED AS NOTED
BY CITY ENGINEER OF WICHITA

Sanitary Sewers _____

Storm Sewers VRH 9/30/98

Driveway Approaches _____

Water Mains _____

Paving _____

NOTE TO CONTRACTORS

Inspection and testing for this project are to be provided by a Licensed Consulting Engineering Firm under contract with the Owner/Developer. Said inspection to be in accordance with the City of Wichita standard construction engineering practices and certified by a Licensed Professional Engineer. No work shall be performed in dedicated easements or public right-of-way by the Contractor without such inspection, nor shall any work be commenced without written authorization by the City Engineer.

BM - CITY OF WICHITA STD. DISC. 61'
E. & 66.6' N. OF INTERSECTION OF
CENTERLINES OF RIDGE RD. & 21ST
ST. N. ELEV. 142.34 (CITY DATUM)

NOTE: All storm sewer construction on this project shall conform to City of Wichita Standard Specifications. March 1998 edition.

AS-BUILT NOTE: USED ALTERNATE
PRECAST DROP INLET MFG. BY
WICHITA CONCRETE PIPE CO.
(48" I.D. W/DEETER # 2512 GRATES)

THOMAS CHARLES GUGLER
LICENSED
6621
9-25-98
KANSAS
PROFESSIONAL ENGINEER

REVISED AS BUILT 12-18-98 JCR

LOT 3, R.M.C. ADDITION
SITE GRADING AND PRIVATE STORM SEWER
WICHITA, KANSAS

SRB
924 NORTH MAIN
WICHITA KANSAS 67203
316-264-8208
FAX 264-4621
http://www.feist.com/~srb
E-mail: srb@feist.com

SAVOY, RUGGLES & BOHM, P.A.
ENGINEERING & SURVEYING

PROJECT NUMBER
Proj. Number 852 PPS (607861)

DESIGN	DRAWN	UTILITY	REVIEW	DATE	REVISED
TCR	JTS	JCR	JCR	Sept. 18, 1998	Date

DWG. FILE 1125E
DATE 2000 1125E
SHEET 1 OF 2

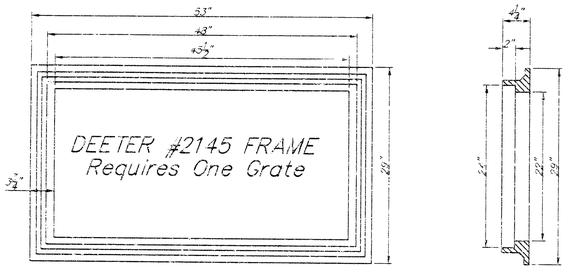

48" x 24" Frame Detail

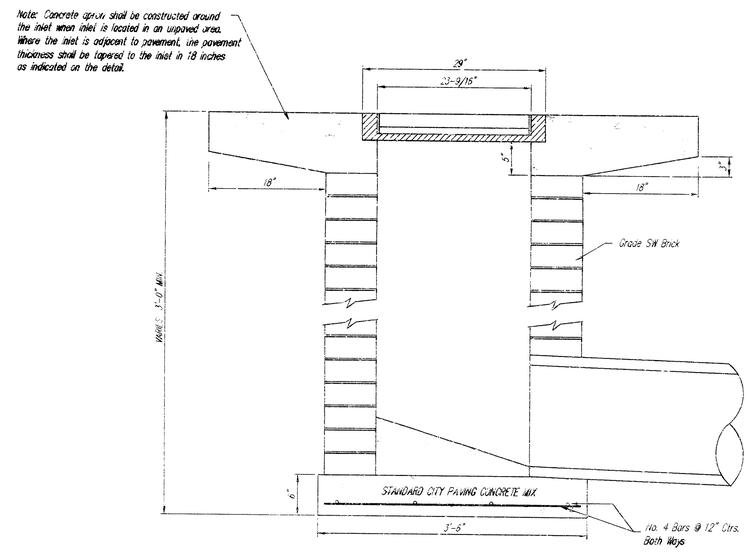

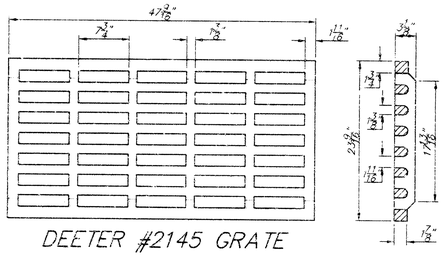

48" x 24" Grate Detail

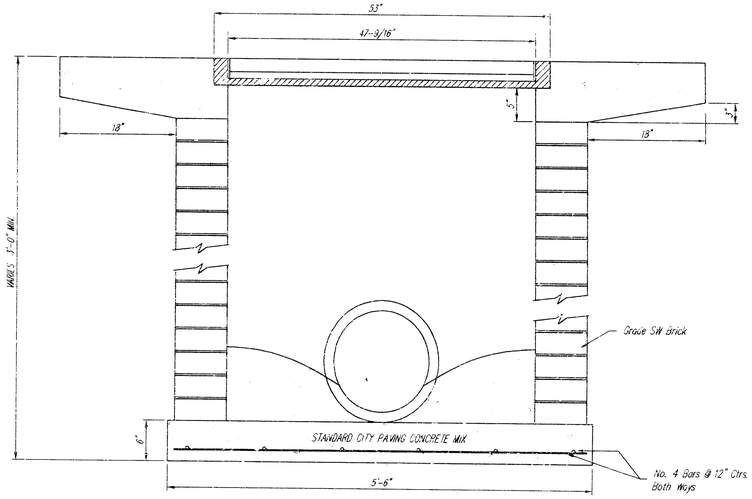

AS-BUILT NOTE: USED ALTERNATE PRECAST DROP INLET MFG. BY WICHITA CONCRETE PIPE CO. (48" I.D.)

LOT 3, R.M.C. ADDITION
2' x 4' DROP INLET DETAILS
WICHITA, KANSAS

SRB
924 NORTH MAIN
WICHITA, KANSAS 67203
http://www.feist.com/~srb
316-264-8008
FAX 264-4621
E-mail: srb@feist.com
SAVOY, RUGGLES & BOHM, P. A.
ENGINEERING & SURVEYING

PROJECT NUMBER: 852 PPS

DESIGN	DRAWN	UTILITY	REVISED	DATE	REVISED
JDS	JTS		JCR	Sept. 18, 1998	

SHEET: Drop Inlet Details
SHEET NO. 4 of 4

01 90 10 41