
1. ALL MANHOLES MEET CURRENT ASTM DATA SPECIFICATIONS.


2. ALL RE-INFORCING IS GRADE 60.

3. JOINTS BETWEEN MANHOLE SECTIONS TO BE SEALED WITH TWO RAMPS OF EXTRUDED BUTYL RUBBER JOINT MAST O MEETING CITY OF WICHITA TYPE D MANHOLE SPECIFICATIONS

CAST IRON, NEENAH NO. R-3067 OR DEESER FOUNDRY CO. NO. 32 OR EQUIVALENT

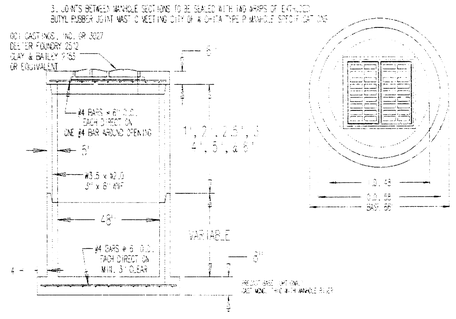

PRECAST DROP INLET DETAIL

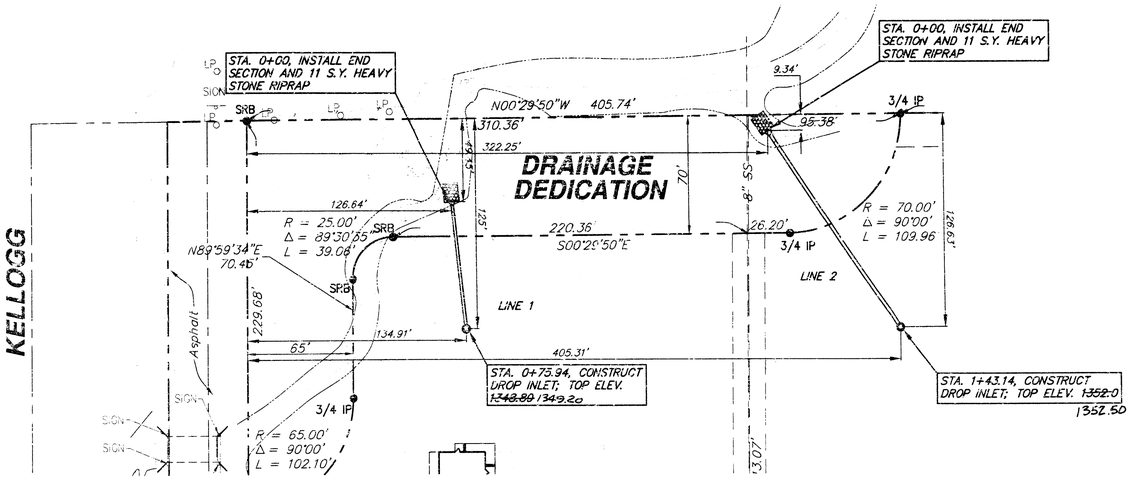

SRB

SCALE
1" = 40' Horiz. (Plan)
1" = 5' Vert. (Profile)

APPROVED AS NOTED
BY CITY ENGINEER OF WICHITA

Sanitary Sewers _____

Storm Sewers VRH 9/16/99

Driveway Approaches _____


Water Mains _____


Paving _____


NOTE TO CONTRACTORS

Inspection and testing for this project are to be provided by a Licensed Consulting Engineering Firm under contract with the Owner/Developer. Said Inspection to be in accordance with the City of Wichita standard construction engineering practices and certified by a Licensed Professional Engineer. No work shall be performed in dedicated easements or public right-of-way by the Contractor without such inspection, nor shall any work be commenced without written authorization by the City Engineer.

VICINITY MAP

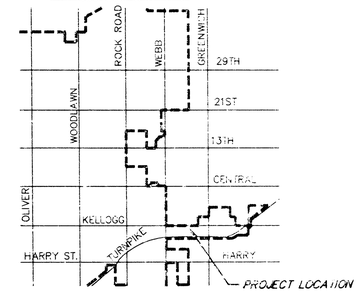

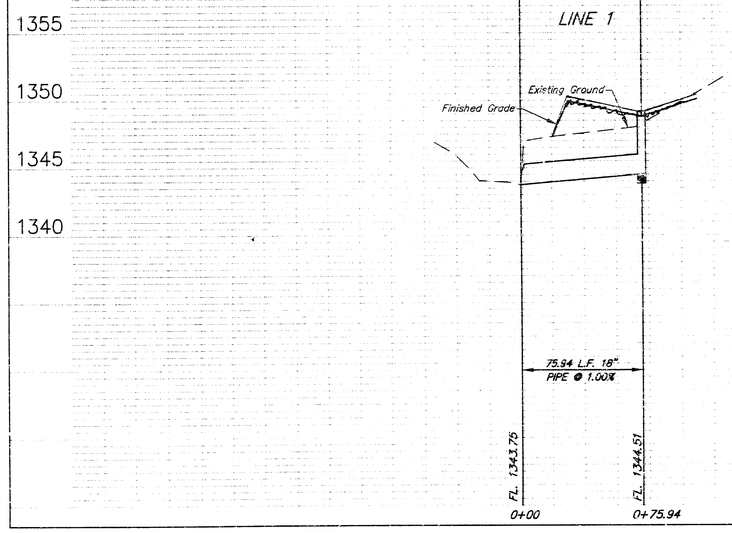

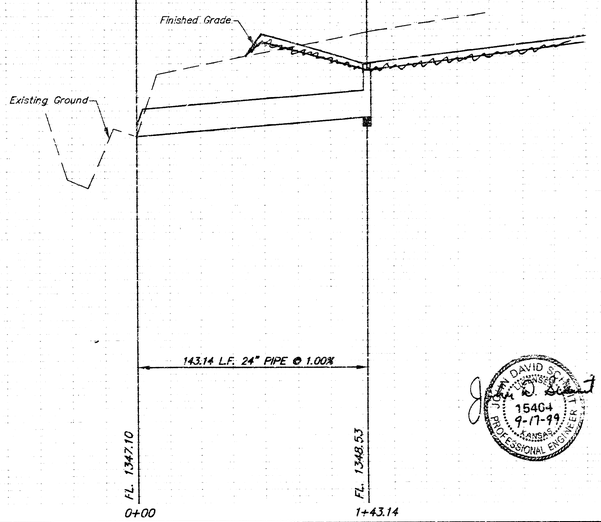

BOOKED
6-5-00
MLC
D-462

REV. 9-16-99 TOP OF INLET JCR

As-Builts
11/22/99
M. Stump

LOTS 1-3, BLK. 3, WIEDEMANN BUS. PARK
STORM SEWER PROFILES
WICHITA, KANSAS

SRB 924 NORTH MAIN WICHITA, KANSAS 67203 http://www.feist.com/~srb
316-264-8008 FAX 264-4621 E-Mail: srb@feist.com
SAVOY, RUGGLES & BOHM, P.A.
ENGINEERING & SURVEYING

PROJECT NUMBER 936-PPS (607861)

DESIGN	DRAWN	UTILITY	REVIEW	DATE	REVISED
TCR	JTS	-		Sept. 3, 1999	9-16-99

JOHN DAVID STEVENS 15404 9-17-99 KANSAS PROFESSIONAL ENGINEER

Sheet No. 1 of 1 Sheets