STORM WATER SEWER IMPROVEMENTS TO SERVE
LOT 4, J.W. RUSSELL 2ND ADDITION
MILLINEUM CONCEPTS

PROJECT NUMBER
1199 PPS (607861)
CITY OF WICHITA, KANSAS
MICHAEL LINDEBAK, P.E., CITY ENGINEER

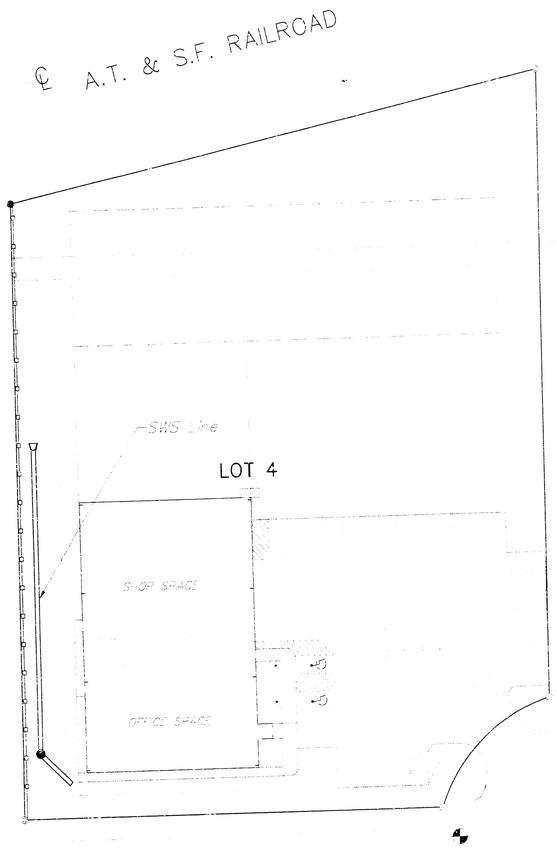

MONROE CIRCLE

TYLER ROAD

INDEX

BENCHMARK

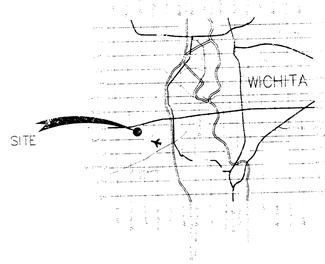

LOCATION MAP

BOOKED 5-30-02 MCG D-416

AS-BUILT
Date: 4/15/02
Signed: [signature]

APPROVED AS NOTED BY CITY ENGINEER OF WICHITA

STORM SEWERS VRH 2/5/02

[illegible]

1/29/02

AUSTIN Inc.
ENGINEERING SERVICES

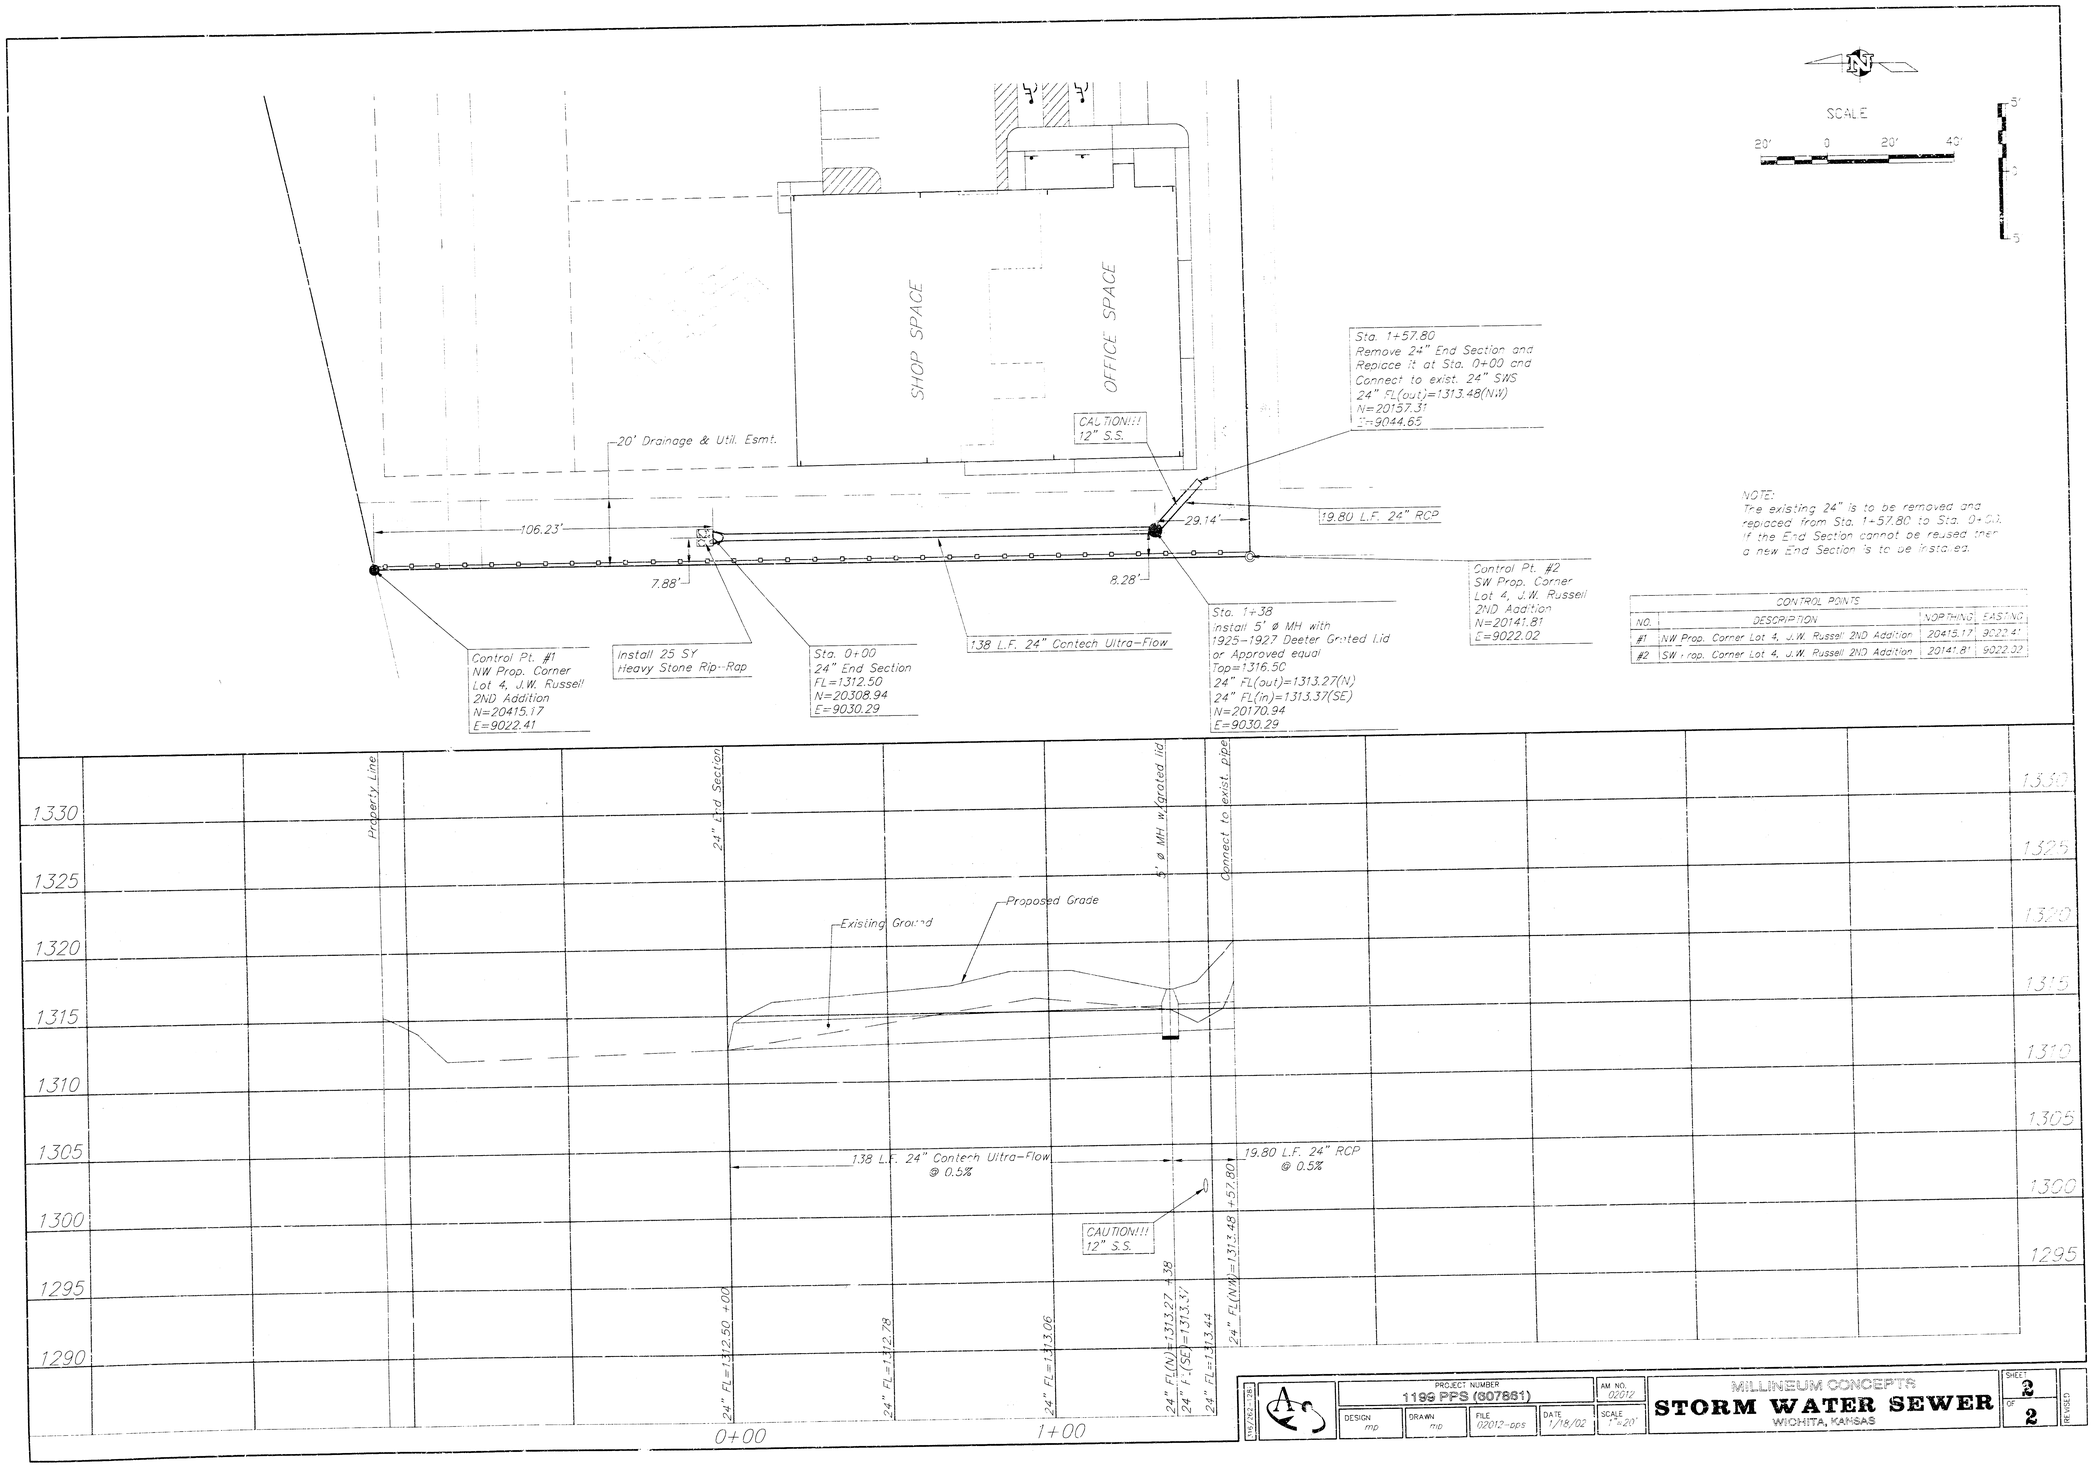

NOTE:
The existing 24" is to be removed and replaced from Sta. 1+57.80 to Sta. 0+00. If the End Section cannot be reused then a new End Section is to be installed.

CONTROL POINTS

NO.	DESCRIPTION	NORTHING	EASTING
#1	NW Prop. Corner Lot 4, J.W. Russell 2ND Addition	20415.17	9022.41
#2	SW Prop. Corner Lot 4, J.W. Russell 2ND Addition	20141.81	9022.02

PROJECT NUMBER 1199 PPS (607861)				AM NO. 02012	MILLINEUM CONCEPTS STORM WATER SEWER WICHITA, KANSAS	SHEET 2 OF 2
DESIGN mp	DRAWN mp	FILE 02012-pps	DATE 1/18/02	SCALE 1"=20'		REVISED