




PLAN

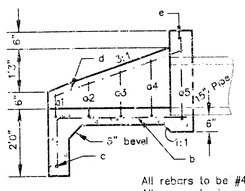

All rebars to be #4.
All exposed edges to have 1/2" bevel

SECTION

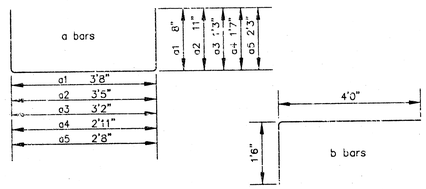

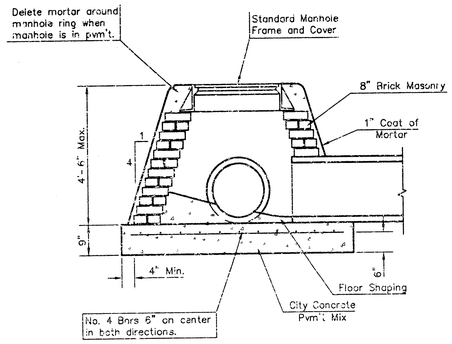


SPECIAL SHALLOW TYPE "A" MANHOLE


BAR	NUMBER	LENGTH	SHAPE	WEIGHT
a1	1	5'0"		3.34
a2	1	5'3"		3.51
a3	1	5'8"		3.79
a4	1	6'1"		4.06
a5	1	7'2"		4.79
b	5	5'6"		18.37
c	1	4'0"		2.67
d	2	4'0"		5.34
e	1	3'2"		2.12
Total Rebar, lbs				47.99
Concrete, C.Y.				0.91

All rebars to be #4.

HEADWALL FOR 15" PIPE

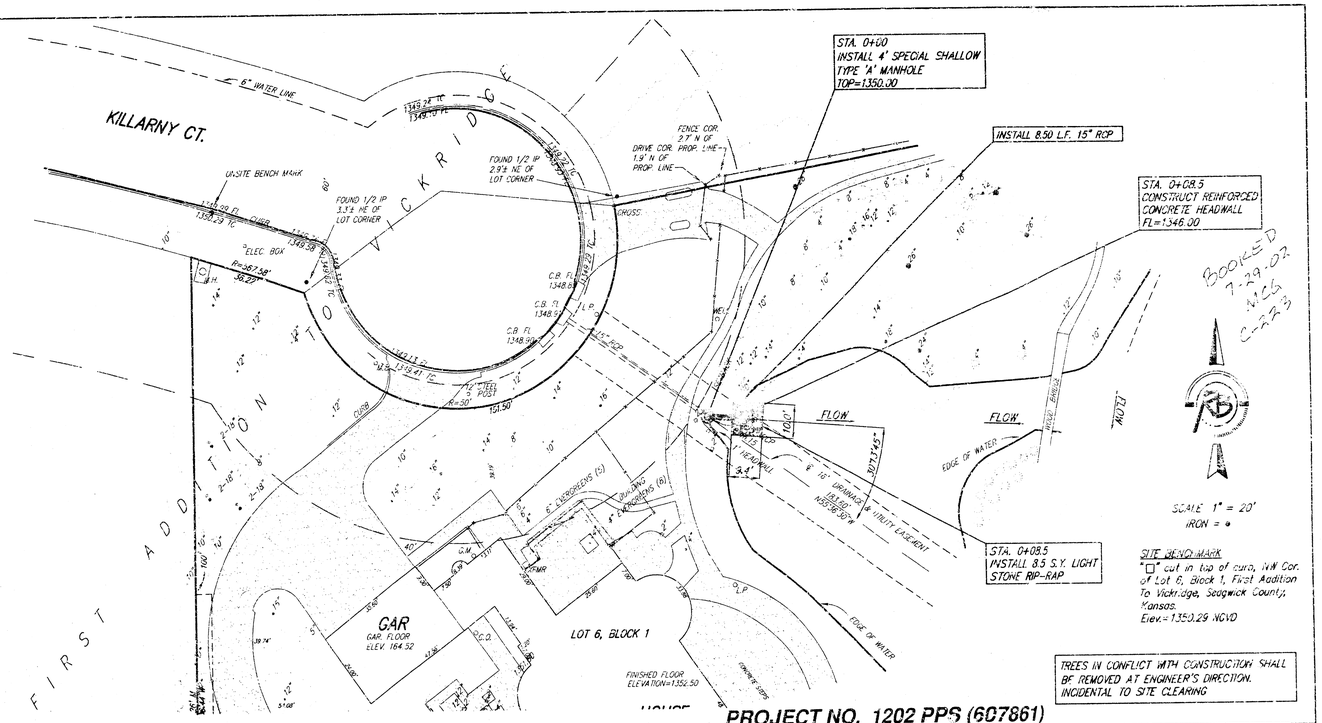

PROJECT NO. 1202 PPS (607861)

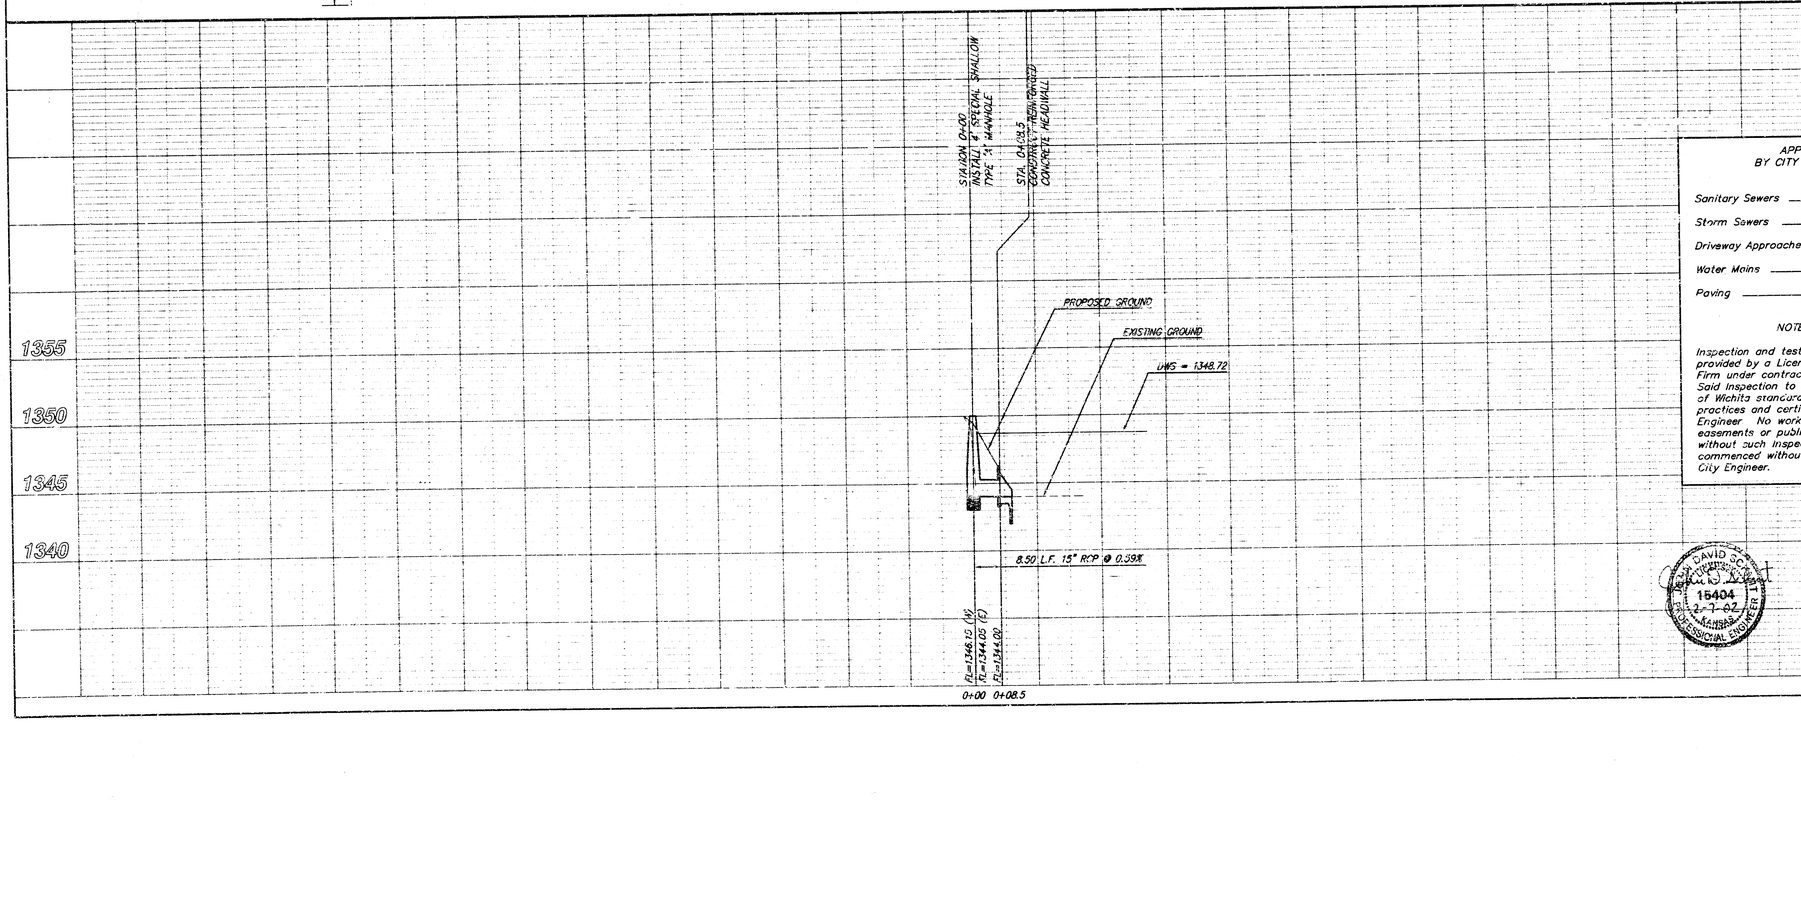

APPROVED AS NOTED
BY CITY ENGINEER OF WICHITA

Sanitary Sewers _____
Storm Sewers VRH 2/7/02
Driveway Approaches _____
Water Mains _____
Paving _____

NOTE TO CONTRACTORS

Inspection and testing for this project are to be provided by a Licensed Consulting Engineering Firm under contract with the Owner/Developer. Said inspection to be in accordance with the City of Wichita standard construction engineering practices and certified by a Licensed Professional Engineer. No work shall be performed in dedicated easements or public right-of-way by the Contractor without such inspection, nor shall any work be commenced without written authorization by the City Engineer.

Inspector: Tim Kelly Ruggles & Bohm, P.A.
Engineer: John Schmitt, P.E., Ruggles & Bohm, P.A.
Contractor: Mike Gore Construction
Built per plans
Date of construction: 2-22-02
As built 5-29-02 JDS

DAVID L. SCHMITT 15404 2-7-02 KANSAS PROFESSIONAL ENGINEER

Ruggles & Bohm, P.A.
Engineering, Surveying, Land Planning
824 North Main
Wichita, Kansas 67203
www.rbkansas.com
(316) 264-8000
(316) 264-4621 fax
E-mail: info@rbkansas.com

DESIGN JDS DRAWN JDS DATE 1-21-02 REVISED

PROJECT NUMBER 1202PPS (607861) DRAWING NO. FILE 21130-Approp

SPEC JOB 21130 SHEET 1 OF 1

LOTS 5 & 6, FIRST ADD. TO VICKRIDGE
SWS EXTENSION
WICHITA, KANSAS

80 10 TT 81