FLOOD DETENTION RESERVOIR NO. 23

IN RESERVE "C" BRIARWOOD ESTATES


CITY OF WICHITA, KANSAS

PROJECT NO. 468-82005

M.E. LINDEBAK CITY ENGINEER

INDEX NO. 750067

PROJECT LOCATION

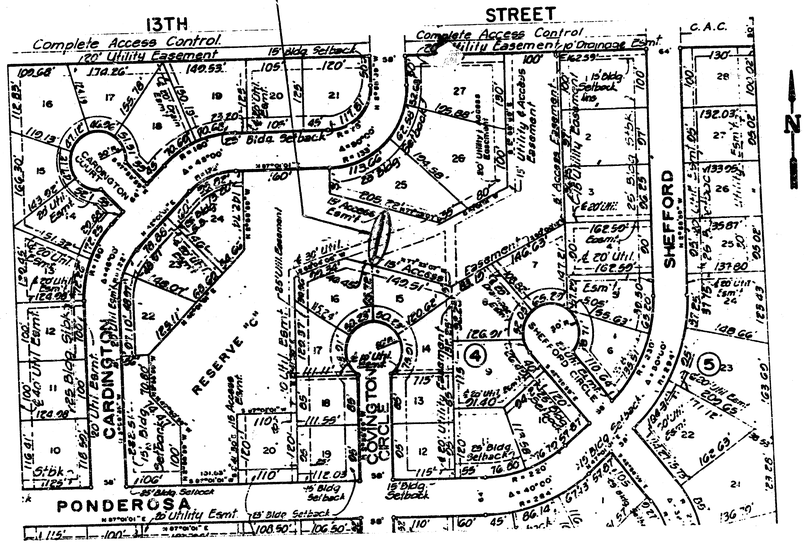

GENERAL NOTES

1. ~~THE BID ITEM LUMP SUM REINFORCED CONCRETE FLOOD DETENTION RESERVIOR CONTROL STRUCTURE AND SPILLWAY SHALL INCLUDE THE FOLLOWING ITEMS: 86 L.F. REINF CONC. WEIR RIP-RAP AND SPILLWAY CONSTRUCTION, INCLUDING EARTHWORK COMPACTION AND AREA GRADING. ALL GRASSED AREAS DISTURBED BY THE CONSTRUCTION OF THE IMPROVEMENTS UNDER THIS CONTRACT SHALL BE REPLANTED WITH REBEL II FESCUE GRASS SEED AT AN APPLICATION RATE OF 10 lbs / 1000 S.F. FERTILIZER SHALL BE 16-20-6 APPLIED AT A RATE OF 10 lbs / 1000 S.F.~~

2. BORROW EXCAVATION SHALL BE TAKEN FROM THE UP STREAM LAKE AREA AND CONFORM TO GENERAL EXIST'G OUTLINE. ALL BORROW EXCAVATION AND RIP-RAP MATERIAL SHALL BE OBTAINED ON SITE. ANY SURPLUS MATERIAL SHALL BE PLACED ON-SITE, AND GRADED AND SEEDED.
SURPLUS RIP-RAP MATERIAL SHALL BE USED FOR CHANNEL STABILIZATION DOWNSTREAM FROM THE PROPOSED STRUCTURE OR BURIED AND COVERED AS APPROVED BY THE FIELD ENGINEER.

3. APPROX. 20. CU.YDS CONCRETE IN PLACE SHALL BE STANDARD PAVING MIX.


INDEX TO DRAWINGS

1 COVER SHEET
2 SITE PLAN


REVISED 1-5-90
REVISED SEPT. 1990


(1)

FILMED FROM THE BEST AVAILABLE COPY

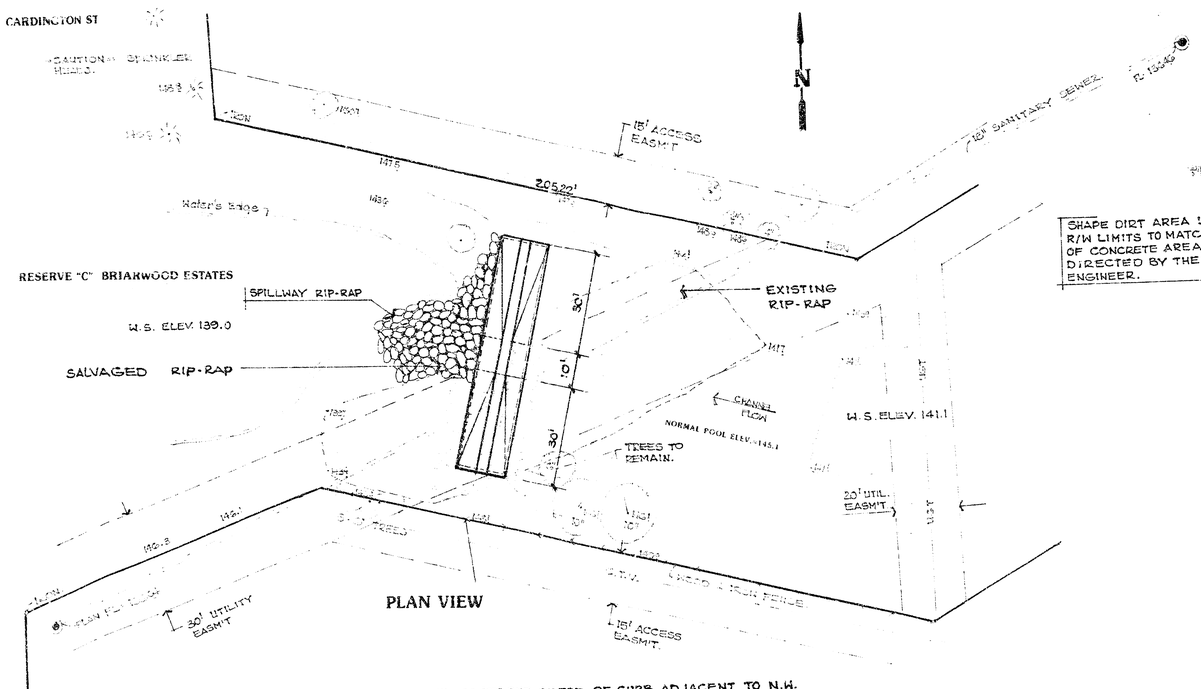


B.M. 150.80 "□" CUT ON TOP OF CURB ADJACENT TO N.W. COR. LOT 25, BLOCK 4, BRIARWOOD ESTATES.

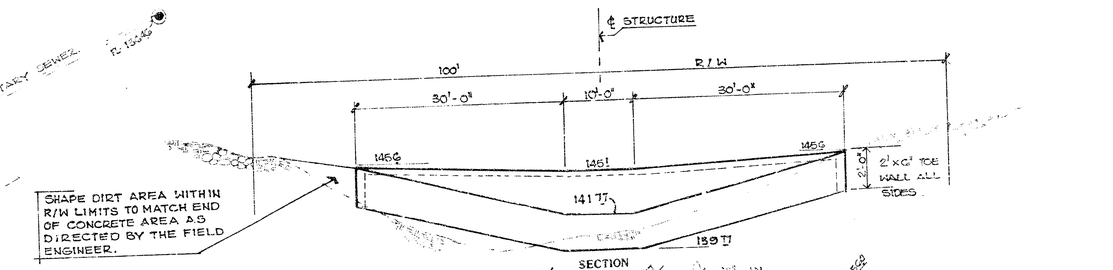

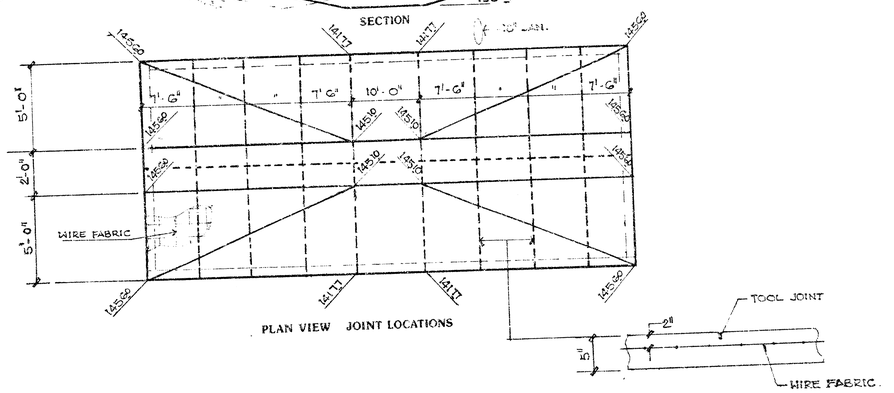

PROFILE SCALE 1"=2' HORZ. 1"=2' 1"=2' VERT.

INDEX NO. 750067

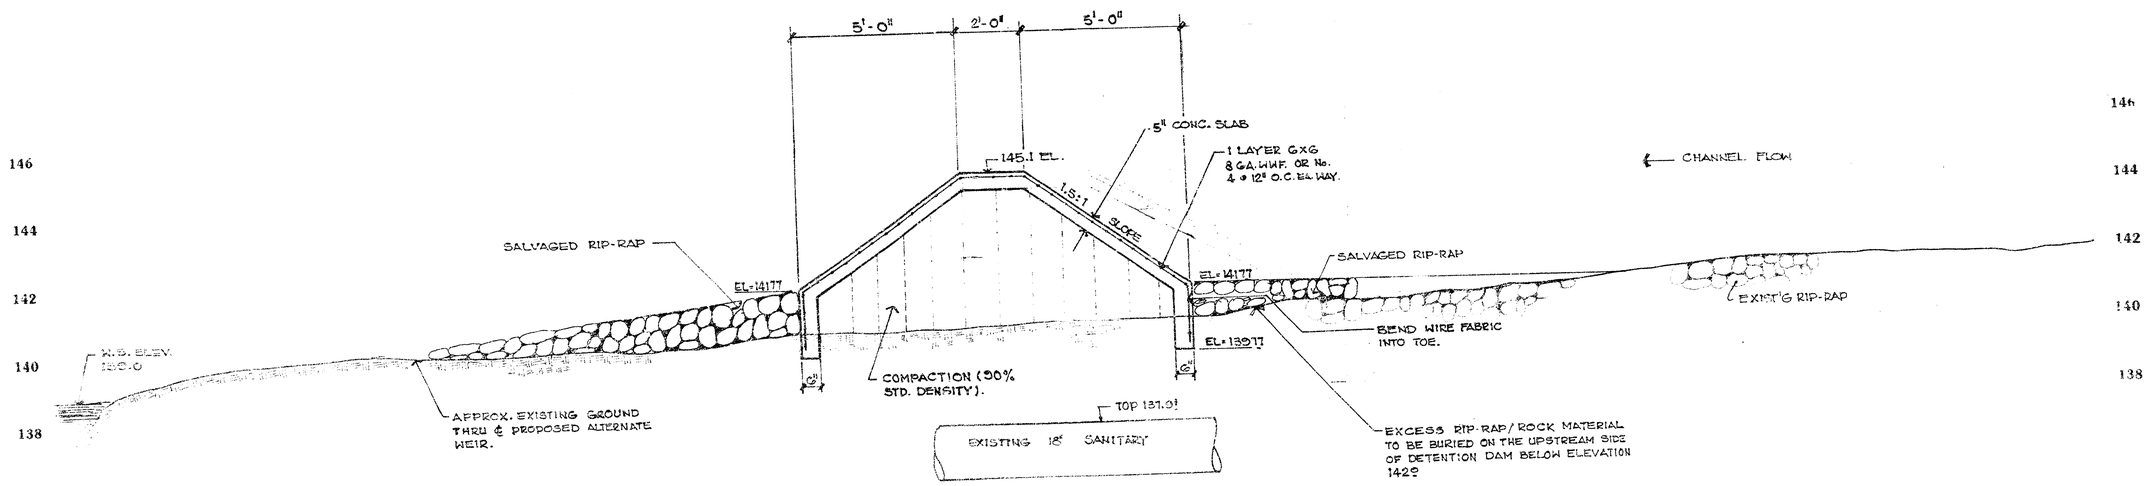

PROJECT DESCRIPTION

FLOOD DETENTION RESERVOIR NO. 23 (6)

PROJECT NUMBER

468-82005

FILMED FROM THE BEST AVAILABLE COPY