
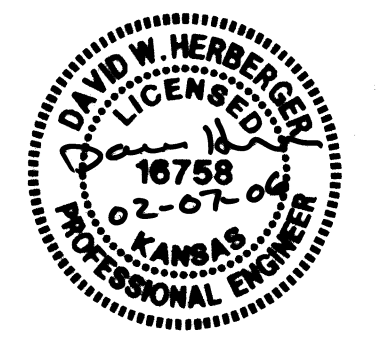
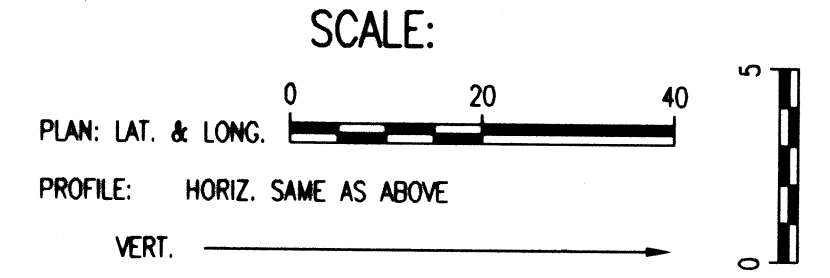


PLAN	CHECKED	DATE
	CHECKED	


PROFILE	CHECKED	DATE
	CHECKED	

Saved 02-04-2006 7:05:32 AM by JDS
 Plot Scale 1:20 02-04-2006 7:33:49 AM by JDS
 C:\2002\02176\001\000\Drawings\020505_MCP202

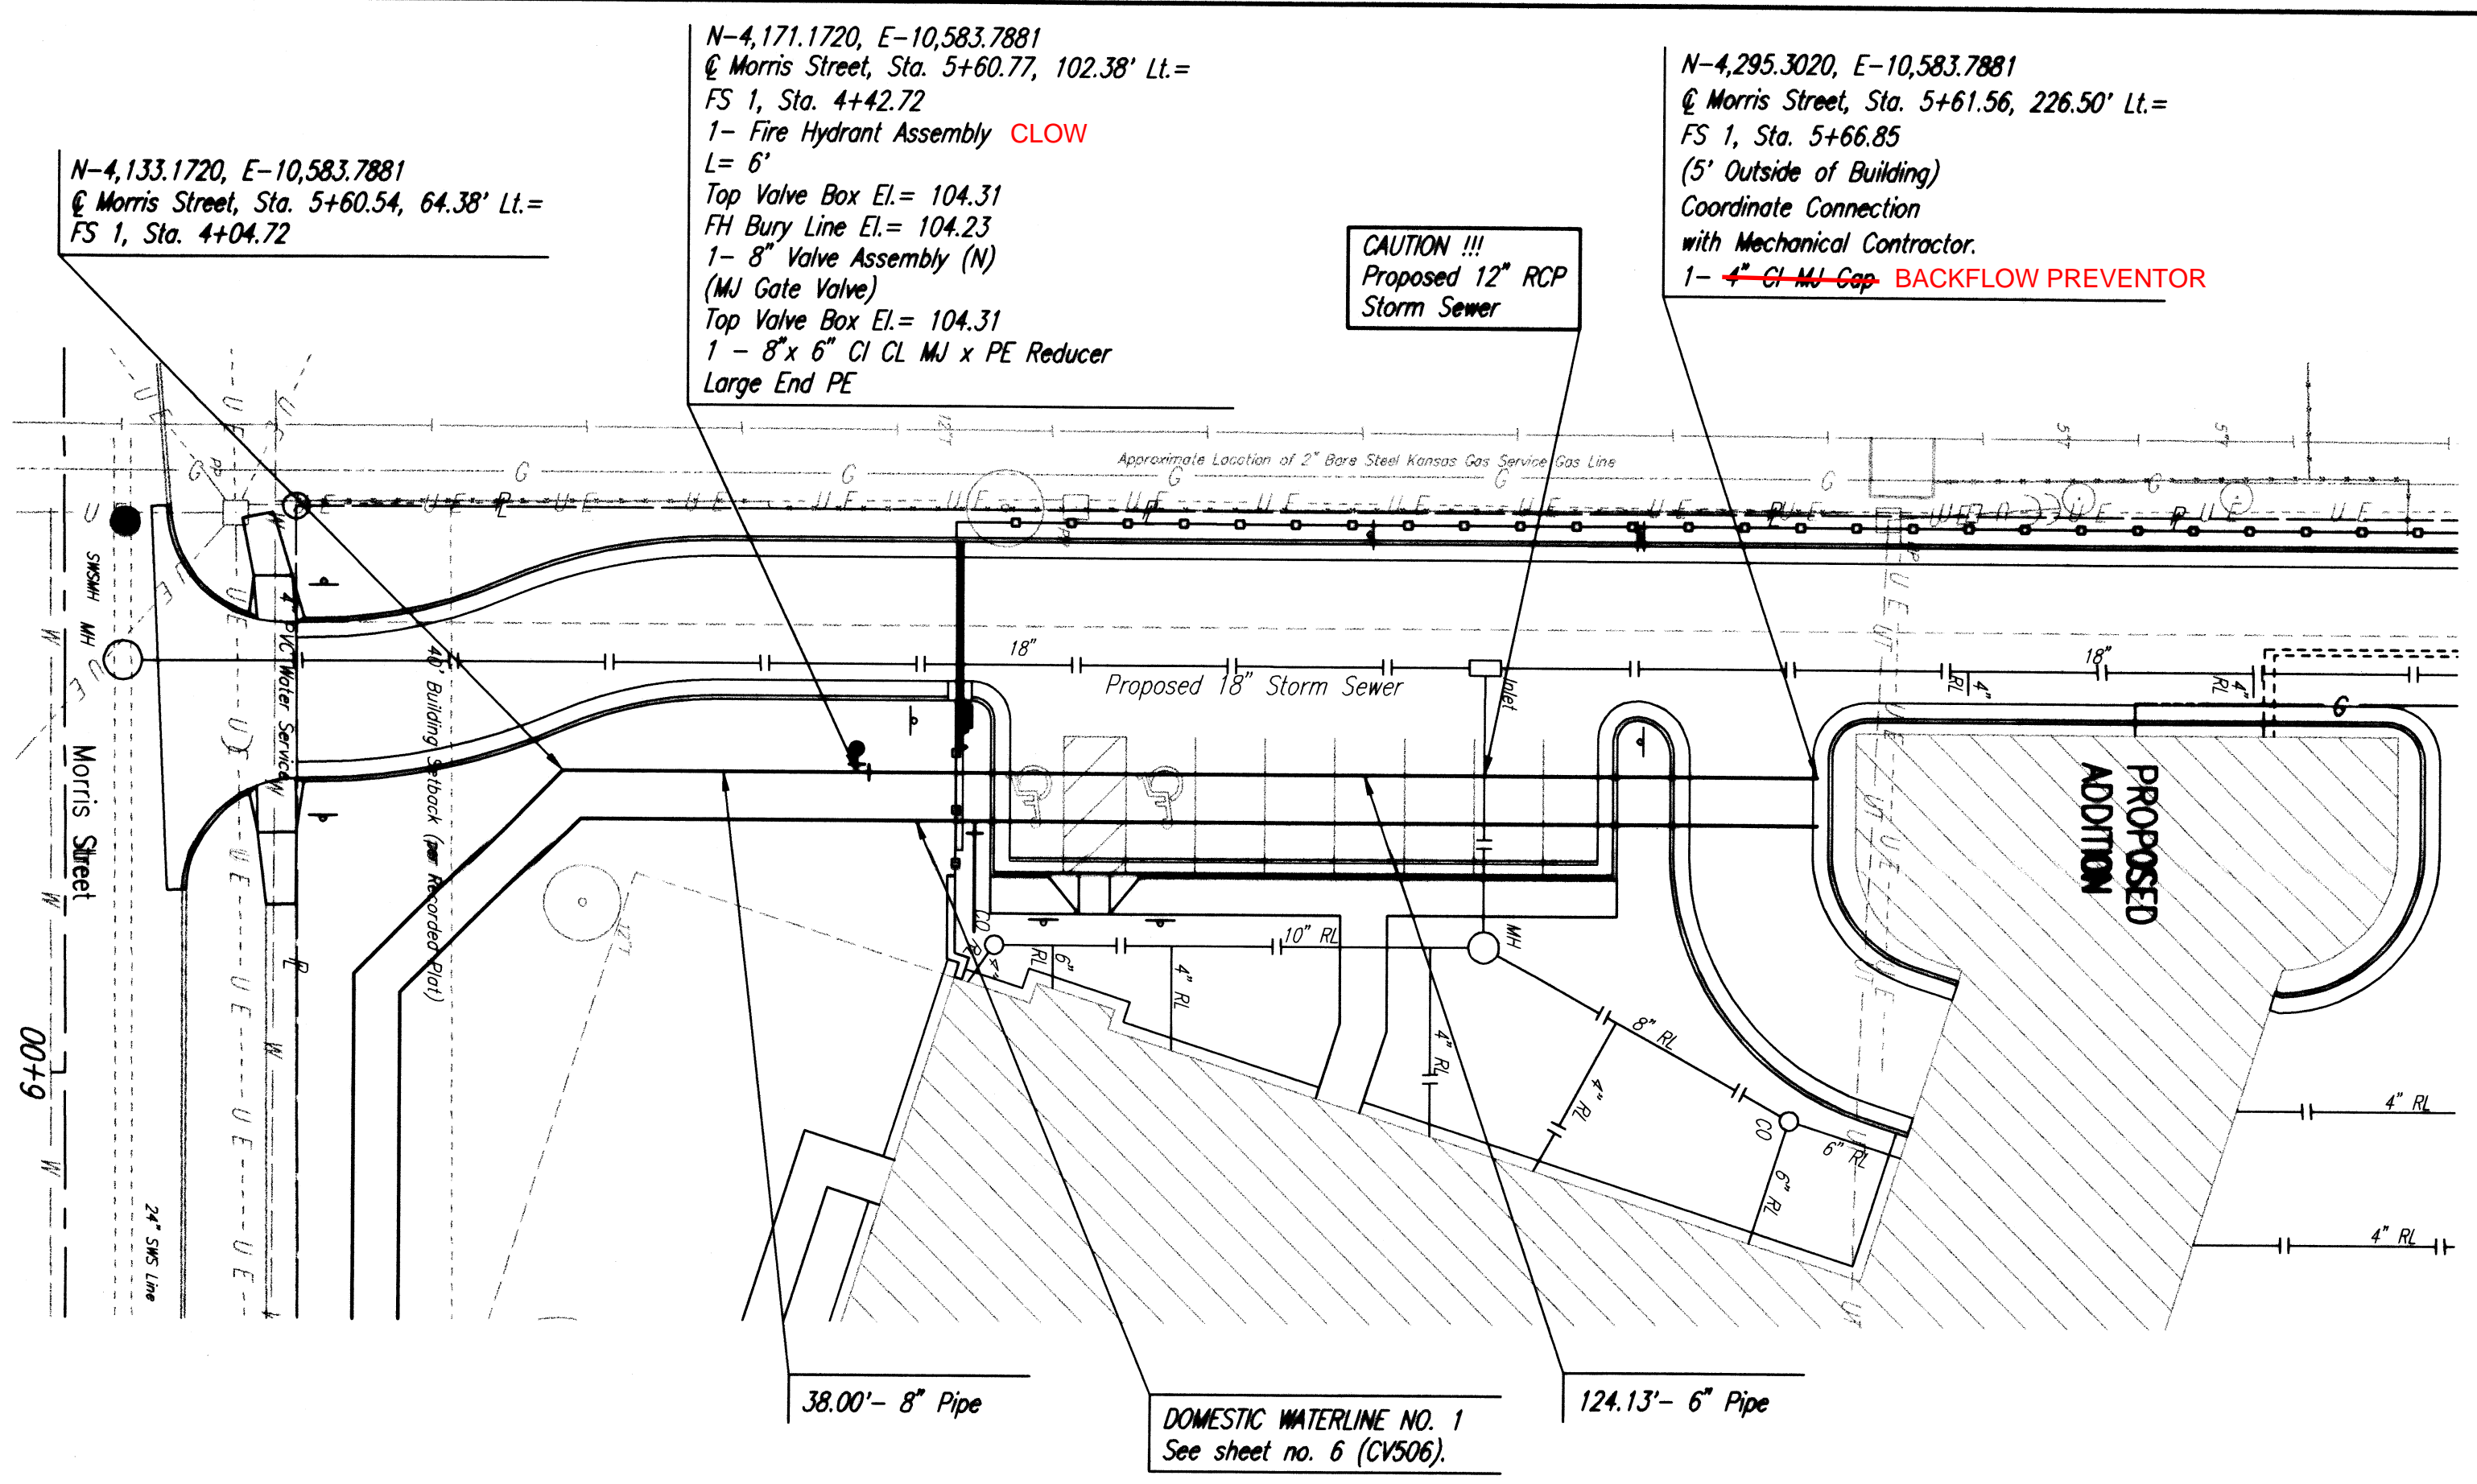

Unless noted otherwise, elevations shown are top of pipe

FIRE SERVICE LINE NO. 1

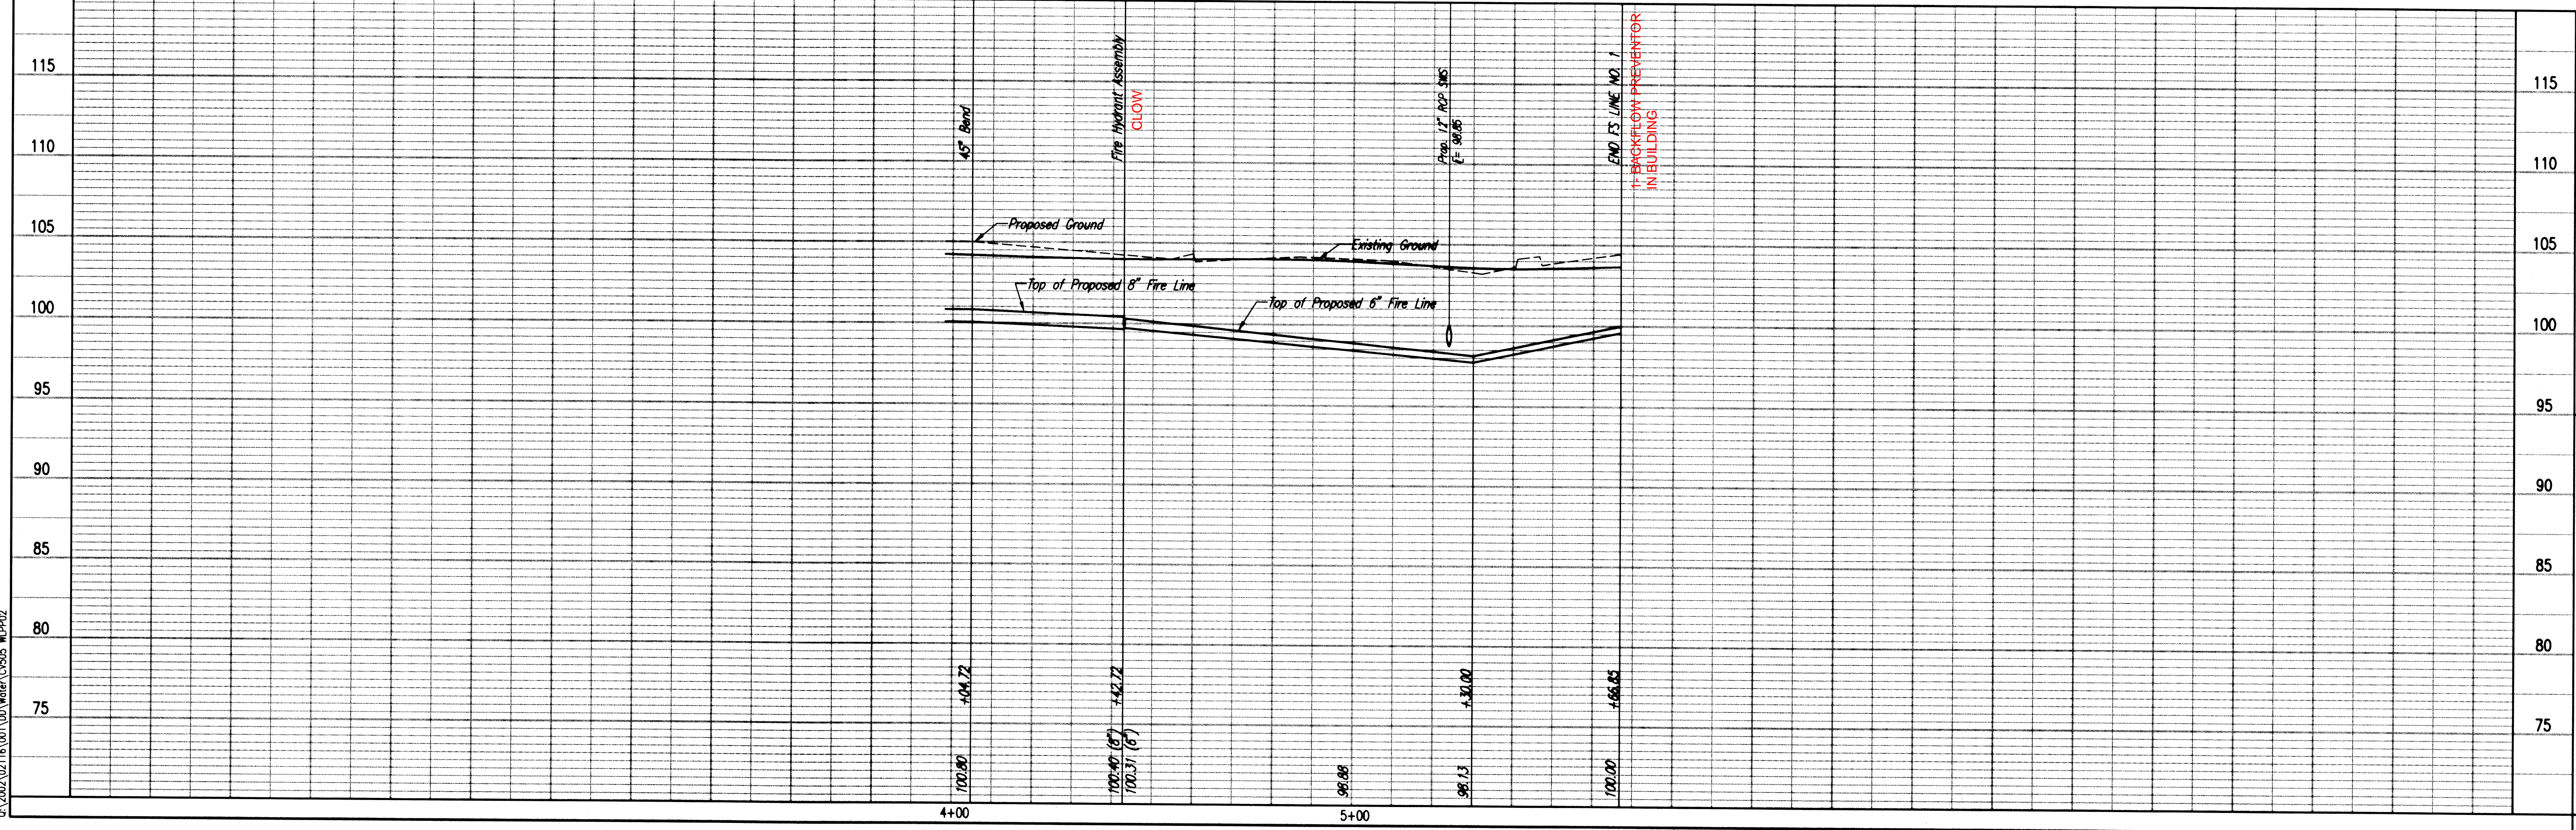

Professional Engineering Consultants, P.A.
 303 S. TOPICK WICHITA, KANSAS 67202
 316-262-2691 • FAX 316-262-8665

City of Wichita, Kansas
 James L. Armour, P.E. - City Engineer
 Sedwick County Juvenile Court Complex

FIRE SERVICE LINE NO. 1 & 2

City of Wichita Private Project No. 1201, PPM (607883)

Designed By: DMH
 Drawn By: DCM

Job No. 35-02116-001-259
 Date August 2003

Sheet 5 of 10