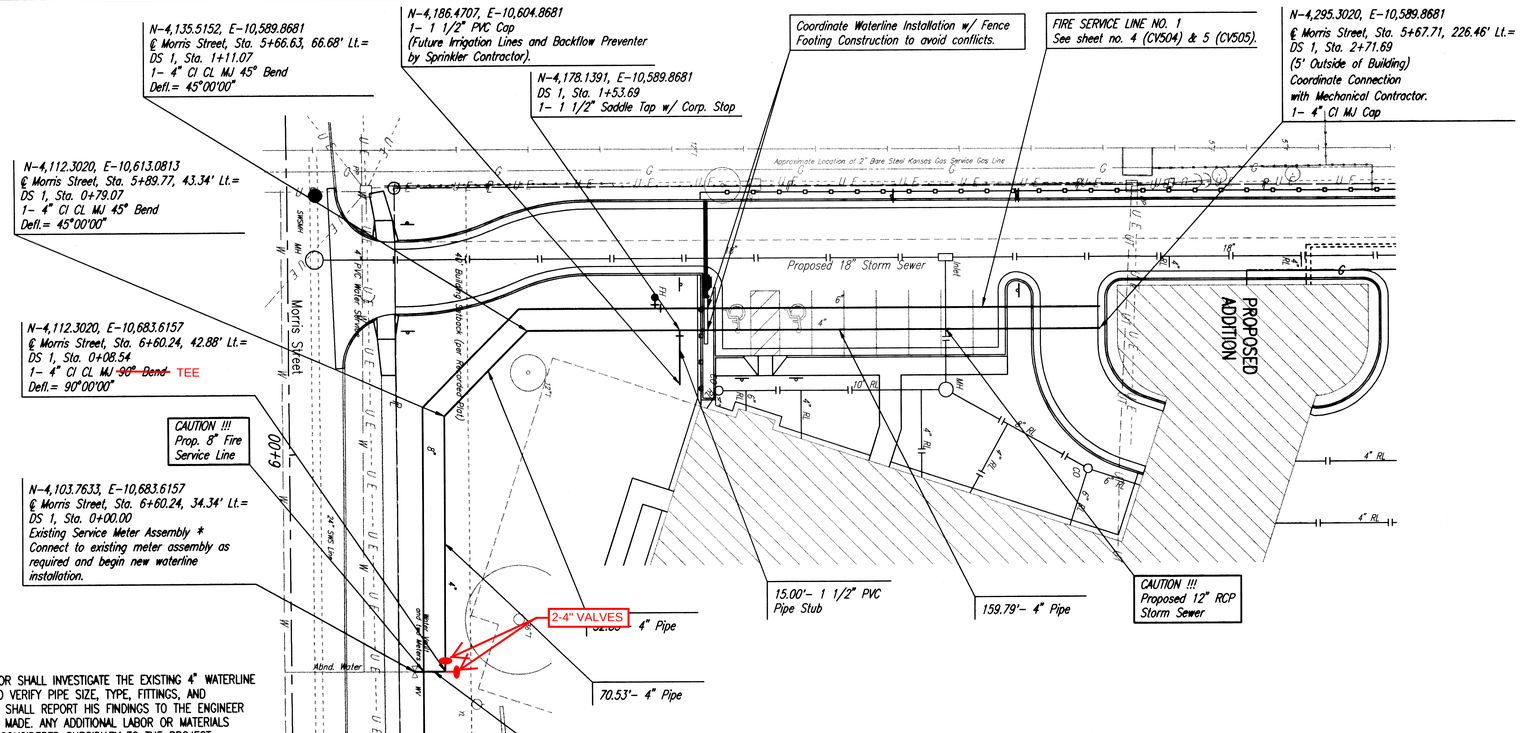

SCALE:

0 20 40

PLAN: LAT. & LONG.

PROFILE: HORIZ. SAME AS ABOVE

VERT.

PLAN

BY	DATE
CHECKED	
CHECKED	

* PRIOR TO BEGINNING CONSTRUCTION, THE CONTRACTOR SHALL INVESTIGATE THE EXISTING 4" WATERLINE AND SERVICE METER ASSEMBLY AT STATION 0+00.00 TO VERIFY PIPE SIZE, TYPE, FITTINGS, AND HORIZONTAL AND VERTICAL LOCATION. THE CONTRACTOR SHALL REPORT HIS FINDINGS TO THE ENGINEER SO THAT ANY NECESSARY PLAN MODIFICATIONS MAY BE MADE. ANY ADDITIONAL LABOR OR MATERIALS NECESSARY TO COMPLETE THE CONNECTION SHALL BE CONSIDERED SUBSIDIARY TO THE PROJECT.

Unless noted otherwise, elevations shown are top of pipe

DOMESTIC SERVICE LINE NO. 1

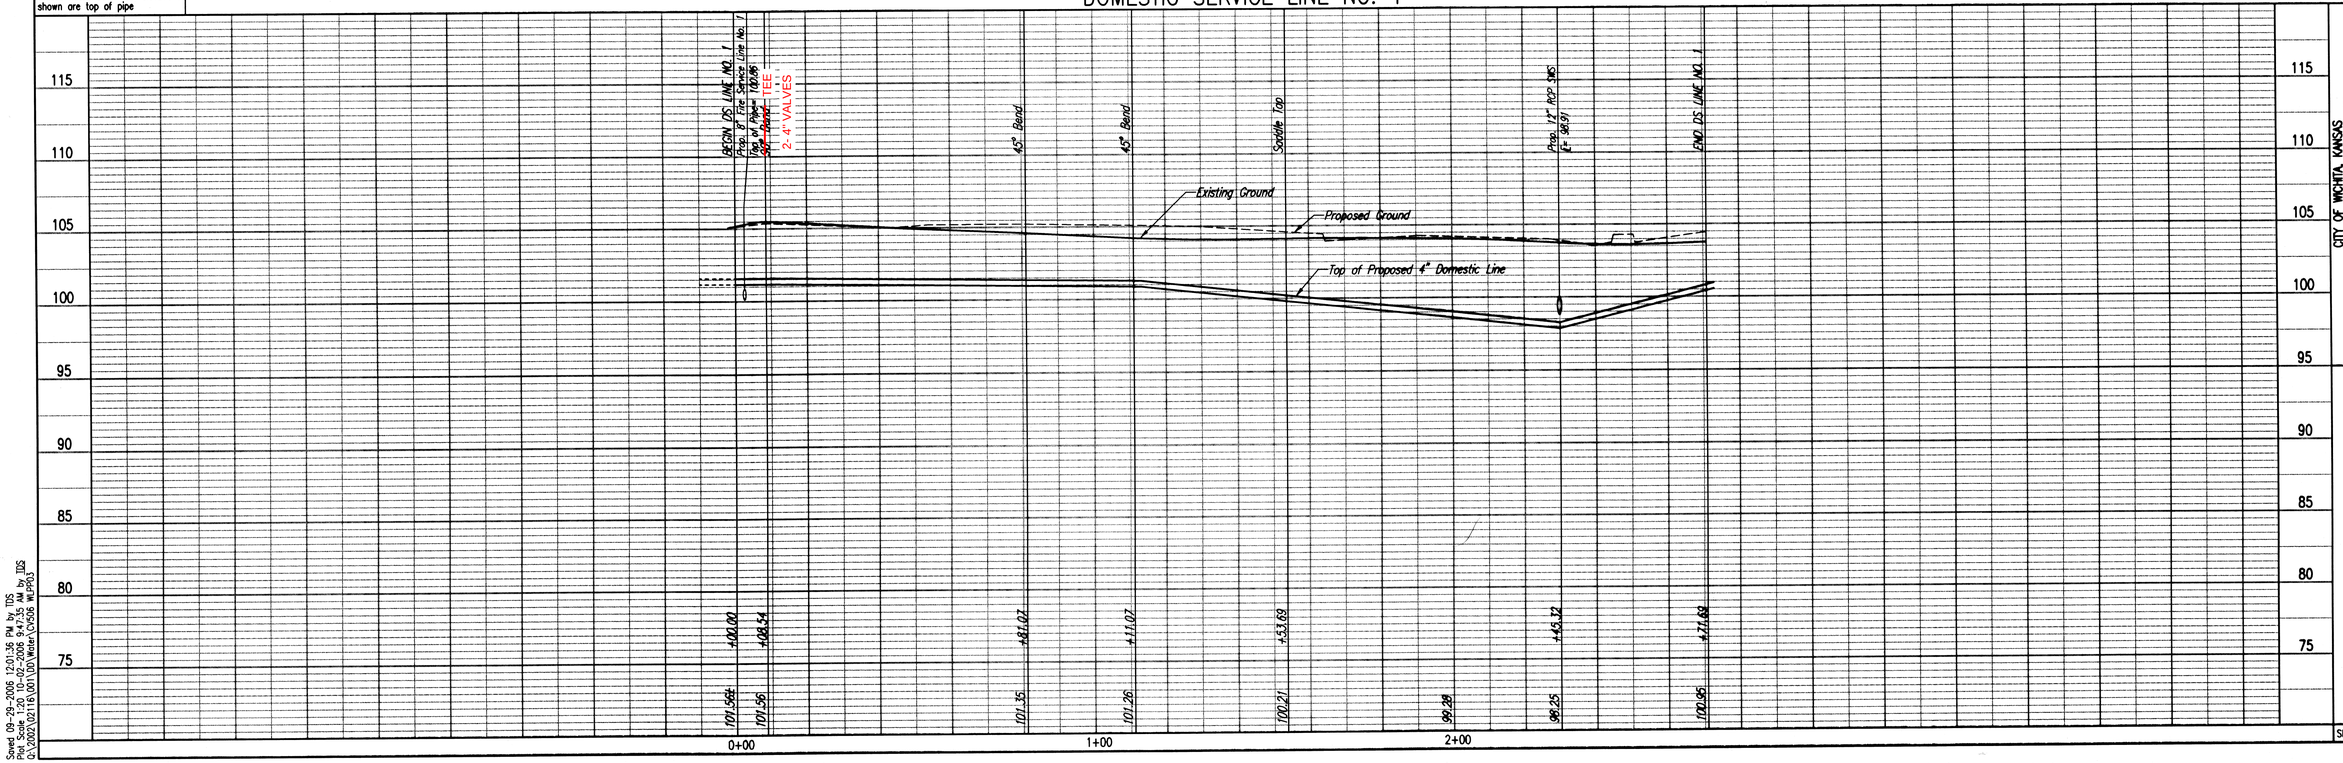

PROFILE

BY	DATE
CHECKED	
CHECKED	

CITY OF WICHITA, KANSAS
JAMES L. LAMOUREUX JUVENILE COURT COMPLEX
SEDGWICK COUNTY JUVENILE COURT COMPLEX

DOMESTIC SERVICE LINE NO. 1

CITY OF WICHITA PRIVATE PROJECT NO. 1201 PPM (607853)

Professional Engineering Consultants, P.A.
303 S. TOPEKA · WICHITA, KANSAS 67202
316.262.2691 · FAX 316.262.3003

Designed by DWH | Job No. 35-02116-001-259
Drawn by DCM | Date August 2003

Sheet 6 of 10

DAVID W. HERBERICH
LICENSED
16758
02-07-06
KANSAS
PROFESSIONAL ENGINEER

Saved 09-29-2006 12:01:36 PM by IDS
Plot Scale 1:20 10-02-2006 9:47:35 AM by IDS
O:\2002\02116\001\00\Water\CV506 WLPP03