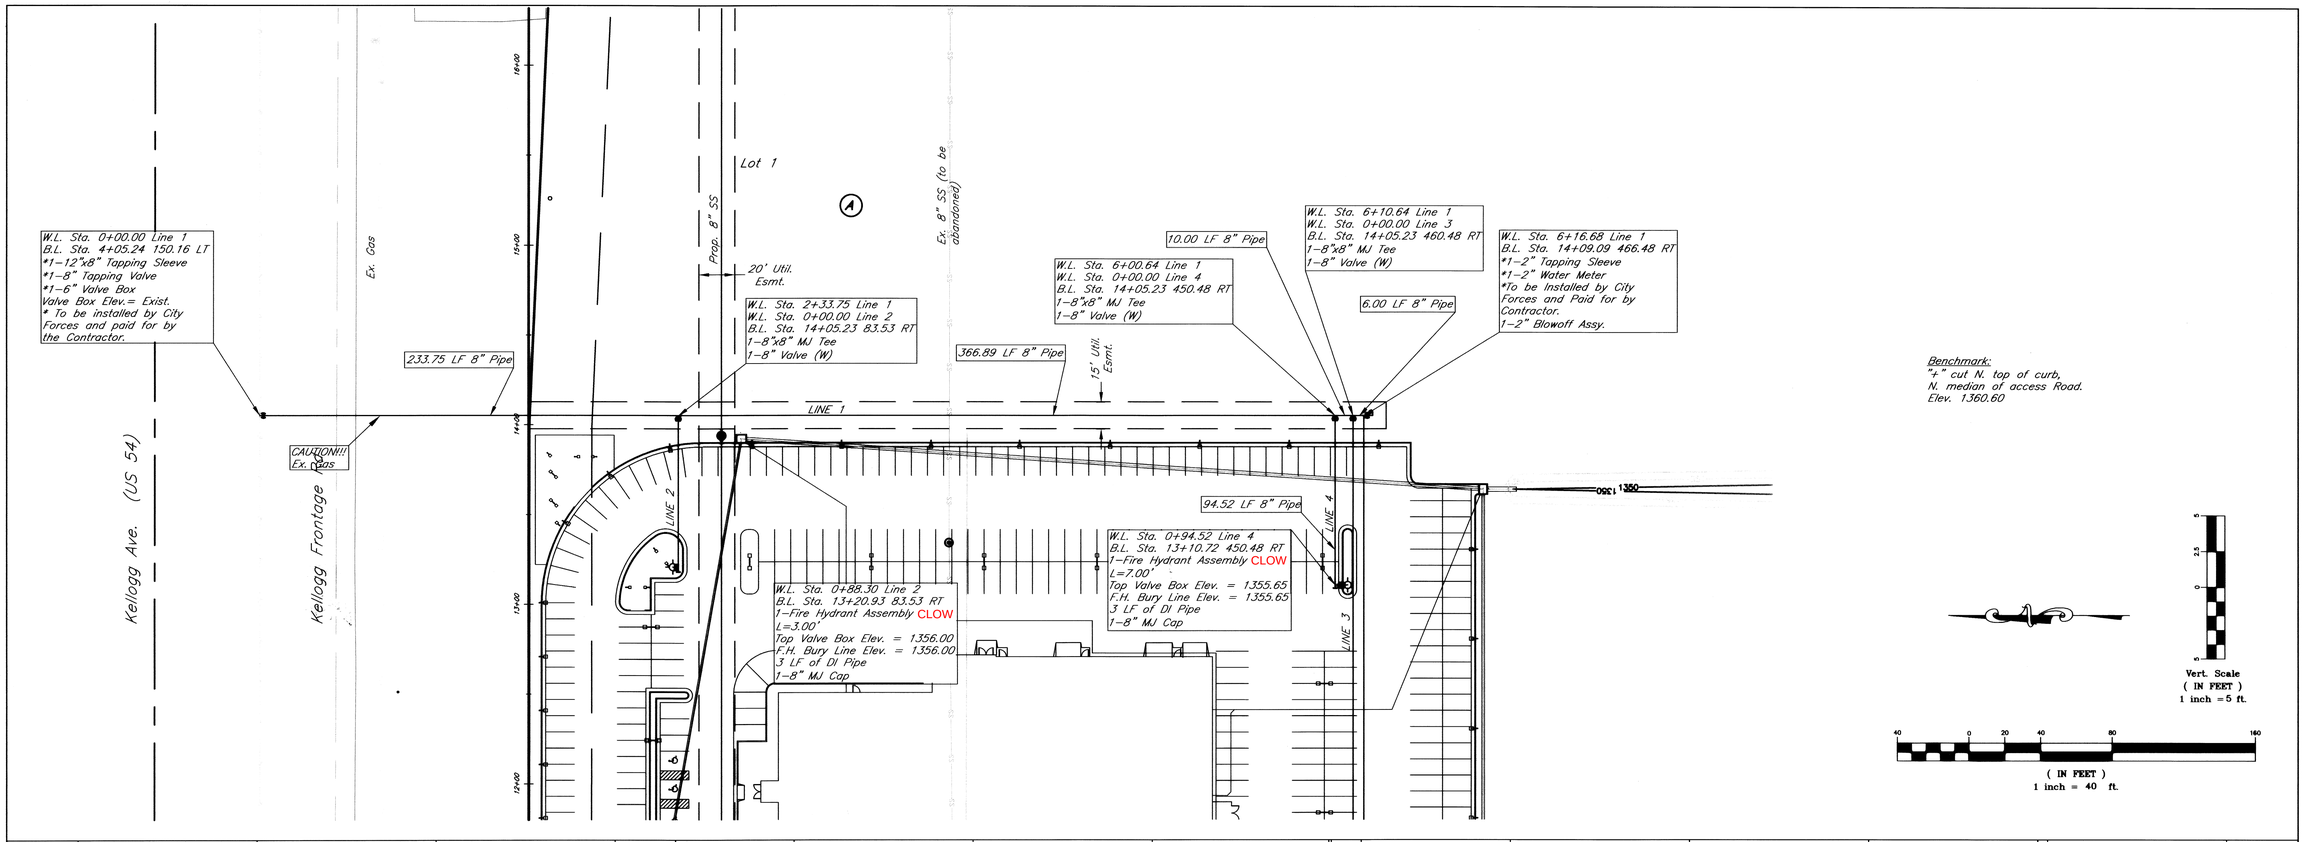

Davis Moore Mazda

Line 1 & Line 4

Wichita, Kansas

kemiller engineering

516 S. Market,
Wichita, KS 67202
316/264-0242

PROJECT NUMBER			
1308 PPW 607853			
KEM NO. 06188	FILE ppw sh 2	DATE 3/07	SHEET 2
DESIGN KM	DRAWN JO	REVISED 05/01/07	OF 4