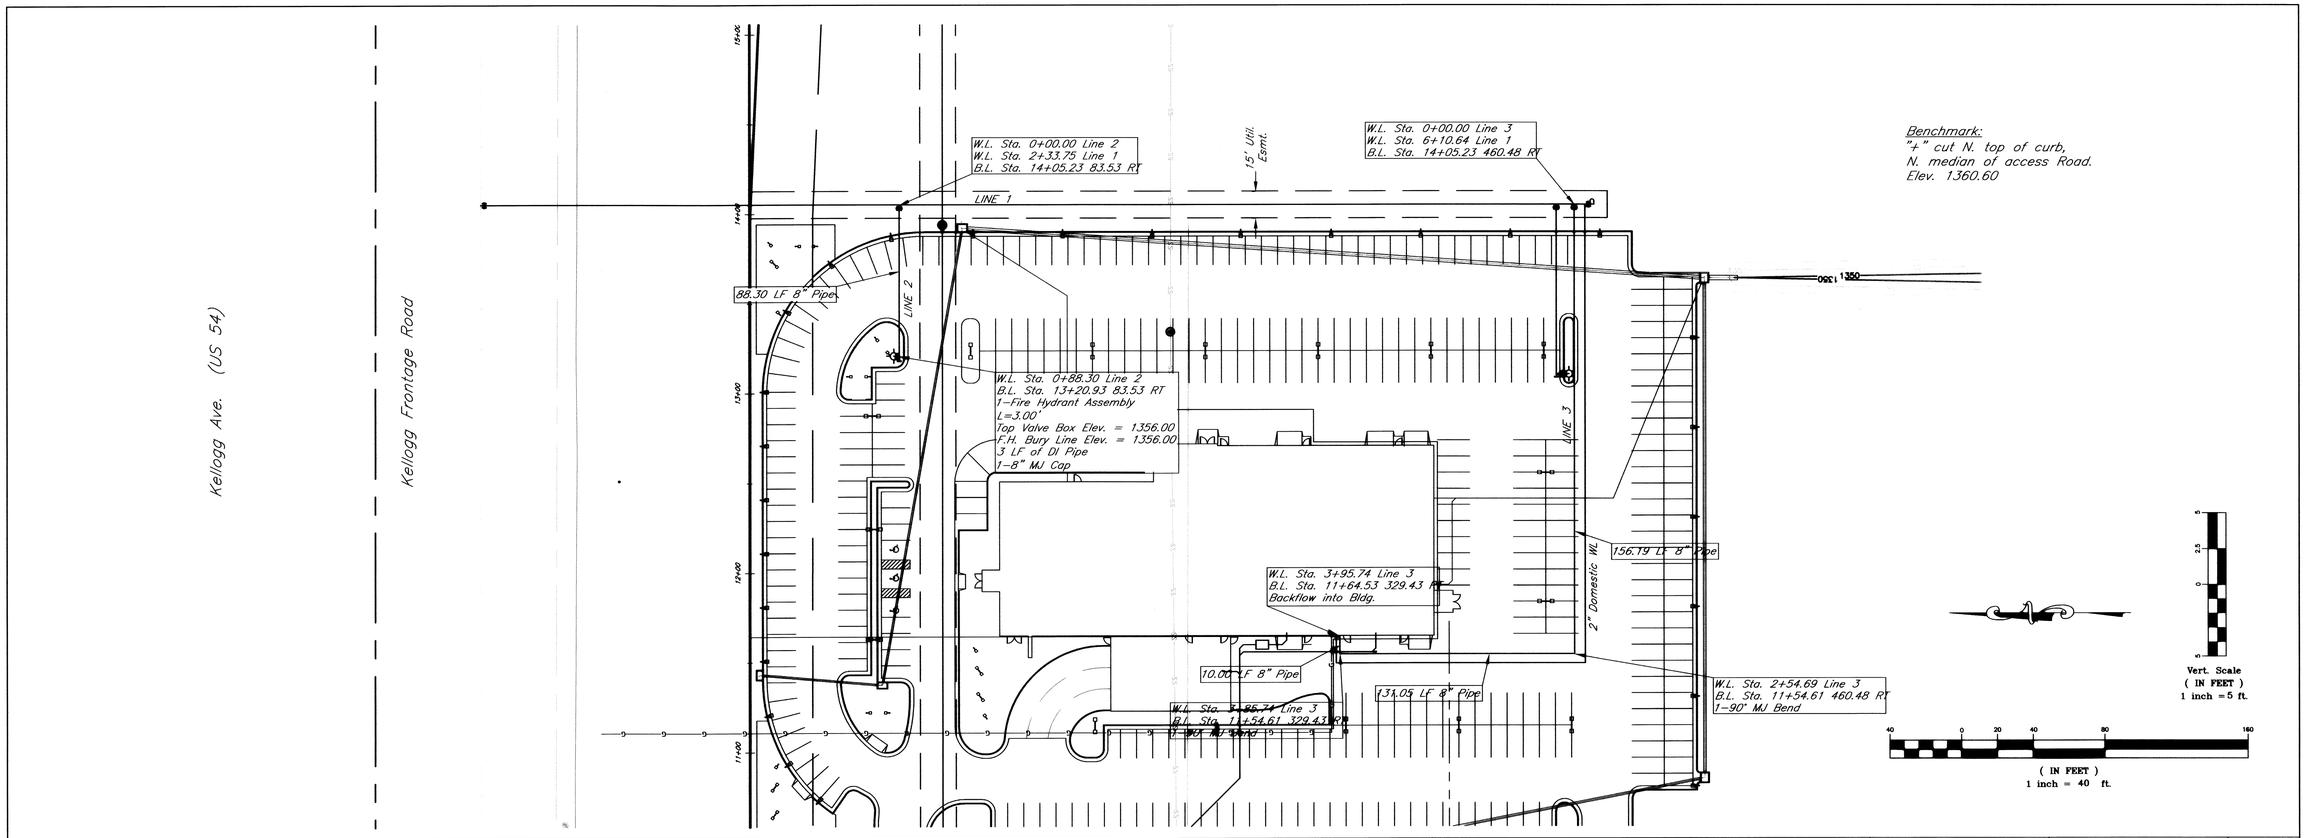

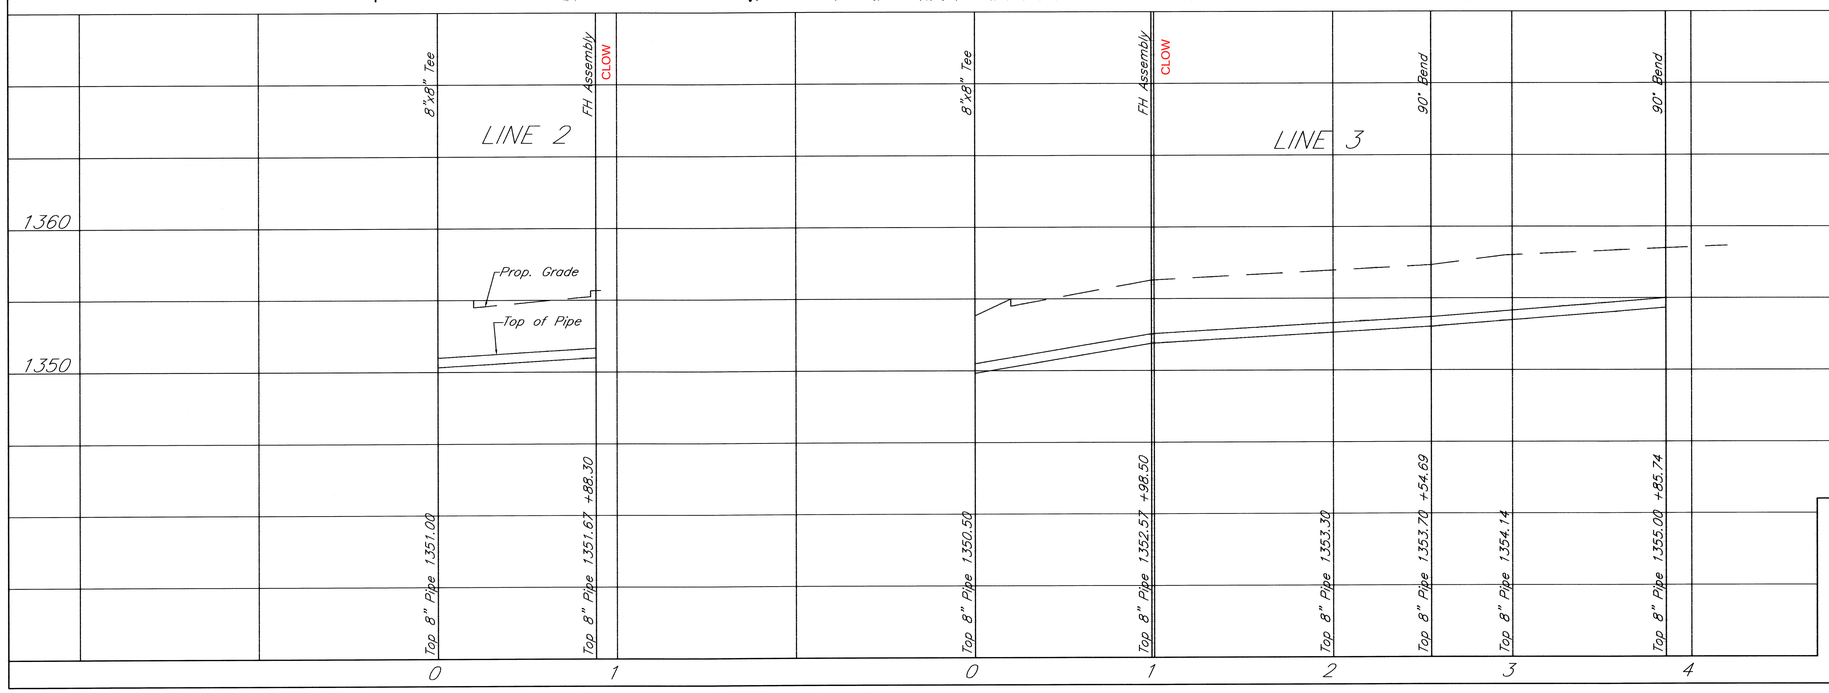

Davis Moore Mazda

Lines 2 & 3

Wichita, Kansas

kemiller engineering
516 S. Market,
Wichita, KS 67202
316/264-0242

PROJECT NUMBER 1308 PPW 607853			
KEM. NO. 06188	FILE ppw sh3	DATE 3/07	SHEET 3
DESIGN KM	DRAWN JO	REVISED 04/04/07	OF 4