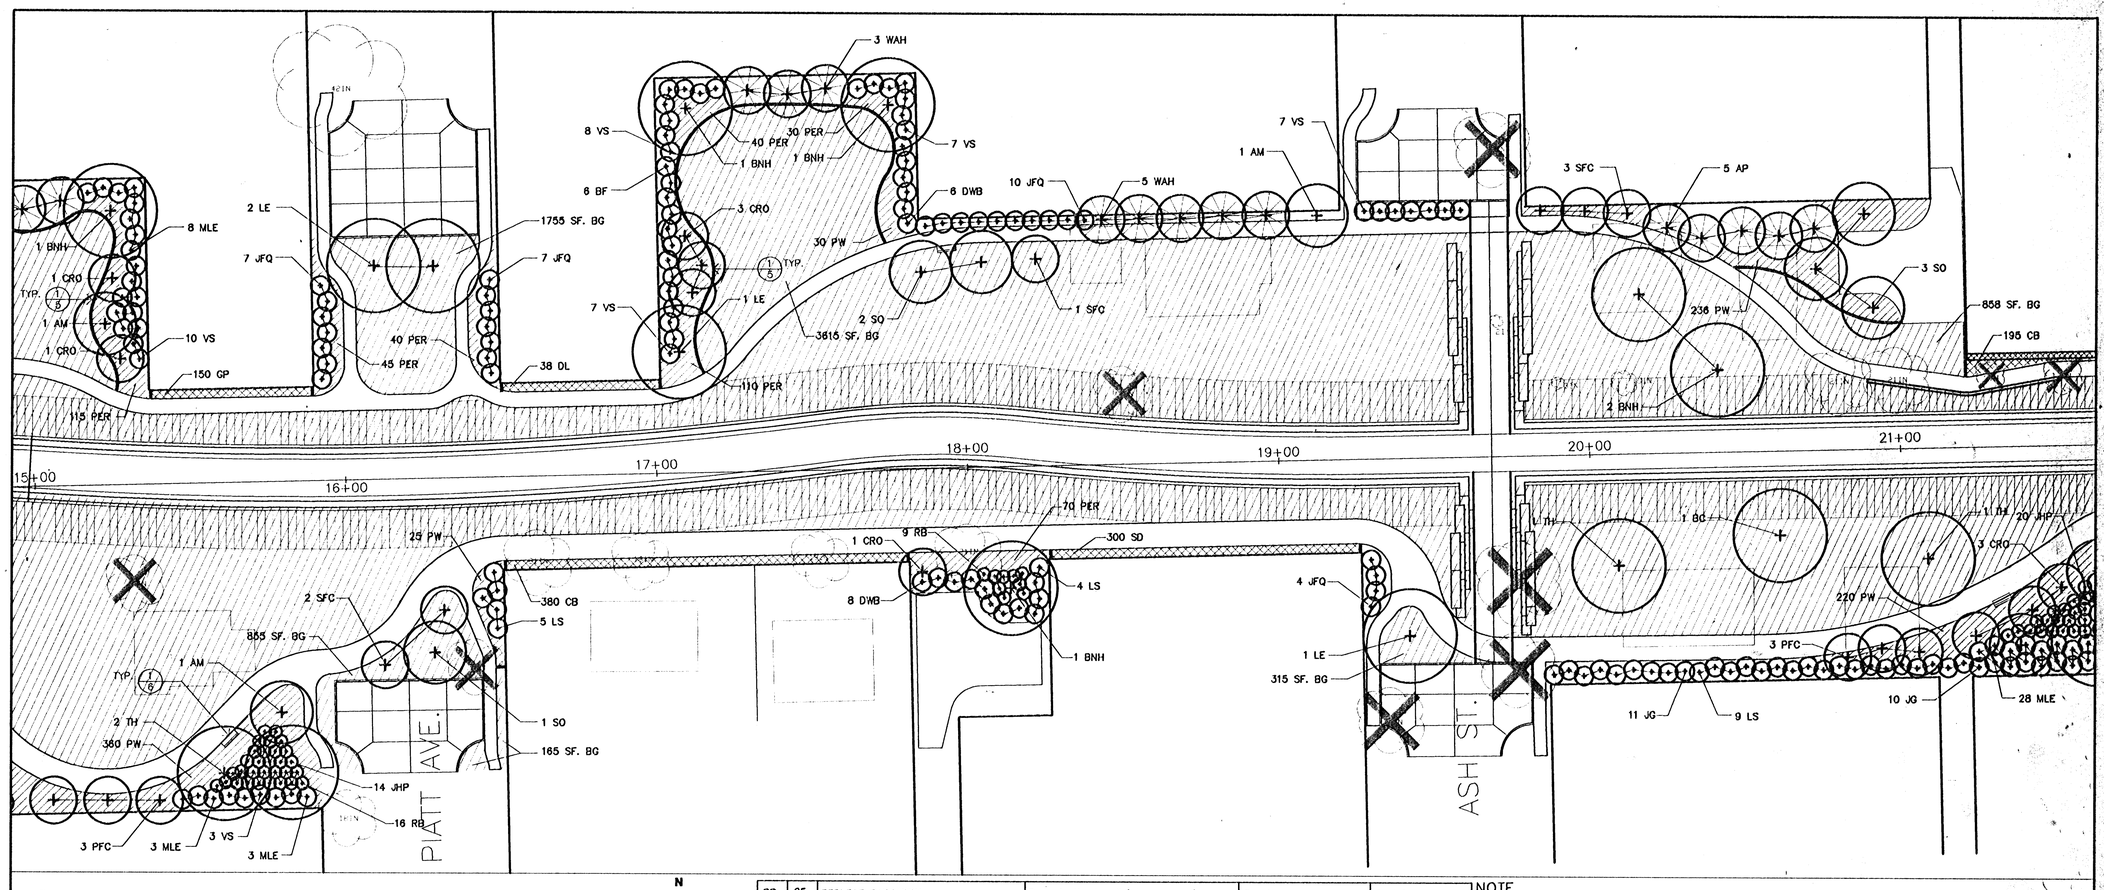

A STATION 15+00.00 TO STATION 21+00.00

N

0' 10' 20'
1"=20'-0"

PLANT LIST FOR THIS SHEET

KEY	QTY.	COMMON NAME	BOTANICAL NAME	SIZE	CONDITION
LARGE DECIDUOUS TREES					
BNH	6	RIVER BIRCH	Betula nigra 'Heritage'	2" to 2 1/2" cal.	Balled-in-Burlap
TH	4	THORNLESS HONEYLOCUST	Gleditsia triacanthos 'Shademaster'	2" to 2 1/2" cal.	Balled-in-Burlap
LE	4	LACEBARK ELM	Ulmus parvifolia	2" to 2 1/2" cal.	Balled-in-Burlap
BC	1	BALD CYPRESS	Taxodium distichum	2" to 2 1/2" cal.	Balled-in-Burlap
SMALL TO MEDIUM DECIDUOUS TREES					
AM	3	AMUR MAPLE	Acer ginnala 'Flame'	2" to 2 1/2" cal.	Balled-in-Burlap
CRO	9	OKLAHOMA REDBUD	Cercis reniformis 'Oklahoma'	2" to 2 1/2" cal.	Balled-in-Burlap
WAH	8	WASHINGTON HAWTHORN	Crataegus phaenopyrum 'Select'	2" to 2 1/2" cal.	Balled-in-Burlap
PFC	6	FLOWERING CRABAPPLE	Malus spp. 'Prairifire'	2" to 2 1/2" cal.	Balled-in-Burlap
SFC	6	FLOWERING CRABAPPLE	Malus spp. 'Spring Snow'	2" to 2 1/2" cal.	Balled-in-Burlap
SO	6	SAWTOOTH OAK	Quercus acutissima	2" to 2 1/2" cal.	Balled-in-Burlap
SMALL TO MEDIUM BROADLEAF EVERGREEN TREES					
AP	5	AUSTRIAN PINE	Pinus nigra	2" to 2 1/2" cal.	Balled-in-Burlap
MEDIUM TO LARGE DECIDUOUS SHRUBS					
RB	25	REDLEAF BARBERRY	Berberis thunbergii 'atropurpurea'	5 gal.	Container
JFQ	28	JAPANESE FLOWERING QUINCE	Chaenomeles japonica	5 gal.	Container
DWB	14	DWARF WINGED BURNING BUSH	Euonymus alatus 'compacta'	5 gal.	Container
MLE	42	MEDIUM LEAF EUONYMUS	Euonymus kiautschovicus	5 gal.	Container
BF	6	BORDER FORSYTHIA	Forsythia x intermedia	5 gal.	Container
LS	25	LILAC	Lilac Syringe	5 gal.	Container
VS	42	VANHOUTT SPIREA	Spirea x vanhouttei	5 gal.	Container
EVERGREEN SHRUB					
JHP	34	ANDORRA JUNIPER	Juniperus horizontalis 'Plumosa'	2 gal.	Container
JG	21	JAPANESE GARDEN JUNIPER	Juniperus procumbens	5 gal.	Container
GROUNDCOVERS					
PW	871	PURPLELEAF WINTERCREEPER	Euonymus fortunei 'coloratus'	1 gal., 24" O.C.	Container
PER	450	PERIWINKLE	Vinca minor	1 gal., 24" O.C.	Container
PERENNIALS					
DL	38	DAYLILY	Hemerocallis hybrids	1 gal., 24" O.C.	Container
CB	575	COREL BELLS	Heuchera sanguinea	2 1/4" pot, 18" O.C.	Container
SD	300	SHASTA DAISY	Chrysanthemum superburn	2 1/4" pot, 18" O.C.	Container
GP	150	GARDEN PHLOX	Phlox paniculata	4" pot, 18" O.C.	Container
GRASS					
BG	7563 SF.	COMMON BERMUDA GRASS	Cynodon dactylon	Seed	Drilled

NOTE

-CONSTRUCTION OF SANITARY SEWER SEE SHEET 4-10
-CONSTRUCTION OF STORM WATER SEWER SEE SHEET 11-15
-CONSTRUCTION OF PAVED CHANNEL SEE SHEET 16-23
-CONSTRUCTION OF PAVED CUL-DE-SACS SEE SHEET 24-33
-CONSTRUCTION OF PEDESTRIAN BRIDGE SEE SHEET 41-42
-CONSTRUCTION OF SIDEWALK/PATHWAY SEE SHEET 34-40

GosselLivingston

MID-KANSAS ENGINEERING CONSULTANTS, INC.
411 N. WEBB ROAD
WICHITA, KS. 67206
316-684-9600

AREA "K" 3RD. STREET CHANNEL
PROJECT NAME

LANDSCAPE PLAN
SHEET TITLE

TDM, JRS	TDM, JRS	CHECKED BY:
DESIGN BY:	DRAWN BY:	
JUNE 96	9331_B2	44, 77
DATE	JOB NO.	SHEET/OF