BENCHMARKS:

BM #8 – City of Wichita Disc @ 13th Street North & Firefly Drive, 38.5' N of ℄ of 13th Street North @ the ℄ of Firefly Drive Elev. = 1332.92 (MSL Datum)

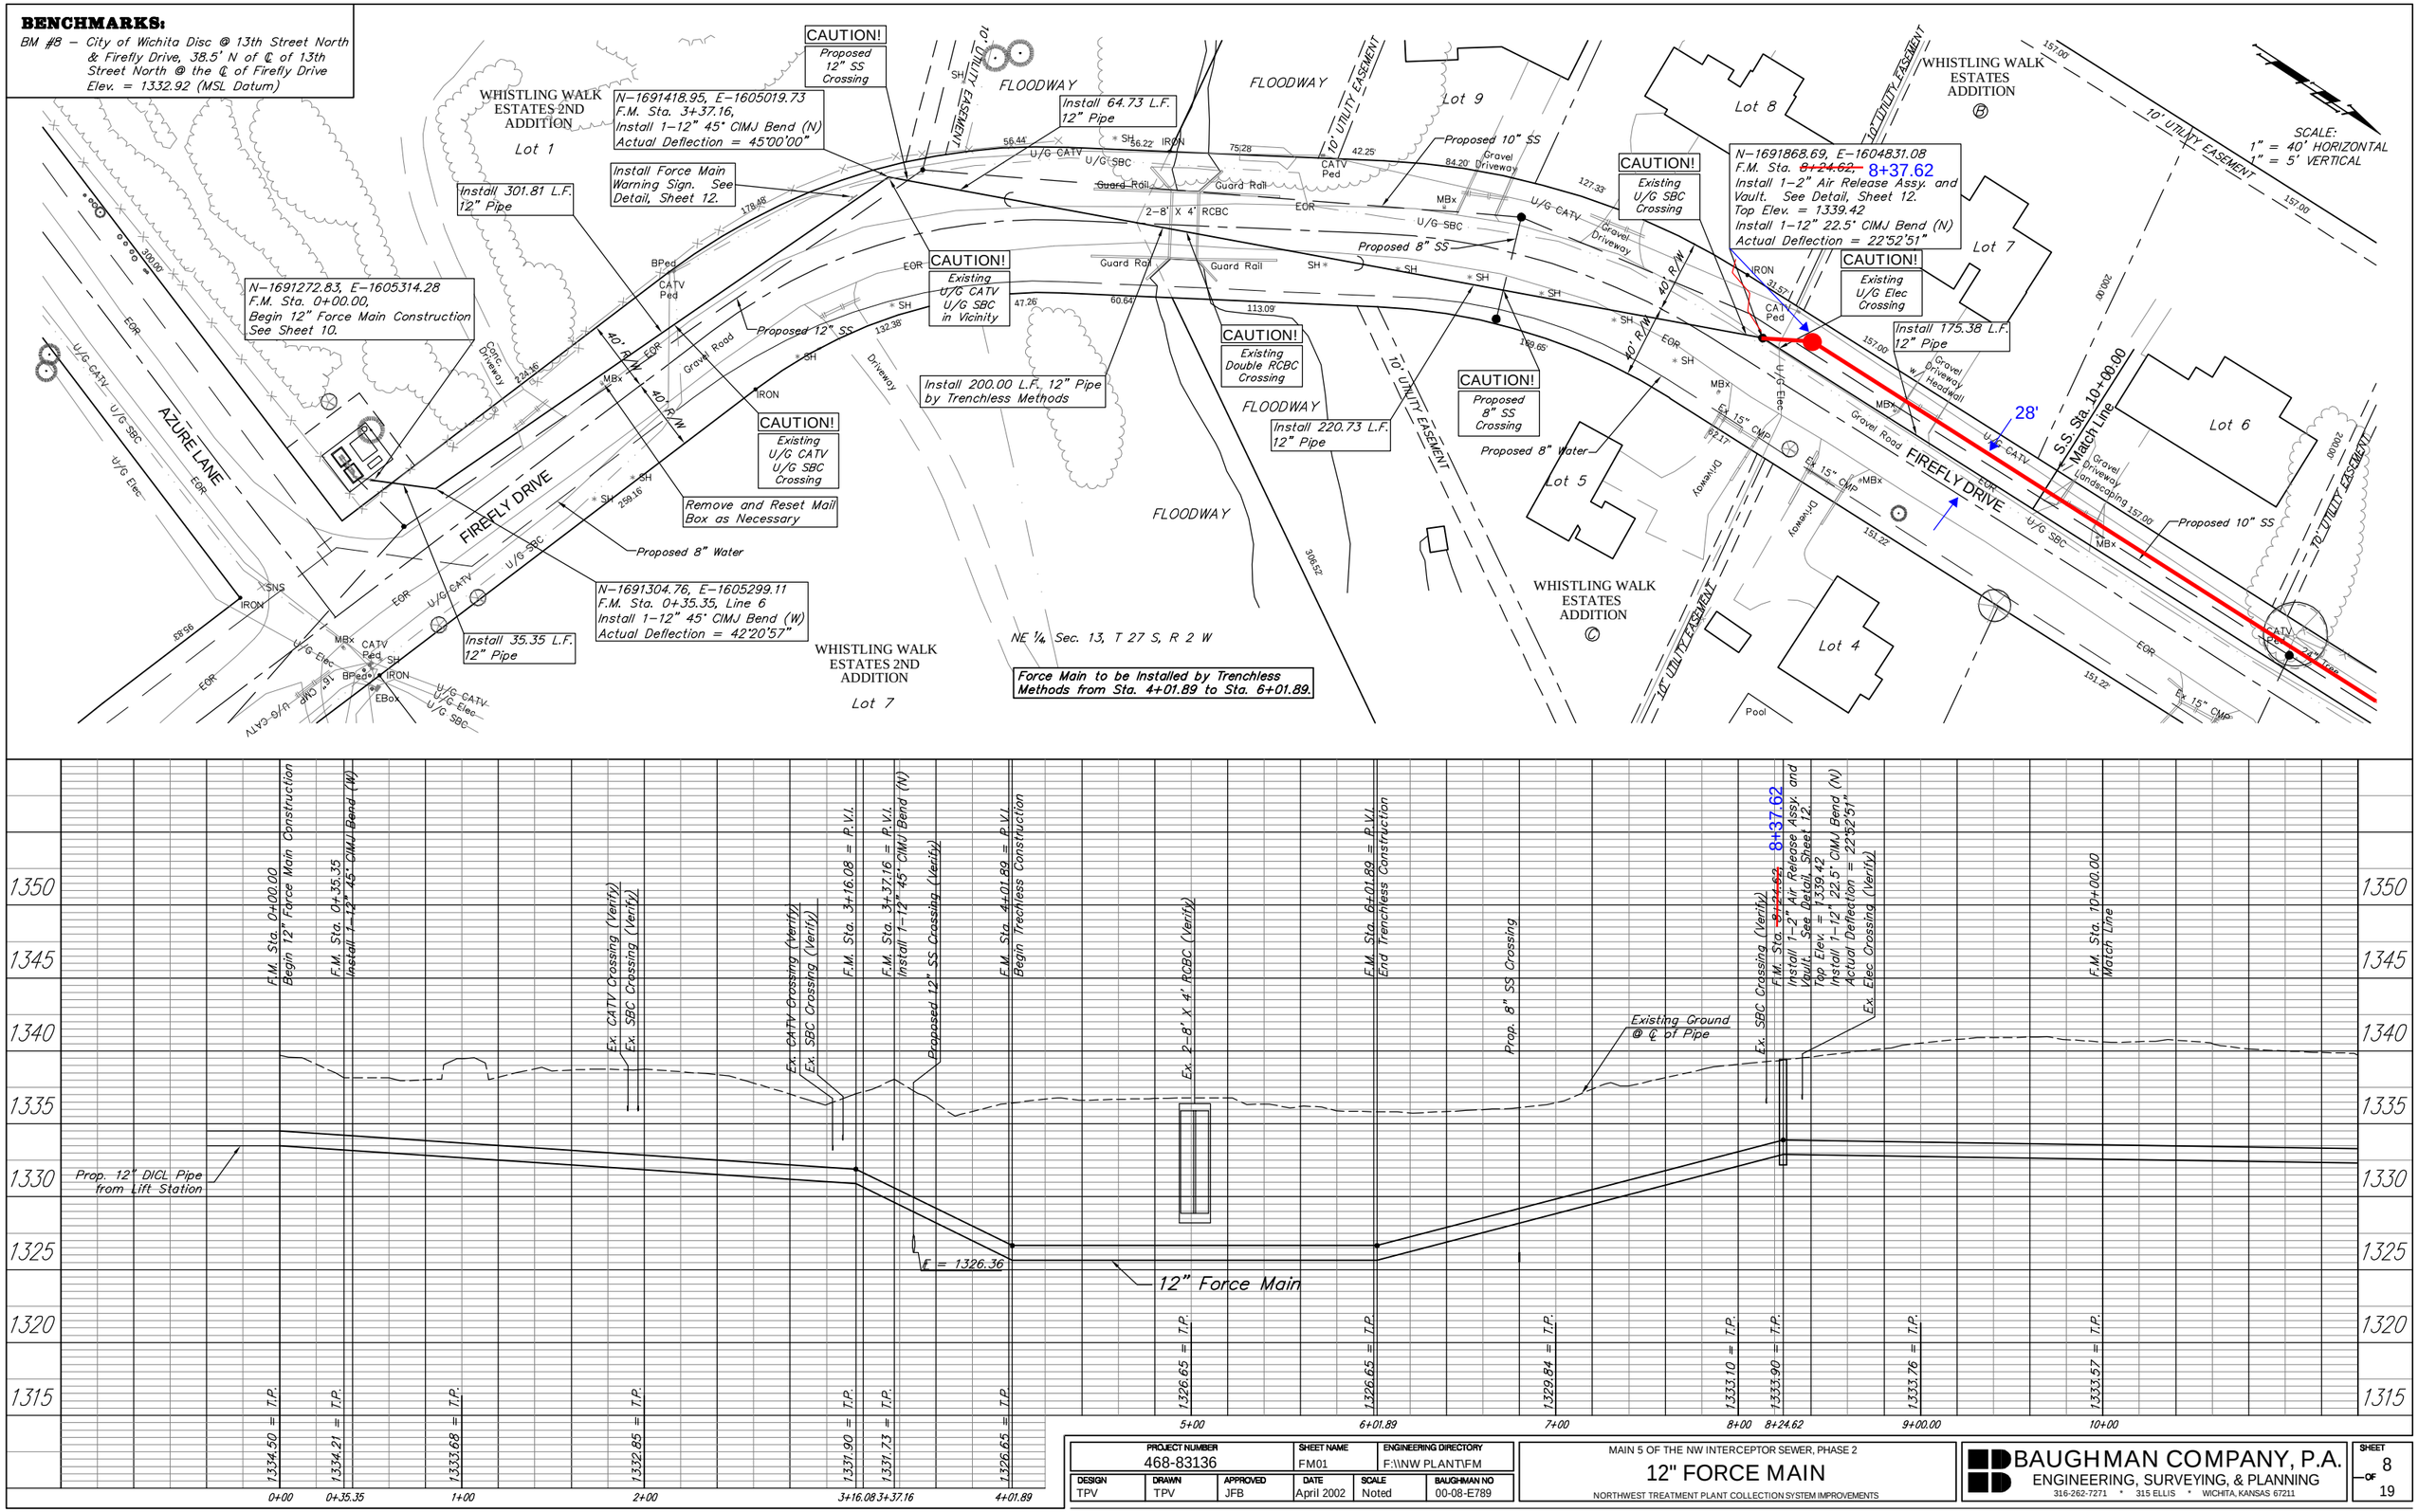

PROJECT NUMBER			SHEET NAME	ENGINEERING DIRECTORY	
468-83136			FM01	F:\\NW PLANT\FM	
DESIGN	DRAWN	APPROVED	DATE	SCALE	BAUGHMAN NO
TPV	TPV	JFB	April 2002	Noted	00-08-E789

MAIN 5 OF THE NW INTERCEPTOR SEWER, PHASE 2

12" FORCE MAIN

NORTHWEST TREATMENT PLANT COLLECTION SYSTEM IMPROVEMENTS

BAUGHMAN COMPANY, P.A.
ENGINEERING, SURVEYING, & PLANNING
316-262-7271 * 315 ELLIS * WICHITA, KANSAS 67211