
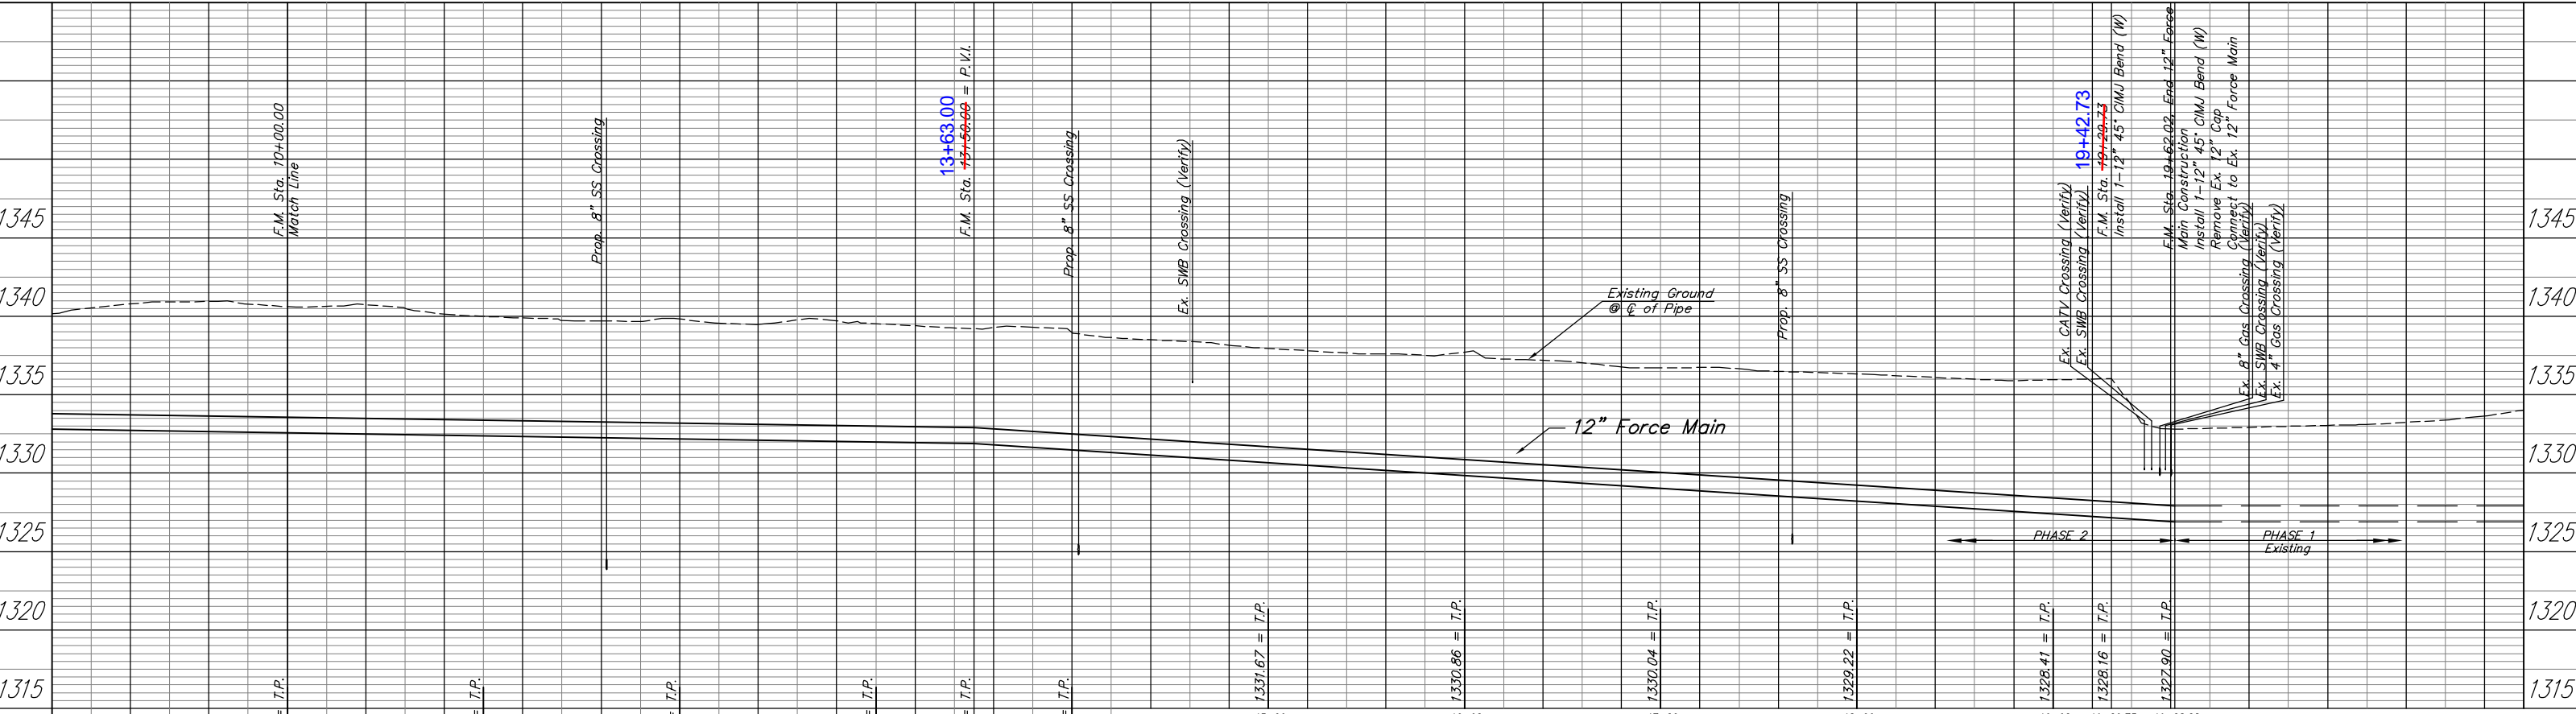


BENCHMARKS:
 BM #8 - City of Wichita Disc @ 13th Street North & Firefly Drive, 38.5' N of @ of 13th Street North @ the @ of Firefly Drive Elev. = 1332.92 (MSL Datum)

SCALE:
 1" = 40' HORIZONTAL
 1" = 5' VERTICAL

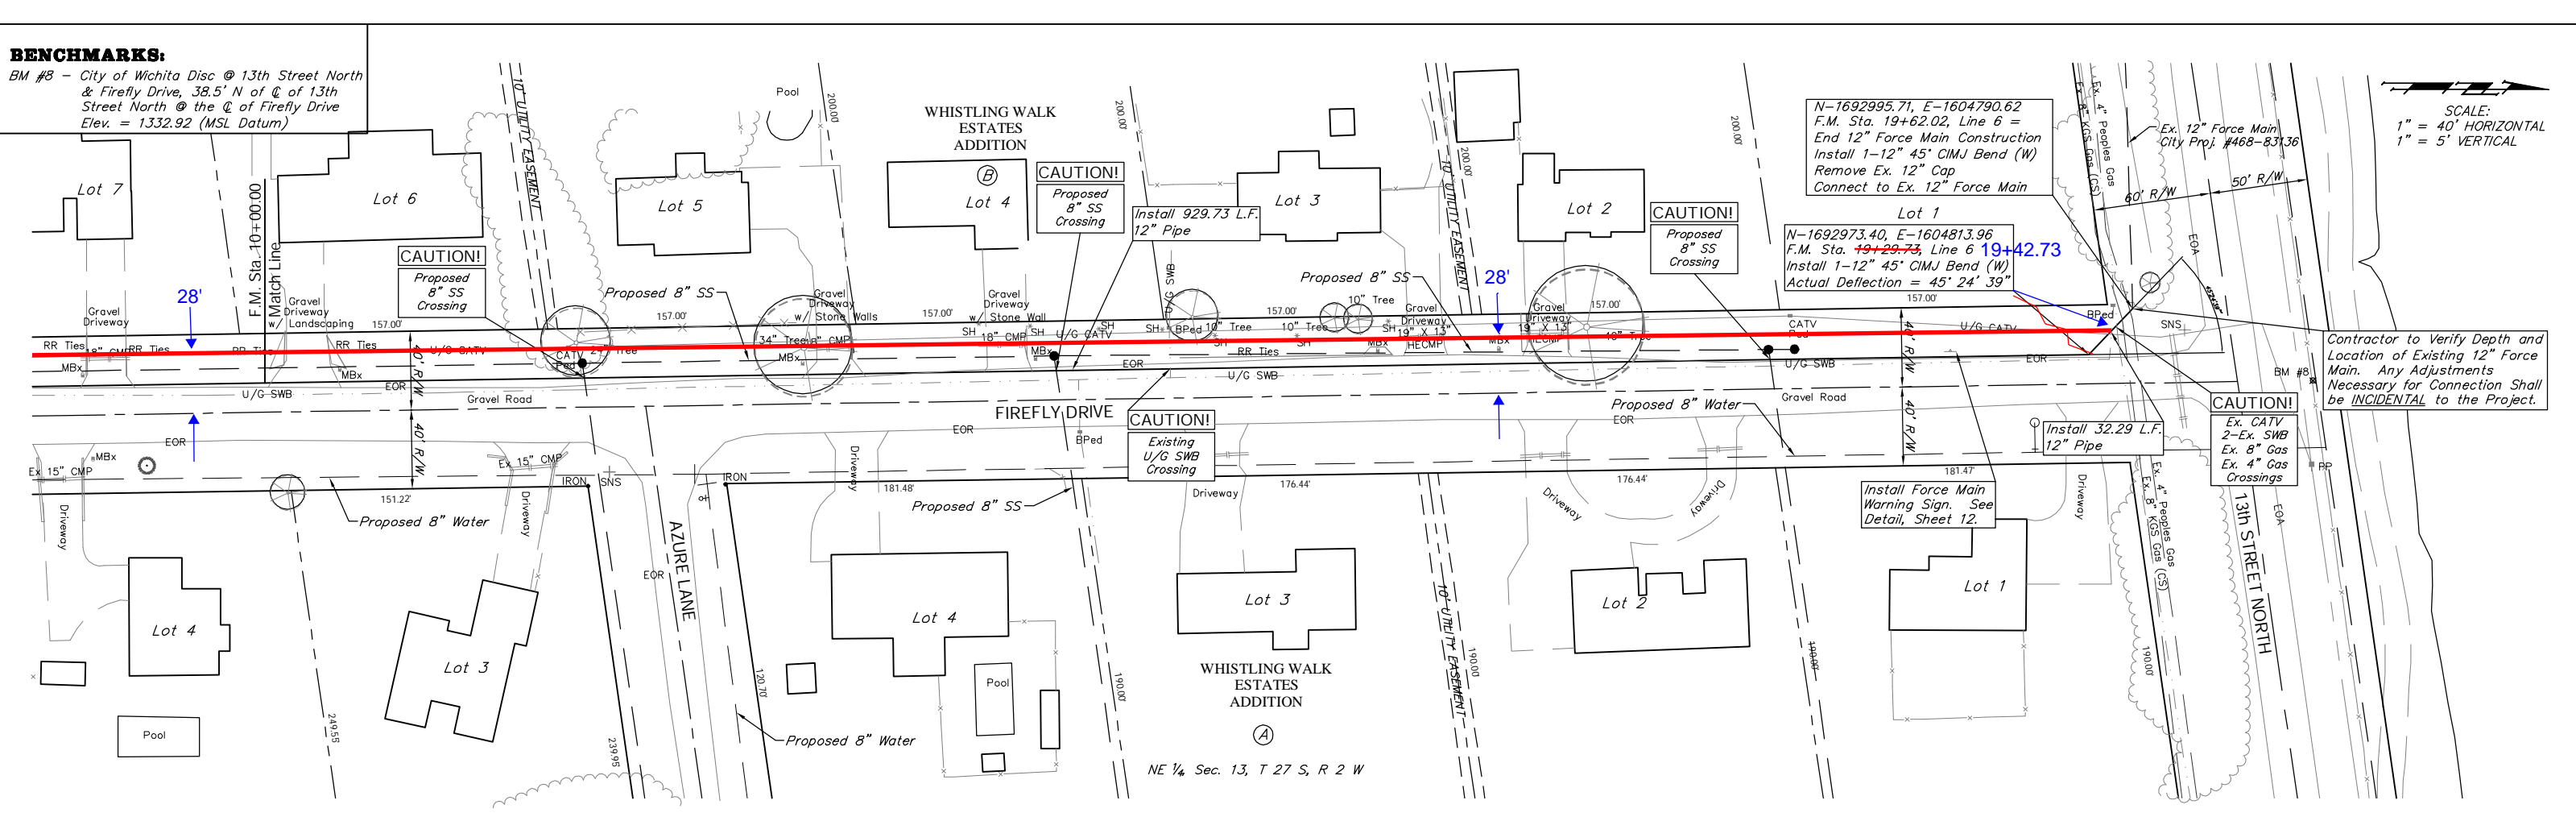

PROJECT NUMBER 468-83136		SHEET NAME FM02		ENGINEERING DIRECTORY F:\NW PLANT\FM	
DESIGN TPV	DRAWN TPV	APPROVED JFB	DATE April 2002	SCALE Noted	BAUGHMAN NO 00-08-E789
PROJECT TITLE MAIN 5 OF THE NW INTERCEPTOR SEWER, PHASE 2			SHEET NUMBER 9 OF 19		
PROJECT TITLE 12" FORCE MAIN			COMPANY BAUGHMAN COMPANY, P.A. ENGINEERING, SURVEYING, & PLANNING 316-262-7271 • 315 ELLIS • WICHITA, KANSAS 67211		