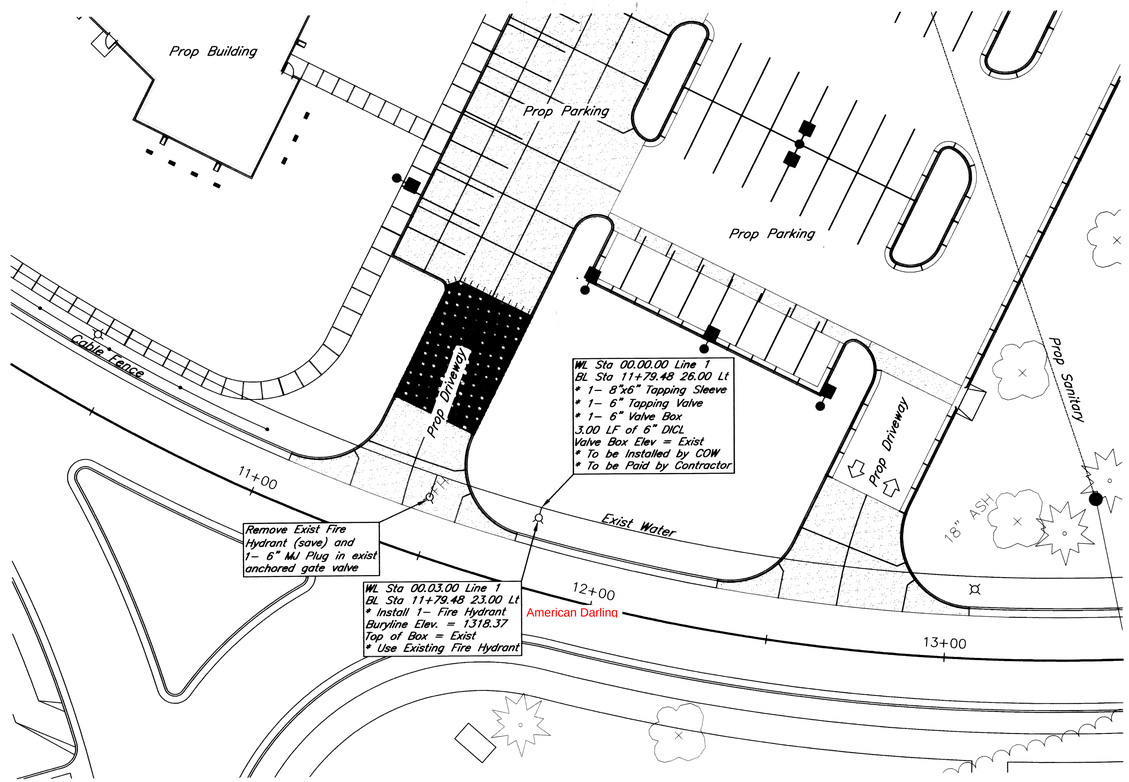

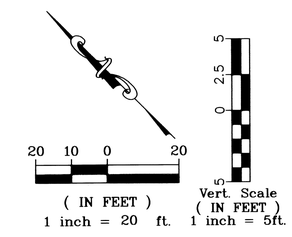

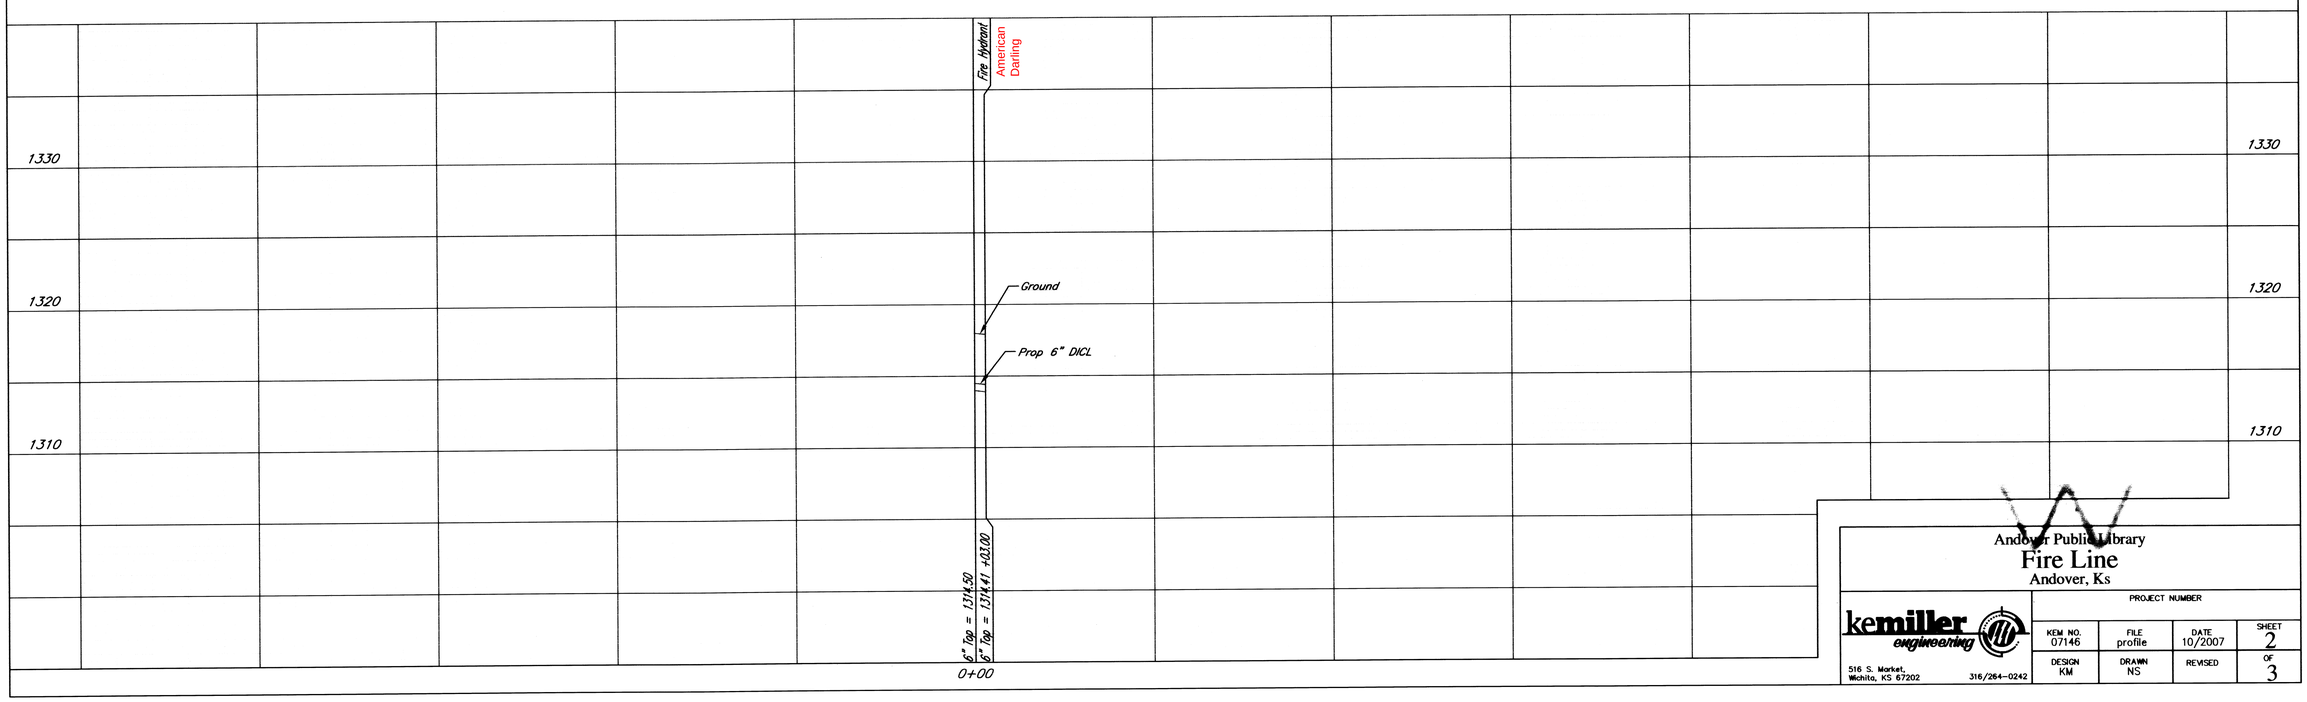

Andover Public Library

Fire Line

Andover, Ks

kemiller engineering
516 S. Market,
Wichita, KS 67202
316/264-0242

PROJECT NUMBER			
KEM NO. 07146	FILE profile	DATE 10/2007	SHEET 2
DESIGN KM	DRAWN NS	REVISED	OF 3