
B.M. 193.29 N.W. Cor. Conc. Step Ho. #1056

N

Scale: 1"=20'

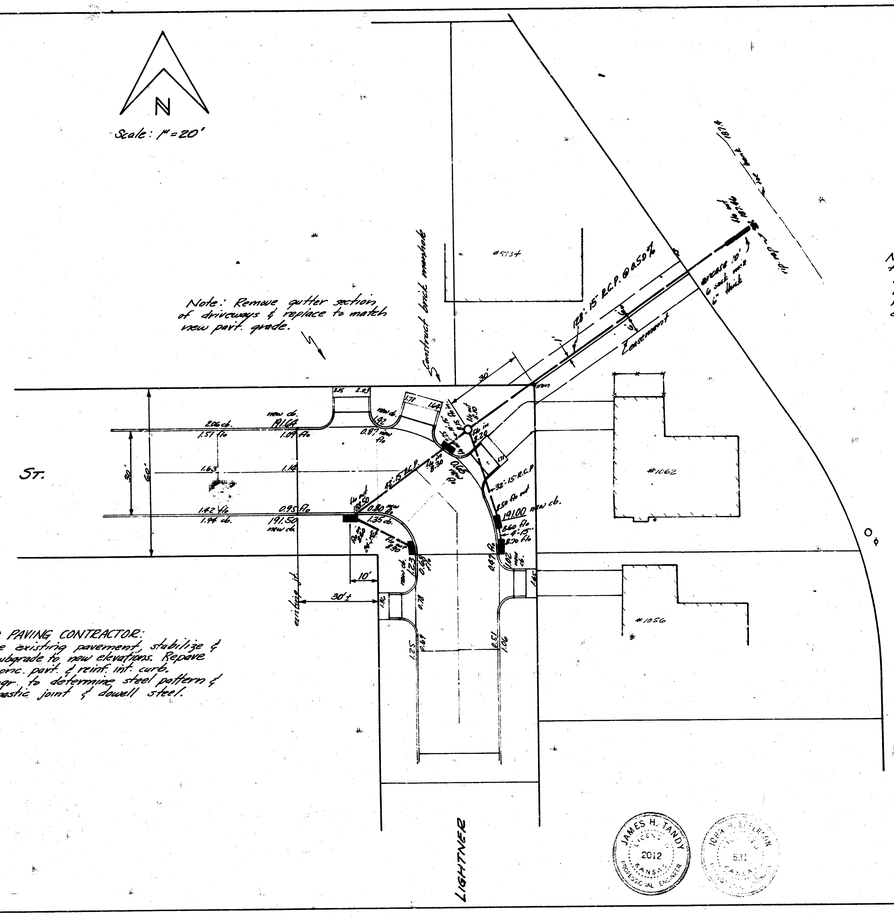

NOTE TO PAVING CONTRACTOR:
Remove existing pavement, stabilize & compact subgrade to new elevations. Prepare with 6" conc. pvmt. & front lot curb. Field Engr. to determine steel pattern & use of mastic joint & dowell steel.

NOTE TO SEWER CONTRACTOR: All drives to be trenched. Cost of pushing to be included in bid of sand fill where sand fill is used. Lin. ft. of pushing will be paid where excavated material is used for backfill. Encasement at outfall to be included in bid price of pipe.

INTERSECTION
LIGHTNER DR. & 10TH ST.
REMOVE EXISTING PVMT. & REPAVE - 6" CONC. PVMT.
INCIDENTAL DRAINAGE
CITY OF WICHITA, KANSAS
B.E. SMITH - CITY ENGINEER
MAY., 1958 GAS TAX REFUND
61-45-31-P

JAMES H. TANDY 2012 KANSAS REGISTERED PROFESSIONAL ENGINEER
JOHN C. HOLDEN 631 KANSAS REGISTERED PROFESSIONAL ENGINEER

6