
S-13

BM 108.72 T in Trdy Tan Hdg. N.W. Cor. Lincoln & St. Francis

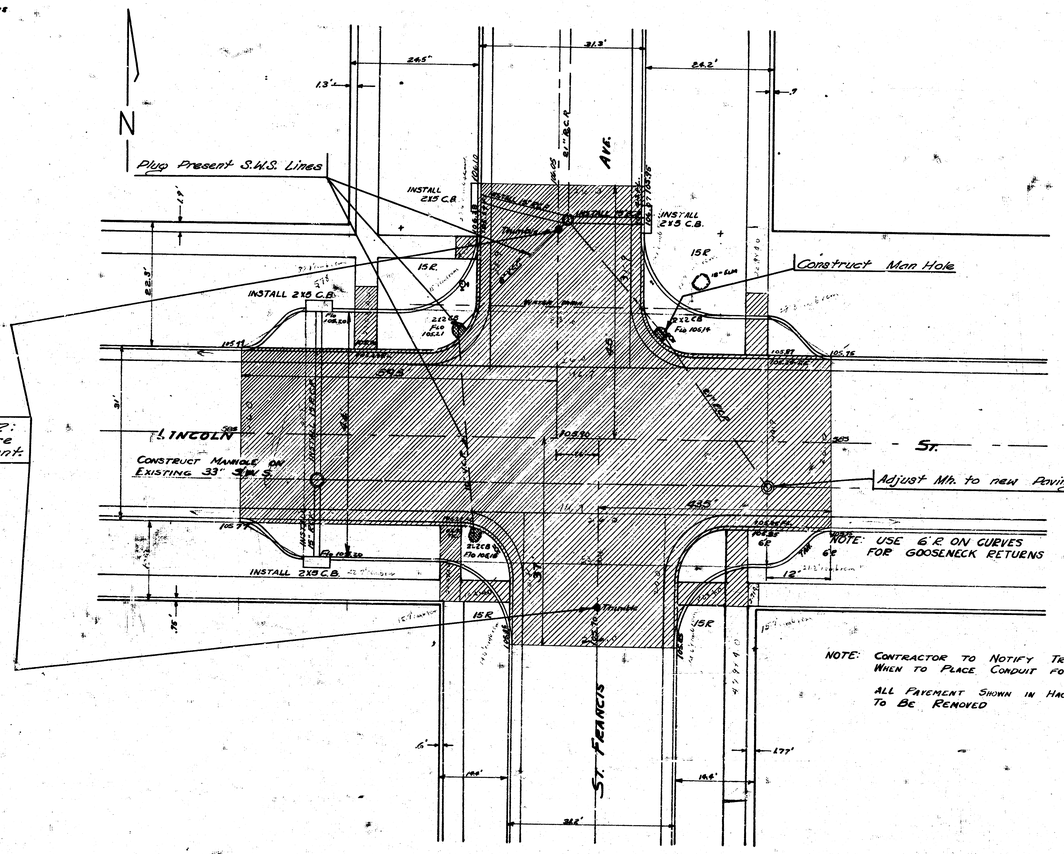

NOTE TO FIELD ENGINEER:
Get Ties to THIMBLES before removal of present pavement.

NOTE: CONTRACTOR TO NOTIFY TRAFFIC ENGINEER WHEN TO PLACE CONDUIT FOR TRAFFIC SIGNALS

ALL PAVEMENT SHOWN IN HACHURED AREA TO BE REMOVED

Survey Bk. 5-11
Plan 25
Est. 1.F.C.
Checked

INTERSECTION OF LINCOLN & ST. FRANCIS

REPAVE 8" CONC.

CITY OF WICHITA KANSAS

L.K. WHITE CITY ENGINEER

JUNE 1952 PROJ. NO. C11-102

1 3 5 (52)