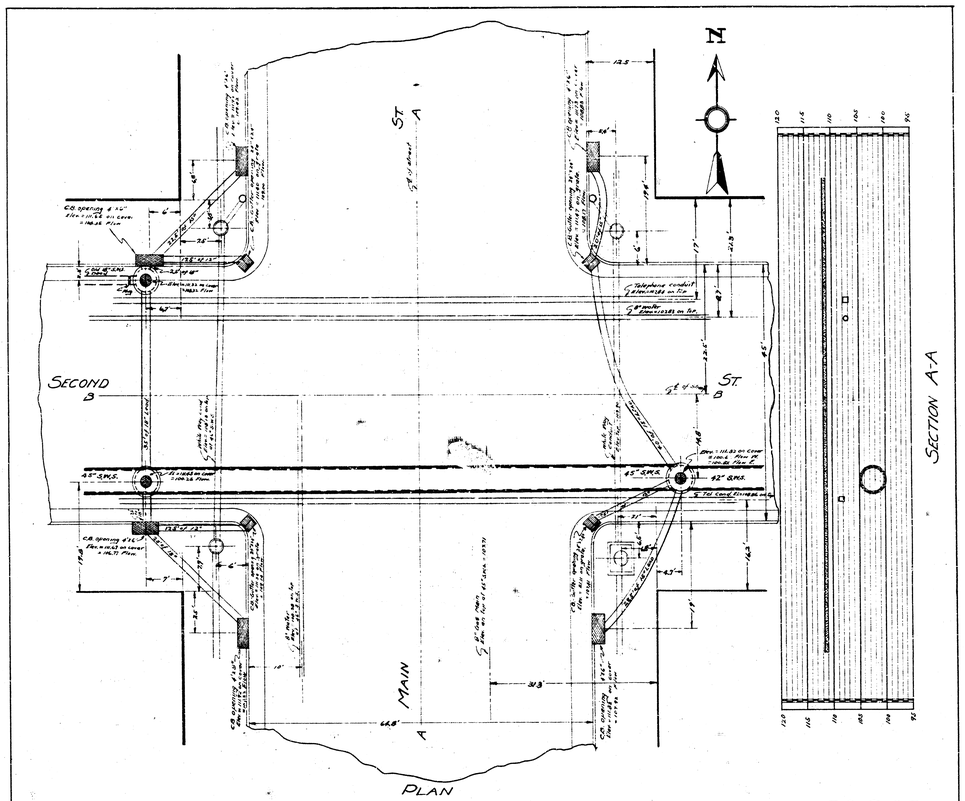


INTERSECTION OF MAIN & SECOND STREETS. WICHITA, KANSAS. CORRECTED TO SEPT. 1923.